


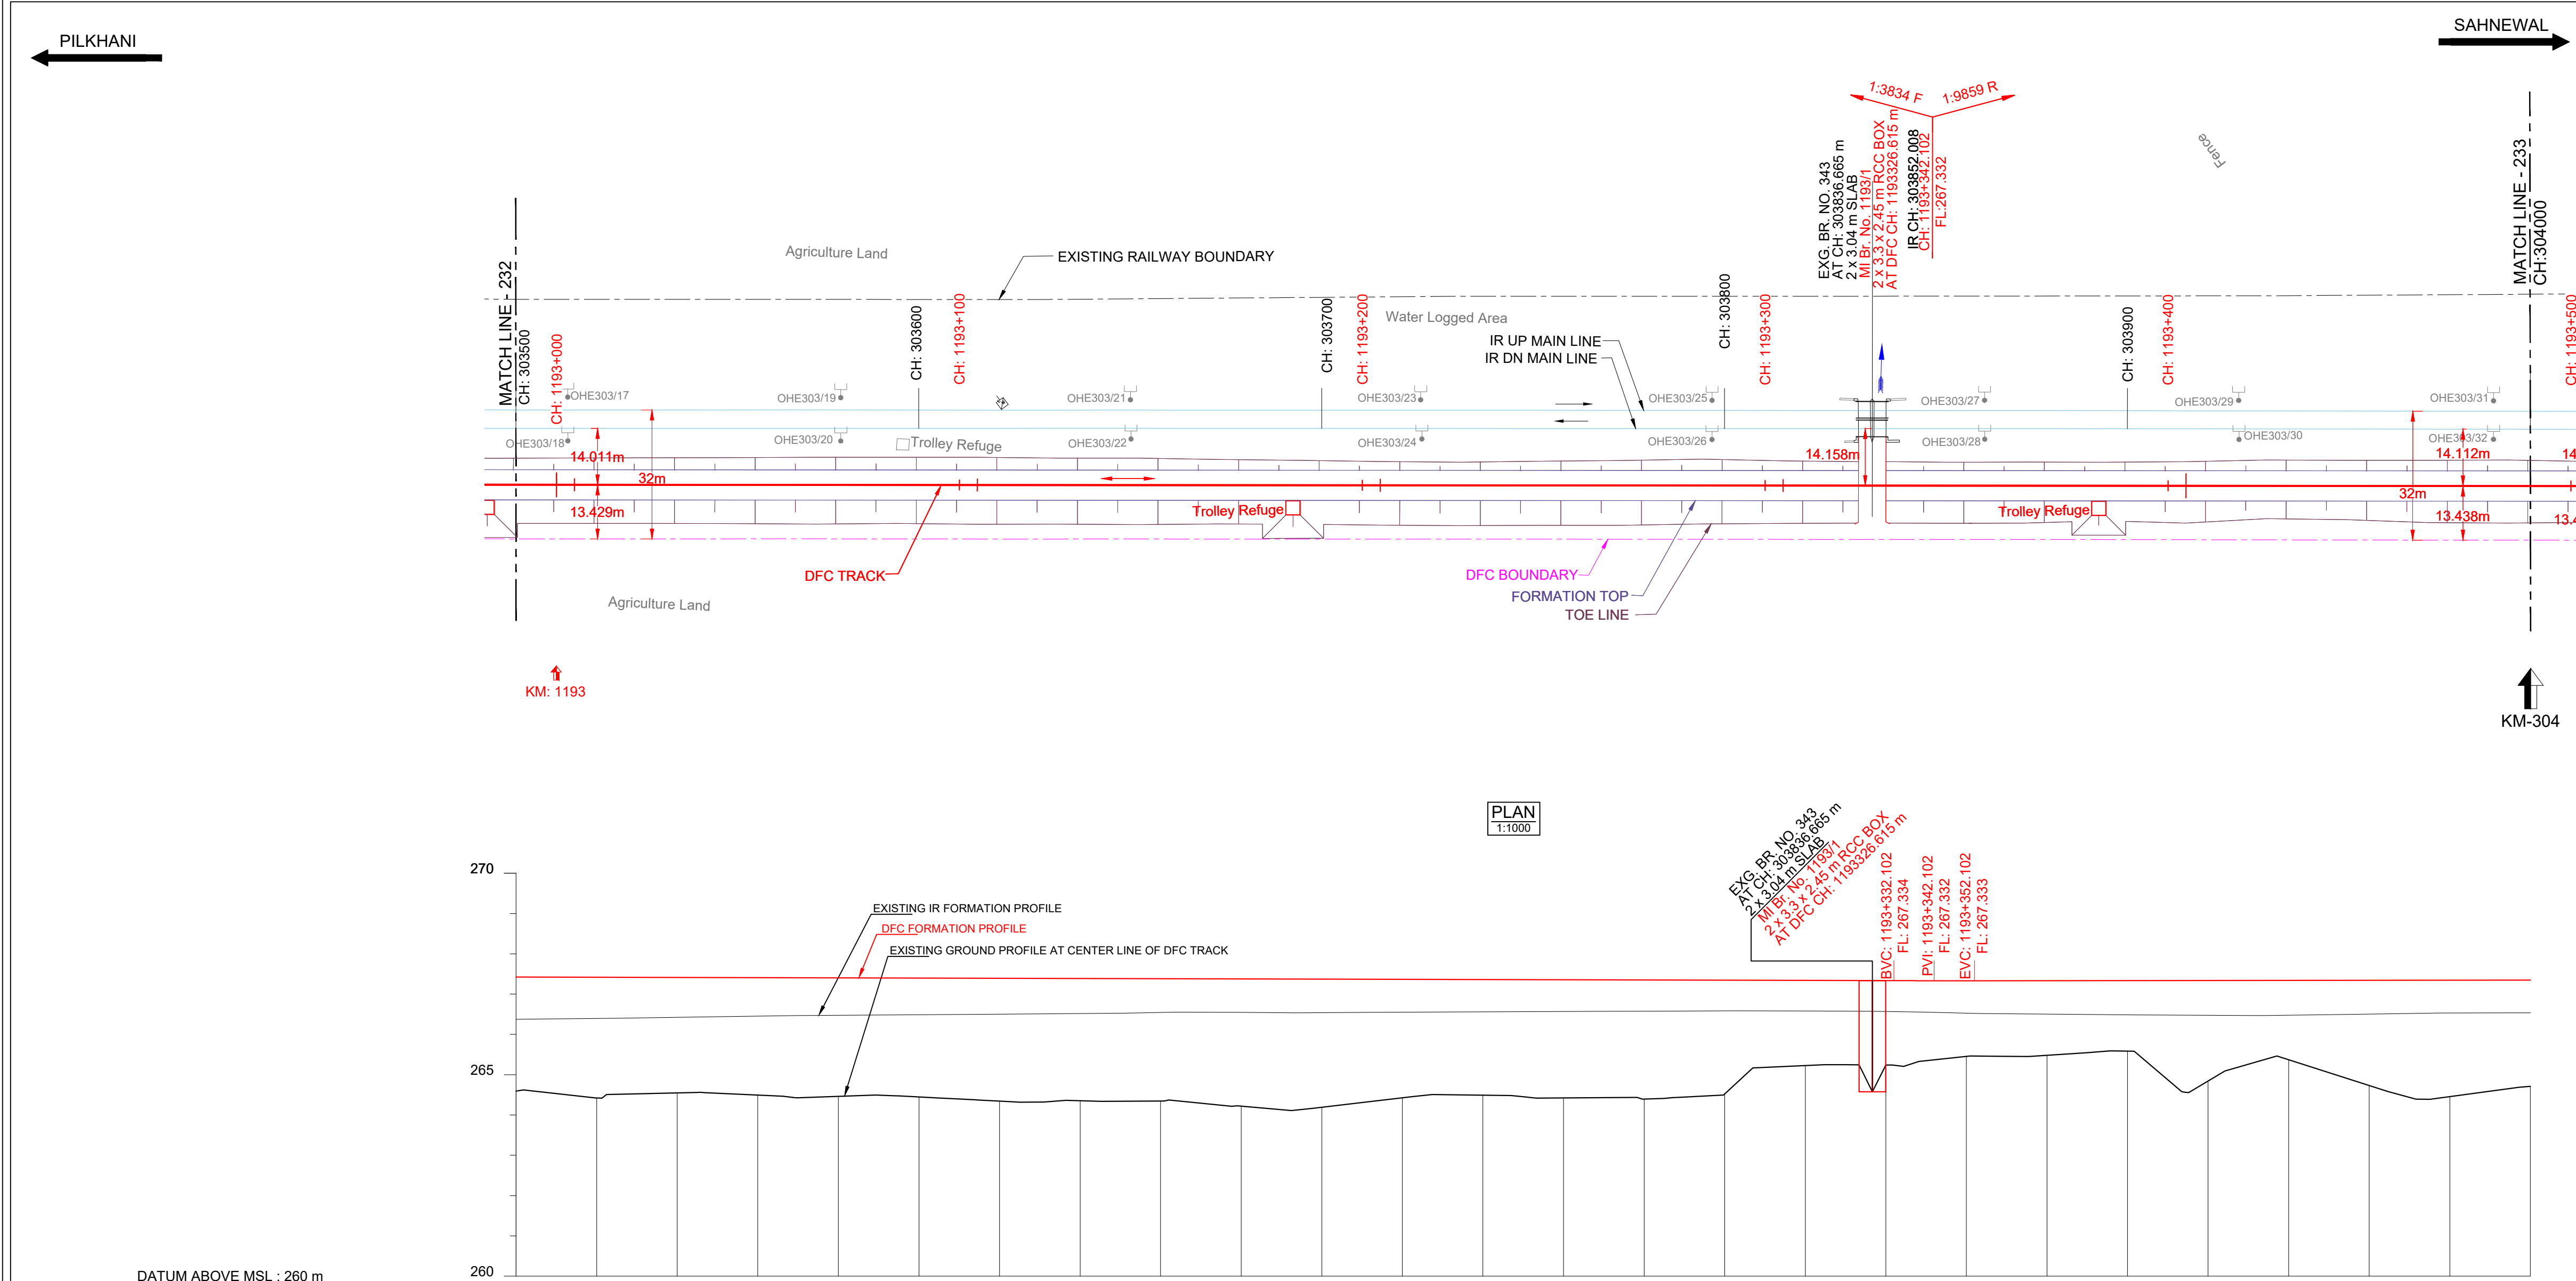

HORIZONTAL ALIGNMENT	L=3511.712m																			
VERTICAL ALIGNMENT	L=1820.969 m 1 IN 3834.074 F																			
TRACK DISTANCE FROM EXISTING NEAREST IR DN MAIN LINE TO DFC MAIN LINE	13.989	13.989	13.989	13.989	13.989	13.989	13.989	13.989	13.989	13.989	13.989	13.989	13.989	13.989	13.989	13.989	13.989	13.989	13.989	13.989
HEIGHT OF BANKING(+) / DEPTH OF CUTTING(-) (PFL-GL)	+2.831	+2.831	+2.831	+2.831	+2.831	+2.831	+2.831	+2.831	+2.831	+2.831	+2.831	+2.831	+2.831	+2.831	+2.831	+2.831	+2.831	+2.831	+2.831	+2.831
EXG GROUND LEVEL AT CENTER LINE OF DFC TRACK (GL)	264.593	264.593	264.593	264.593	264.593	264.593	264.593	264.593	264.593	264.593	264.593	264.593	264.593	264.593	264.593	264.593	264.593	264.593	264.593	264.593
EXG GROUND LEVEL AT TOE LOCATION OF DFC TRACK	264.449	264.449	264.449	264.449	264.449	264.449	264.449	264.449	264.449	264.449	264.449	264.449	264.449	264.449	264.449	264.449	264.449	264.449	264.449	264.449
DIFFERENCE BETWEEN DFC FORMATION LEVEL AND EXG.FORMATION LEVEL (PFL-EFL)	1.049	1.049	1.049	1.049	1.049	1.049	1.049	1.049	1.049	1.049	1.049	1.049	1.049	1.049	1.049	1.049	1.049	1.049	1.049	1.049
DFC FORMATION LEVEL (PFL)	267.424	267.424	267.424	267.424	267.424	267.424	267.424	267.424	267.424	267.424	267.424	267.424	267.424	267.424	267.424	267.424	267.424	267.424	267.424	267.424
EXG. FORMATION LEVEL OF EXG IR DN MAIN LINE (EFL)	266.375	266.375	266.375	266.375	266.375	266.375	266.375	266.375	266.375	266.375	266.375	266.375	266.375	266.375	266.375	266.375	266.375	266.375	266.375	266.375
DIFFERENCE BETWEEN DFC RAIL LEVEL AND EXG. RAIL LEVEL (PRL - ERL)	1.089	1.089	1.089	1.089	1.089	1.089	1.089	1.089	1.089	1.089	1.089	1.089	1.089	1.089	1.089	1.089	1.089	1.089	1.089	1.089
DFC RAIL LEVEL (PRL)	268.137	268.137	268.137	268.137	268.137	268.137	268.137	268.137	268.137	268.137	268.137	268.137	268.137	268.137	268.137	268.137	268.137	268.137	268.137	268.137
EXG.RAIL LEVEL OF NEAREST IR DN MAIN LINE(ERL)	267.047	267.047	267.047	267.047	267.047	267.047	267.047	267.047	267.047	267.047	267.047	267.047	267.047	267.047	267.047	267.047	267.047	267.047	267.047	267.047
EQUIVALENT CHAINAGE ON DFC TRACK	1192990.0	1193010.0	1193030.0	1193050.0	1193070.0	1193090.0	1193110.0	1193130.0	1193150.0	1193170.0	1193190.0	1193210.0	1193230.0	1193250.0	1193270.0	1193290.0	1193310.0	1193330.0	1193350.0	1193370.0
EXISTING IR CHAINAGE	303500.0	303520.0	303540.0	303560.0	303580.0	303600.0	303620.0	303640.0	303660.0	303680.0	303700.0	303720.0	303740.0	303760.0	303780.0	303800.0	303820.0	303840.0	303860.0	303880.0

L - SECTION

DRG NO. - 301-2/AL/A/1233

NOTE:-

1. DFC WORKS ARE SHOWN IN RED.

2. IR NEW WORKS ARE SHOWN IN VIOLET.

3. ALL DIMENSIONS ARE SHOWN IN METRES.

4. THIS DRAWING IS PREPARED BASED ON LATEST SURVEY DATA HELD ON APRIL-2022. GTS BENCH MARK OF 261.850M CONSIDERED ON TOP OF CANAL BRIDGE ABUTMENT AT DORAH VILLAGE ALONG THE NH1.

5. DFC NEW CHAINAGE OF 1075.950M IS WITH REFERENCE TO THE IR KM OF 187.500KM END OF KM OF CP-303(SECTION P-3 PILKHANI END) AGAINST THE EXISTING DFC CHAINAGE. 116277.742M ISSUED VIDE LETTER NO. COM/DFCC/UMS/SURVEY/2021-301-230116-011173 DT. 17.01.2023.

6. BALLAST PROFILE HAS BEEN PROVIDED ACCORDING TO THE CLAUSE 1.11.3 OF STANDARD SCHEDULE OF DIMENSION(EASTERN CORRIDOR) & THE BALLAST CUSHION DIMENSION SHOWN IN 35CM ON GE-14 PARA 17. SPECIFICATIONS & RECOMMENDATIONS 2. TWO LAYER SYSTEM FIG.10.

REFERENCE DRAWINGS :-

1. FOR KEY PLAN REFER DRAWING NO. 301-2/AL/0001

2. FOR LEGEND AND ABBREVIATIONS REFER DRAWING NO. 301-2/AL/1000

3. FOR TYPICAL SECTION OF BALLAST PROFILE (FL-RL) REFER DRG. NO. 301-2/TK/TFD/004 (TR.1952)

07.09.2024

SUBMISSION OF AS-BUILT DRAWING

FOR APPROVAL

REV.

DATE

REVISION DETAILS

PURPOSE OF ISSUE

SCALE

HOR - 1:1000

VER - 1:100

SHEET SIZE : A1

LEGEND:

IR TRACK

DFCC TRACK

DFCC FUTURE PROPOSALS

STRUCTURE / BUILDING

DFCC TOE LINE

DFCC FORMATION

RETAINING WALL

ROAD

STREAM, DRAIN, NALA, CANAL.

FENCE

POWER LINES

TBM

ELECTRIC POLE/OHE MAST

IR RAILWAY BOUNDARY

DFCC BOUNDARY

TYPICAL SECTION

TRACK STRUCTURE

RAIL SECTION: 60Kg/m (UIC 60Kg/m)

DFC LINE: 60Kg/m (UIC 60Kg/m)

IR MAIN LINE: 52Kg/m

Difference between FL- RL (Below Rail Seat)

IR Line

DFC

172mm

172mm

6mm

10mm

210mm

210mm

300mm

350mm

Total Depth (FL TO RL)

688mm

742mm

OWNER

DEDICATED FREIGHT CORRIDOR CORPORATION OF INDIA LTD.

(A GOVERNMENT OF INDIA ENTERPRISE)

PROJECT OFFICE(AMBALA UNIT): OLD RAILWAY COLONY (NEAR ANAND MARKET),AMBALA CANTT-133001.

CORPORATE IDENTITY NO. : U60232DL2006GGI155068

ENGINEER:

DB Engineering & Consulting GmbH

Deutsche Bahn Engineering & Consulting GmbH

CONTRACTOR:

GIL - TPL JV

GAR

TATA

SUBMITTED BY

GIL - TPL JV

DATED

NAME

SIGNATURE

PREPARED BY

CHECKED BY

07.09.2024

VIJAY PRATAP

APPROVED BY

07.09.2024

PARASURAM KOTYADA

APPROVED BY

DEUTSCHE BAHN ENGINEERING & CONSULTING GMBH

DATED

NAME

SIGNATURE

Sr. DE./CHIEF ENGINEER

SURESH K.YALANGI

CHIEF TRACK ENGINEER

RAJ PAL SINGH

T.L.

H.D. VIDJAK

STAMP

A

AS-BUILT DRAWING

TR. Ref.....

ENGINEER Sign.:

EMPLOYER (DFCCIL):

DEDICATED FREIGHT CORRIDOR CORPORATION OF INDIA LTD.

AS BUILT DRAWING

TITLE

AS-BUILT PLAN AND PROFILE

DFCC APPR. NO. -

ENGG. APPR. NO. -

DRG. NO. - 301-2/AL/A/1233

SHEET NO. : 1 OF 1

DATE : 07.09.2024

STATUS

A

FROM IR KM: 303.500 TO 304.000

DFC KM: 1192.990 TO 1193.490

TR.