
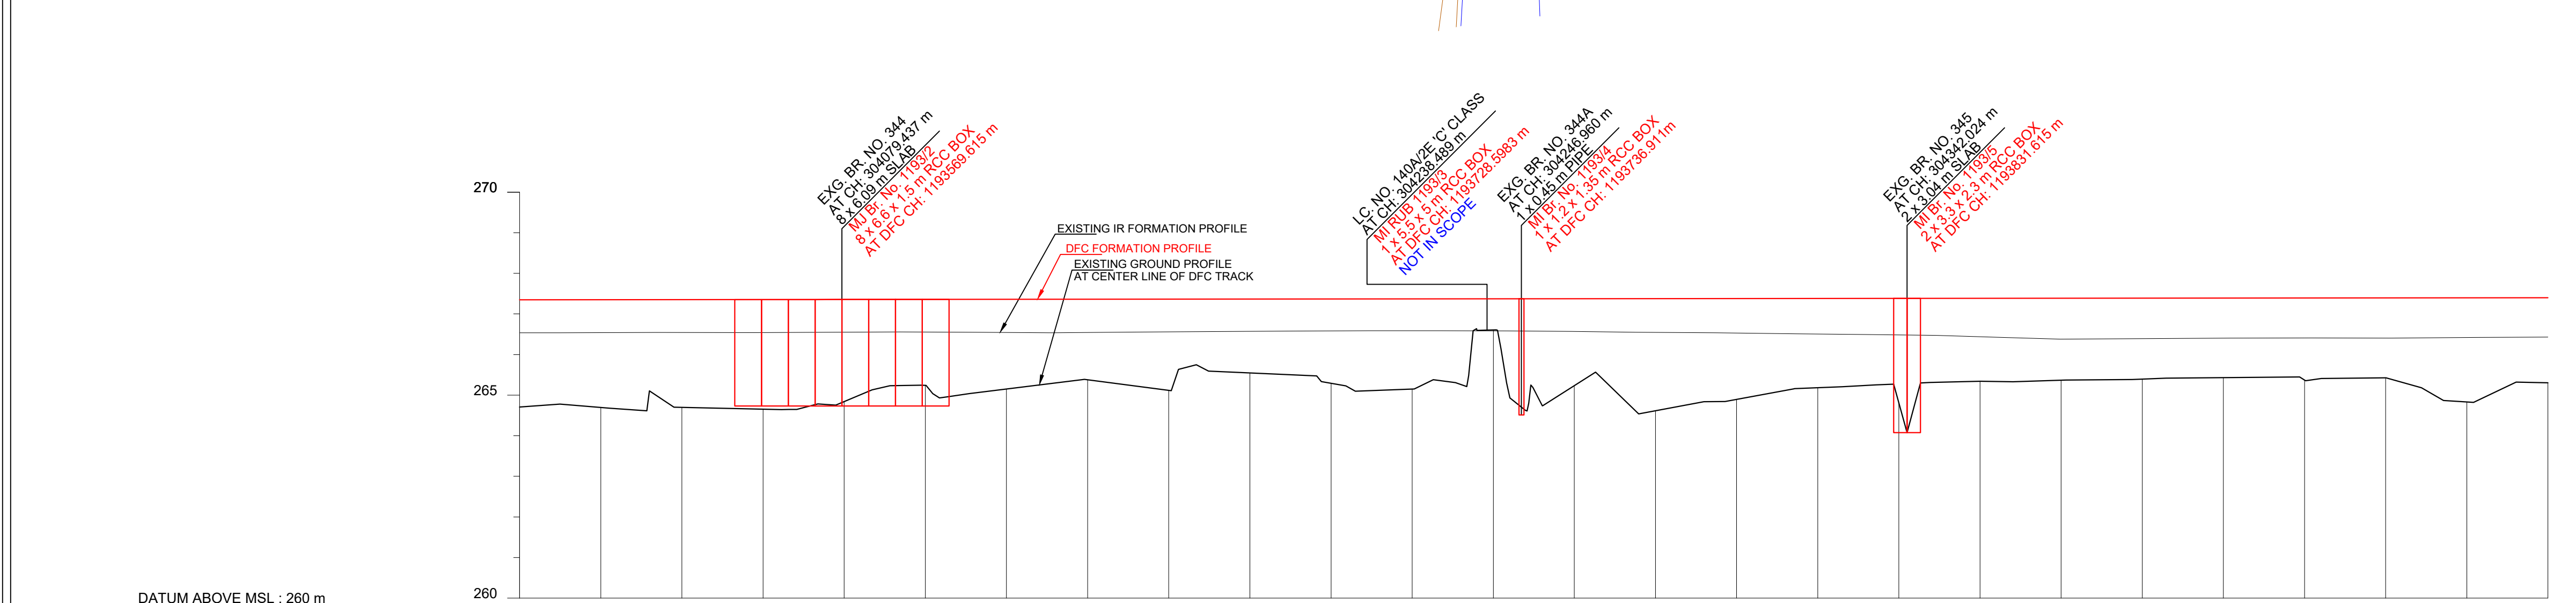


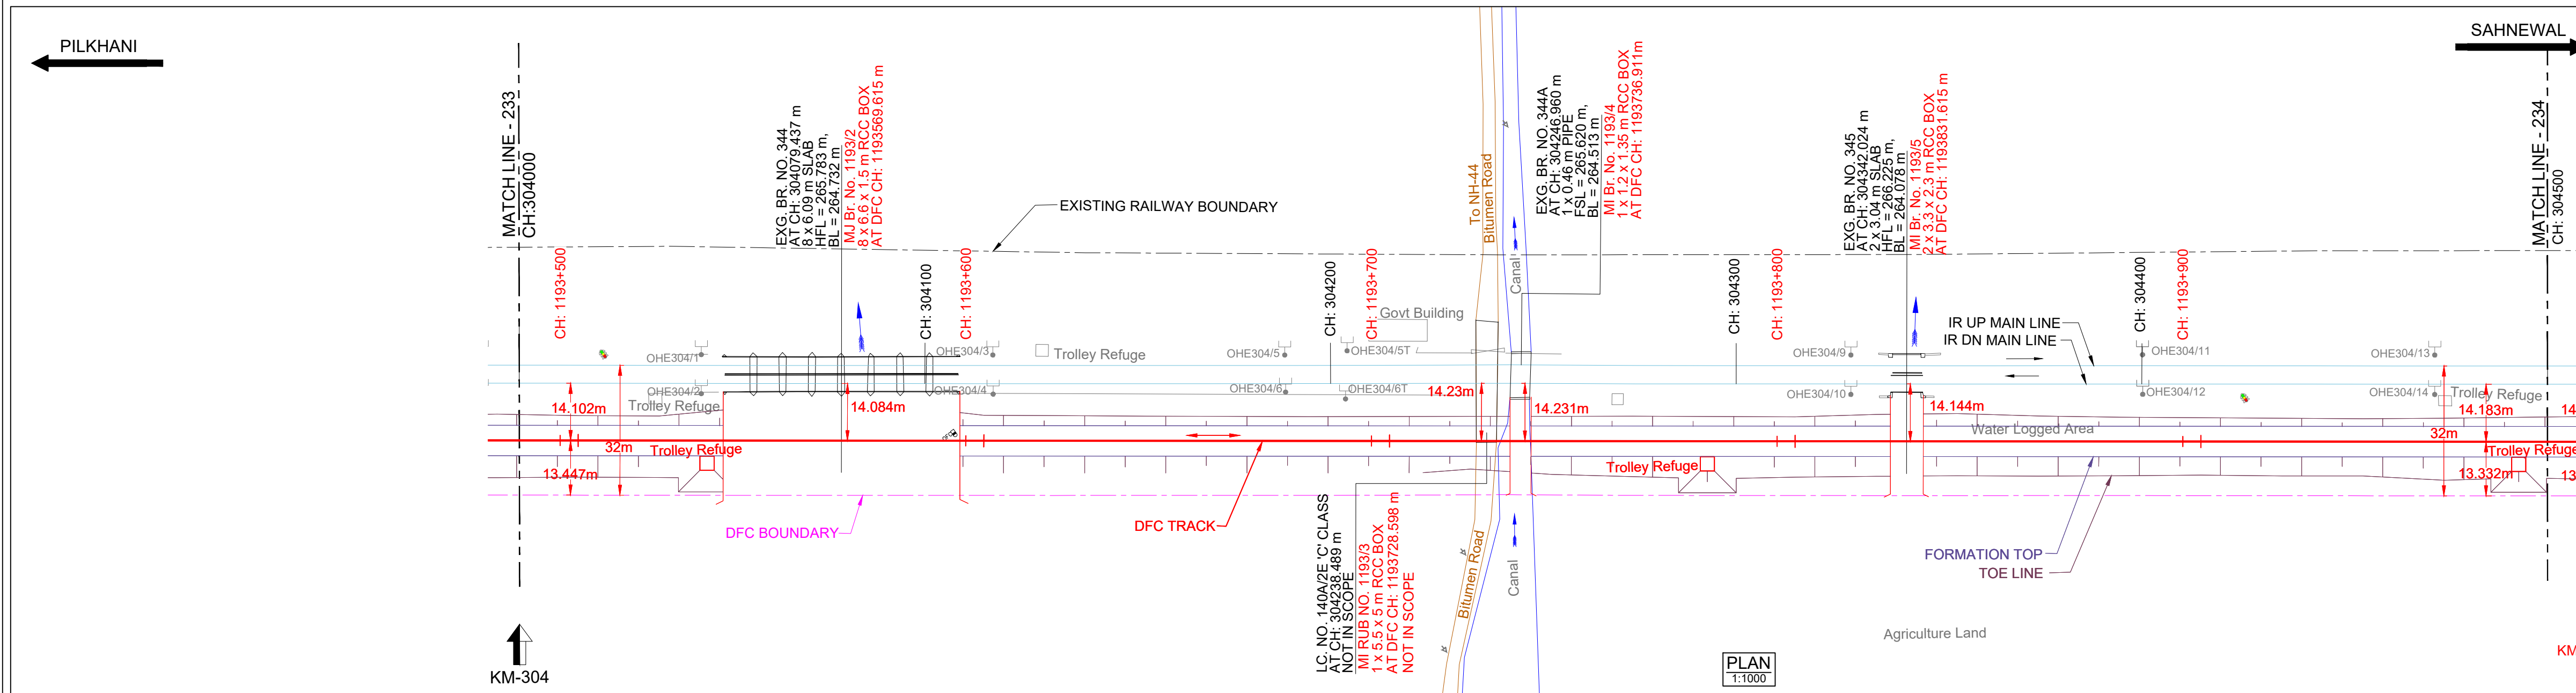

DATUM ABOVE MSL : 260 m

HORIZONTAL ALIGNMENT	L=3511.712m																			
VERTICAL ALIGNMENT	L=1628.0 m 1 IN 9858.854R																			
TRACK DISTANCE FROM EXISTING NEAREST IR DN MAIN LINE TO DFC MAIN LINE	14.106	14.638	14.099	14.091	14.084	14.084	14.081	14.069	14.069	14.083	14.110	14.149	14.190	14.189	14.141	14.141	14.142	14.143	14.152	14.165
HEIGHT OF BANKING(+) / DEPTH OF CUTTING(-) (PFL-GL)	+2.638	+2.653	+2.652	+2.652	+2.652	+2.652	+2.652	+2.652	+2.652	+2.652	+2.652	+2.652	+2.652	+2.652	+2.652	+2.652	+2.652	+2.652	+2.652	+2.652
EXG GROUND LEVEL AT CENTER LINE OF DFC TRACK (GL)	264.709	264.696	264.696	264.699	264.653	264.841	265.242	265.152	265.380	265.117	265.545	265.291	265.150	265.233	265.163	265.183	265.343	265.367	265.431	265.426
EXG GROUND LEVEL AT TOE LOCATION OF DFC TRACK	264.592	264.642	264.642	264.604	264.652	264.851	264.887	264.620	264.677	264.741	265.089	265.016	265.172	265.019	264.753	264.624	264.953	264.939	265.032	264.825
DIFFERENCE BETWEEN DFC FORMATION LEVEL AND EXG.FORMATION LEVEL.(PFL-EFL)	0.810	0.809	0.807	0.807	0.811	0.803	0.802	0.817	0.818	0.805	0.793	0.784	0.781	0.806	0.830	0.848	0.945	1.005	0.995	0.988
DFC FORMATION LEVEL (PFL)	267.347	267.349	267.349	267.351	267.353	267.355	267.357	267.359	267.361	267.363	267.365	267.367	267.369	267.373	267.375	267.377	267.383	267.385	267.387	267.394
EXG. FORMATION LEVEL OF EXG IR DN MAIN LINE (EFL)	266.537	266.540	266.544	266.544	266.542	266.552	266.555	266.542	266.543	266.558	266.572	266.583	266.588	266.567	266.545	266.529	266.505	266.380	266.403	266.406
DIFFERENCE BETWEEN DFC RAIL LEVEL AND EXG. RAIL LEVEL (PRL - ERL)	0.851	0.850	0.848	0.848	0.852	0.845	0.843	0.858	0.859	0.846	0.835	0.825	0.823	0.848	0.871	0.890	0.916	1.047	1.027	1.029
DFC RAIL LEVEL (PRL)	268.060	268.062	268.064	268.064	268.066	268.068	268.070	268.072	268.074	268.076	268.078	268.080	268.082	268.086	268.088	268.090	268.092	268.099	268.103	268.107
EXG.RAIL LEVEL OF NEAREST IR DN MAIN LINE(ERL)	267.209	267.212	267.216	267.214	267.214	267.224	267.227	267.214	267.215	267.230	267.244	267.255	267.260	267.239	267.217	267.201	267.177	267.062	267.075	267.078
EQUIVALENT CHAINAGE ON DFC TRACK	1193490.1	1193510.1	1193530.1	1193550.1	1193570.1	1193590.1	1193610.1	1193630.1	1193650.1	1193670.1	1193690.1	1193710.1	1193730.1	1193750.1	1193770.1	1193790.1	1193810.1	1193830.1	1193850.1	1193870.1
EXISTING IR CHAINAGE	304000.0	304020.0	304040.0	304060.0	304080.0	304100.0	304120.0	304140.0	304160.0	304180.0	304200.0	304220.0	304240.0	304260.0	304280.0	304300.0	304320.0	304340.0	304360.0	304380.0

L - SECTION

NOTE:-

- DFCC WORKS ARE SHOWN IN RED.
- IR NEW WORKS ARE SHOWN IN VIOLET.
- ALL DIMENSIONS ARE SHOWN IN METRES.
- THIS DRAWING IS PREPARED BASED ON LATEST SURVEY DATA HELD ON APRIL-2022. GTS BENCH MARK OF 261.850M CONSIDERED ON TOP OF CANAL BRIDGE ABUTMENT AT DORAHA VILLAGE ALONG THE NH1.
- DFC NEW CHAINAGE OF 1075.950M IS WITH REFERENCE TO THE IR KM OF 187.500KM END OF KM OF CP-303(SECTION P-3 PILKHANI END) AGAINST THE EXISTING DFC CHAINAGE. 116277.742M ISSUED VIDE LETTER NO. COM/DFCC/UM/SURVEY/2021-301-230116-011173 DT. 17.01.2023.
- BALLAST PROFILE HAS BEEN PROVIDED ACCORDING TO THE CLAUSE 1.11.3 OF STANDARD SCHEDULE OF DIMENSION(EASTERN CORRIDOR) & THE BALLAST CUSHION DIMENSION SHOWN IN 35CM ON GE-14 PARA 17. SPECIFICATIONS & RECOMMENDATIONS 2. TWO LAYER SYSTEM FIG.10.

REFERENCE DRAWINGS :-

- FOR KEY PLAN REFER DRAWING NO. 301-2/AL/0001
- FOR LEGEND AND ABBREVIATIONS REFER DRAWING NO. 301-2/AL/1000
- FOR TYPICAL SECTION OF BALLAST PROFILE (FL-RL) REFER DRG. NO. 301-2/TK/TFDI-004 (TR.1952)

07.09.2024SUBMISSION OF AS-BUILT DRAWINGFOR APPROVAL

REV. DATE REVISION DETAILS PURPOSE OF ISSUE

SCALE
HOR - 1:1000
VER - 1:100
SHEET SIZE : A1

LEGEND:
IR TRACK
DFCC TRACK
DFCC FUTURE PROPOSALS
STRUCTURE / BUILDING
DFCC TOE LINE
DFCC FORMATION
RETAINING WALL
ROAD
STREAM, DRAIN, NALA, CANAL.
FENCE
POWER LINES
TBM
ELECTRIC POLE/OHE MAST
IR RAILWAY BOUNDARY
DFCC BOUNDARY

TRACK STRUCTURE

RAIL SECTION: 60Kg/m (UIC 60Kg/m) DFC LINE: 60Kg/m (UIC 60Kg/m) IR MAIN LINE: 52Kg/m	Difference between FL- RL (Below Rail Seat)	
	IR Line	DFC
RUBBER PAD	172mm	172mm
SLEEPER DEPTH	6mm	10mm
BALLAST CUSHION	210mm	210mm
	300mm	350mm
Total Depth (FL TO RL)	688mm	742mm

OWNER
DEDICATED FREIGHT CORRIDOR CORPORATION OF INDIA LTD.
(A GOVERNMENT OF INDIA ENTERPRISE)
PROJECT OFFICE(AMBALA UNIT): OLD RAILWAY COLONY (NEAR ANAND MARKET),AMBALA CANTT-133001.
CORPORATE IDENTITY NO. : U60232DL20060G01155068

ENGINEER:
DB Engineering & Consulting GmbH
Deutsche Bahn Engineering & Consulting GmbH

CONTRACTOR:
GIL - TPL JV
GAR TATA

SUBMITTED BY	GIL - TPL JV		
	DATED	NAME	SIGNATURE
PREPARED BY			
CHECKED BY	07.09.2024	VIJAY PRATAP	
APPROVED BY	07.09.2024	PARASURAM KOTYADA	
APPROVED BY	DEUTSCHE BAHN ENGINEERING & CONSULTING GMBH		
	DATED	NAME	SIGNATURE
Sr. DE./CHIEF ENGINEER		SURESH K.YALANGI	
CHIEF TRACK ENGINEER		RAJ PAL SINGH	
T.L.		H.D. VIDJAK	

STAMP
A AS-BUILT DRAWING
TR. Ref.:.....
ENGINEER Sign.:.....

EMPLOYER (DFCCIL): DEDICATED FREIGHT CORRIDOR CORPORATION OF INDIA LTD.

AS BUILT DRAWING

TITLE
AS-BUILT PLAN AND PROFILE

DFCC APPR. NO. -
ENGG. APPR. NO. -
DRG. NO. - 301-2/AL/A/1234
SHEET NO. : 1 OF 1
DATE : 07.09.2024

STATUS
A

FROM IR KM: 304.000 TO 304.500
DFC KM: 1193.490 TO 1193.990

TR.