
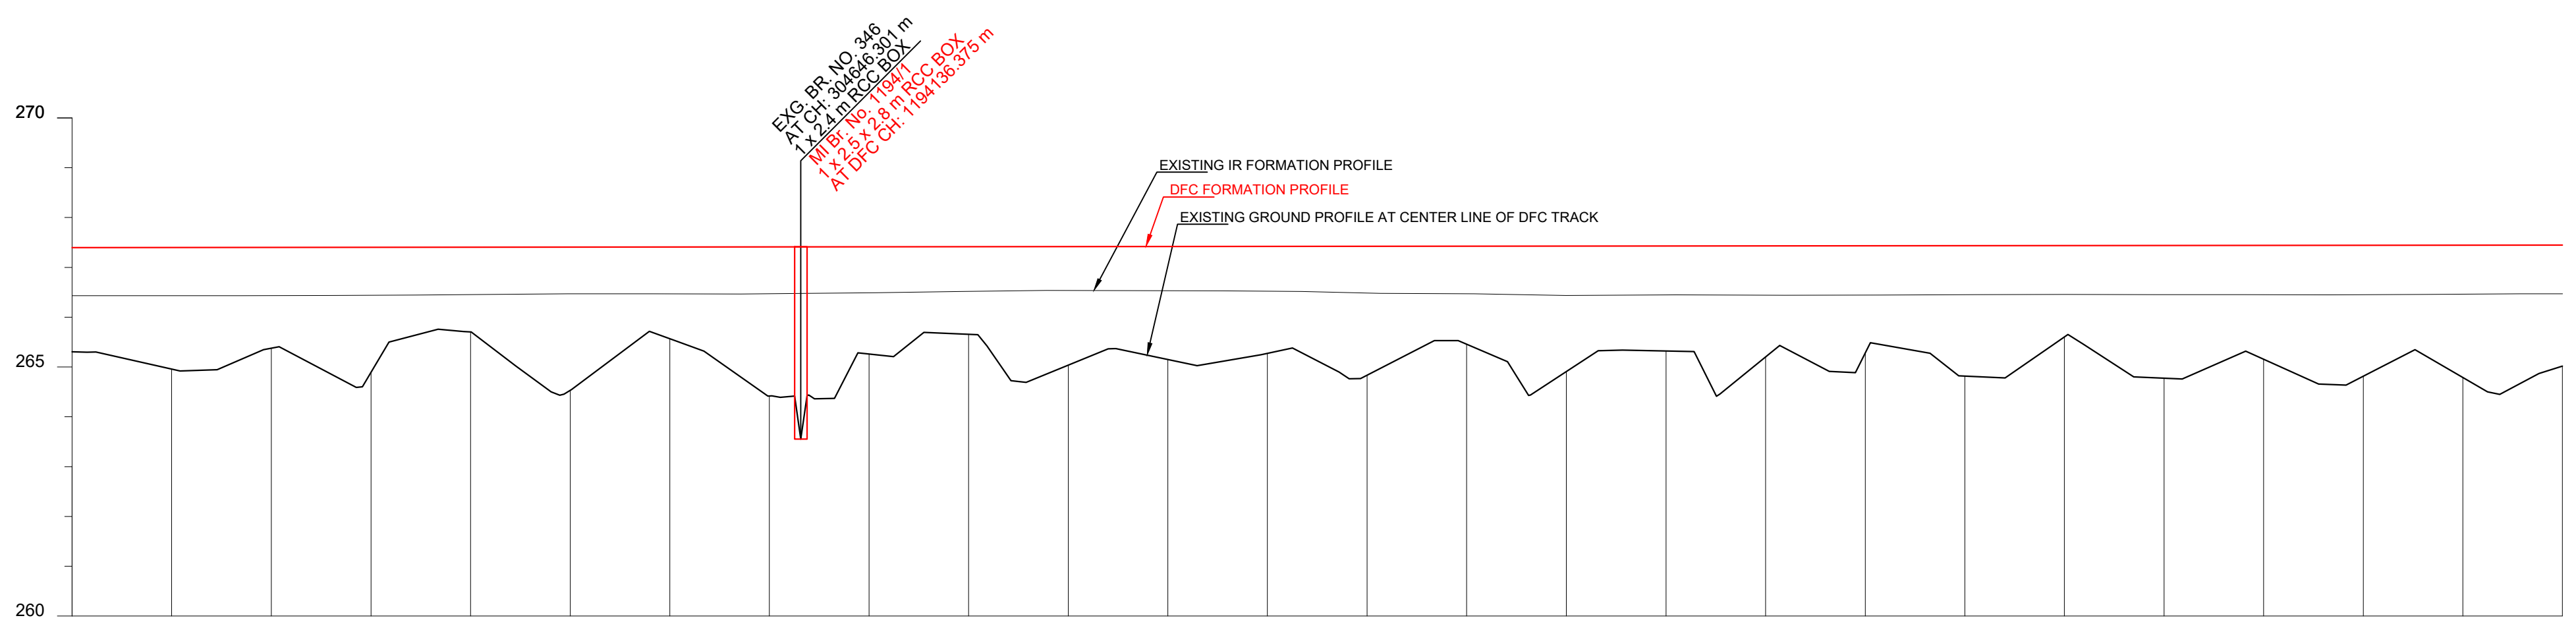


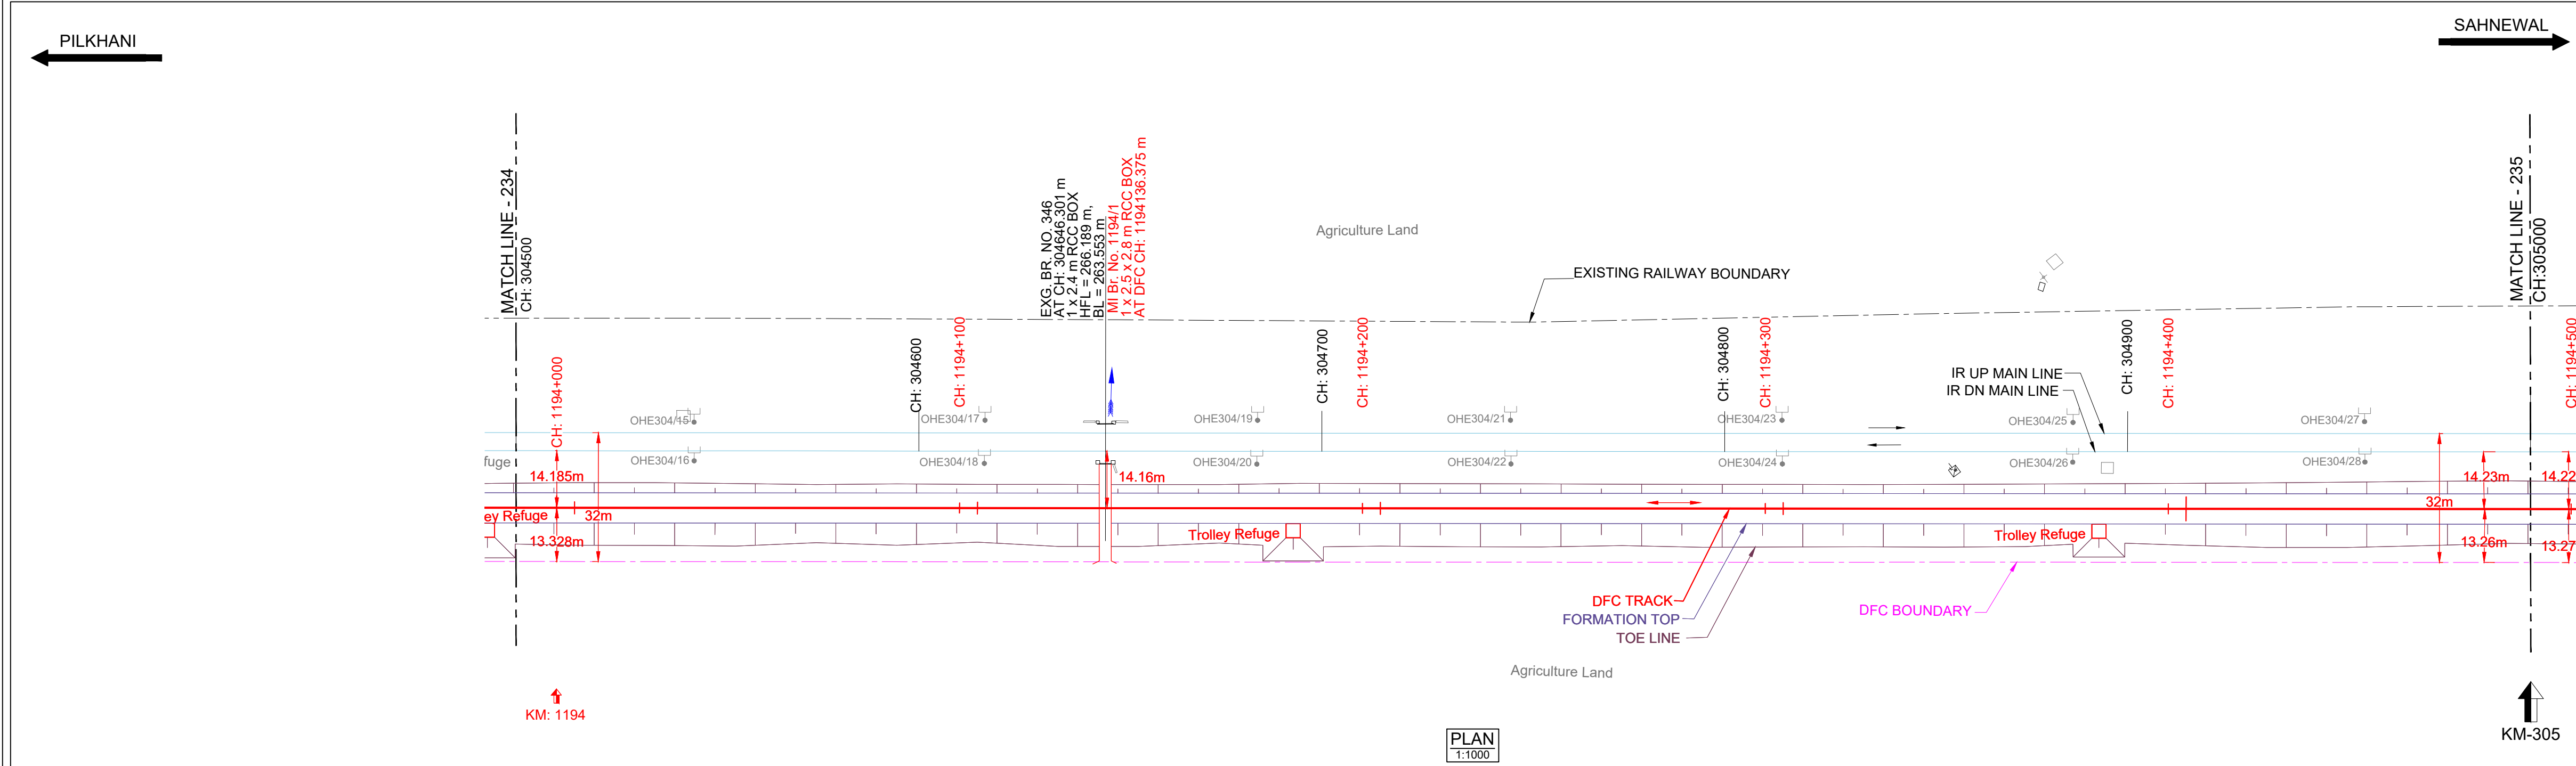

HORIZONTAL ALIGNMENT	L=3511.712m																			
VERTICAL ALIGNMENT	L=1628.0 m 1 IN 9858.554R																			
TRACK DISTANCE FROM EXISTING NEAREST IR DN MAIN LINE TO DFC MAIN LINE	14.193																			
HEIGHT OF BANKING(+) / DEPTH OF CUTTING(-) (PFL-GL)	+2.093																			
EXG GROUND LEVEL AT CENTER LINE OF DFC TRACK (GL)	265.305	265.305	264.959	264.959	264.959	264.959	264.959	264.959	264.959	264.959	264.959	264.959	264.959	264.959	264.959	264.959	264.959	264.959	264.959	264.959
EXG GROUND LEVEL AT TOE LOCATION OF DFC TRACK	264.704	264.704	264.559	264.559	264.559	264.559	264.559	264.559	264.559	264.559	264.559	264.559	264.559	264.559	264.559	264.559	264.559	264.559	264.559	264.559
DIFFERENCE BETWEEN DFC FORMATION LEVEL AND EXG.FORMATION LEVEL (PFL-EFL)	0.968	0.968	0.967	0.967	0.967	0.967	0.967	0.967	0.967	0.967	0.967	0.967	0.967	0.967	0.967	0.967	0.967	0.967	0.967	0.967
DFC FORMATION LEVEL (PFL)	267.398	267.398	267.400	267.400	267.400	267.400	267.400	267.400	267.400	267.400	267.400	267.400	267.400	267.400	267.400	267.400	267.400	267.400	267.400	267.400
EXG. FORMATION LEVEL OF EXG IR DN MAIN LINE (EFL)	266.430	266.430	266.433	266.433	266.433	266.433	266.433	266.433	266.433	266.433	266.433	266.433	266.433	266.433	266.433	266.433	266.433	266.433	266.433	266.433
DIFFERENCE BETWEEN DFC RAIL LEVEL AND EXG. RAIL LEVEL (PRL - ERL)	1.008	1.008	1.007	1.007	1.007	1.007	1.007	1.007	1.007	1.007	1.007	1.007	1.007	1.007	1.007	1.007	1.007	1.007	1.007	1.007
DFC RAIL LEVEL (PRL)	268.111	268.111	268.113	268.113	268.113	268.113	268.113	268.113	268.113	268.113	268.113	268.113	268.113	268.113	268.113	268.113	268.113	268.113	268.113	268.113
EXG.RAIL LEVEL OF NEAREST IR DN MAIN LINE(ERL)	267.102	267.102	267.105	267.105	267.105	267.105	267.105	267.105	267.105	267.105	267.105	267.105	267.105	267.105	267.105	267.105	267.105	267.105	267.105	267.105
EQUIVALENT CHAINAGE ON DFC TRACK	1193990.1	1194010.1	1194030.1	1194050.1	1194070.1	1194090.1	1194110.1	1194130.1	1194150.1	1194170.1	1194190.1	1194210.1	1194230.1	1194250.1	1194270.1	1194290.1	1194310.1	1194330.1	1194350.1	1194370.1
EXISTING IR CHAINAGE	304500.0	304520.0	304540.0	304560.0	304580.0	304600.0	304620.0	304640.0	304660.0	304680.0	304700.0	304720.0	304740.0	304760.0	304780.0	304800.0	304820.0	304840.0	304860.0	304880.0

L - SECTION

DRG NO. - 301-2/AL/A/1235

NOTE:-

1. DFC WORKS ARE SHOWN IN RED.

2. IR NEW WORKS ARE SHOWN IN VIOLET.

3. ALL DIMENSIONS ARE SHOWN IN METRES.

4. THIS DRAWING IS PREPARED BASED ON LATEST SURVEY DATA HELD ON APRIL-2022. GTS BENCH MARK OF 261.850M CONSIDERED ON TOP OF CANAL BRIDGE ABUTMENT AT DORAH VILLAGE ALONG THE NH1.

5. DFC NEW CHAINAGE OF 1075.950M IS WITH REFERENCE TO THE IR KM OF 187.500KM END OF KM OF CP-303(SECTION P-3 PILKHANI END) AGAINST THE EXISTING DFC CHAINAGE. 116277.742M ISSUED VIDE LETTER NO. COM/DFCC/UM/SURVEY/2021-301-230116-011173 DT. 17.01.2023.

6. BALLAST PROFILE HAS BEEN PROVIDED ACCORDING TO THE CLAUSE 1.11.3 OF STANDARD SCHEDULE OF DIMENSION(EASTERN CORRIDOR) & THE BALLAST CUSHION DIMENSION SHOWN IN 35CM ON GE-14 PARA 17. SPECIFICATIONS & RECOMMENDATIONS 2. TWO LAYER SYSTEM FIG.10.

REFERENCE DRAWINGS :-

1. FOR KEY PLAN REFER DRAWING NO. 301-2/AL/0001

2. FOR LEGEND AND ABBREVIATIONS REFER DRAWING NO. 301-2/AL/1000

3. FOR TYPICAL SECTION OF BALLAST PROFILE (FL-RL) REFER DRG. NO. 301-2/TK/TFD/004 (TR.1952)

07.09.2024

SUBMISSION OF AS-BUILT DRAWING

FOR APPROVAL

REV.

DATE

REVISION DETAILS

PURPOSE OF ISSUE

SCALE

HOR - 1:1000

VER - 1:100

SHEET SIZE - A1

IR TRACK

DFCC TRACK

DFCC FUTURE PROPOSALS

STRUCTURE / BUILDING

DFCC TOE LINE

DFCC FORMATION

RETAINING WALL

ROAD

STREAM, DRAIN, NALA, CANAL.

FENCE

POWER LINES

TBM

ELECTRIC POLE/OHE MAST

IR RAILWAY BOUNDARY

DFCC BOUNDARY

TYPICAL SECTION

TRACK STRUCTURE

RAIL SECTION: 60Kg/m (UIC 60Kg/m)

DFC LINE: 60Kg/m (UIC 60Kg/m)

IR MAIN LINE: 52Kg/m

DIFFERENCE BETWEEN FL- RL (Below Rail Seat)

IR Line

DFC

RUBBER PAD

SLEEPER DEPTH

BALLAST CUSHION

Total Depth (FL TO RL)

OWNER

DEDICATED FREIGHT CORRIDOR CORPORATION OF INDIA LTD.

(A GOVERNMENT OF INDIA ENTERPRISE)

PROJECT OFFICE(AMBALA UNIT): OLD RAILWAY COLONY (NEAR ANAND MARKET),AMBALA CANTT-133001.

CORPORATE IDENTITY NO. : U60232DL2006GGI155068

ENGINEER:

DB Engineering & Consulting GmbH

Deutsche Bahn Engineering & Consulting GmbH

CONTRACTOR:

GIL - TPL JV

GAR

TATA

SUBMITTED BY

GIL - TPL JV

DATED

NAME

SIGNATURE

PREPARED BY

CHECKED BY

APPROVED BY

APPROVED BY

DEUTSCHE BAHN ENGINEERING & CONSULTING GMBH

DATED

NAME

SIGNATURE

Sr. DE./CHIEF ENGINEER

SURESH K.YALANGI

CHIEF TRACK ENGINEER

RAJ PAL SINGH

T.L.

H.D. VIDJAK

STAMP

A

AS-BUILT DRAWING

TR. Ref.....

ENGINEER Sign.:

EMPLOYER (DFCCIL):

DEDICATED FREIGHT CORRIDOR CORPORATION OF INDIA LTD.

AS BUILT DRAWING

TITLE

AS-BUILT PLAN AND PROFILE

DFCC APPR. NO. -

ENGG. APPR. NO. -

DRG. NO. - 301-2/AL/A/1235

SHEET NO. : 1 OF 1

DATE : 07.09.2024

STATUS

A

FROM IR KM: 304.500 TO 305.000

DFC KM: 1193.990 TO 1194.490

TR.