

NOTE

DRG NO.- 301-2/AL/A/1236

1. DFC WORKS ARE SHOWN IN **RED**.
2. IR NEW WORKS ARE SHOWN IN **VIOLET**.
3. ALL DIMENSIONS ARE SHOWN IN METRES.
4. THIS DRAWING IS PREPARED BASED ON LATEST SURVEY DATA HELD ON APRIL-2022. GTS BENCH MARK OF 261.850M CONSIDERED ON TOP OF CANAL BRIDGE ABUTMENT AT DORAHA VILLAGE ALONG THE CANAL.
5. DFC NEW CHAINAGE OF 179.950M IS WITH REFERENCE TO THE IR KM OF 187.500KM END OF KM OF DFC-303(SECTION 3-PILKHANI END) AGAINST THE EXISTING DFC CHAINAGE 116277.742M ISSUED BY DFC. THE CHAINAGE OF 179.950M IS THE BALL POINT CUSHION MARK AT 17.0% OF 100M CHAINAGE.
6. BALL POINT PROFILE HAS BEEN PROVIDED ACCORDING TO THE CLAUSE 11.1.3 OF STANDARD SCHEDULE OF CONDITIONS (EASTERN ZONE) OF THE BALL POINT CUSHION MARK IN 35CM ON GE-1.
7. ALL THE SPECIFICATIONS ARE AS PER RECOMMENDATIONS 2. TWO LAYER SYSTEM OF ASPHALT.

REFERENCE DRAWINGS :-


1. FOR KEY PLAN REFER DRAWING NO. 301-2/AL/0001
2. FOR LEGEND AND ABBREVIATIONS REFER DRAWING NO. 301-2/AL1000
3. FOR TYPICAL SECTION OF BALLAST PROFILE (FL-RL) REFFER DRG. NO. 301-2/TK/TFD/-004 (TR.1952)

0	07.09.2024	SUBMISSION OF AS-BUILT DRAWING	FOR APPROVAL
REV.	DATE	REVISION DETAILS	PURPOSE OF ISSUE

LEGEND

SCALE

HOR - 1:1000

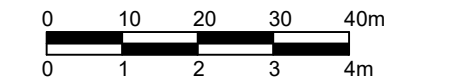


VER - 1:100

SHEET SIZE : A1

_____ SHEET SIZE : A1

IR TRACK
 DFCC TRACK
 DFCC FUTURE PROPOSALS
 STRUCTURE / BUILDING
 DFCC TOE LINE
 DFCC FORMATION
 RETAINING WALL
 ROAD
 STREAM, DRAIN, NALA, CANAL.
 FENCE
 POWER LINES
 TBM
 ELECTRIC POLE/OHE MAST
 IR RAILWAY BOUNDARY
 DFCC BOUNDARY

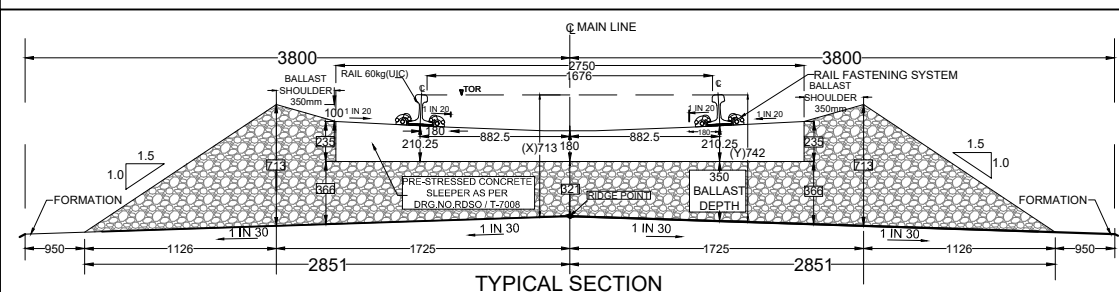

TRACK STRUCTURE		
RAIL SECTION: 60Kg/m (UIC 60Kg/m) DFC LINE: 60Kg/m (UIC 60Kg/m) IR MAIN LINE: 52Kg/m	Difference between FL- RL (Below Rail Seat)	
	IR Line	DFC
	172mm	172mm
RUBBER PAD	6mm	10mm
SLEEPER DEPTH	210mm	210mm
BALLAST CUSHION	300mm	350mm
Total Depth (FL TO RL)	688mm	742mm

OWNER

DEDICATED FREIGHT CORRIDOR CORPORATION OF INDIA LTD.

(A GOVERNMENT OF INDIA ENTERPRISE)
PROJECT OFFICE (AMBALA UNIT), OLD RAILWAY COLONY,

PROJECT OFFICE(AMBALA UNIT): OLD RAILWAY COLONY
ANAND MARKET),AMBALA CANTT-133001.

CORPORATE IDENTITY NO. : U60232DL2006GOI1550

ENGINEER

DB Engineering & Consulting GmbH

Deutsche Bahn Engineering & Consulting GmbH

CONTRACTOR

GIL - TPL JW



SUBMITTED BY	GIL - TPL JV		
	DATED	NAME	SIGNATURE
PREPARED BY			
CHECKED BY	07.09.2024	VIJAY PRATAP	
APPROVED BY	07.09.2024	PARASURAM KOTYADA	
APPROVED BY	DEUTSCHE BAHN ENGINEERING & CONSULTING GMBH		
	DATED	NAME	SIGNATURE
Sr. DE./CHIEF ENGINEER		SURESH K.YALANGI	
CHIEF TRACK ENGINEER		RAJ PAL SINGH	
T.L.		H.D. VIDJAK	

STAMP

A AS-BUILT DRAWING
TR. Ref.....
ENGINEER Sign.:

EMPLOYER (DFCCIL):

DEDICATED FREIGHT CORRIDOR CORPORATION OF INDIA LTD

AS BUILT DRAWING

TITLE

AS-BUILT PLAN AND PROFILE

FROM IR KM: 305 000 TO 305 500

DFC KM: 1194.490 TO 1194.990

DFCC APPR. NO. -


ENGG. APPR. NO.

DRG. NO. - 301-2/

SHEET NO. : 1 OF

STATUS

ED

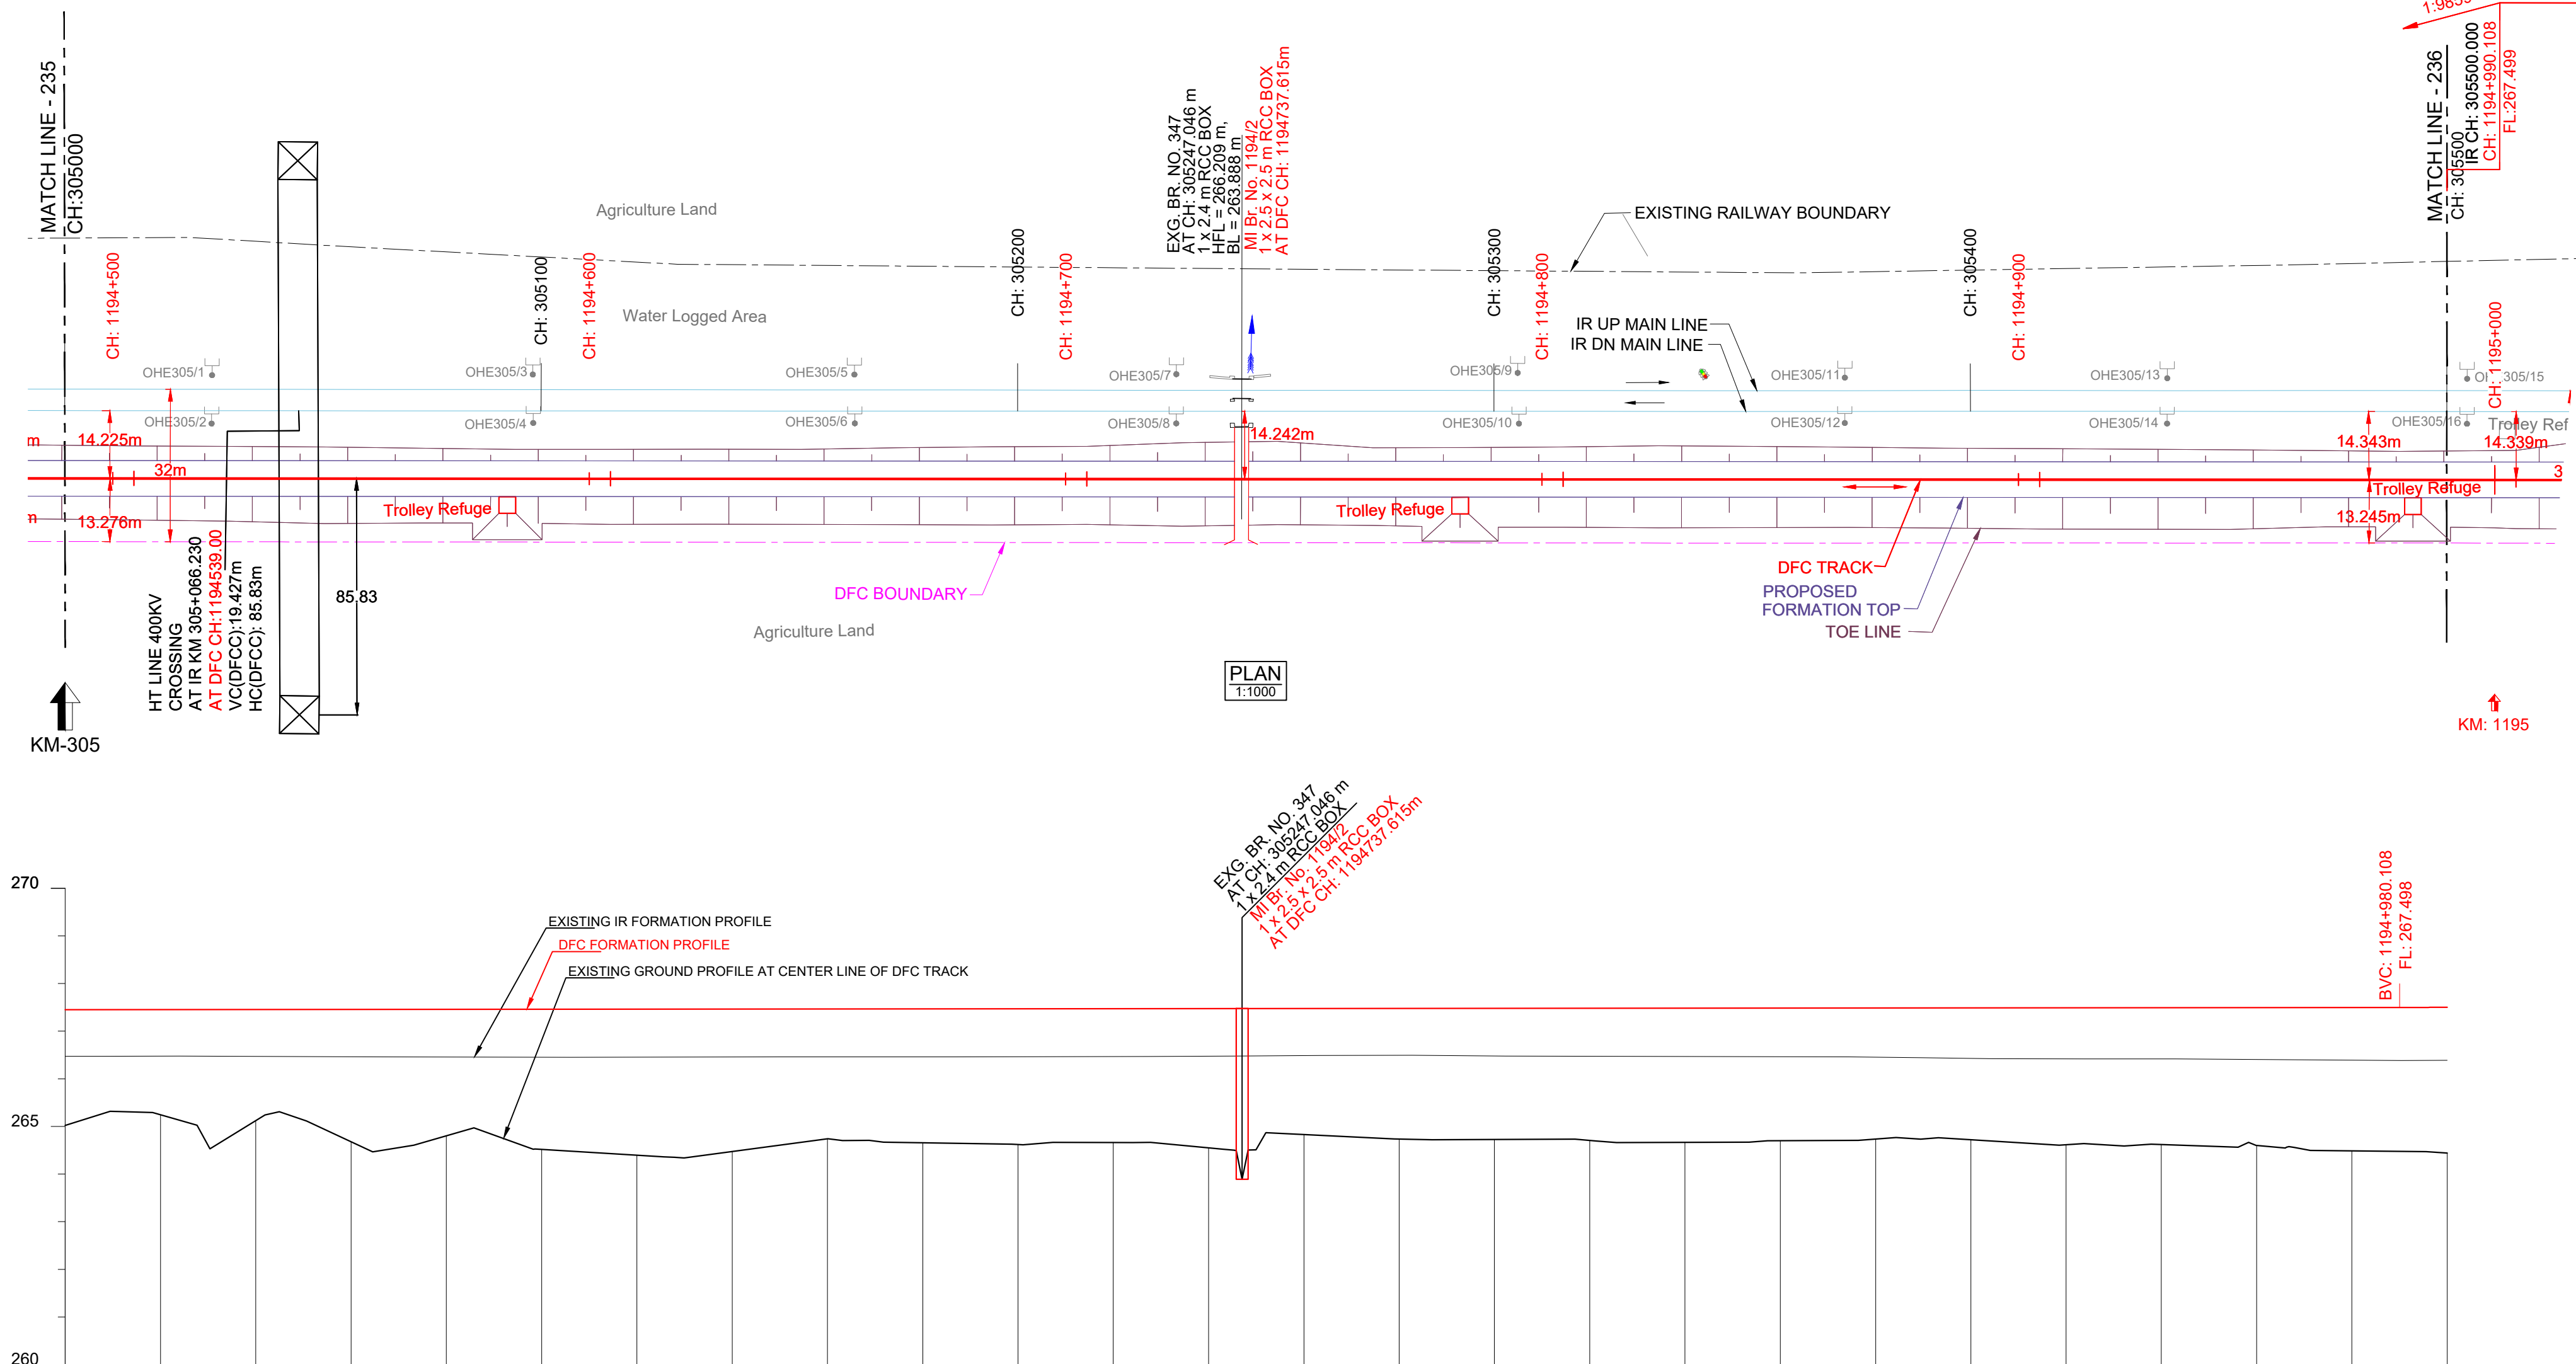

DATUM ABOVE MSL : 260 m

HORIZONTAL ALIGNMENT		L=3511.712m									
VERTICAL ALIGNMENT		L=1628.0 m 1 IN 9858.854R									
TRACK DISTANCE FROM EXISTING NEAREST IR DN MAIN LINE TO DFC MAIN LINE		+2.429	-14.227								
HEIGHT OF BANKING(+) / DEPTH OF CUTTING(-) (PFL-GL)		+2.429	-14.227								
EXG GROUND LEVEL AT CENTER LINE OF DFC TRACK (GL)		264.951	265.019								
EXG GROUND LEVEL AT TOE LOCATION OF DFC TRACK		264.854	265.242								
DIFFERENCE BETWEEN DFC FORMATION LEVEL AND EXG.FORMATION LEVEL (PFL-EFL)		0.978	0.978								
DFC FORMATION LEVEL (PFL)		267.448	267.448								
EXG. FORMATION LEVEL OF EXG IR DN MAIN LINE (EFL)		266.470	267.426								
DIFFERENCE BETWEEN DFC RAIL LEVEL AND EXG. RAIL LEVEL (PRL - ERL)		1.019	1.019								
DFC RAIL LEVEL (PRL)		268.161	268.161								
EXG.RAIL LEVEL OF NEAREST IR DN MAIN LINE(ERL)		267.142	267.142								
EQUIVALENT CHAINAGE ON DFC TRACK		305000.0	305000.0								
EXISTING IR CHAINAGE		305000.0	305000.0								

L - SECTION