
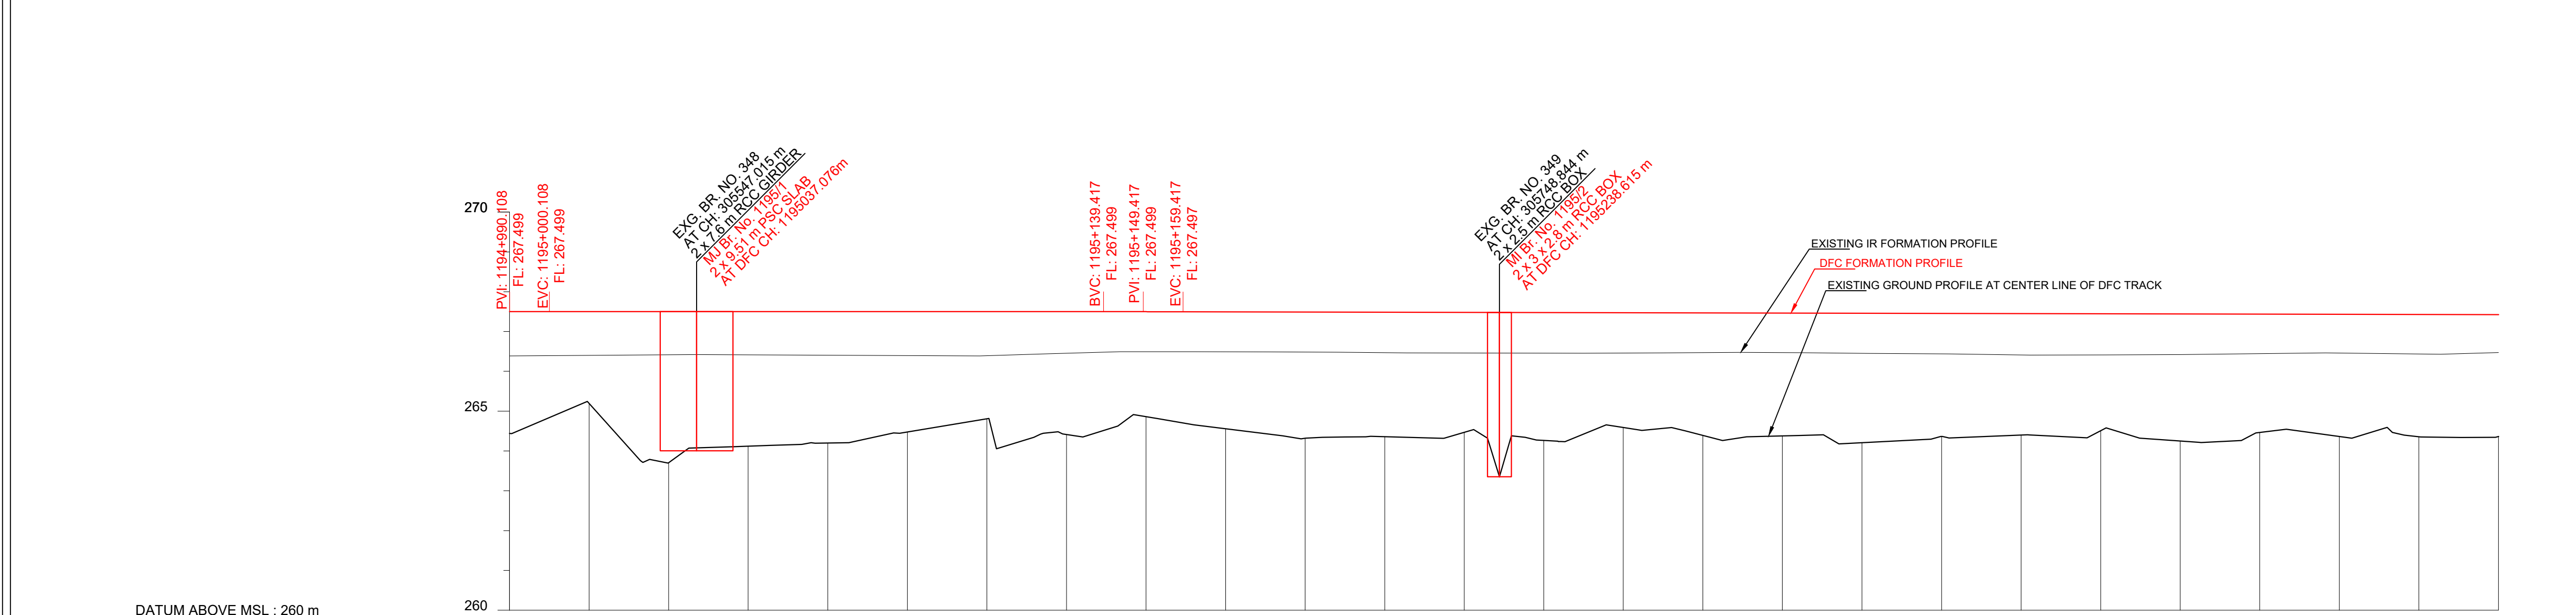


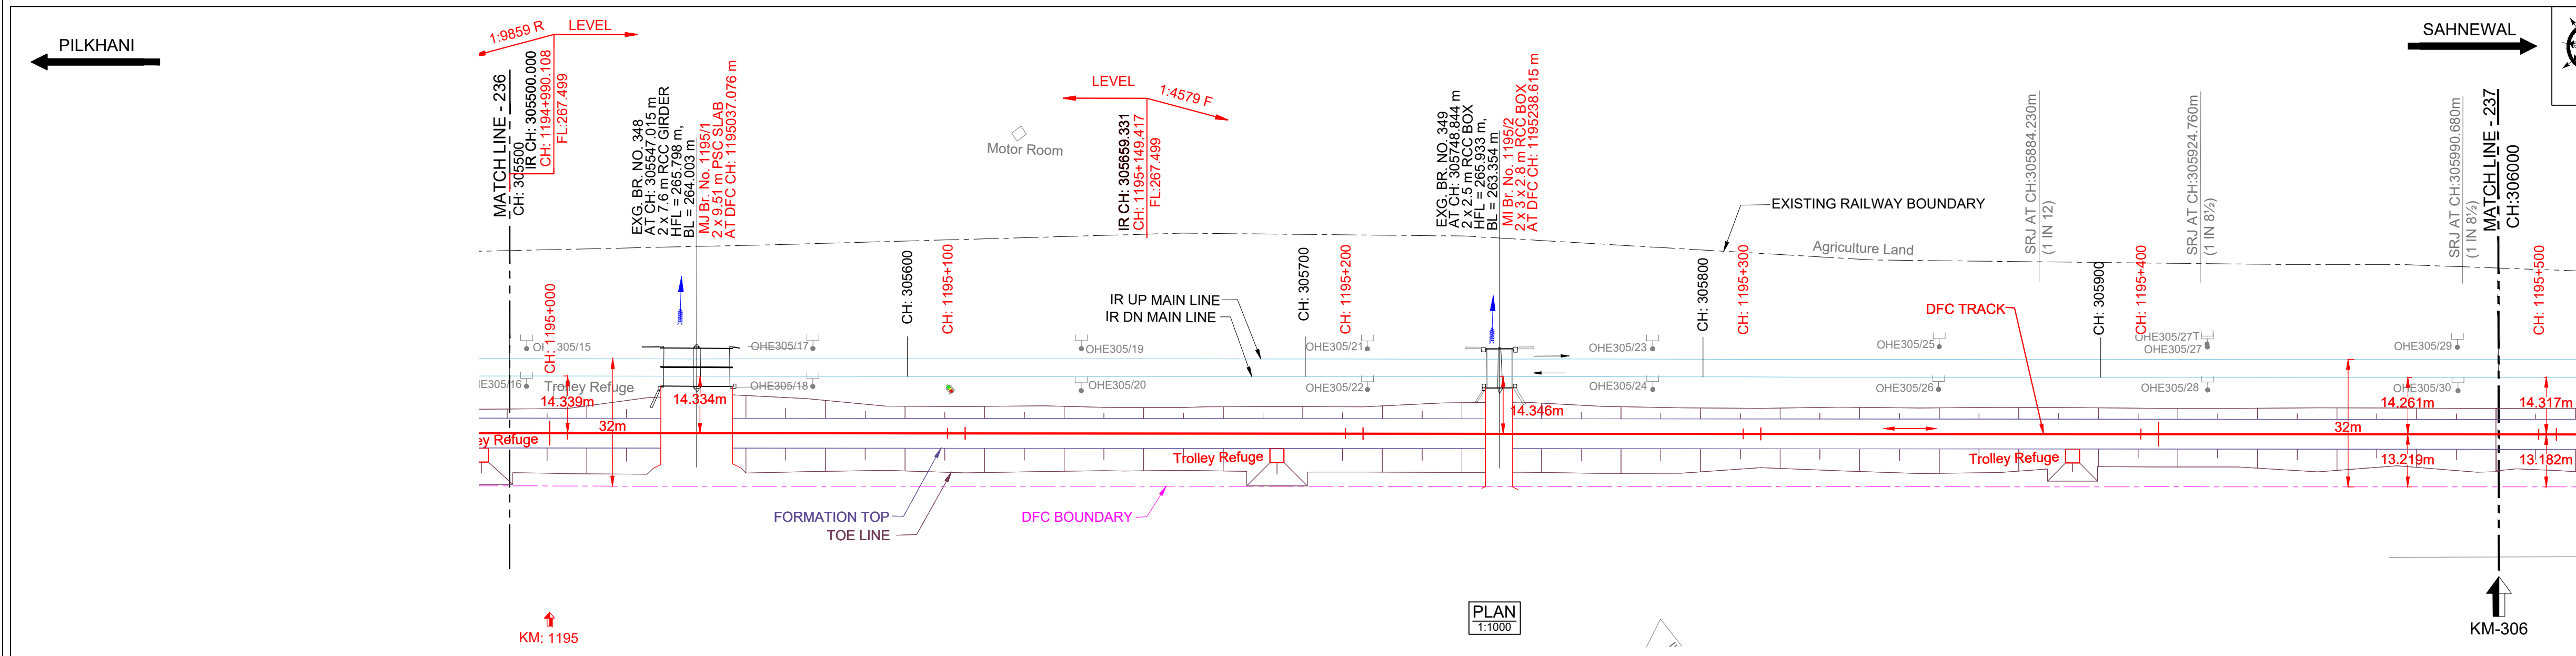


DATUM ABOVE MSL : 260 m

HORIZONTAL ALIGNMENT	L=3511.712m																		
VERTICAL ALIGNMENT	L=20.0 m R=97177 m L=139.309 m LEVEL L=20.0 m R=91583 m L=570.710 m 1 IN 4579.147 F																		
TRACK DISTANCE FROM EXISTING NEAREST IR DN MAIN LINE TO DFC MAIN LINE	14.340	14.338	14.335	14.319	14.295	14.297	14.301	14.303	14.306	14.312	14.323	14.340	14.346	14.347	14.338	14.320	14.245	14.248	14.270
HEIGHT OF BANKING(+) / DEPTH OF CUTTING(-) (PFL-GL)	+3.059	+2.305		+3.379	+3.300	+3.022	+2.691	+3.088	+2.636	+2.937	+3.171	+3.126	+3.014	+3.212	+2.885	+3.076	+3.092	+3.053	+2.939
EXG GROUND LEVEL AT CENTER LINE OF DFC TRACK (GL)	264.440	264.440	264.440	264.420	264.199	264.477	264.808	264.411	264.862	264.557	264.319	264.360	264.467	264.265	264.588	264.392	264.363	264.398	264.507
EXG GROUND LEVEL AT TOE LOCATION OF DFC TRACK	264.313	264.165	264.147	264.285	264.507	264.545	264.368	264.540	264.604	264.572	264.439	264.433	264.414	264.382	264.288	264.492	264.300	264.599	264.634
DIFFERENCE BETWEEN DFC FORMATION LEVEL AND EXG.FORMATION LEVEL (PFL-EFL)	1.112	1.099	1.082	1.084	1.096	1.105	1.108	1.045	1.004	1.003	1.005	1.015	1.020	1.021	1.014	0.998	1.016	1.038	1.032
DFC FORMATION LEVEL (PFL)	267.499	267.499	267.499	267.499	267.499	267.499	267.499	267.499	267.499	267.499	267.499	267.499	267.499	267.499	267.499	267.499	267.499	267.499	267.499
EXG. FORMATION LEVEL OF EXG IR DN MAIN LINE (EFL)	266.387	266.400	266.417	266.415	266.403	266.394	266.391	266.454	266.494	266.491	266.485	266.471	266.461	266.456	266.459	266.470	266.439	266.413	266.414
DIFFERENCE BETWEEN DFC RAIL LEVEL AND EXG. RAIL LEVEL (PRL - ERL)	1.153	1.140	1.123	1.125	1.137	1.146	1.149	1.086	1.046	1.044	1.046	1.056	1.061	1.062	1.055	1.039	1.057	1.079	1.073
DFC RAIL LEVEL (PRL)	268.212	268.212	268.212	268.212	268.212	268.212	268.212	268.212	268.212	268.207	268.203	268.199	268.194	268.190	268.186	268.181	268.168	268.164	268.159
EXG.RAIL LEVEL OF NEAREST IR DN MAIN LINE(ERL)	267.059	267.072	267.089	267.087	267.075	267.066	267.063	267.126	267.166	267.163	267.157	267.143	267.133	267.128	267.131	267.142	267.111	267.085	267.086
EQUIVALENT CHAINAGE ON DFC TRACK	1194990.0	1195010.1	1195030.1	1195050.1	1195070.1	1195090.1	1195110.1	1195130.1	1195150.1	1195170.1	1195190.1	1195210.1	1195230.1	1195250.1	1195270.1	1195290.1	1195310.1	1195330.1	1195350.1
EXISTING IR CHAINAGE	305500.0	305520.0	305540.0	305560.0	305580.0	305600.0	305620.0	305640.0	305660.0	305680.0	305700.0	305720.0	305740.0	305760.0	305780.0	305800.0	305820.0	305840.0	305860.0

L - SECTION

SAHNEWAL

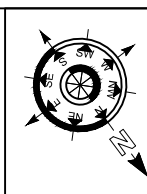

- NOTE:-
- DFCC WORKS ARE SHOWN IN RED.
 - IR NEW WORKS ARE SHOWN IN VIOLET.
 - ALL DIMENSIONS ARE SHOWN IN METRES.
 - THIS DRAWING IS PREPARED BASED ON LATEST SURVEY DATA HELD ON APRIL-2022. GTS BENCH MARK OF 261.850M CONSIDERED ON TOP OF CANAL BRIDGE ABUTMENT AT DORANA VILLAGE ALONG THE NH1.
 - DFC NEW CHAINAGE OF 1075.950M IS WITH REFERENCE TO THE IR KM OF 187.500KM END OF KM OF CP-303(SECTION P-3 PILKHANI END) AGAINST THE EXISTING DFC CHAINAGE. 116277.742M ISSUED VIDE LETTER NO. COM/DFCC/MB/SURVEY/2021-301-230116-011173 DT. 17.01.2023.
 - BALLAST PROFILE HAS BEEN PROVIDED ACCORDING TO THE CLAUSE 1.11.3 OF STANDARD SCHEDULE OF DIMENSION(EASTERN CORRIDOR) & THE BALLAST CUSHION DIMENSION SHOWN IN 35CM ON GE-14 PARA 17. SPECIFICATIONS & RECOMMENDATIONS 2. TWO LAYER SYSTEM FIG.10.

- REFERENCE DRAWINGS :-
- FOR KEY PLAN REFER DRAWING NO. 301-2/AL/0001
 - FOR LEGEND AND ABBREVIATIONS REFER DRAWING NO. 301-2/AL/1000
 - FOR TYPICAL SECTION OF BALLAST PROFILE (FL-RL) REFER DRG. NO. 301-2/TK/TFD/004 (TR.1952)

REV.	DATE	REVISION DETAILS	PURPOSE OF ISSUE
0	07.09.2024	SUBMISSION OF AS-BUILT DRAWING	FOR APPROVAL

LEGEND:


SCALE

HOR - 1:1000

VER - 1:100

SHEET SIZE : A1

IR TRACK
DFCC TRACK
DFCC FUTURE PROPOSALS
STRUCTURE / BUILDING
DFCC TOE LINE
DFCC FORMATION
RETAINING WALL
ROAD
STREAM, DRAIN, NALA, CANAL.
FENCE
POWER LINES
TBM
ELECTRIC POLE/OHE MAST
IR RAILWAY BOUNDARY
DFCC BOUNDARY

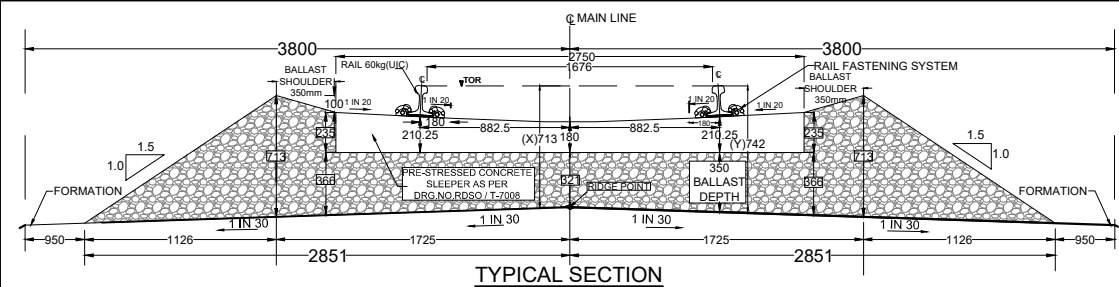

TRACK STRUCTURE		
RAIL SECTION: 60Kg/m (UIC 60Kg/m) DFC LINE: 60Kg/m (UIC 60Kg/m) IR MAIN LINE: 52Kg/m	Difference between FL- RL (Below Rail Seat)	
	IR Line	DFC
RUBBER PAD	172mm	172mm
SLEEPER DEPTH	6mm	10mm
BALLAST CUSHION	210mm	210mm
	300mm	350mm
Total Depth (FL TO RL)	688mm	742mm

OWNER

DEDICATED FREIGHT CORRIDOR CORPORATION OF INDIA LTD.

(A GOVERNMENT OF INDIA ENTERPRISE)

PROJECT OFFICE/AMBALA UNIT: OLD RAILWAY COLONY (NEAR ANAND MARKET),AMBALA CANTT-133001.

CORPORATE IDENTITY NO. : U60232DL2006GGI155068

ENGINEER:

DB Engineering & Consulting GmbH

Deutsche Bahn Engineering & Consulting GmbH

CONTRACTOR:

GIL - TPL JV

GAR TATA

SUBMITTED BY	GIL - TPL JV		
	DATED	NAME	SIGNATURE
PREPARED BY			
CHECKED BY	07.09.2024	VIJAY PRATAP	
APPROVED BY	07.09.2024	PARASURAM KOTYADA	

APPROVED BY	DEUTSCHE BAHN ENGINEERING & CONSULTING GMBH		
	DATED	NAME	SIGNATURE
Sr. DE./CHIEF ENGINEER		SURESH K.YALANGI	
CHIEF TRACK ENGINEER		RAJ PAL SINGH	
T.L.		H.D. VIDJAK	

STAMP	A AS-BUILT DRAWING TR. Ref.:..... ENGINEER Sign.:.....		
EMPLOYER (DFCCIL):	DEDICATED FREIGHT CORRIDOR CORPORATION OF INDIA LTD.		

AS BUILT DRAWING			
TITLE	AS-BUILT PLAN AND PROFILE		
	DFCC APPR. NO. -		
	ENGG. APPR. NO. -		
	DRG. NO. - 301-2/AL/A/1237		
	SHEET NO. : 1 OF 1	STATUS	
	DATE : 07.09.2024	A	

TR.