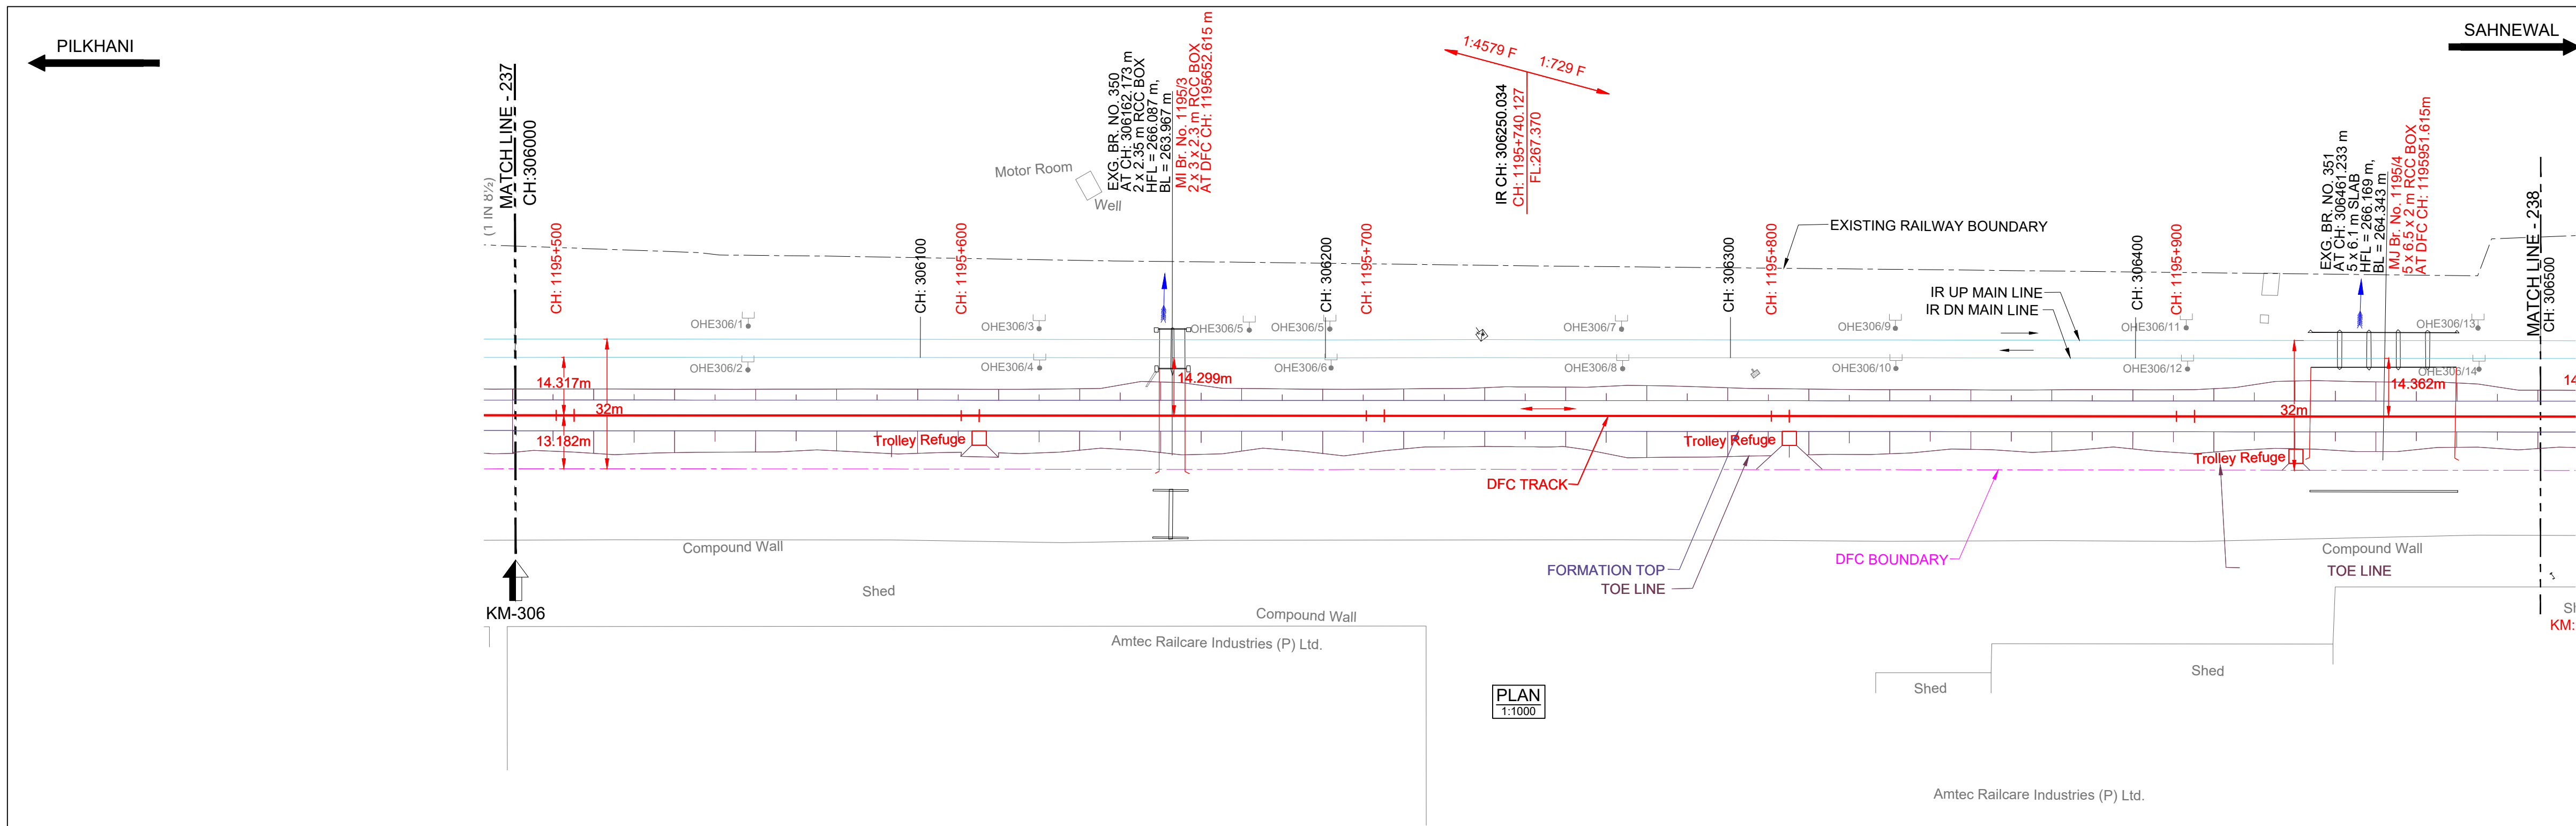


DATUM ABOVE MSL : 263 m

HORIZONTAL ALIGNMENT	L=3511.712m																										
VERTICAL ALIGNMENT	L=570.710 m 1 IN 4579.147 F												L = 20m = 17331.7m												L = 450.00 m 1 IN 728.685		
TRACK DISTANCE FROM EXISTING NEAREST IR DN MAIN LINE TO DFC MAIN LINE	14.291	14.291	14.337	14.338	14.337	14.332	14.325	14.314	14.306	14.299	14.296	14.345	14.394	14.385	14.385	14.405	14.415	14.420	14.420	14.410	14.399	14.387	14.376	14.365	14.361	14.363	14.364
HEIGHT OF BANKING(+) / DEPTH OF CUTTING(-) (PFL-GL)	+3.059	+3.059	+3.062	+3.063	+3.221	+3.242	+3.208	+3.017	+2.927	+3.274	+3.355	+3.415	+3.193	+2.913	+2.725	+3.191	+3.091	+2.919	+2.902	+2.801	+2.865	+2.760	+2.913	+2.577	+2.521	+2.332	+2.567
EXG GROUND LEVEL AT CENTER LINE OF DFC TRACK (GL)	264.366	264.366	264.358	264.323	264.191	264.165	264.195	264.381	264.467	264.116	264.030	263.966	264.184	264.459	264.631	264.138	264.210	264.355	264.345	264.418	264.327	264.404	264.224	264.532	264.551	264.723	264.460
EXG GROUND LEVEL AT TOE LOCATION OF DFC TRACK	264.509	264.509	264.537	264.593	264.748	264.813	264.511	264.677	264.736	264.775	264.557	264.801	264.981	265.405	265.279	263.981	264.081	264.236	264.469	264.418	264.690	264.934	264.485	264.826	264.655	264.915	264.855
DIFFERENCE BETWEEN DFC FORMATION LEVEL AND EXG.FORMATION LEVEL (PFL-EFL)	0.954	0.954	0.894	0.889	0.884	0.880	0.877	0.879	0.872	0.855	0.829	0.801	0.801	0.803	0.786	0.763	0.731	0.693	0.653	0.624	0.605	0.613	0.603	0.549	0.510	0.482	0.460
DFC FORMATION LEVEL (PFL)	267.425	267.425	267.420	267.416	267.412	267.407	267.403	267.398	267.394	267.390	267.385	267.381	267.377	267.372	267.366	267.329	267.301	267.274	267.247	267.219	267.192	267.164	267.137	267.082	267.055	267.027	266.999
EXG. FORMATION LEVEL OF EXG IR DN MAIN LINE (EFL)	266.471	266.471	266.526	266.527	266.528	266.527	266.526	266.519	266.522	266.535	266.556	266.580	266.576	266.569	266.570	266.586	266.570	266.581	266.594	266.595	266.587	266.554	266.534	266.572	266.573	266.567	266.567
DIFFERENCE BETWEEN DFC RAIL LEVEL AND EXG. RAIL LEVEL (PRL - ERL)	0.995	0.995	0.935	0.929	0.924	0.921	0.918	0.920	0.913	0.895	0.871	0.842	0.841	0.845	0.828	0.804	0.772	0.734	0.694	0.665	0.646	0.654	0.550	0.522	0.501	0.482	0.460
DFC RAIL LEVEL (PRL)	268.138	268.138	268.133	268.129	268.125	268.120	268.116	268.111	268.107	268.103	268.098	268.094	268.090	268.085	268.069	268.042	268.014	267.987	267.960	267.932	267.905	267.877	267.850	267.795	267.767	267.740	267.740
EXG.RAIL LEVEL OF NEAREST IR DN MAIN LINE(ERL)	267.143	267.143	267.198	267.199	267.200	267.199	267.198	267.191	267.194	267.207	267.228	267.252	267.248	267.241	267.242	267.238	267.242	267.253	267.266	267.267	267.259	267.223	267.206	267.244	267.245	267.239	267.239
EQUIVALENT CHAINAGE ON DFC TRACK	1195490.0	1195490.0	1195510.0	1195530.0	1195550.0	1195570.0	1195590.0	1195610.0	1195630.0	1195650.0	1195670.0	1195690.0	1195710.0	1195730.0	1195750.0	1195770.0	1195790.0	1195810.0	1195830.0	1195850.0	1195870.0	1195890.0	1195910.0	1195930.0	1195950.0	1195970.0	1195990.0
EXISTING IR CHAINAGE	306000.0	306000.0	306020.0	306040.0	306060.0	306080.0	306100.0	306120.0	306140.0	306160.0	306180.0	306200.0	306220.0	306240.0	306260.0	306280.0	306300.0	306320.0	306340.0	306360.0	306380.0	306400.0	306420.0	306440.0	306460.0	306480.0	306500.0

L - SECTION

DRG NO. - 301-2/AL/1238

NOTE:-

1. DFC WORKS ARE SHOWN IN RED.

2. IR NEW WORKS ARE SHOWN IN VIOLET.

3. ALL DIMENSIONS ARE SHOWN IN METRES.

4. THIS DRAWING IS PREPARED BASED ON LATEST SURVEY DATA HELD ON APRIL-2022. GTS BENCH MARK OF 261.850M CONSIDERED ON TOP OF CANAL BRIDGE ABUTMENT AT DORANA VILLAGE ALONG THE NH1.

5. DFC NEW CHAINAGE OF 1075.950M IS WITH REFERENCE TO THE IR KM OF 187.500KM END OF KM OF CP-303(SECTION P-3 PILKHANI END) AGAINST THE EXISTING DFC CHAINAGE. 116277.742M ISSUED VIDE LETTER NO. COM/DFCC/MB/SURVEY/2021-301-2/0116-011173 DT. 17.01.2023.

6. BALLAST PROFILE HAS BEEN PROVIDED ACCORDING TO THE CLAUSE 1.11.3 OF STANDARD SCHEDULE OF DIMENSION(EASTERN CORRIDOR) & THE BALLAST CUSHION DIMENSION SHOWN IN 35CM ON GE-14 PARA 17. SPECIFICATIONS & RECOMMENDATIONS 2. TWO LAYER SYSTEM FIG.10.

REFERENCE DRAWINGS :-

1. FOR KEY PLAN REFER DRAWING NO. 301-2/AL/0001

2. FOR LEGEND AND ABBREVIATIONS REFER DRAWING NO. 301-2/AL/1000

3. FOR TYPICAL SECTION OF BALLAST PROFILE (FL-RL) REFER DRG. NO. 301-2/TK/TFDI-004 (TR.1952)

07.09.2024

SUBMISSION OF AS-BUILT DRAWING

FOR APPROVAL

REV.

DATE

REVISION DETAILS

PURPOSE OF ISSUE

SCALE

HOR - 1:1000

VER - 1:100

SHEET SIZE : A1

LEGEND:

IR TRACK

DFCC TRACK

DFCC FUTURE PROPOSALS

STRUCTURE / BUILDING

DFCC TOE LINE

DFCC FORMATION

RETAINING WALL

ROAD

STREAM, DRAIN, NALA, CANAL.

FENCE

POWER LINES

TBM

ELECTRIC POLE/OHE MAST

IR RAILWAY BOUNDARY

DFCC BOUNDARY

TYPICAL SECTION

TRACK STRUCTURE

RAIL SECTION: 60Kg/m (UIC 60Kg/m)

DFC LINE: 60Kg/m (UIC 60Kg/m)

IR MAIN LINE: 52Kg/m

Difference between FL- RL (Below Rail Seat)

IR Line

DFC

172mm

172mm

6mm

10mm

210mm

210mm

300mm

350mm

Total Depth (FL TO RL)

688mm

742mm

OWNER

DEDICATED FREIGHT CORRIDOR CORPORATION OF INDIA LTD.

(A GOVERNMENT OF INDIA ENTERPRISE)

PROJECT OFFICE(AMBALA UNIT): OLD RAILWAY COLONY (NEAR ANAND MARKET),AMBALA CANTT-133001.

CORPORATE IDENTITY NO. : U60232DL2006GGI155068

ENGINEER:

DB Engineering & Consulting GmbH

Deutsche Bahn Engineering & Consulting GmbH

CONTRACTOR:

GIL - TPL JV

GAR TATA

SUBMITTED BY

GIL - TPL JV

PREPARED BY

DATED

NAME

SIGNATURE

CHECKED BY

07.09.2024

VIJAY PRATAP

APPROVED BY

07.09.2024

PARASURAM KOTYADA

APPROVED BY

DEUTSCHE BAHN ENGINEERING & CONSULTING GMBH

Sr. DE./CHIEF ENGINEER

SURESH K.YALANGI

CHIEF TRACK ENGINEER

RAJ PAL SINGH

T.L.

H.D. VIDJAK

STAMP

A AS-BUILT DRAWING TR. Ref.:..... ENGINEER Sign.:.....

EMPLOYER (DFCCIL):

DEDICATED FREIGHT CORRIDOR CORPORATION OF INDIA LTD.

AS BUILT DRAWING

TITLE

AS-BUILT PLAN AND PROFILE

DFCC APPR. NO. -

ENGG. APPR. NO. -

DRG. NO. - 301-2/AL/1238

SHEET NO. : 1 OF 1

DATE : 07.09.2024

STATUS

A

FROM IR KM: 306.000 TO 306.500

DFC KM: 1195.490 TO 1195.990

TR.