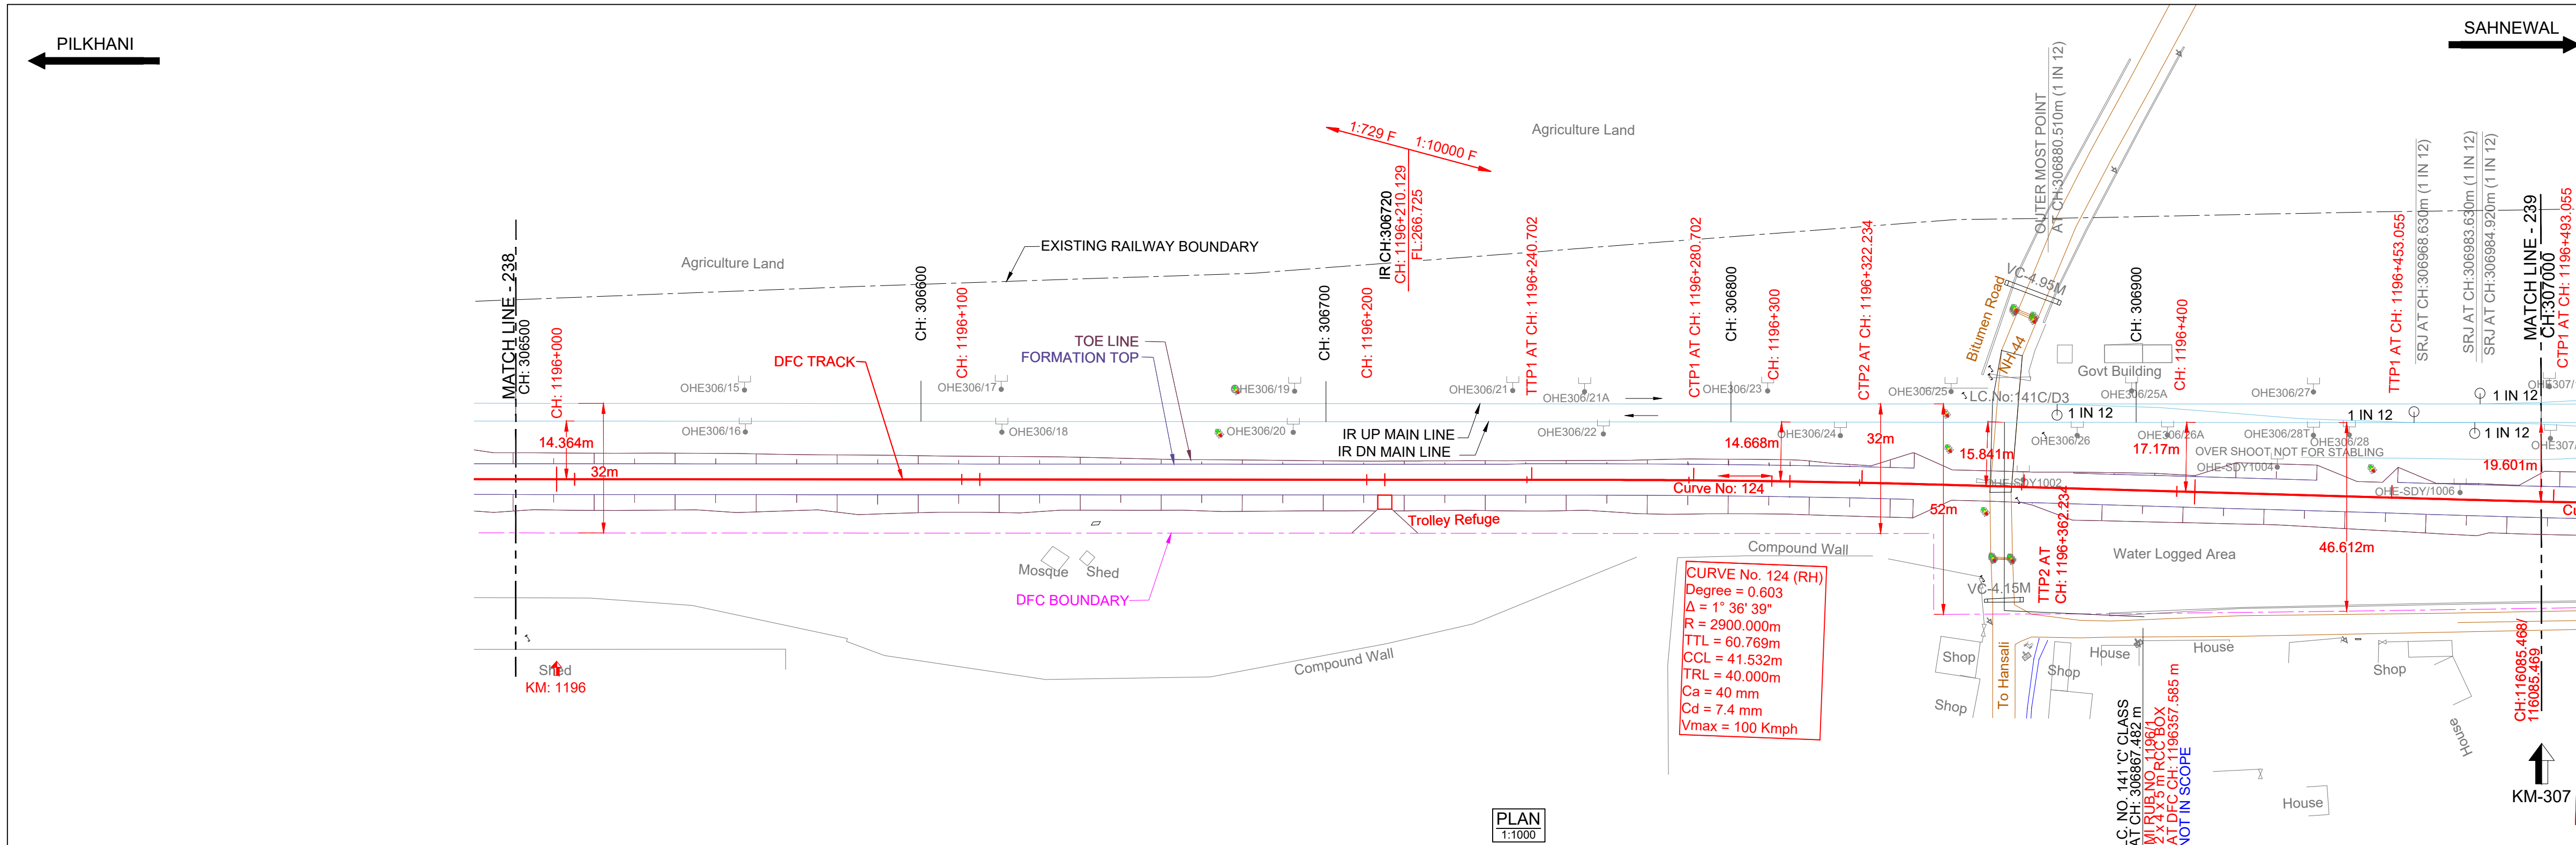


DATUM ABOVE MSL : 263 m

HORIZONTAL ALIGNMENT	L=3511.712m TL= 40m R= 2900m CCL 41.532m TL= 40m L= 90.821m TL= 40m																			
VERTICAL ALIGNMENT	L= 450.000 m 1 IN 728.685 L=20.000m R=15719.14 L= 540.319 m 1 IN 10000																			
TRACK DISTANCE FROM EXISTING NEAREST IR DN MAIN LINE TO DFC MAIN LINE	14.364	14.365	14.367	14.368	14.369	14.370	14.371	14.372	14.373	14.374	14.375	14.376	14.377	14.378	14.379	14.380	14.381	14.382	14.383	14.384
HEIGHT OF BANKING(+) / DEPTH OF CUTTING(-) (PFL-GL)	2.567	2.179	2.122	2.086	2.050	2.014	1.978	1.942	1.906	1.870	1.834	1.798	1.762	1.726	1.690	1.654	1.618	1.582	1.546	1.510
EXG GROUND LEVEL AT CENTER LINE OF DFC TRACK (GL)	264.460	264.821	264.850	264.859	264.868	264.877	264.886	264.895	264.904	264.913	264.922	264.931	264.940	264.949	264.958	264.967	264.976	264.985	264.994	265.003
EXG GROUND LEVEL AT TOE LOCATION OF DFC TRACK	264.855	265.280	265.059	264.459	264.461	264.513	264.568	264.616	264.666	264.717	264.775	264.831	264.886	264.940	264.994	265.048	265.102	265.156	265.210	265.264
DIFFERENCE BETWEEN DFC FORMATION LEVEL AND EXG.FORMATION LEVEL (PFL-EFL)	0.460	0.446	0.436	0.431	0.402	0.372	0.337	0.307	0.269	0.234	0.201	0.167	0.132	0.098	0.064	0.030	-0.004	-0.038	-0.072	-0.106
DFC FORMATION LEVEL (PFL)	267.027	267.000	266.972	266.945	266.917	266.890	266.862	266.835	266.808	266.780	266.753	266.725	266.697	266.670	266.642	266.615	266.587	266.560	266.532	266.505
EXG. FORMATION LEVEL OF EXG IR DN MAIN LINE (EFL)	266.567	266.554	266.536	266.514	266.515	266.518	266.525	266.528	266.539	266.546	266.552	266.558	266.563	266.568	266.573	266.578	266.583	266.588	266.593	266.598
DIFFERENCE BETWEEN DFC RAIL LEVEL AND EXG. RAIL LEVEL (PRL - ERL)	0.501	0.486	0.477	0.471	0.443	0.413	0.379	0.348	0.309	0.275	0.242	0.208	0.173	0.139	0.104	0.070	0.035	0.001	-0.034	-0.068
DFC RAIL LEVEL (PRL)	267.740	267.713	267.685	267.658	267.630	267.603	267.575	267.548	267.520	267.493	267.466	267.438	267.410	267.383	267.355	267.328	267.300	267.273	267.245	267.218
EXG.RAIL LEVEL OF NEAREST IR DN MAIN LINE(ERL)	267.239	267.228	267.208	267.186	267.187	267.190	267.197	267.200	267.211	267.218	267.224	267.230	267.236	267.241	267.246	267.251	267.256	267.261	267.266	267.271
EQUIVALENT CHAINAGE ON DFC TRACK	1195990.1	1196010.1	1196030.1	1196050.1	1196070.1	1196090.1	1196110.1	1196130.1	1196150.1	1196170.1	1196190.1	1196210.1	1196230.1	1196250.1	1196270.1	1196290.1	1196310.1	1196330.1	1196350.1	1196370.1
EXISTING IR CHAINAGE	306500.0	306520.0	306540.0	306560.0	306580.0	306600.0	306620.0	306640.0	306660.0	306680.0	306700.0	306720.0	306740.0	306760.0	306780.0	306800.0	306820.0	306840.0	306860.0	307000.0

L - SECTION

NOTE:-

- DFCC WORKS ARE SHOWN IN RED.
- IR NEW WORKS ARE SHOWN IN VIOLET.
- ALL DIMENSIONS ARE SHOWN IN METRES.
- THIS DRAWING IS PREPARED BASED ON LATEST SURVEY DATA HELD ON APRIL-2022. GTS BENCH MARK OF 261.850M CONSIDERED ON TOP OF CANAL BRIDGE ABUTMENT AT DORAH VILLAGE ALONG THE NH1.
- DFC NEW CHAINAGE OF 1075.950M IS WITH REFERENCE TO THE IR KM OF 187.500KM END OF KM OF CP-303(SECTION P-3 PILKHANI END) AGAINST THE EXISTING DFC CHAINAGE. 116277.742M ISSUED VIDE LETTER NO. COM/DFCC/MB/SURVEY/2021-301-2301/16-011173.DT. 17.01.2023.
- BALLAST PROFILE HAS BEEN PROVIDED ACCORDING TO THE CLAUSE 1.11.3 OF STANDARD SCHEDULE OF DIMENSION(EASTERN CORRIDOR) & THE BALLAST CUSHION DIMENSION SHOWN IN 35CM ON GE-14 PARA 17. SPECIFICATIONS & RECOMMENDATIONS 2. TWO LAYER SYSTEM FIG.10.

REFERENCE DRAWINGS :-

- FOR KEY PLAN REFER DRAWING NO. 301-2/AL/0001
- FOR LEGEND AND ABBREVIATIONS REFER DRAWING NO. 301-2/AL/1000
- FOR TYPICAL SECTION OF BALLAST PROFILE (FL-RL) REFER DRG. NO. 301-2/TK/TFD/-004 (TR.1952)

07.09.2024SUBMISSION OF AS-BUILT DRAWINGFOR APPROVAL

REV. DATE REVISION DETAILS PURPOSE OF ISSUE

SCALE
HOR - 1:1000
VER - 1:100
SHEET SIZE : A1

LEGEND:

- IR TRACK
- DFCC TRACK
- DFCC FUTURE PROPOSALS
- STRUCTURE / BUILDING
- DFCC TOE LINE
- DFCC FORMATION
- RETAINING WALL
- ROAD
- STREAM, DRAIN, NALA, CANAL.
- FENCE
- POWER LINES
- TBM
- ELECTRIC POLE/OHE MAST
- IR RAILWAY BOUNDARY
- DFCC BOUNDARY

TRACK STRUCTURE

RAIL SECTION: 60Kg/m (UIC 60Kg/m)	Difference between FL- RL (Below Rail Seat)	
DFC LINE: 60Kg/m (UIC 60Kg/m)	IR Line	DFC
IR MAIN LINE: 52Kg/m	172mm	172mm
	6mm	10mm
RUBBER PAD	210mm	210mm
SLEEPER DEPTH	300mm	350mm
BALLAST CUSHION	688mm	742mm

OWNER

DEDICATED FREIGHT CORRIDOR CORPORATION OF INDIA LTD.
(A GOVERNMENT OF INDIA ENTERPRISE)
PROJECT OFFICE (AMBALA UNIT): OLD RAILWAY COLONY (NEAR ANAND MARKET), AMBALA CANTT-133001.
CORPORATE IDENTITY NO. : U60232DL2006GGI155068

ENGINEER:

DB Engineering & Consulting GmbH
Deutsche Bahn Engineering & Consulting GmbH

CONTRACTOR:

GIL - TPL JV
GAR TATA

SUBMITTED BY	GIL - TPL JV		
PREPARED BY	DATED	NAME	SIGNATURE
CHECKED BY	07.09.2024	VIJAY PRATAP	
APPROVED BY	07.09.2024	PARASURAM KOTYADA	

APPROVED BY	DEUTSCHE BAHN ENGINEERING & CONSULTING GMBH		
	DATED	NAME	SIGNATURE
Sr. DE./CHIEF ENGINEER		SURESH K.YALANGI	
CHIEF TRACK ENGINEER		RAJ PAL SINGH	
T.L.		H.D. VIDJAK	

STAMP

A AS-BUILT DRAWING
TR. Ref.:.....
ENGINEER Sign.:.....

EMPLOYER (DFCCIL):

DEDICATED FREIGHT CORRIDOR CORPORATION OF INDIA LTD.

TITLE

AS-BUILT PLAN AND PROFILE

DFCC APPR. NO. -
ENGG. APPR. NO. -
DRG. NO. - 301-2/AL/A/1239
SHEET NO. : 1 OF 1
DATE : 07.09.2024

STATUS
A

FROM IR KM: 306.500 TO 307.000
DFC KM: 1195.990 TO 1196.490

TR.