
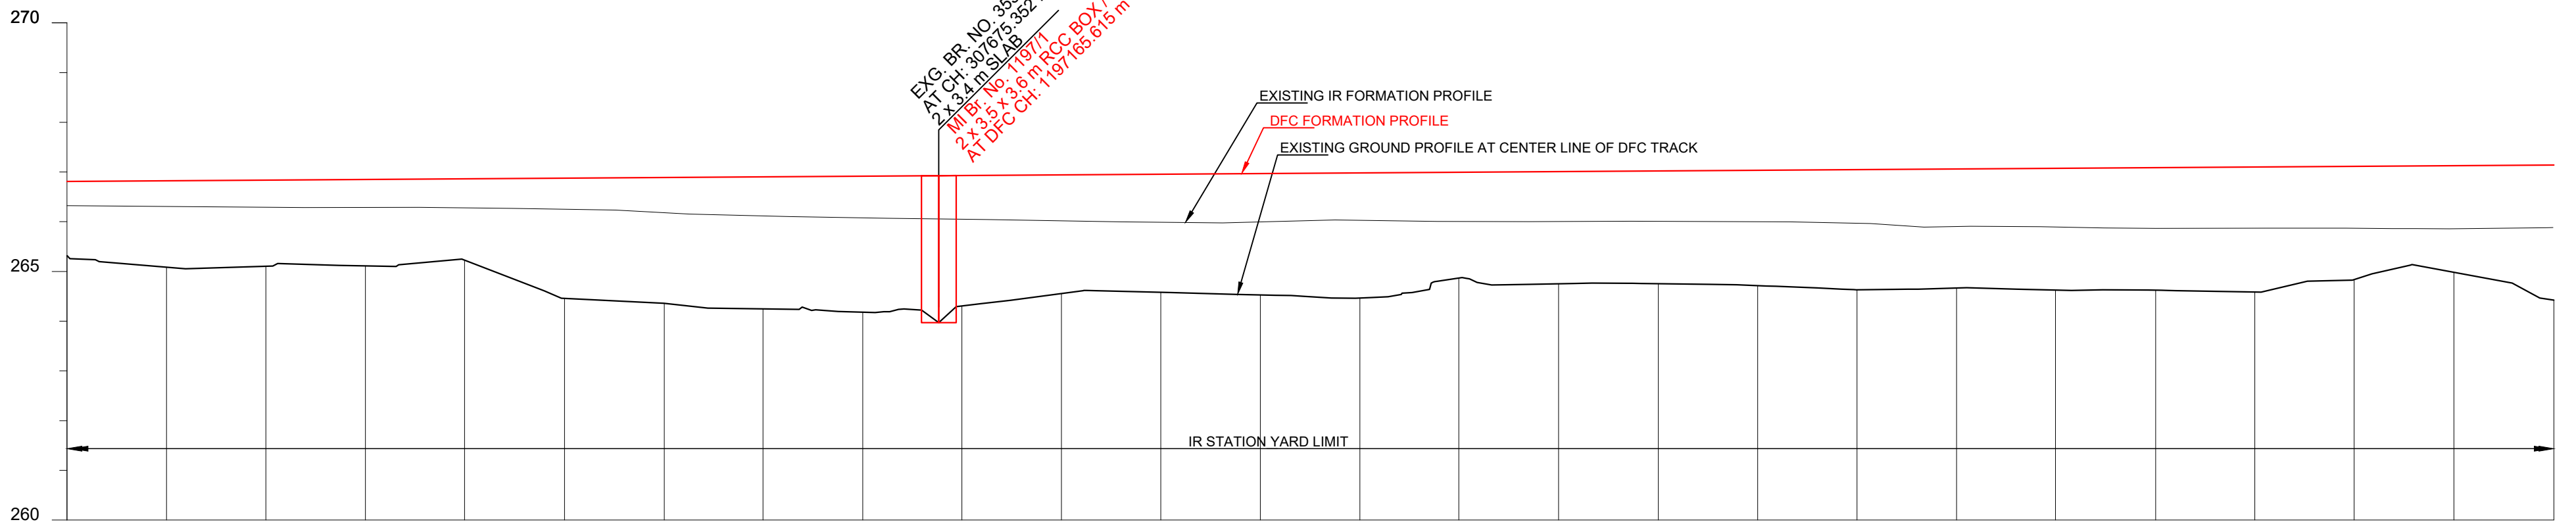


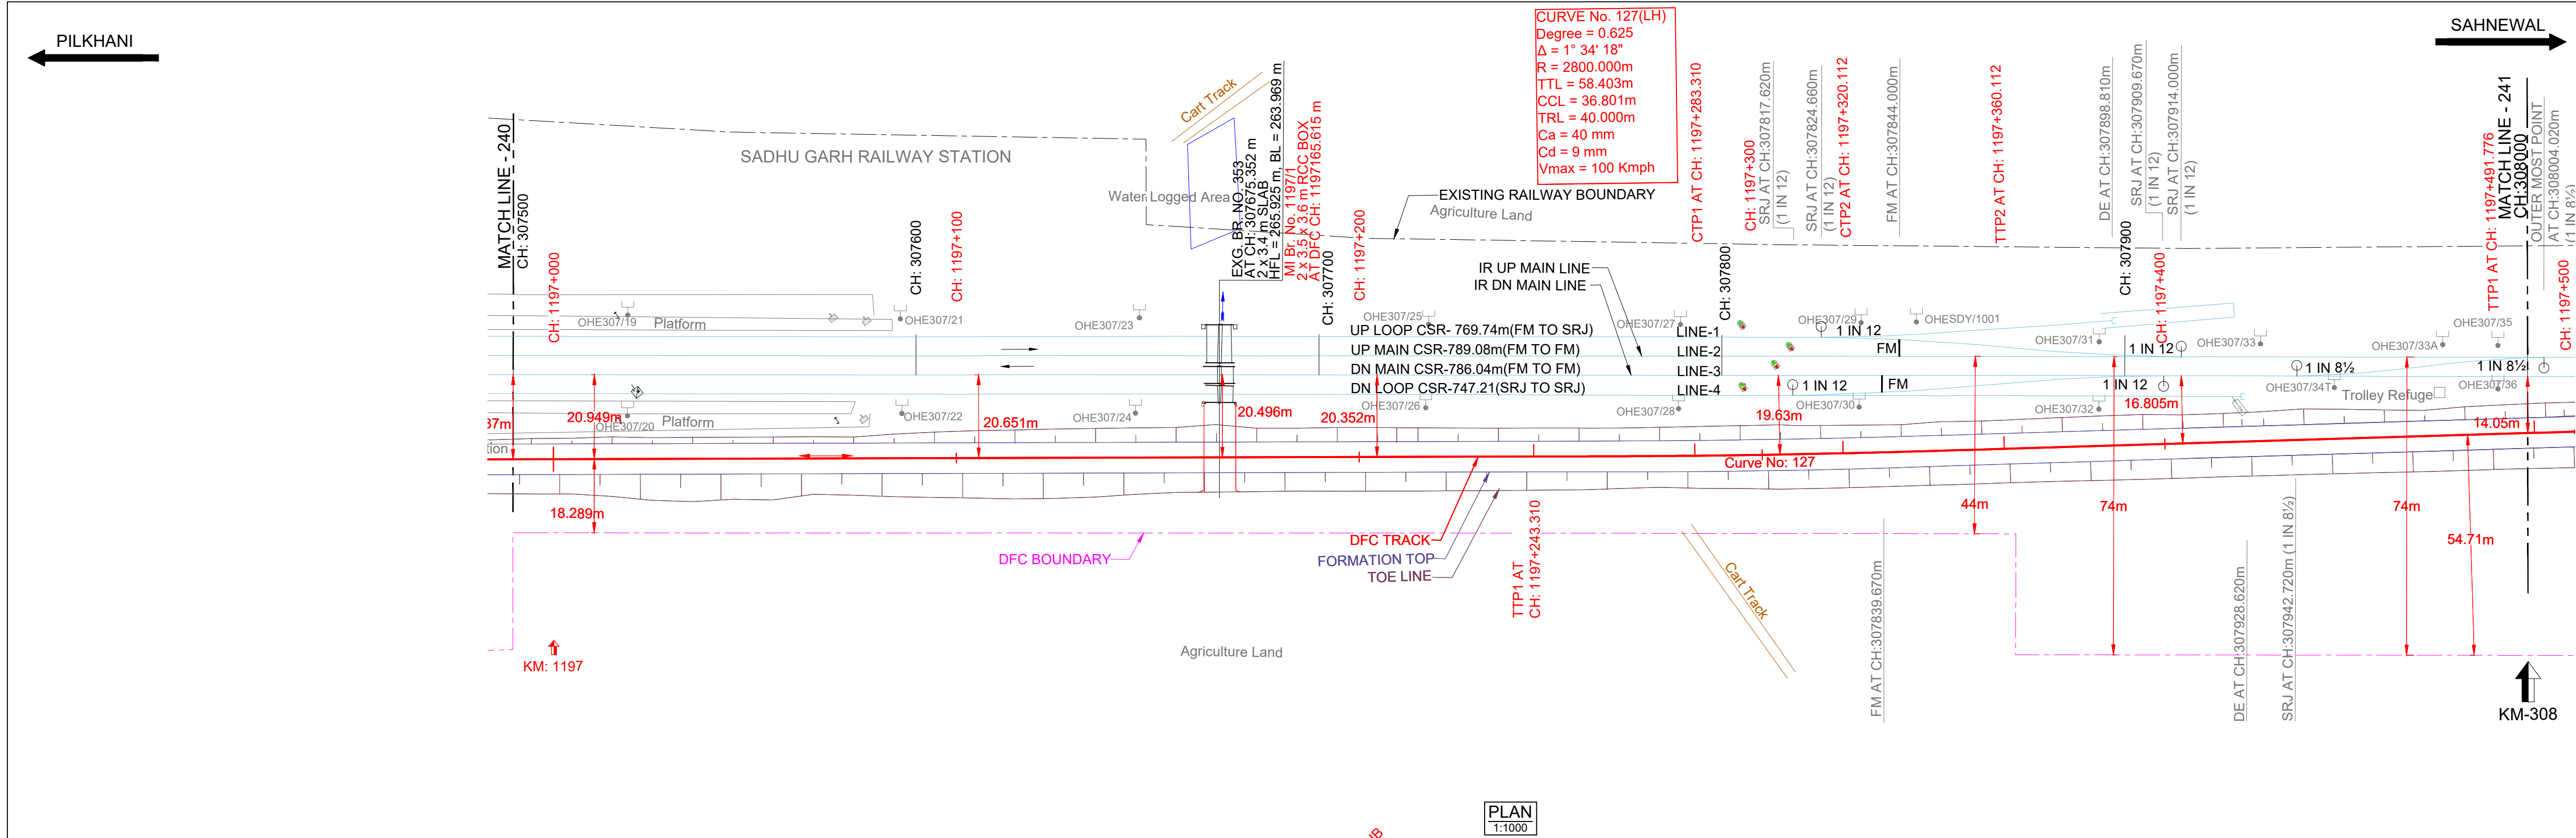

DATUM ABOVE MSL : 260 m

HORIZONTAL ALIGNMENT	L = 348.778 m																		
VERTICAL ALIGNMENT	L = 786.074 m 1 IN 1532.390																		
TRACK DISTANCE FROM EXISTING NEAREST IR DN MAIN LINE TO DFC MAIN LINE	21.037	21.498	20.955	20.879	20.820	20.732	20.666	20.678	20.603	20.553	20.480	20.408	20.328	20.252	20.192	20.080	19.848	19.520	19.078
HEIGHT OF BANKING(+) / DEPTH OF CUTTING(-) (PFL-GL)	+1.498	+1.738	+1.733	+1.740	+1.638	+2.419	+2.533	+2.657	+2.735	+2.625	+2.387	+2.377	+2.441	+2.517	+2.428	+2.255	+2.415	+2.391	+2.298
EXG GROUND LEVEL AT CENTER LINE OF DFC TRACK (GL)	265.314	265.087	265.105	265.112	265.227	264.459	264.358	264.247	264.182	264.305	264.566	264.579	264.528	264.753	264.465	264.867	264.753	264.625	264.715
EXG GROUND LEVEL AT TOE LOCATION OF DFC TRACK	264.342	264.237	263.854	263.787	264.154	263.853	263.690	263.776	264.205	264.430	264.497	264.490	264.535	264.576	264.611	264.838	264.588	264.586	264.592
DIFFERENCE BETWEEN DFC FORMATION LEVEL AND EXG FORMATION LEVEL (PFL-EFL)	0.488	0.519	0.548	0.564	0.584	0.626	0.709	0.786	0.837	0.880	0.925	0.966	0.972	0.952	0.990	1.003	1.013	1.035	1.078
DFC FORMATION LEVEL (PFL)	266.812	266.825	266.838	266.852	266.865	266.878	266.891	266.904	266.917	266.930	266.943	266.956	266.969	266.982	266.995	267.008	267.017	267.034	267.047
EXG FORMATION LEVEL OF EXG IR DN MAIN LINE (EFL)	266.324	266.306	266.290	266.286	266.281	266.252	266.182	266.118	266.080	266.050	266.018	265.990	265.997	266.030	266.005	266.989	266.989	266.971	266.959
DIFFERENCE BETWEEN DFC RAIL LEVEL AND EXG. RAIL LEVEL (PRL - ERL)	0.529	0.560	0.590	0.604	0.624	0.666	0.750	0.827	0.878	0.921	0.965	1.007	1.013	0.993	1.031	1.044	1.054	1.119	1.199
DFC RAIL LEVEL (PRL)	267.525	267.538	267.551	267.565	267.578	267.591	267.604	267.617	267.630	267.643	267.656	267.669	267.682	267.695	267.708	267.721	267.734	267.766	267.773
EXG RAIL LEVEL OF NEAREST IR DN MAIN LINE (ERL)	266.996	266.978	266.962	266.960	266.953	266.924	266.854	266.790	266.752	266.722	266.690	266.662	266.669	266.702	266.677	266.677	266.680	266.566	266.575
EQUIVALENT CHAINAGE ON DFC TRACK	307500.0	307520.0	307540.0	307560.0	307580.0	307600.0	307620.0	307640.0	307660.0	307680.0	307700.0	307720.0	307740.0	307760.0	307780.0	307800.0	307820.0	307840.0	307860.0
EXISTING IR CHAINAGE	307500.0	307520.0	307540.0	307560.0	307580.0	307600.0	307620.0	307640.0	307660.0	307680.0	307700.0	307720.0	307740.0	307760.0	307780.0	307800.0	307820.0	307840.0	307860.0

L - SECTION

NOTE:-

- DFCC WORKS ARE SHOWN IN RED.
- IR NEW WORKS ARE SHOWN IN VIOLET.
- ALL DIMENSIONS ARE SHOWN IN METRES.
- THIS DRAWING IS PREPARED BASED ON LATEST SURVEY DATA HELD ON APRIL-2022. GTS BENCH MARK OF 261.850M CONSIDERED ON TOP OF CANAL BRIDGE ABUTMENT AT DORANA VILLAGE ALONG THE NH1.
- DFC NEW CHAINAGE OF 1075.950M IS WITH REFERENCE TO THE IR KM OF 187.500KM END OF KM OF CP-303(SECTION P-3 PILKHANI END) AGAINST THE EXISTING DFC CHAINAGE. 116277.742M ISSUED VIDE LETTER NO. COM/DFCC/MB/SURVEY/2021-301-230116-011173 DT. 17.01.2023
- BALLAST PROFILE HAS BEEN PROVIDED ACCORDING TO THE CLAUSE 1.11.3 OF STANDARD SCHEDULE OF DIMENSION (EASTERN CORRIDOR) & THE BALLAST CUSHION DIMENSION SHOWN IN 35CM ON GE-14 PARA 17. SPECIFICATIONS & RECOMMENDATIONS 2. TWO LAYER SYSTEM FIG.10.

REFERENCE DRAWINGS :-

- FOR KEY PLAN REFER DRAWING NO. 301-2/AL/0001
- FOR LEGEND AND ABBREVIATIONS REFER DRAWING NO. 301-2/AL/1000
- FOR TYPICAL SECTION OF BALLAST PROFILE (FL-RL) REFER DRG. NO. 301-2/TK/TFDI-004 (TR.1952)

07.09.2024SUBMISSION OF AS-BUILT DRAWINGFOR APPROVAL

REV. DATE REVISION DETAILS PURPOSE OF ISSUE

SCALE
HOR - 1:1000
VER - 1:100
SHEET SIZE : A1

LEGEND:

- IR TRACK
- DFCC TRACK
- DFCC FUTURE PROPOSALS
- STRUCTURE / BUILDING
- DFCC TOE LINE
- DFCC FORMATION
- RETAINING WALL
- ROAD
- STREAM, DRAIN, NALA, CANAL
- FENCE
- POWER LINES
- TBM
- ELECTRIC POLE/OHE MAST
- IR RAILWAY BOUNDARY
- DFCC BOUNDARY

TYPICAL SECTION

TRACK STRUCTURE

RAIL SECTION: 60Kg/m (UIC 60Kg/m)	Difference between FL- RL (Below Rail Seat)	
DFC LINE: 60Kg/m (UIC 60Kg/m)	IR Line	DFC
IR MAIN LINE: 52Kg/m	172mm	172mm
RUBBER PAD	6mm	10mm
SLEEPER DEPTH	210mm	210mm
BALLAST CUSHION	300mm	350mm
Total Depth (FL TO RL)	688mm	742mm

OWNER
DEDICATED FREIGHT CORRIDOR CORPORATION OF INDIA LTD.
(A GOVERNMENT OF INDIA ENTERPRISE)
PROJECT OFFICE (AMBALA UNIT): OLD RAILWAY COLONY (NEAR ANAND MARKET), AMBALA CANTT-133001.
CORPORATE IDENTITY NO. : U60232DL2006GGI155068

ENGINEER:
DB Engineering & Consulting GmbH
Deutsche Bahn Engineering & Consulting GmbH

CONTRACTOR:
GIL - TPL JV
GAR TATA

SUBMITTED BY	GIL - TPL JV		
PREPARED BY	DATED	NAME	SIGNATURE
CHECKED BY	07.09.2024	VIJAY PRATAP	
APPROVED BY	07.09.2024	PARASURAM KOTYADA	
APPROVED BY	DEUTSCHE BAHN ENGINEERING & CONSULTING GMBH		
	DATED	NAME	SIGNATURE
Sr. DE./CHIEF ENGINEER		SURESH K.YALANGI	
CHIEF TRACK ENGINEER		RAJ PAL SINGH	
T.L.		H.D. VIDJAK	

STAMP
A AS-BUILT DRAWING
TR. Ref.:.....
ENGINEER Sign.:.....

EMPLOYER (DFCCIL): DEDICATED FREIGHT CORRIDOR CORPORATION OF INDIA LTD.

AS BUILT DRAWING

AS-BUILT PLAN AND PROFILE

DFCC APPR. NO. -
ENGG. APPR. NO. -
DRG. NO. - 301-2/AL/A/1241
SHEET NO. : 1 OF 1
DATE : 07.09.2024

STATUS
A

FROM IR KM: 307.500 TO 308.000
DFC KM: 1196.990 TO 1197.490

TR.