




DEDICATED FREIGHT CORRIDOR CORPORATION OF INDIA LTD.
(A GOVERNMENT OF INDIA ENTERPRISE)

EASTERN DEDICATED FREIGHT CORRIDOR
SAHNEWAL TO PILKHANI SECTION
CONTRACT PACKAGE - 301

PLAN & PROFILE OF AS BUILT DRAWINGS FOR DFC MAIN LINE

IR CHAINAGE FROM 308.000 KM TO 311.500 KM
DFCC CHAINAGE FROM KM 1197.490 TO KM 1200.990

DESIGN CONSULTANT

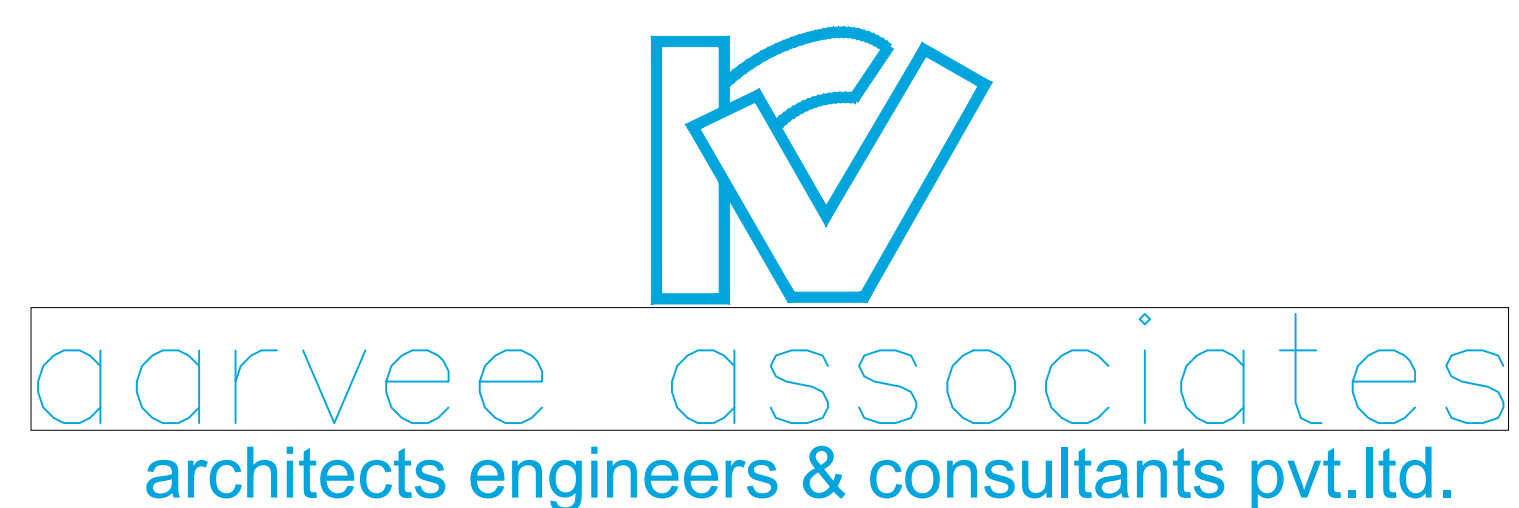


ENGINEER





CONTRACTOR CLIENT
GIL - TPL JV

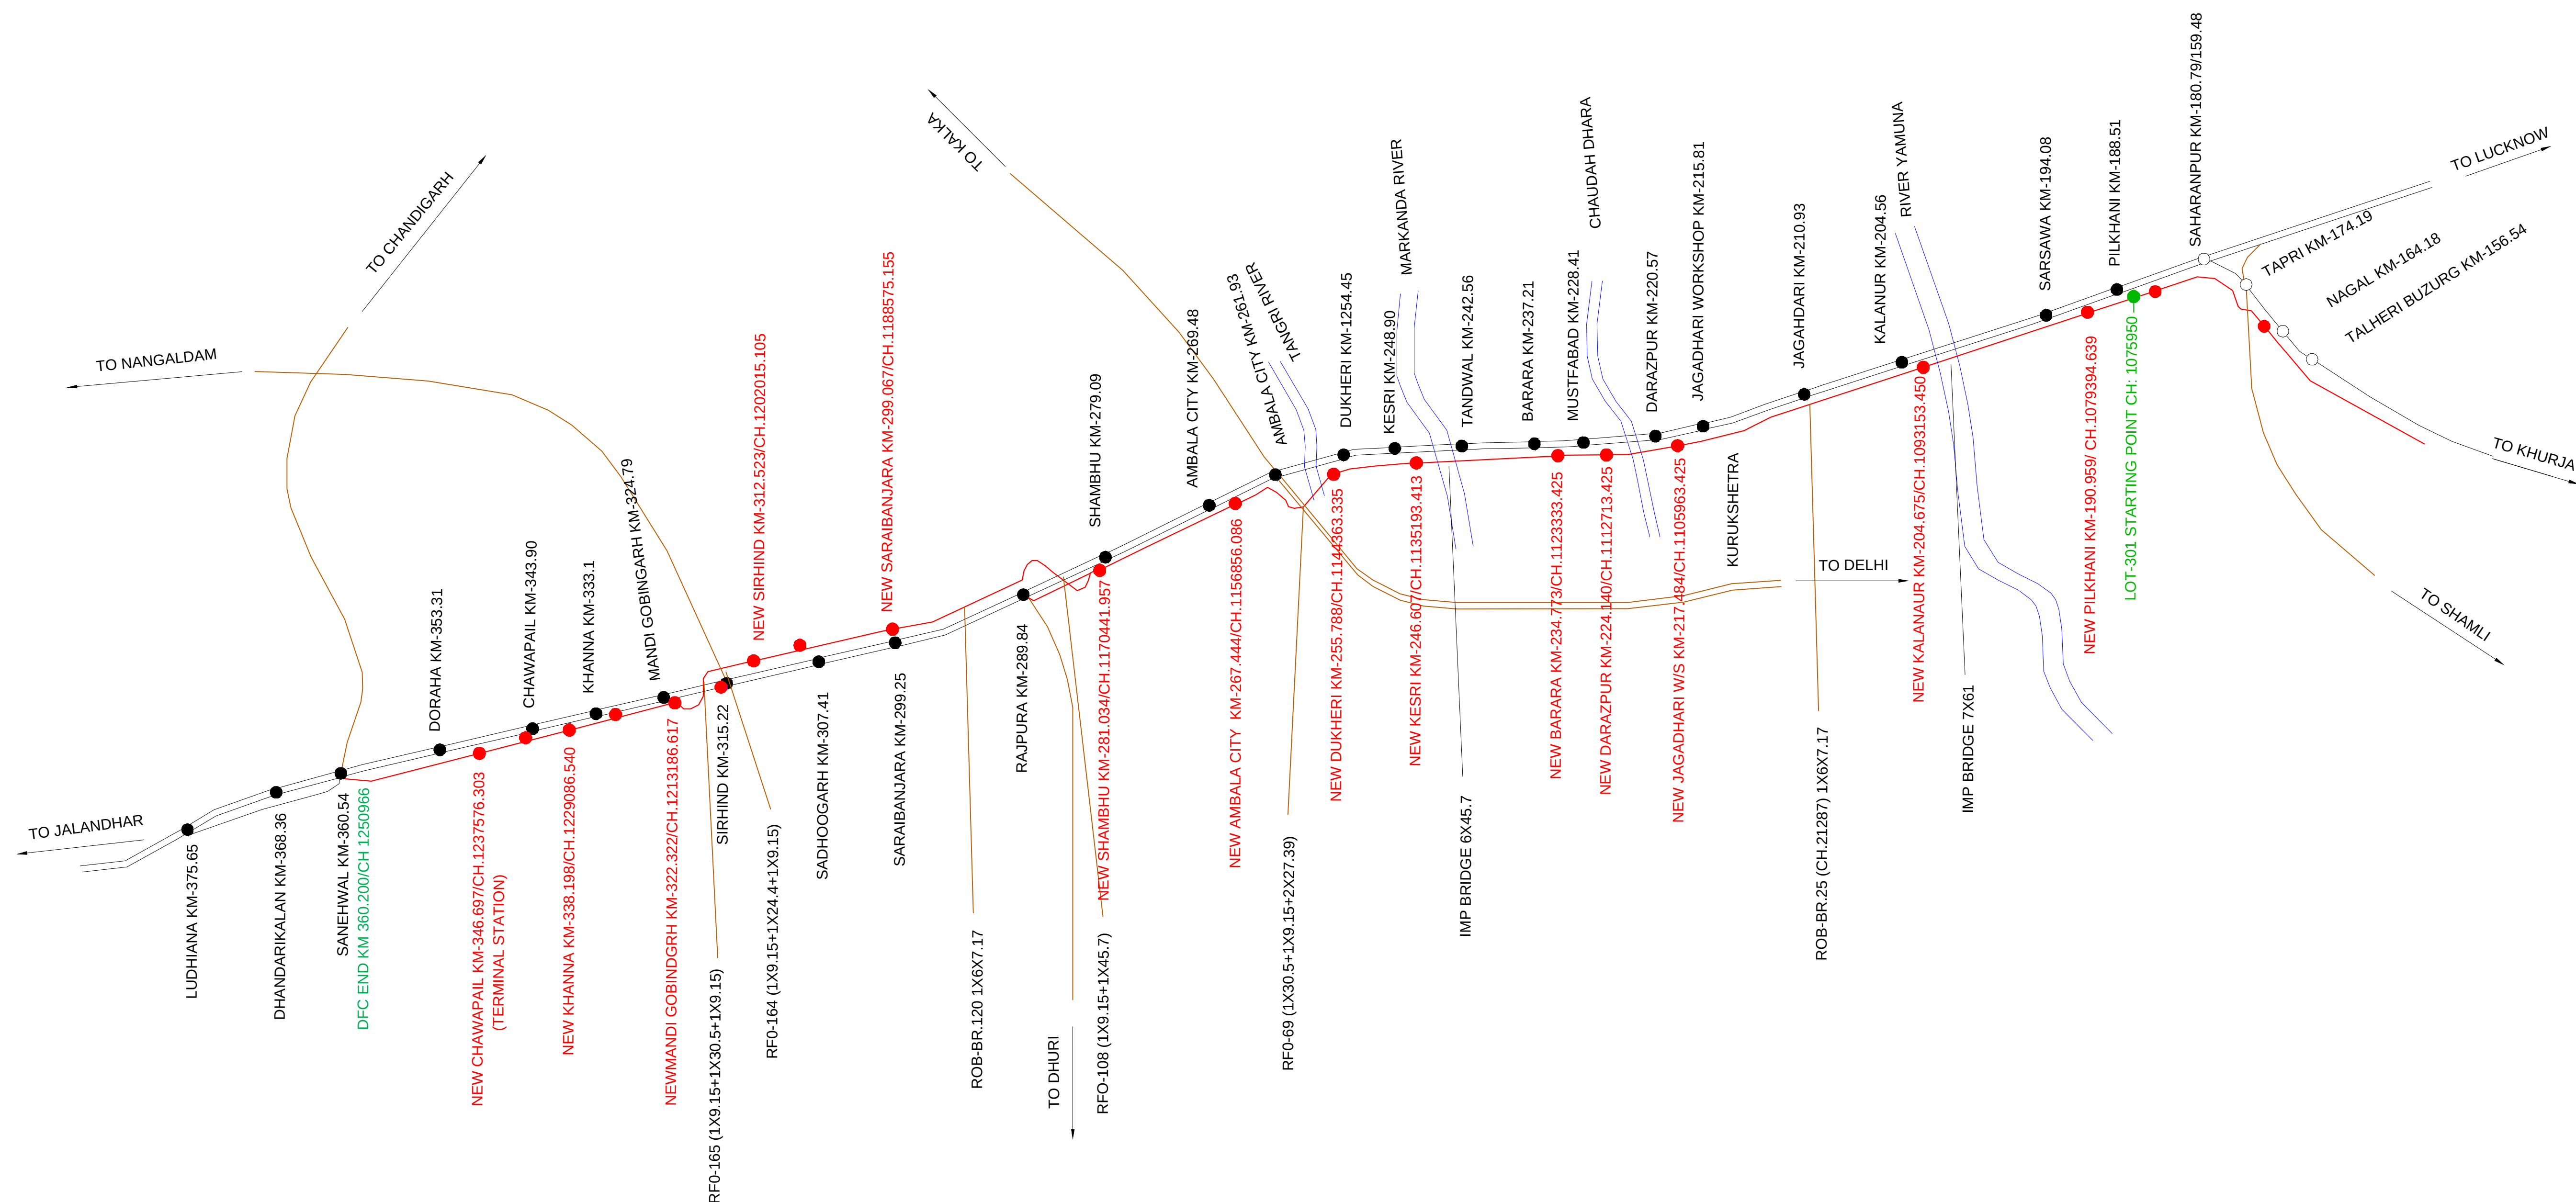

[illegible]

LEGEND	
EXISTING IR TRACK	
DFC TRACK	
DFC FUTURE PROPOSALS	
IR PROPOSALS	
TOE LINE	
FORMATION CESS	
RETAINING WALL	
DRAIN CUM RETAINING WALL	
ROAD	
STREAM, DRAIN, NALA, CANAL.	
FENCE	
POWER LINES	
GPS POINTS	
ELECTRIC POLE/OHE MAST	
EXISTING RAILWAY BOUNDARY	
DFC BOUNDARY	
DISMANTLED WORKS	
IOCL PIPE LINE	
IOCL ROW	
SIGNALLING CABLE PIPE	

ABBREVIATIONS		
1.	BL	- BED LEVEL
2.	BVC	- BEGIN OF VERTICAL CURVE
3.	Ca	- APPLIED CANT
4.	CCL	- CIRCULAR CURVE LENGTH
5.	CTP1	- COMMON TANGENT POINT
6.	CTP2	- COMMON TANGENT POINT
7.	DEGREE	- DEGREE OF CURVE
8.	DE	- DEAD END
9.	ECL	- EXISTING CLEARANCE
10.	EFB	- EXISTING FREE BOARD
11.	EFL	- EXISTING FORMATION LEVEL
12.	ERL	- EXISTING RAIL LEVEL
13.	ESL	- EXISTING SOFFIT LEVEL
14.	EVC	- END OF VERTICAL CURVE
15.	EVCL	- EXISTING VERTICAL CLEARANCE
16.	F/CSB	- FROM CENTER LINE OF STN BLDG
17.	FM	- FOULING MARK
18.	FSL	- FULL SUPPLY LEVEL
19.	HFL	- HIGH FLOOD LEVEL
20.	L	- STRAIGHT LENGTH
21.	LH	- LEFT HANDED
22.	LHS	- LIMITED HEIGHT SUBWAY
23.	PCL	- PROPOSED CLEARANCE
24.	PFB	- PROPOSED FREE BOARD
25.	PFL	- PROPOSED FORMATION LEVEL
26.	PRL	- PROPOSED RAIL LEVEL
27.	PSL	- PROPOSED SOFFIT LEVEL
28.	PVCL	- PROPOSED VERTICAL CLEARANCE
29.	PVI	- POINT OF VERTICAL INTERSECTION
30.	R	- RADIUS
31.	REV.BL	- REVISED BED LEVEL
32.	RH	- RIGHT HANDED
33.	Rr	- RESULTANT RADIUS
34.	SE	- SUPER ELEVATION
35.	SRJ	- STOCK RAIL JOINT
36.	TS	- TRAP SWITCH
37.	TTL	- TOTAL TANGENT LENGTH
38.	TTP1	- TRANSITION TANGENT POINT
39.	TTP2	- TRANSITION TANGENT POINT
40.	TL	- TRANSITION LENGTH
41.	DELTA	- DEFLECTION ANGLE

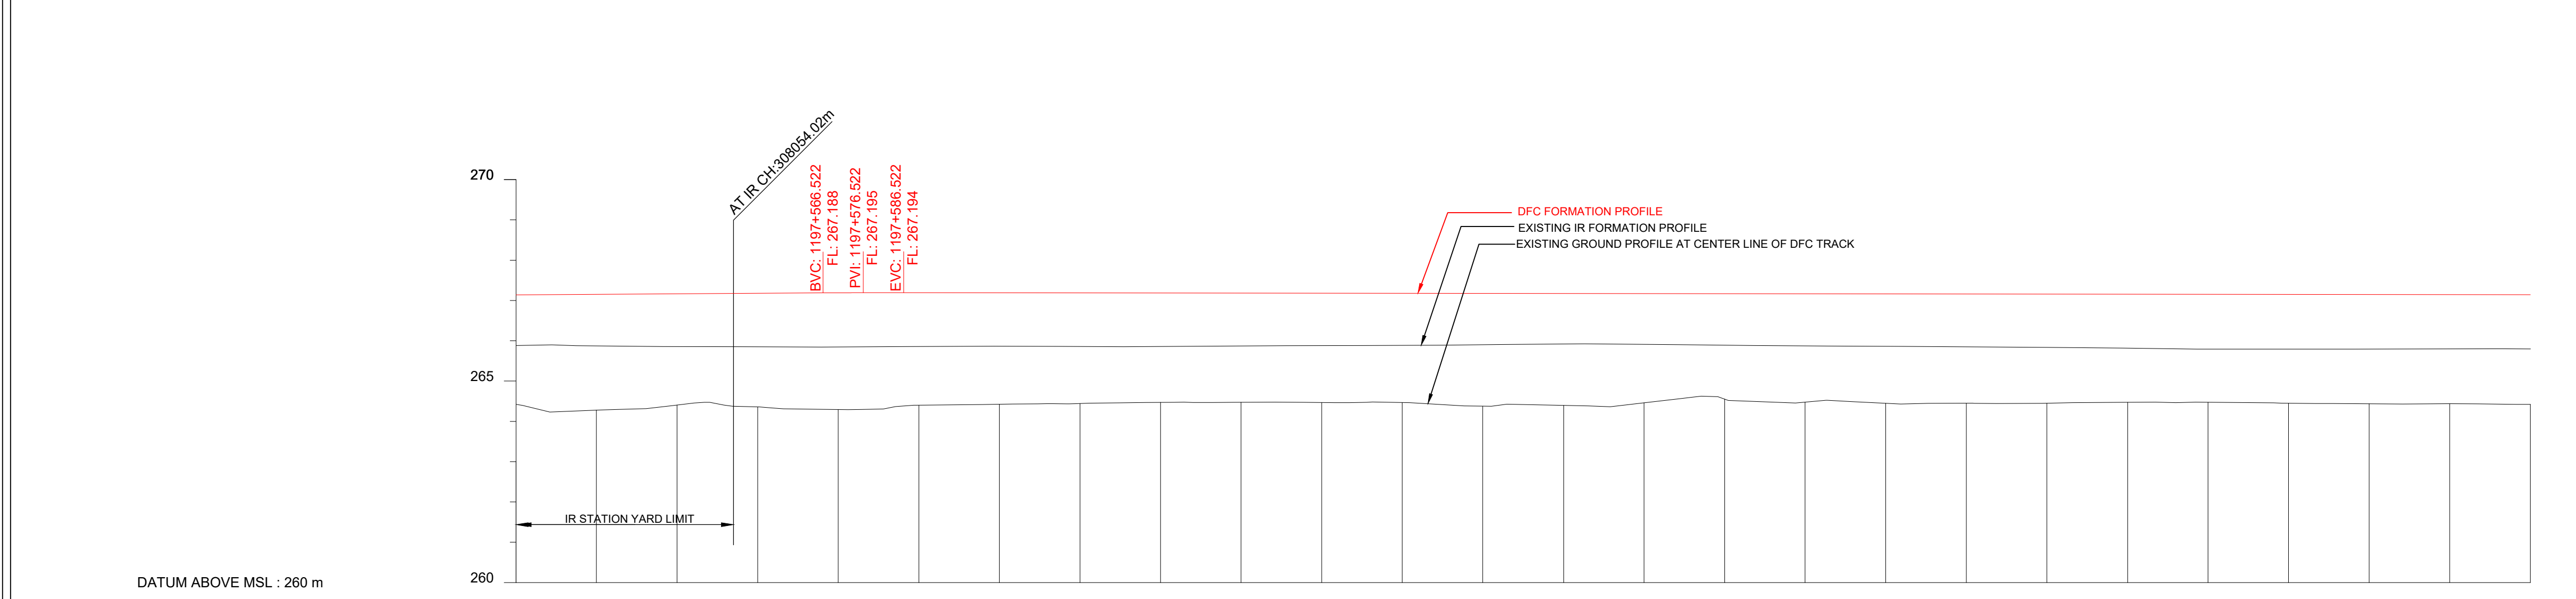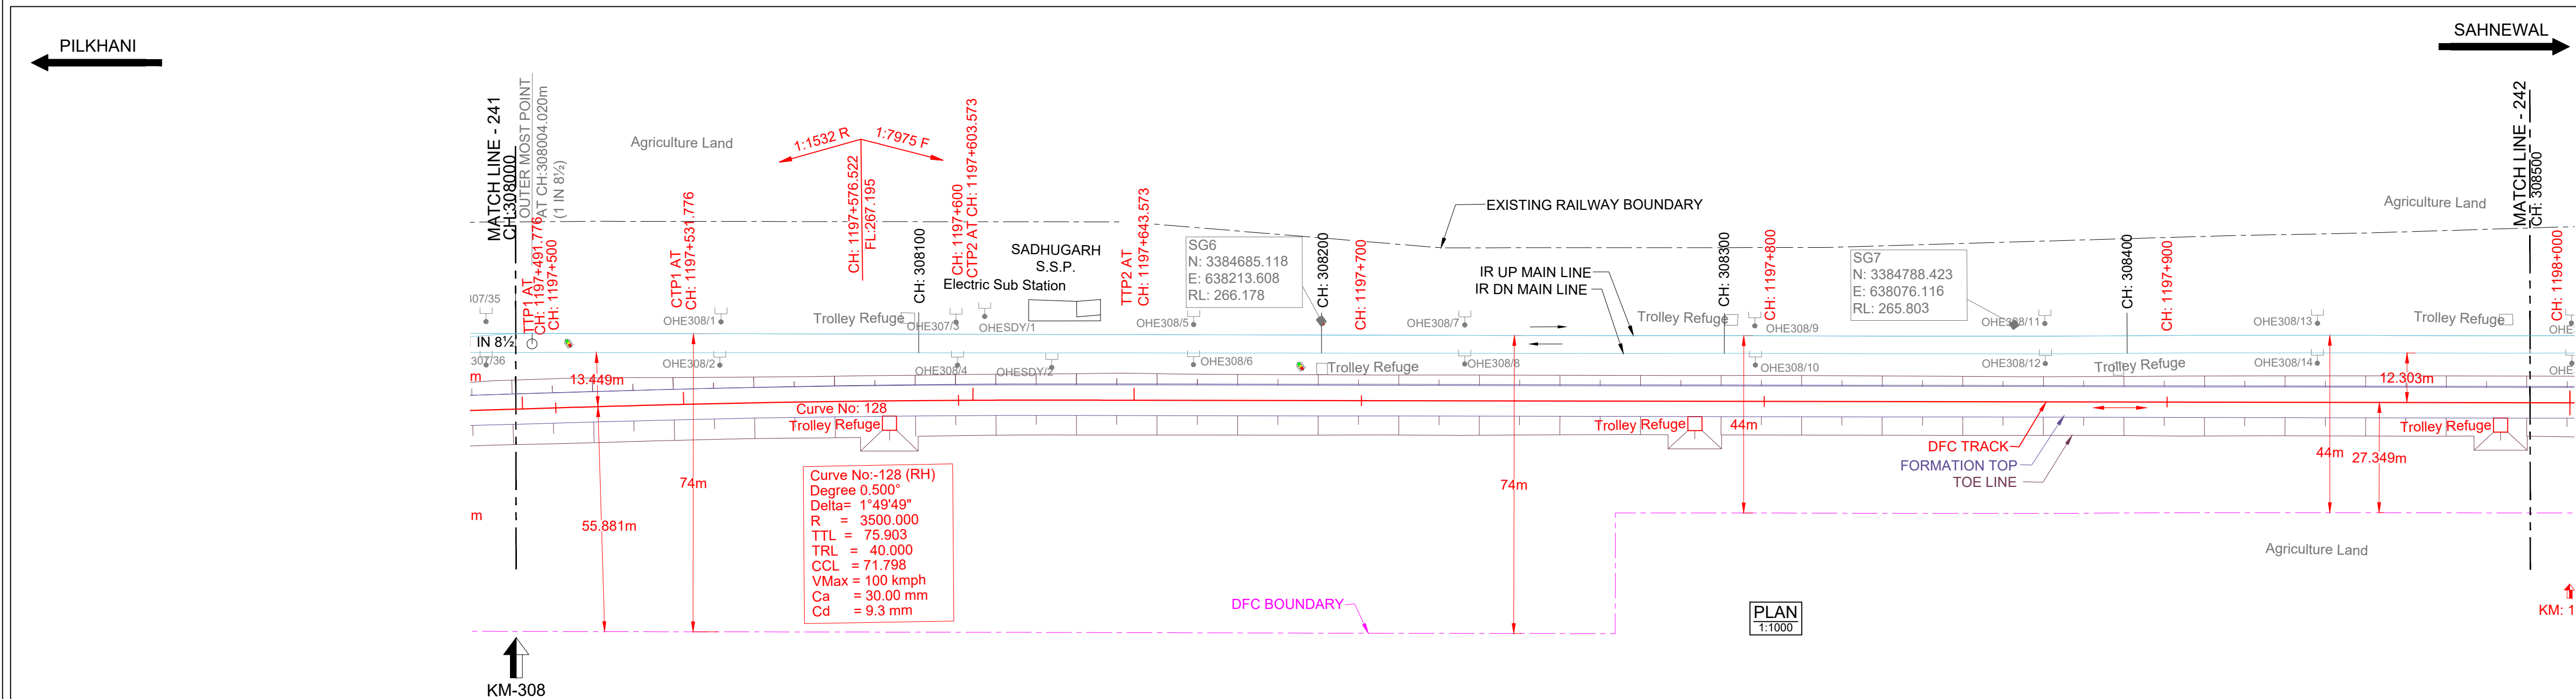

HORIZONTAL ALIGNMENT	TL=40 R = 3500 CC = 71.798 TL=40 L = 2263.954 m																									
VERTICAL ALIGNMENT	L=786.074 m 1 IN 1532.390 R L=20.0 m R=25707 m L=1476.005 m 1 IN 7974.823 F																									
TRACK DISTANCE FROM EXISTING NEAREST IR DN MAIN LINE TO DFC MAIN LINE	14.050	13.455	12.881	12.428	12.089	11.862	11.750	11.737	11.756	11.771	11.785	11.798	11.796	11.890	11.906	11.929	12.099	12.251	12.276	12.298	12.307	12.333				
HEIGHT OF BANKING(+) / DEPTH OF CUTTING(-) (PFL-GL)	+2.717	+2.872	+2.760	+2.819	+2.898	+2.792	+2.767	+2.745	+2.715	+2.711	+2.714	+2.710	+2.800	+2.714	+2.712	+2.709	+2.684	+2.679	+2.701	+2.711	+2.707	+2.722				
EXG GROUND LEVEL AT CENTER LINE OF DFC TRACK (GL)	264.422	264.280	264.405	264.359	264.293	264.401	264.424	264.443	264.471	264.472	264.467	264.468	264.376	264.449	264.449	264.449	264.472	264.474	264.450	264.437	264.439	264.421				
EXG GROUND LEVEL AT TOE LOCATION OF DFC TRACK	264.497	264.468	264.480	264.455	264.378	264.445	264.489	264.482	264.488	264.490	264.513	264.542	264.524	264.597	264.595	264.624	264.611	264.618	264.618	264.600	264.600	264.590				
DIFFERENCE BETWEEN DFC FORMATION LEVEL AND EXG.FORMATION LEVEL.(PFL-EFL)	1.257	1.280	1.310	1.327	1.344	1.337	1.327	1.331	1.328	1.311	1.300	1.292	1.274	1.300	1.312	1.324	1.340	1.358	1.356	1.352	1.347	1.345				
DFC FORMATION LEVEL (PFL)	267.139	267.152	267.165	267.178	267.191	267.193	267.191	267.188	267.186	267.183	267.181	267.178	267.176	267.163	267.161	267.158	267.156	267.153	267.151	267.148	267.146	267.143				
EXG. FORMATION LEVEL OF EXG IR DN MAIN LINE (EFL)	265.882	265.872	265.855	265.851	265.847	265.856	265.864	265.857	265.858	265.872	265.881	265.886	265.902	265.883	265.849	265.834	265.816	265.795	265.795	265.796	265.799	265.798				
DIFFERENCE BETWEEN DFC RAIL LEVEL AND EXG. RAIL LEVEL (PRL - ERL)	1.298	1.320	1.351	1.368	1.395	1.378	1.367	1.372	1.368	1.352	1.340	1.333	1.315	1.341	1.352	1.365	1.381	1.399	1.397	1.394	1.388	1.386				
DFC RAIL LEVEL (PRL)	267.852	267.865	267.878	267.891	267.904	267.906	267.904	267.901	267.899	267.886	267.884	267.879	267.876	267.876	267.874	267.871	267.869	267.866	267.864	267.861	267.859	267.856				
EXG.RAIL LEVEL OF NEAREST IR DN MAIN LINE(ERL)	266.554	266.544	266.527	266.523	266.519	266.528	266.536	266.529	266.530	266.544	266.553	266.558	266.574	266.535	266.521	266.506	266.488	266.467	266.467	266.468	266.471	266.470				
EQUIVALENT CHAINAGE ON DFC TRACK	308000.0	308020.0	308040.0	308060.0	308080.0	308100.0	308120.0	308140.0	308160.0	308180.0	308200.0	308220.0	308240.0	308260.0	308280.0	308300.0	308320.0	308340.0	308360.0	308380.0	308400.0	308420.0	308440.0	308460.0	308480.0	308500.0
EXISTING IR CHAINAGE	308000.0	308020.0	308040.0	308060.0	308080.0	308100.0	308120.0	308140.0	308160.0	308180.0	308200.0	308220.0	308240.0	308260.0	308280.0	308300.0	308320.0	308340.0	308360.0	308380.0	308400.0	308420.0	308440.0	308460.0	308480.0	308500.0

L - SECTION

NOTE:-

- DFCC WORKS ARE SHOWN IN RED.
- IR NEW WORKS ARE SHOWN IN VIOLET.
- ALL DIMENSIONS ARE SHOWN IN METRES.
- THIS DRAWING IS PREPARED BASED ON LATEST SURVEY DATA HELD ON APRIL-2022. GTS BENCH MARK OF 261.850M CONSIDERED ON TOP OF CANAL BRIDGE ABUTMENT AT DORAHA VILLAGE ALONG THE NH1.
- DFC NEW CHAINAGE OF 1075.950M IS WITH REFERENCE TO THE IR KM OF 187.500KM END OF KM OF CP-303(SECTION P-3 PILKHANI END) AGAINST THE EXISTING DFC CHAINAGE. 116277.742M ISSUED VIDE LETTER NO. COM/DFCC/UM/SURVEY/2021-301-230116-011173.DT. 17.01.2023.
- BALLAST PROFILE HAS BEEN PROVIDED ACCORDING TO THE CLAUSE 1.11.3 OF STANDARD SCHEDULE OF DIMENSION(EASTERN CORRIDOR) & THE BALLAST CUSHION DIMENSION SHOWN IN 35CM ON GE-14 PARA 17. SPECIFICATIONS & RECOMMENDATIONS 2. TWO LAYER SYSTEM FIG.10.

REFERENCE DRAWINGS :-

- FOR KEY PLAN REFER DRAWING NO. 301-2/AL/0001
- FOR LEGEND AND ABBREVIATIONS REFER DRAWING NO. 301-2/AL/1000
- FOR TYPICAL SECTION OF BALLAST PROFILE (FL-RL) REFER DRG. NO. 301-2/TK/TFDI-004 (TR.1952)

012.09.2024SUBMISSION OF AS-BUILT DRAWINGFOR APPROVAL

REV. DATE REVISION DETAILS PURPOSE OF ISSUE

SCALE
HOR - 1:1000
VER - 1:100
SHEET SIZE : A1

LEGEND:

- IR TRACK
- DFCC TRACK
- DFCC FUTURE PROPOSALS
- STRUCTURE / BUILDING
- DFCC TOE LINE
- DFCC FORMATION
- RETAINING WALL
- ROAD
- STREAM, DRAIN, NALA, CANAL.
- FENCE
- POWER LINES
- TBM
- ELECTRIC POLE/OHE MAST
- IR RAILWAY BOUNDARY
- DFCC BOUNDARY

TYPICAL SECTION

TRACK STRUCTURE

RAIL SECTION: 60Kg/m (UIC 60Kg/m)	Difference between FL- RL (Below Rail Seat)	
DFC LINE: 60Kg/m (UIC 60Kg/m)	IR Line	DFC
IR MAIN LINE: 52Kg/m	172mm	172mm
RUBBER PAD	6mm	10mm
SLEEPER DEPTH	210mm	210mm
BALLAST CUSHION	300mm	350mm
Total Depth (FL TO RL)	688mm	742mm

OWNER
DEDICATED FREIGHT CORRIDOR CORPORATION OF INDIA LTD.
(A GOVERNMENT OF INDIA ENTERPRISE)
PROJECT OFFICE(AMBALA UNIT): OLD RAILWAY COLONY (NEAR ANAND MARKET),AMBALA CANTT-133001.
CORPORATE IDENTITY NO. : U60232DL2006GGI155068

ENGINEER:
DB Engineering & Consulting GmbH
Deutsche Bahn Engineering & Consulting GmbH

CONTRACTOR:
GIL - TPL JV
GAR TATA

SUBMITTED BY	GIL - TPL JV		
PREPARED BY	DATED	NAME	SIGNATURE
CHECKED BY	12.09.2024	VIJAY PRATAP	
APPROVED BY	12.09.2024	PARASURAM KOTYADA	
APPROVED BY	DEUTSCHE BAHN ENGINEERING & CONSULTING GMBH		
	DATED	NAME	SIGNATURE
Sr. DE./CHIEF ENGINEER		SURESH K.YALANGI	
CHIEF TRACK ENGINEER		RAJ PAL SINGH	
T.L.		H.D. VIDJAK	


STAMP
A AS-BUILT DRAWING
TR. Ref.....
ENGINEER Sign.:

EMPLOYER (DFCCIL): DEDICATED FREIGHT CORRIDOR CORPORATION OF INDIA LTD.

AS BUILT DRAWING

TITLE AS-BUILT PLAN AND PROFILE	DFCC APPR. NO. - ENGG. APPR. NO. -
FROM IR KM: 308.000 TO 308.500 DFC KM: 1197.490 TO 1197.990	DRG. NO. - 301-2/AL/A/1242 SHEET NO. : 1 OF 1 DATE : 12.09.2024
	STATUS A

TR.

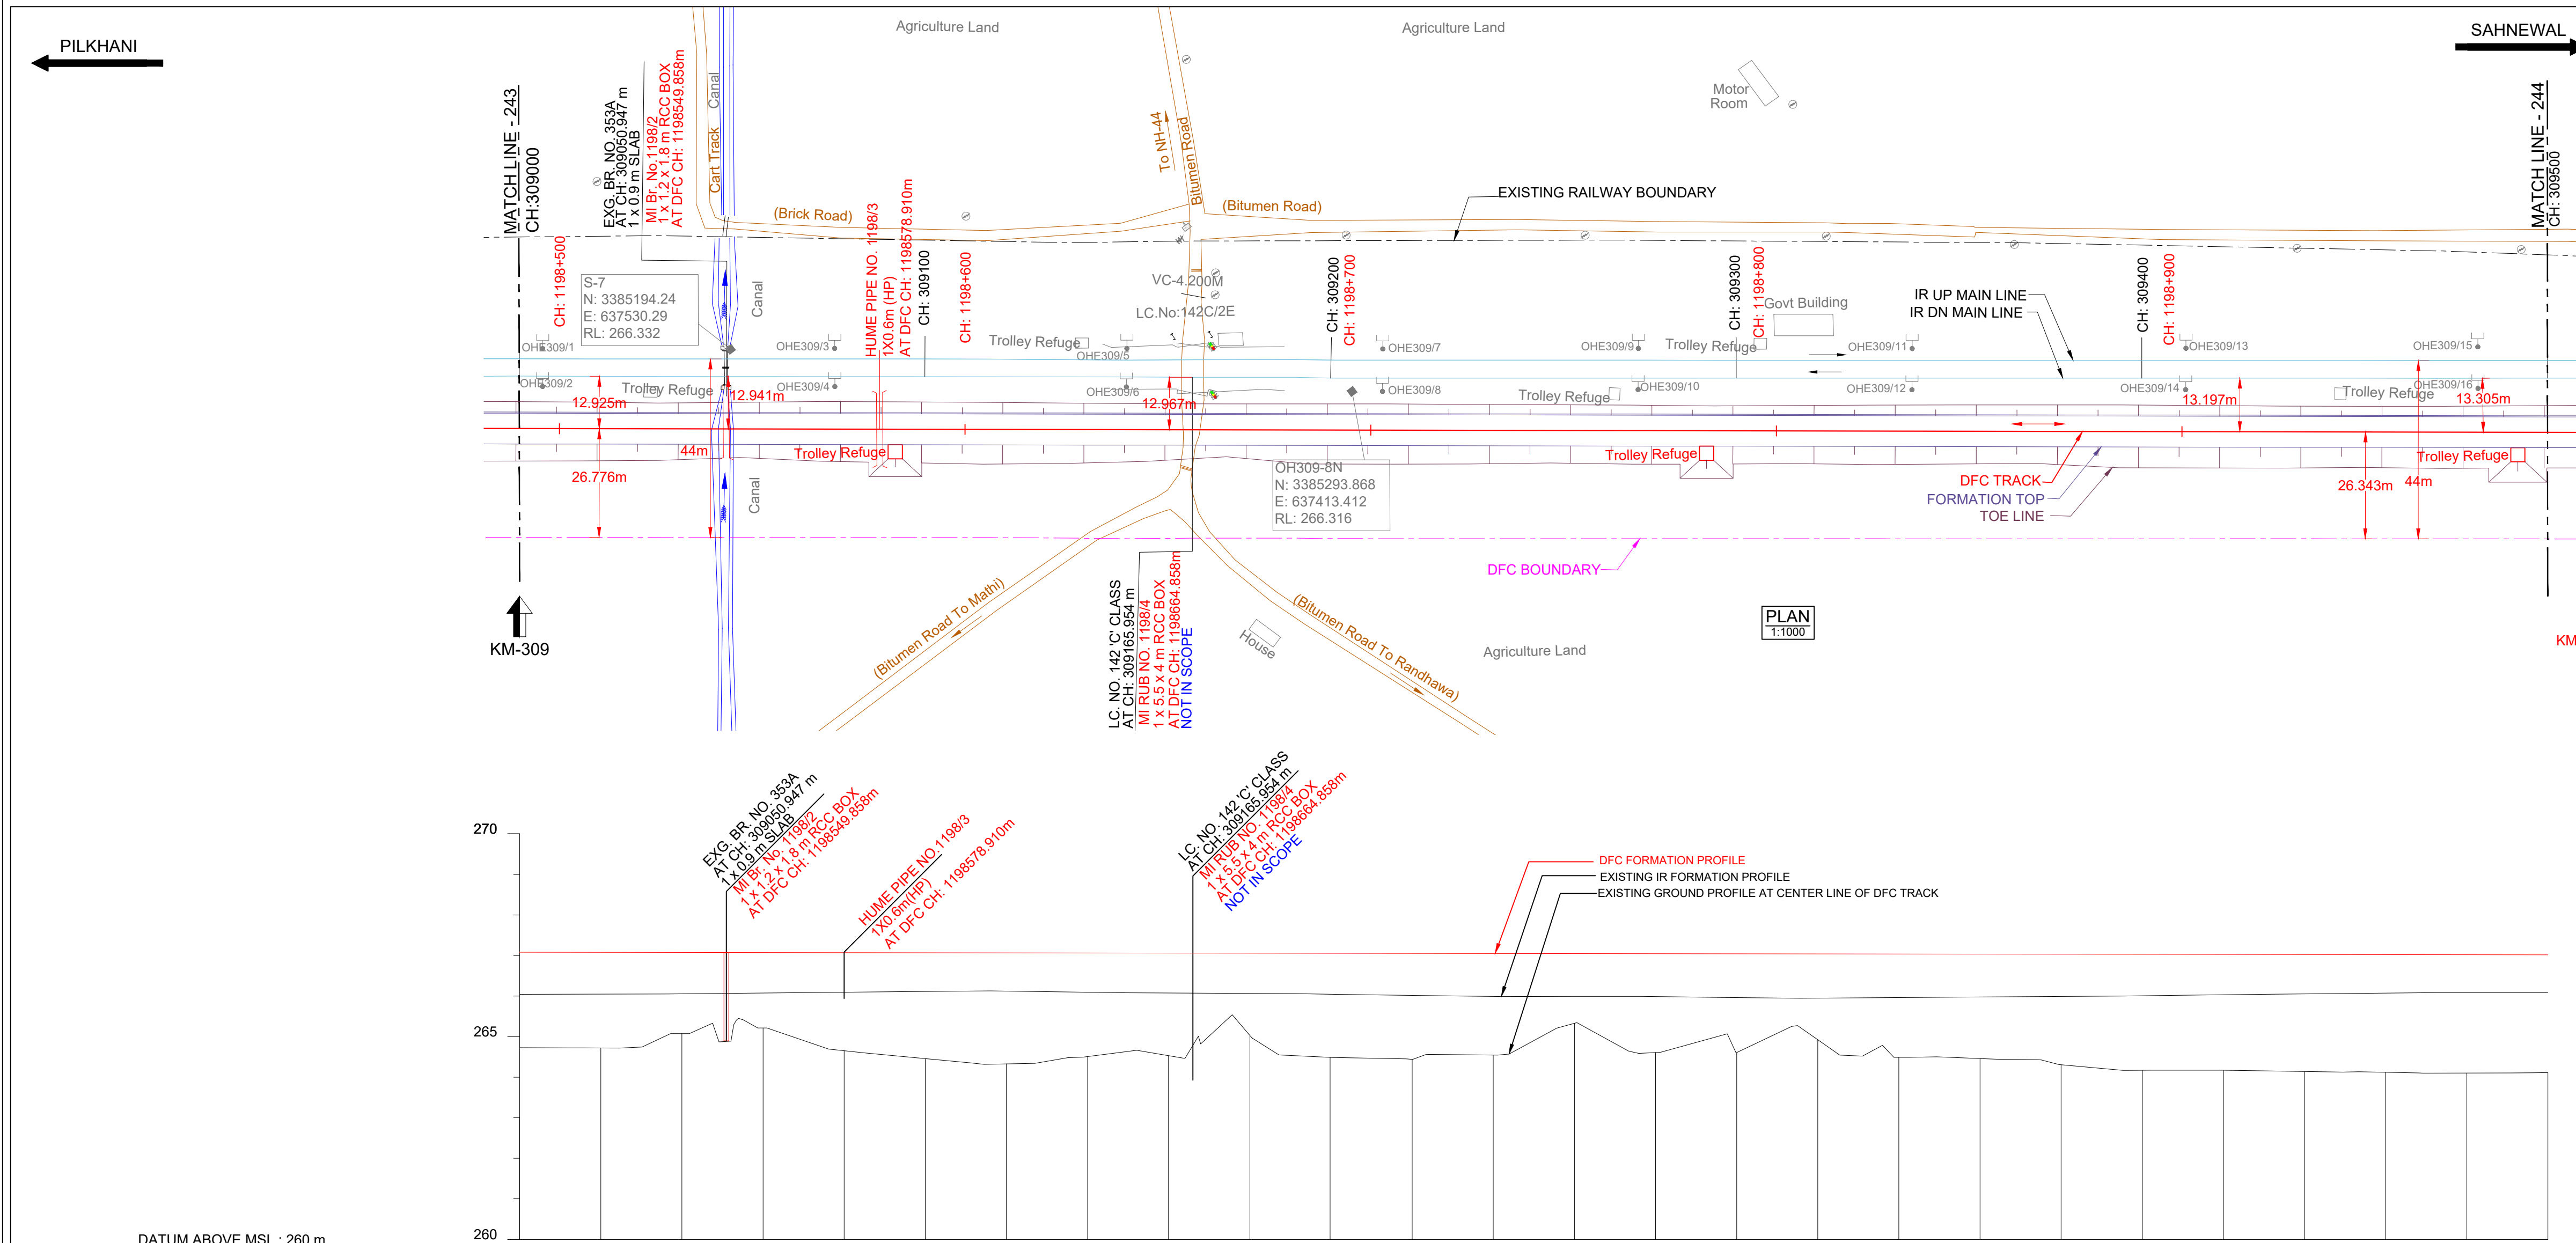


DATUM ABOVE MSL : 260 m

HORIZONTAL ALIGNMENT	L = 2263.954 m																			
VERTICAL ALIGNMENT	L=1476.005 m 1 IN 7974.823 F																			
TRACK DISTANCE FROM EXISTING NEAREST IR DN MAIN LINE TO DFC MAIN LINE	12.922	12.925	12.931	12.949	12.968	12.986	13.003	13.012	12.984	12.973	12.819	12.844	12.888	12.917	12.945	12.977	13.010	13.046	13.082	13.118
HEIGHT OF BANKING(+) / DEPTH OF CUTTING(-) (PFL-GL)	+2.354	+2.357	+2.002	+1.889	+2.416	+2.811	+2.737	+2.553	+2.528	+2.028	+2.565	+2.811	+2.502	+1.718	+2.438	+2.437	+2.116	+2.549	+2.575	+2.726
EXG GROUND LEVEL AT CENTER LINE OF DFC TRACK (GL)	-264.726	-264.721	-265.073	-265.215	-264.654	-264.457	-264.328	-264.574	-264.532	-265.030	-264.490	-264.442	-264.548	-265.330	-264.607	-264.606	-264.599	-264.924	-264.480	-264.307
EXG GROUND LEVEL AT TOE LOCATION OF DFC TRACK	-264.695	-264.747	-264.911	-265.044	-264.688	-264.523	-264.423	-264.574	-264.933	-265.100	-264.475	-264.491	-264.546	-265.615	-264.532	-264.567	-264.589	-264.924	-264.480	-264.307
DIFFERENCE BETWEEN DFC FORMATION LEVEL AND EXG.FORMATION LEVEL (PFL-EFL)	1.038	1.029	1.019	0.997	0.974	0.952	0.943	0.969	0.984	0.992	1.012	1.035	1.057	1.055	1.057	1.079	1.090	1.073	1.056	1.042
DFC FORMATION LEVEL (PFL)	-267.080	-267.078	-267.075	-267.073	-267.070	-267.068	-267.065	-267.063	-267.060	-267.058	-267.055	-267.053	-267.050	-267.048	-267.045	-267.043	-267.040	-267.038	-267.035	-267.033
EXG. FORMATION LEVEL OF EXG IR DN MAIN LINE (EFL)	-266.042	-266.049	-266.056	-266.076	-266.096	-266.116	-266.122	-266.094	-266.076	-266.066	-266.043	-266.018	-265.993	-265.993	-265.988	-265.964	-265.950	-265.965	-265.979	-265.991
DIFFERENCE BETWEEN DFC RAIL LEVEL AND EXG. RAIL LEVEL (PRL - ERL)	1.080	1.070	1.081	1.038	1.015	0.993	0.984	1.010	1.026	1.033	1.053	1.076	1.098	1.095	1.099	1.119	1.131	1.114	1.097	1.083
DFC RAIL LEVEL (PRL)	-267.793	-267.791	-267.788	-267.786	-267.783	-267.781	-267.778	-267.776	-267.773	-267.771	-267.768	-267.766	-267.763	-267.761	-267.758	-267.756	-267.753	-267.751	-267.748	-267.746
EXG.RAIL LEVEL OF NEAREST IR DN MAIN LINE(ERL)	-266.714	-266.721	-266.728	-266.748	-266.768	-266.788	-266.794	-266.766	-266.748	-266.738	-266.715	-266.690	-266.665	-266.665	-266.660	-266.636	-266.622	-266.637	-266.651	-266.663
EQUIVALENT CHAINAGE ON DFC TRACK	309000.0	309020.0	309040.0	309060.0	309080.0	309100.0	309120.0	309140.0	309160.0	309180.0	309200.0	309220.0	309240.0	309260.0	309280.0	309300.0	309320.0	309340.0	309360.0	309380.0
EXISTING IR CHAINAGE	309000.0	309020.0	309040.0	309060.0	309080.0	309100.0	309120.0	309140.0	309160.0	309180.0	309200.0	309220.0	309240.0	309260.0	309280.0	309300.0	309320.0	309340.0	309360.0	309380.0

L - SECTION

SAHNEWAL

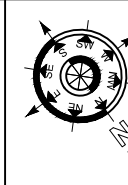

- NOTE:-
1. DFC WORKS ARE SHOWN IN RED.
 2. IR NEW WORKS ARE SHOWN IN VIOLET.
 3. ALL DIMENSIONS ARE SHOWN IN METRES.
 4. THIS DRAWING IS PREPARED BASED ON LATEST SURVEY DATA HELD ON APRIL-2022. GTS BENCH MARK OF 261.850M CONSIDERED ON TOP OF CANAL BRIDGE ABUTMENT AT DORAH VILLAGE ALONG THE NH1.
 5. DFC NEW CHAINAGE OF 1075.950M IS WITH REFERENCE TO THE IR KM OF 187.500KM END OF KM OF CP-303(SECTION P-3 PILKHANI END) AGAINST THE EXISTING DFC CHAINAGE. 116277.742M ISSUED VIDE LETTER NO. COM/DFCC/MB/SURVEY/2021-301-230116-011173 DT. 17.01.2023.
 6. BALLAST PROFILE HAS BEEN PROVIDED ACCORDING TO THE CLAUSE 1.11.3 OF STANDARD SCHEDULE OF DIMENSION(EASTERN CORRIDOR) & THE BALLAST CUSHION DIMENSION SHOWN IN 35CM ON GE-14 PARA 17. SPECIFICATIONS & RECOMMENDATIONS 2. TWO LAYER SYSTEM FIG.10.

REFERENCE DRAWINGS :-


1. FOR KEY PLAN REFER DRAWING NO. 301-2/AL/0001
2. FOR LEGEND AND ABBREVIATIONS REFER DRAWING NO. 301-2/AL/1000
3. FOR TYPICAL SECTION OF BALLAST PROFILE (FL-RL) REFER DRG. NO. 301-2/TK/TFD/004 (TR.1952)

REV.	DATE	REVISION DETAILS	PURPOSE OF ISSUE
0	12.09.2024	SUBMISSION OF AS-BUILT DRAWING	FOR APPROVAL

LEGEND:

IR TRACK
DFCC TRACK
DFCC FUTURE PROPOSALS
STRUCTURE / BUILDING
DFCC TOE LINE
DFCC FORMATION
RETAINING WALL
ROAD
STREAM, DRAIN, NALA, CANAL.
FENCE
POWER LINES
TBM
ELECTRIC POLE/OHE MAST
IR RAILWAY BOUNDARY
DFCC BOUNDARY

SCALE
HOR - 1:1000
VER - 1:100
SHEET SIZE : A1

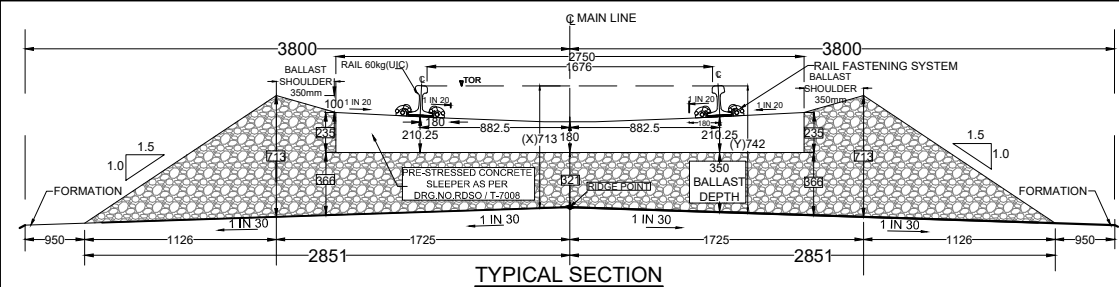

TRACK STRUCTURE		
RAIL SECTION: 60Kg/m (UIC 60Kg/m) DFC LINE: 60Kg/m (UIC 60Kg/m) IR MAIN LINE: 52Kg/m	Difference between FL- RL (Below Rail Seat)	
	IR Line	DFC
RUBBER PAD	172mm	172mm
SLEEPER DEPTH	6mm	10mm
BALLAST CUSHION	210mm	210mm
Total Depth (FL TO RL)	300mm	350mm
	688mm	742mm

OWNER
DEDICATED FREIGHT CORRIDOR CORPORATION OF INDIA LTD.
(A GOVERNMENT OF INDIA ENTERPRISE)
PROJECT OFFICE/AMBALA UNIT: OLD RAILWAY COLONY (NEAR ANAND MARKET), AMBALA CANTT-133001.
CORPORATE IDENTITY NO. : U60232DL2006GGI155068

ENGINEER:
DB Engineering & Consulting GmbH
Deutsche Bahn Engineering & Consulting GmbH

CONTRACTOR:
GIL - TPL JV
GAR TATA


SUBMITTED BY	GIL - TPL JV		
	DATED	NAME	SIGNATURE
PREPARED BY	12.09.2024	VIJAY PRATAP	
CHECKED BY	12.09.2024	PARASURAM KOTYADA	
APPROVED BY	12.09.2024	PARASURAM KOTYADA	

APPROVED BY	DEUTSCHE BAHN ENGINEERING & CONSULTING GMBH		
	DATED	NAME	SIGNATURE
Sr. DE./CHIEF ENGINEER		SURESH K.YALANGI	
CHIEF TRACK ENGINEER		RAJ PAL SINGH	
T.L.		H.D. VIDJAK	

STAMP	A AS-BUILT DRAWING TR. Ref.:..... ENGINEER Sign.:.....		
EMPLOYER (DFCCIL):	DEDICATED FREIGHT CORRIDOR CORPORATION OF INDIA LTD.		

AS BUILT DRAWING			
TITLE	AS-BUILT PLAN AND PROFILE		
FROM IR KM: 309.000 TO 309.500	DFC KM: 1198.490 TO 1198.990		
DFCC APPR. NO. -	ENGG. APPR. NO. -	DRG. NO. - 301-2/AL/A/1244	STATUS A
SHEET NO. : 1 OF 1	DATE : 12.09.2024		


TR.

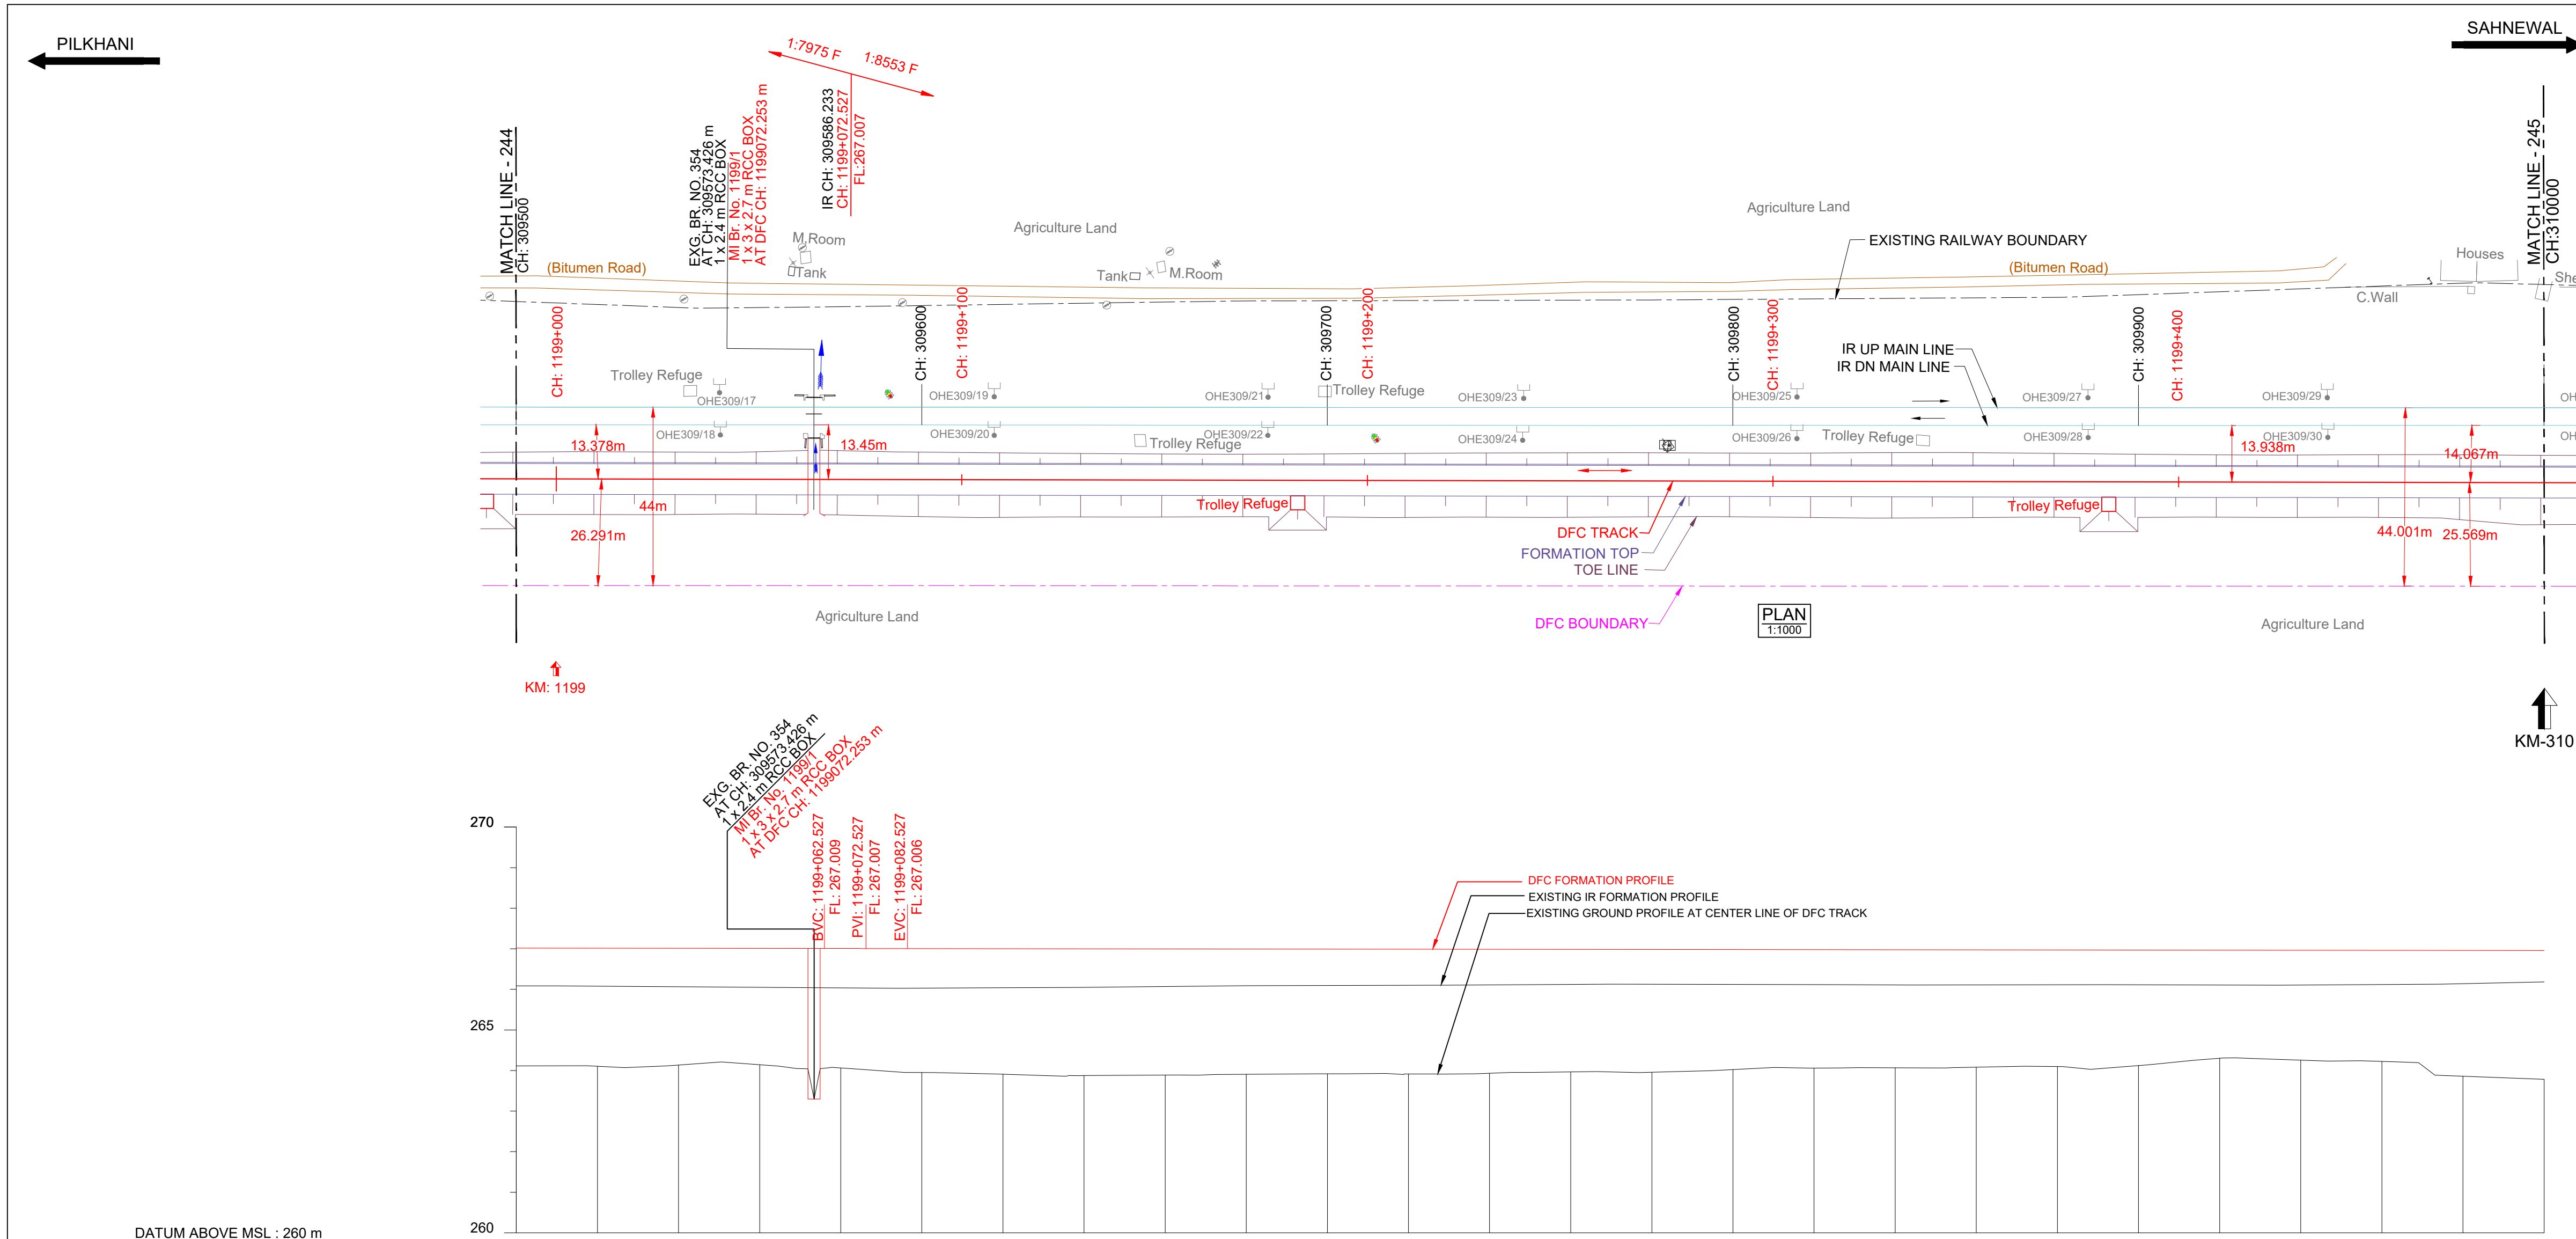

HORIZONTAL ALIGNMENT	L = 2263.954 m																																																		
VERTICAL ALIGNMENT	L=1476.005 m 1 IN 7974.823 F L=20.0 m R=2360503 m L=1485.963m 1 IN 8552.720 F																																																		
TRACK DISTANCE FROM EXISTING NEAREST IR DN MAIN LINE TO DFC MAIN LINE	13.335		13.372		13.402		13.432		13.462		13.487		13.500		13.516		13.546		13.570		13.597		13.624		13.643		13.655		13.692		13.753		13.794		13.815		13.833		13.851		13.882		13.929		13.974		14.016		14.056		14.092
HEIGHT OF BANKING(+) / DEPTH OF CUTTING(-) (PFL-GL)	+2.906		+2.912		+2.877		+2.867		+2.945		+3.055		+3.095		+3.124		+3.111		+3.089		+3.075		+3.078		+3.056		+3.022		+3.028		+2.958		+2.922		+2.912		+2.847		+2.665		+2.709		+2.739		+3.101		+3.174				
EXG GROUND LEVEL AT CENTER LINE OF DFC TRACK (GL)	264.112		264.103		264.136		264.143		264.063		263.950		263.908		263.877		263.887		263.907		263.919		263.913		263.933		263.965		263.956		264.024		264.058		264.065		264.082		264.303		264.257		264.224		263.880		263.785				
EXG GROUND LEVEL AT TOE LOCATION OF DFC TRACK	264.235		264.254		264.278		264.332		264.238		264.065		263.974		264.042		264.057		264.108		264.105		264.053		264.102		264.133		264.171		264.196		264.133		264.082		264.238		264.232		263.958		263.985		263.785						
DIFFERENCE BETWEEN DFC FORMATION LEVEL AND EXG FORMATION LEVEL (PFL-EFL)	0.931		0.936		0.947		0.958		0.970		0.974		0.963		0.950		0.928		0.907		0.899		0.890		0.879		0.866		0.858		0.859		0.862		0.867		0.861		0.860		0.845		0.821		0.774						
DFC FORMATION LEVEL (PFL)	267.016		267.015		267.013		267.010		267.008		267.005		267.003		267.001		266.998		266.996		266.994		266.991		266.989		266.987		266.984		266.982		266.980		266.977		266.975		266.968		266.966		266.963		266.961		266.959				
EXG FORMATION LEVEL OF EXG IR DN MAIN LINE (EFL)	266.087		266.079		266.066		266.052		266.038		266.031		266.040		266.051		266.070		266.089		266.095		266.101		266.110		266.121		266.126		266.123		266.118		266.110		266.111		266.107		266.106		266.118		266.140		266.185				
DIFFERENCE BETWEEN DFC RAIL LEVEL AND EXG RAIL LEVEL (PRL - ERL)	0.972		0.977		0.988		1.000		1.011		1.015		1.003		0.991		0.969		0.948		0.939		0.931		0.919		0.906		0.899		0.899		0.902		0.907		0.904		0.899		0.901		0.886		0.862		0.815				
DFC RAIL LEVEL (PRL)	267.731		267.728		267.726		267.723		267.721		267.718		267.716		267.713		267.711		267.709		267.706		267.704		267.702		267.699		267.697		267.695		267.692		267.689		267.688		267.685		267.681		267.678		267.676		267.673		267.671		
EXG RAIL LEVEL OF NEAREST IR DN MAIN LINE (ERL)	266.759		266.751		266.738		266.724		266.710		266.703		266.712		266.723		266.742		266.761		266.767		266.773		266.782		266.793		266.798		266.795		266.790		266.782		266.779		266.778		266.779		266.790		266.812		266.857				
EQUIVALENT CHAINAGE ON DFC TRACK	309500.0		309520.0		309540.0		309560.0		309580.0		309600.0		309620.0		309640.0		309660.0		309680.0		309700.0		309720.0		309740.0		309760.0		309780.0		309800.0		309820.0		309840.0		309860.0		309880.0		309900.0		309920.0		309940.0		309960.0		309980.0		310000.0
EXISTING IR CHAINAGE	309500.0		309520.0		309540.0		309560.0		309580.0		309600.0		309620.0		309640.0		309660.0		309680.0		309700.0		309720.0		309740.0		309760.0		309780.0		309800.0		309820.0		309840.0		309860.0		309880.0		309900.0		309920.0		309940.0		309960.0		309980.0		310000.0

L - SECTION

SAHNEWAL

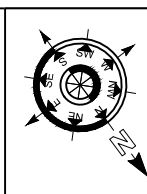


- NOTE:-
- DFCC WORKS ARE SHOWN IN RED.
 - IR NEW WORKS ARE SHOWN IN VIOLET.
 - ALL DIMENSIONS ARE SHOWN IN METRES.
 - THIS DRAWING IS PREPARED BASED ON LATEST SURVEY DATA HELD ON APRIL-2022. GTS BENCH MARK OF 261.850M CONSIDERED ON TOP OF CANAL BRIDGE ABUTMENT AT DORANA VILLAGE ALONG THE NH1.
 - DFC NEW CHAINAGE OF 1075.950M IS WITH REFERENCE TO THE IR KM OF 187.500KM END OF KM OF CP-303(SECTION P-3 PILKHANI END) AGAINST THE EXISTING DFC CHAINAGE. 116277.742M ISSUED VIDE LETTER NO. COM/DFCC/UM/SURVEY/2021-301-230116-011173 DT. 17.01.2023.
 - BALLAST PROFILE HAS BEEN PROVIDED ACCORDING TO THE CLAUSE 1.11.3 OF STANDARD SCHEDULE OF DIMENSION(EASTERN CORRIDOR) & THE BALLAST CUSHION DIMENSION SHOWN IN 35CM ON GE-14 PARA 17. SPECIFICATIONS & RECOMMENDATIONS 2. TWO LAYER SYSTEM FIG.10.

REFERENCE DRAWINGS:-

- FOR KEY PLAN REFER DRAWING NO. 301-2/AL/0001
- FOR LEGEND AND ABBREVIATIONS REFER DRAWING NO. 301-2/AL/1000
- FOR TYPICAL SECTION OF BALLAST PROFILE (FL-RL) REFER DRG. NO. 301-2/TK/TFD/004 (TR.1952)

REV.	DATE	REVISION DETAILS	PURPOSE OF ISSUE
0	12.09.2024	SUBMISSION OF AS-BUILT DRAWING	FOR APPROVAL
LEGEND:			
SCALE			
HOR - 1:1000			
VER - 1:100			
SHEET SIZE : A1			
IR TRACK			
DFCC TRACK			
DFCC FUTURE PROPOSALS			
STRUCTURE / BUILDING			
DFCC TOE LINE			
DFCC FORMATION			
RETAINING WALL			
ROAD			
STREAM, DRAIN, NALA, CANAL			
FENCE			
POWER LINES			
TBM			
ELECTRIC POLE/OHE MAST			
IR RAILWAY BOUNDARY			
DFCC BOUNDARY			

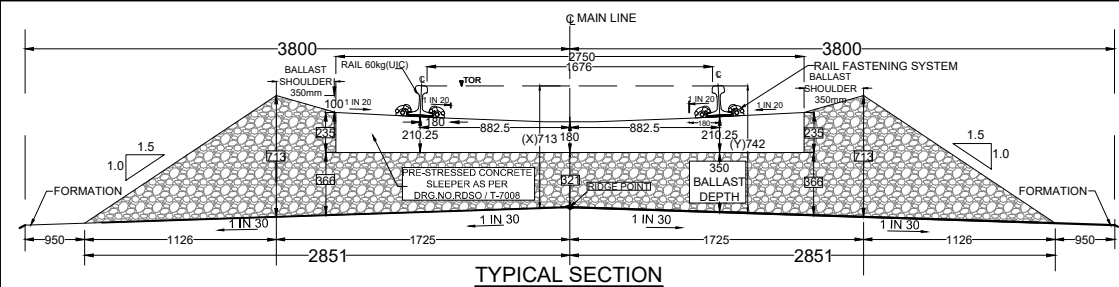

TRACK STRUCTURE		
RAIL SECTION: 60Kg/m (UIC 60Kg/m) DFC LINE: 60Kg/m (UIC 60Kg/m) IR MAIN LINE: 52Kg/m	Difference between FL- RL (Below Rail Seat)	
	IR Line	DFC
RUBBER PAD	172mm	172mm
SLEEPER DEPTH	6mm	10mm
SLEEPER DEPTH	210mm	210mm
BALLAST CUSHION	300mm	350mm
Total Depth (FL TO RL)	688mm	742mm

OWNER: DEDICATED FREIGHT CORRIDOR CORPORATION OF INDIA LTD. (A GOVERNMENT OF INDIA ENTERPRISE)
PROJECT OFFICE (AMBALA UNIT): OLD RAILWAY COLONY (NEAR ANAND MARKET), AMBALA CANTT-133001.
CORPORATE IDENTITY NO.: U60232DL2006GGI155068

ENGINEER: DB Engineering & Consulting GmbH
Deutsche Bahn Engineering & Consulting GmbH

CONTRACTOR: GIL - TPL JV
GAR TATA


SUBMITTED BY	GIL - TPL JV		
	DATED	NAME	SIGNATURE
PREPARED BY	12.09.2024	VIJAY PRATAP	
CHECKED BY	12.09.2024	PARASURAM KOTYADA	
APPROVED BY	12.09.2024	PARASURAM KOTYADA	

APPROVED BY	DEUTSCHE BAHN ENGINEERING & CONSULTING GMBH		
	DATED	NAME	SIGNATURE
Sr. DE./CHIEF ENGINEER		SURESH K.YALANGI	
CHIEF TRACK ENGINEER		RAJ PAL SINGH	
T.L.		H.D. VIDJAK	

STAMP	A AS-BUILT DRAWING TR. Ref.:..... ENGINEER Sign.:.....		
EMPLOYER (DFCCIL):	DEDICATED FREIGHT CORRIDOR CORPORATION OF INDIA LTD.		

AS BUILT DRAWING			
TITLE	AS-BUILT PLAN AND PROFILE		
FROM IR KM: 309.500 TO 310.000	DFC KM: 1198.990 TO 1199.490		
DFCC APPR. NO. -	ENG. APPR. NO. -		
DRG. NO. - 301-2/AL/A/1245	SHEET NO.: 1 OF 1		
DATE: 12.09.2024	STATUS		
	A		

TR.

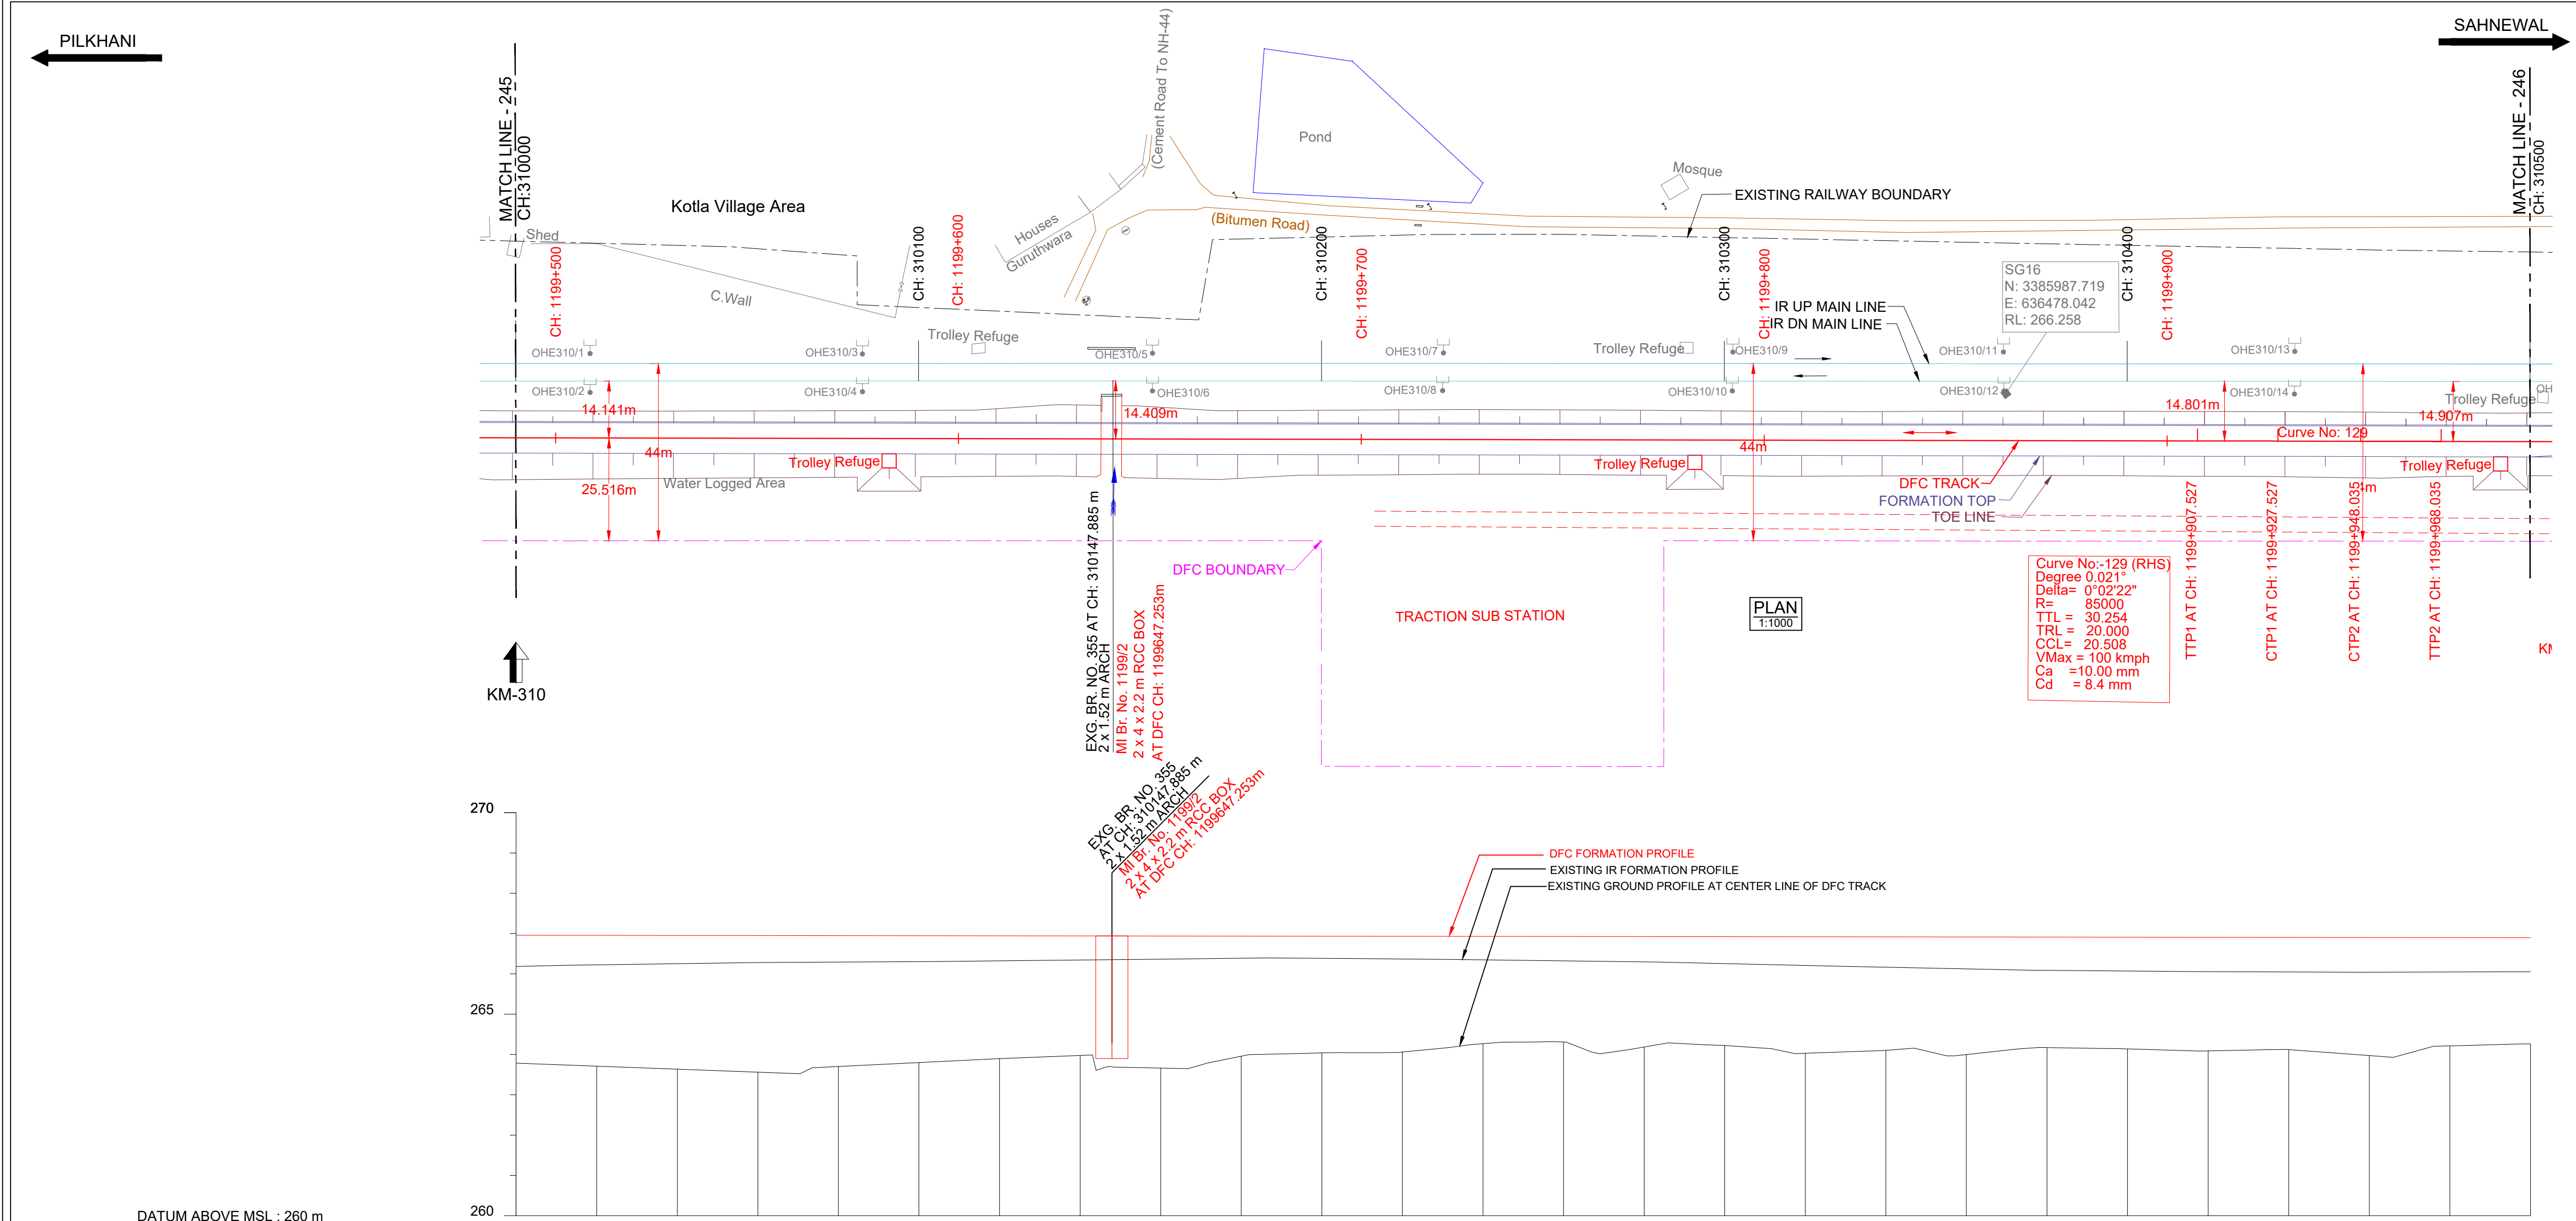

DATUM ABOVE MSL : 260 m	270	265	260
HORIZONTAL ALIGNMENT	TL = 20 R = 85000 CC = 20.508 TL = 20		
VERTICAL ALIGNMENT	L = 1495.963m 1 IN 8562.720 F		
TRACK DISTANCE FROM EXISTING NEAREST IR DN MAIN LINE TO DFC MAIN LINE	14.092	14.136	14.196
HEIGHT OF BANKING(+) / DEPTH OF CUTTING(-) (PFL-GL)	+3.174	+3.245	+3.317
EXG GROUND LEVEL AT CENTER LINE OF DFC TRACK (GL)	263.785	263.711	263.637
EXG GROUND LEVEL AT TOE LOCATION OF DFC TRACK	263.385	263.481	263.574
DIFFERENCE BETWEEN DFC FORMATION LEVEL AND EXG.FORMATION LEVEL (PFL-EFL)	0.774	0.734	0.702
DFC FORMATION LEVEL (PFL)	266.959	266.956	266.954
EXG. FORMATION LEVEL OF EXG IR DN MAIN LINE (EFL)	266.185	266.222	266.252
DIFFERENCE BETWEEN DFC RAIL LEVEL AND EXG. RAIL LEVEL (PRL - ERL)	0.815	0.774	0.743
DFC RAIL LEVEL (PRL)	267.671	267.689	267.686
EXG.RAIL LEVEL OF NEAREST IR DN MAIN LINE(ERL)	266.857	266.894	266.924
EQUIVALENT CHAINAGE ON DFC TRACK	1199490.3	1199510.3	1199530.3
EXISTING IR CHAINAGE	310000.0	310020.0	310040.0

310000.0	310020.0	310040.0	310060.0	310080.0	310100.0	310120.0	310140.0	310160.0	310180.0	310200.0	310220.0	310240.0	310260.0	310280.0	310300.0	310320.0	310340.0	310360.0	310380.0	310400.0	310420.0	310440.0	310460.0	310480.0	310500.0
14.092	14.136	14.196	14.255	14.277	14.300	14.342	14.390	14.434	14.444	14.466	14.494	14.526	14.564	14.602	14.639	14.674	14.698	14.708	14.723	14.758	14.793	14.830	14.871	14.903	14.937
+3.174	+3.245	+3.317	+3.388	+3.246	+3.146	+3.045	+2.967	+3.279	+2.979	+2.897	+2.871	+2.663	+2.617	+2.742	+2.702	+2.892	+2.817	+2.918	+2.743	+2.775	+2.820	+2.787	+2.932	+2.690	+2.637
263.785	263.711	263.637	263.563	263.703	263.801	263.899	263.975	263.661	263.958	264.038	264.062	264.267	264.311	264.184	264.221	264.029	264.102	263.998	264.137	264.171	264.089	264.120	263.973	264.212	264.263
0.774	0.734	0.702	0.670	0.656	0.642	0.620	0.598	0.575	0.548	0.550	0.565	0.582	0.600	0.630	0.669	0.713	0.754	0.793	0.827	0.841	0.852	0.859	0.864	0.855	0.849
266.959	266.956	266.954	266.951	266.949	266.947	266.944	266.942	266.940	266.937	266.935	266.933	266.930	266.928	266.926	266.923	266.921	266.919	266.916	266.914	266.912	266.909	266.907	266.905	266.902	266.900
266.185	266.222	266.252	266.281	266.293	266.305	266.324	266.344	266.365	266.389	266.385	266.368	266.348	266.322	266.296	266.254	266.208	266.165	266.123	266.071	266.026	266.057	266.049	266.041	266.046	266.051
0.815	0.774	0.743	0.711	0.696	0.682	0.661	0.639	0.615	0.589	0.591	0.605	0.623	0.646	0.670	0.710	0.753	0.795	0.834	0.868	0.881	0.893	0.899	0.904	0.897	0.890
267.671	267.689	267.686	267.664	267.662	267.659	267.657	267.655	267.652	267.650	267.648	267.645	267.643	267.641	267.638	267.636	267.634	267.631	267.629	267.624	267.627	267.622	267.620	267.617	267.615	267.613
266.857	266.894	266.924	266.953	266.965	266.977	266.996	267.016	267.037	267.061	267.057	267.040	267.020	266.994	266.968	266.926	266.880	266.837	266.795	266.743	266.759	266.729	266.721	266.713	266.718	266.723
1199490.3	1199510.3	1199530.3	1199550.3	1199570.3	1199590.3	1199610.3	1199630.3	1199650.3	1199670.3	1199690.3	1199710.3	1199730.3	1199750.3	1199770.3	1199790.3	1199810.3	1199830.3	1199850.3	1199870.3	1199890.3	1199910.3	1199930.3	1199950.3	1199970.3	1199990.3
310000.0	310020.0	310040.0	310060.0	310080.0	310100.0	310120.0	310140.0	310160.0	310180.0	310200.0	310220.0	310240.0	310260.0	310280.0	310300.0	310320.0	310340.0	310360.0	310380.0	310400.0	310420.0	310440.0	310460.0	310480.0	310500.0

NOTE:-

- DFCC WORKS ARE SHOWN IN RED.
- IR NEW WORKS ARE SHOWN IN VIOLET.
- ALL DIMENSIONS ARE SHOWN IN METRES.
- THIS DRAWING IS PREPARED BASED ON LATEST SURVEY DATA HELD ON APRIL-2022. GTS BENCH MARK OF 261.850M CONSIDERED ON TOP OF CANAL BRIDGE ABUTMENT AT DORAHA VILLAGE ALONG THE NH1.
- DFC NEW CHAINAGE OF 1075.950M IS WITH REFERENCE TO THE IR KM OF 187.500KM END OF KM OF CP-303(SECTION P-3 PILKHANI END) AGAINST THE EXISTING DFC CHAINAGE. 116277.742M ISSUED VIDE LETTER NO. COM/DFCC/UMS/SURVEY/2021-301-230116-011173.DT. 17.01.2023.
- BALLAST PROFILE HAS BEEN PROVIDED ACCORDING TO THE CLAUSE 1.11.3 OF STANDARD SCHEDULE OF DIMENSION(EASTERN CORRIDOR) & THE BALLAST CUSHION DIMENSION SHOWN IN 35CM ON GE-14 PARA 17. SPECIFICATIONS & RECOMMENDATIONS 2. TWO LAYER SYSTEM FIG.10.

REFERENCE DRAWINGS :-

- FOR KEY PLAN REFER DRAWING NO. 301-2/AL/0001
- FOR LEGEND AND ABBREVIATIONS REFER DRAWING NO. 301-2/AL/1000
- FOR TYPICAL SECTION OF BALLAST PROFILE (FL-RL) REFER DRG. NO. 301-2/TK/TFD/004 (TR.1952)

012.09.2024SUBMISSION OF AS-BUILT DRAWINGFOR APPROVAL

REV. DATE REVISION DETAILS PURPOSE OF ISSUE

SCALE
HOR - 1:1000
VER - 1:100
SHEET SIZE : A1

LEGEND:

- IR TRACK
- DFCC TRACK
- DFCC FUTURE PROPOSALS
- STRUCTURE / BUILDING
- DFCC TOE LINE
- DFCC FORMATION
- RETAINING WALL
- ROAD
- STREAM, DRAIN, NALA, CANAL.
- FENCE
- POWER LINES
- TBM
- ELECTRIC POLE/OHE MAST
- IR RAILWAY BOUNDARY
- DFCC BOUNDARY

TRACK STRUCTURE

RAIL SECTION: 60Kg/m (UIC 60Kg/m)	Difference between FL- RL (Below Rail Seat)	
DFC LINE: 60Kg/m (UIC 60Kg/m)	IR Line	DFC
IR MAIN LINE: 52Kg/m	172mm	172mm
RUBBER PAD	6mm	10mm
SLEEPER DEPTH	210mm	210mm
BALLAST CUSHION	300mm	350mm
Total Depth (FL TO RL)	688mm	742mm

OWNER

DEDICATED FREIGHT CORRIDOR CORPORATION OF INDIA LTD.
(A GOVERNMENT OF INDIA ENTERPRISE)
PROJECT OFFICE(AMBALA UNIT): OLD RAILWAY COLONY (NEAR ANAND MARKET),AMBALA CANTT-133001.
CORPORATE IDENTITY NO. : U60232DL2006G01155068

ENGINEER:

DB Engineering & Consulting GmbH
Deutsche Bahn Engineering & Consulting GmbH

CONTRACTOR:

GIL - TPL JV
GAR TATA

SUBMITTED BY	GIL - TPL JV		
PREPARED BY	DATED	NAME	SIGNATURE
CHECKED BY	12.09.2024	VIJAY PRATAP	
APPROVED BY	12.09.2024	PARASURAM KOTYADA	

APPROVED BY	DEUTSCHE BAHN ENGINEERING & CONSULTING GMBH		
	DATED	NAME	SIGNATURE
Sr. DE./CHIEF ENGINEER		SURESH K.YALANGI	
CHIEF TRACK ENGINEER		RAJ PAL SINGH	
T.L.		H.D. VIDJAK	

STAMP

AAS-BUILT DRAWINGTR. Ref.:ENGINEER Sign.:

EMPLOYER (DFCCIL):

DEDICATED FREIGHT CORRIDOR CORPORATION OF INDIA LTD.


TITLE

AS-BUILT PLAN AND PROFILE

FROM IR KM: 310.000 TO 310.500
DFC KM: 1199.490 TO 1199.990

DFCC APPR. NO. -
ENGG. APPR. NO. -
DRG. NO. -301-2/AL/A/1246
SHEET NO.: 1 OF 1
DATE : 12.09.2024


STATUS
A

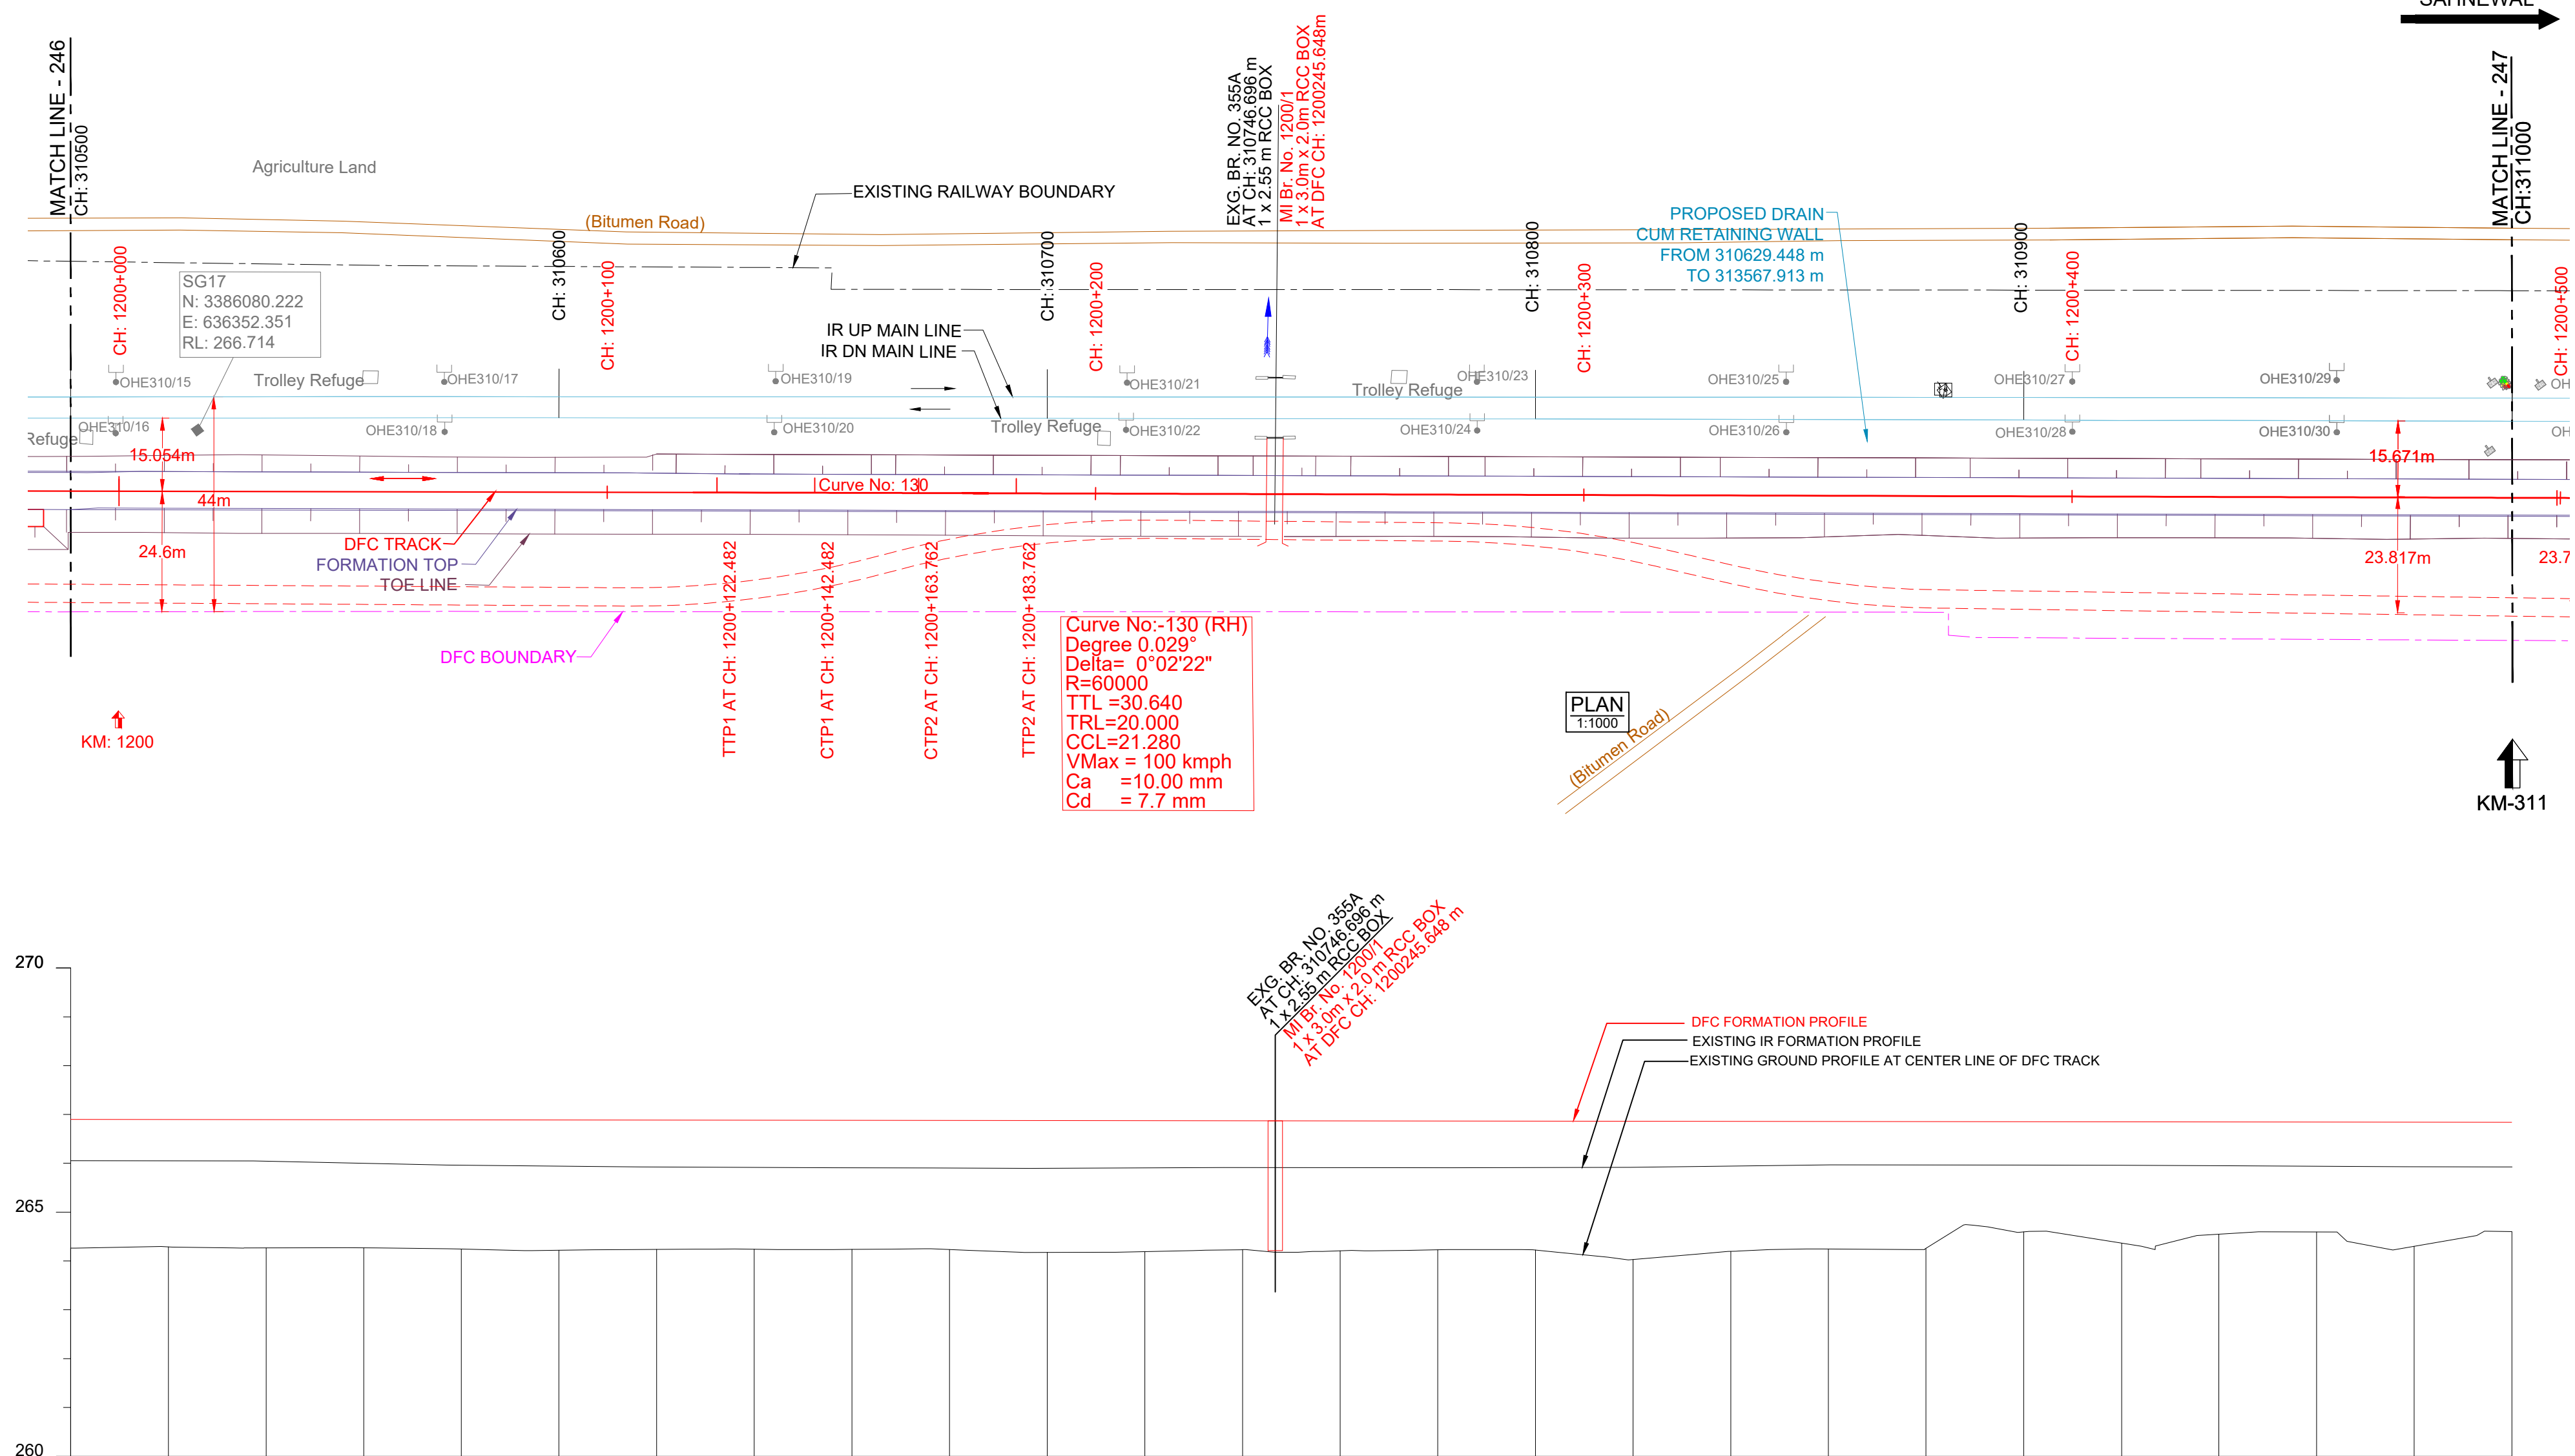

DATUM ABOVE MSL : 260 m

[illegible]

L - SECTION

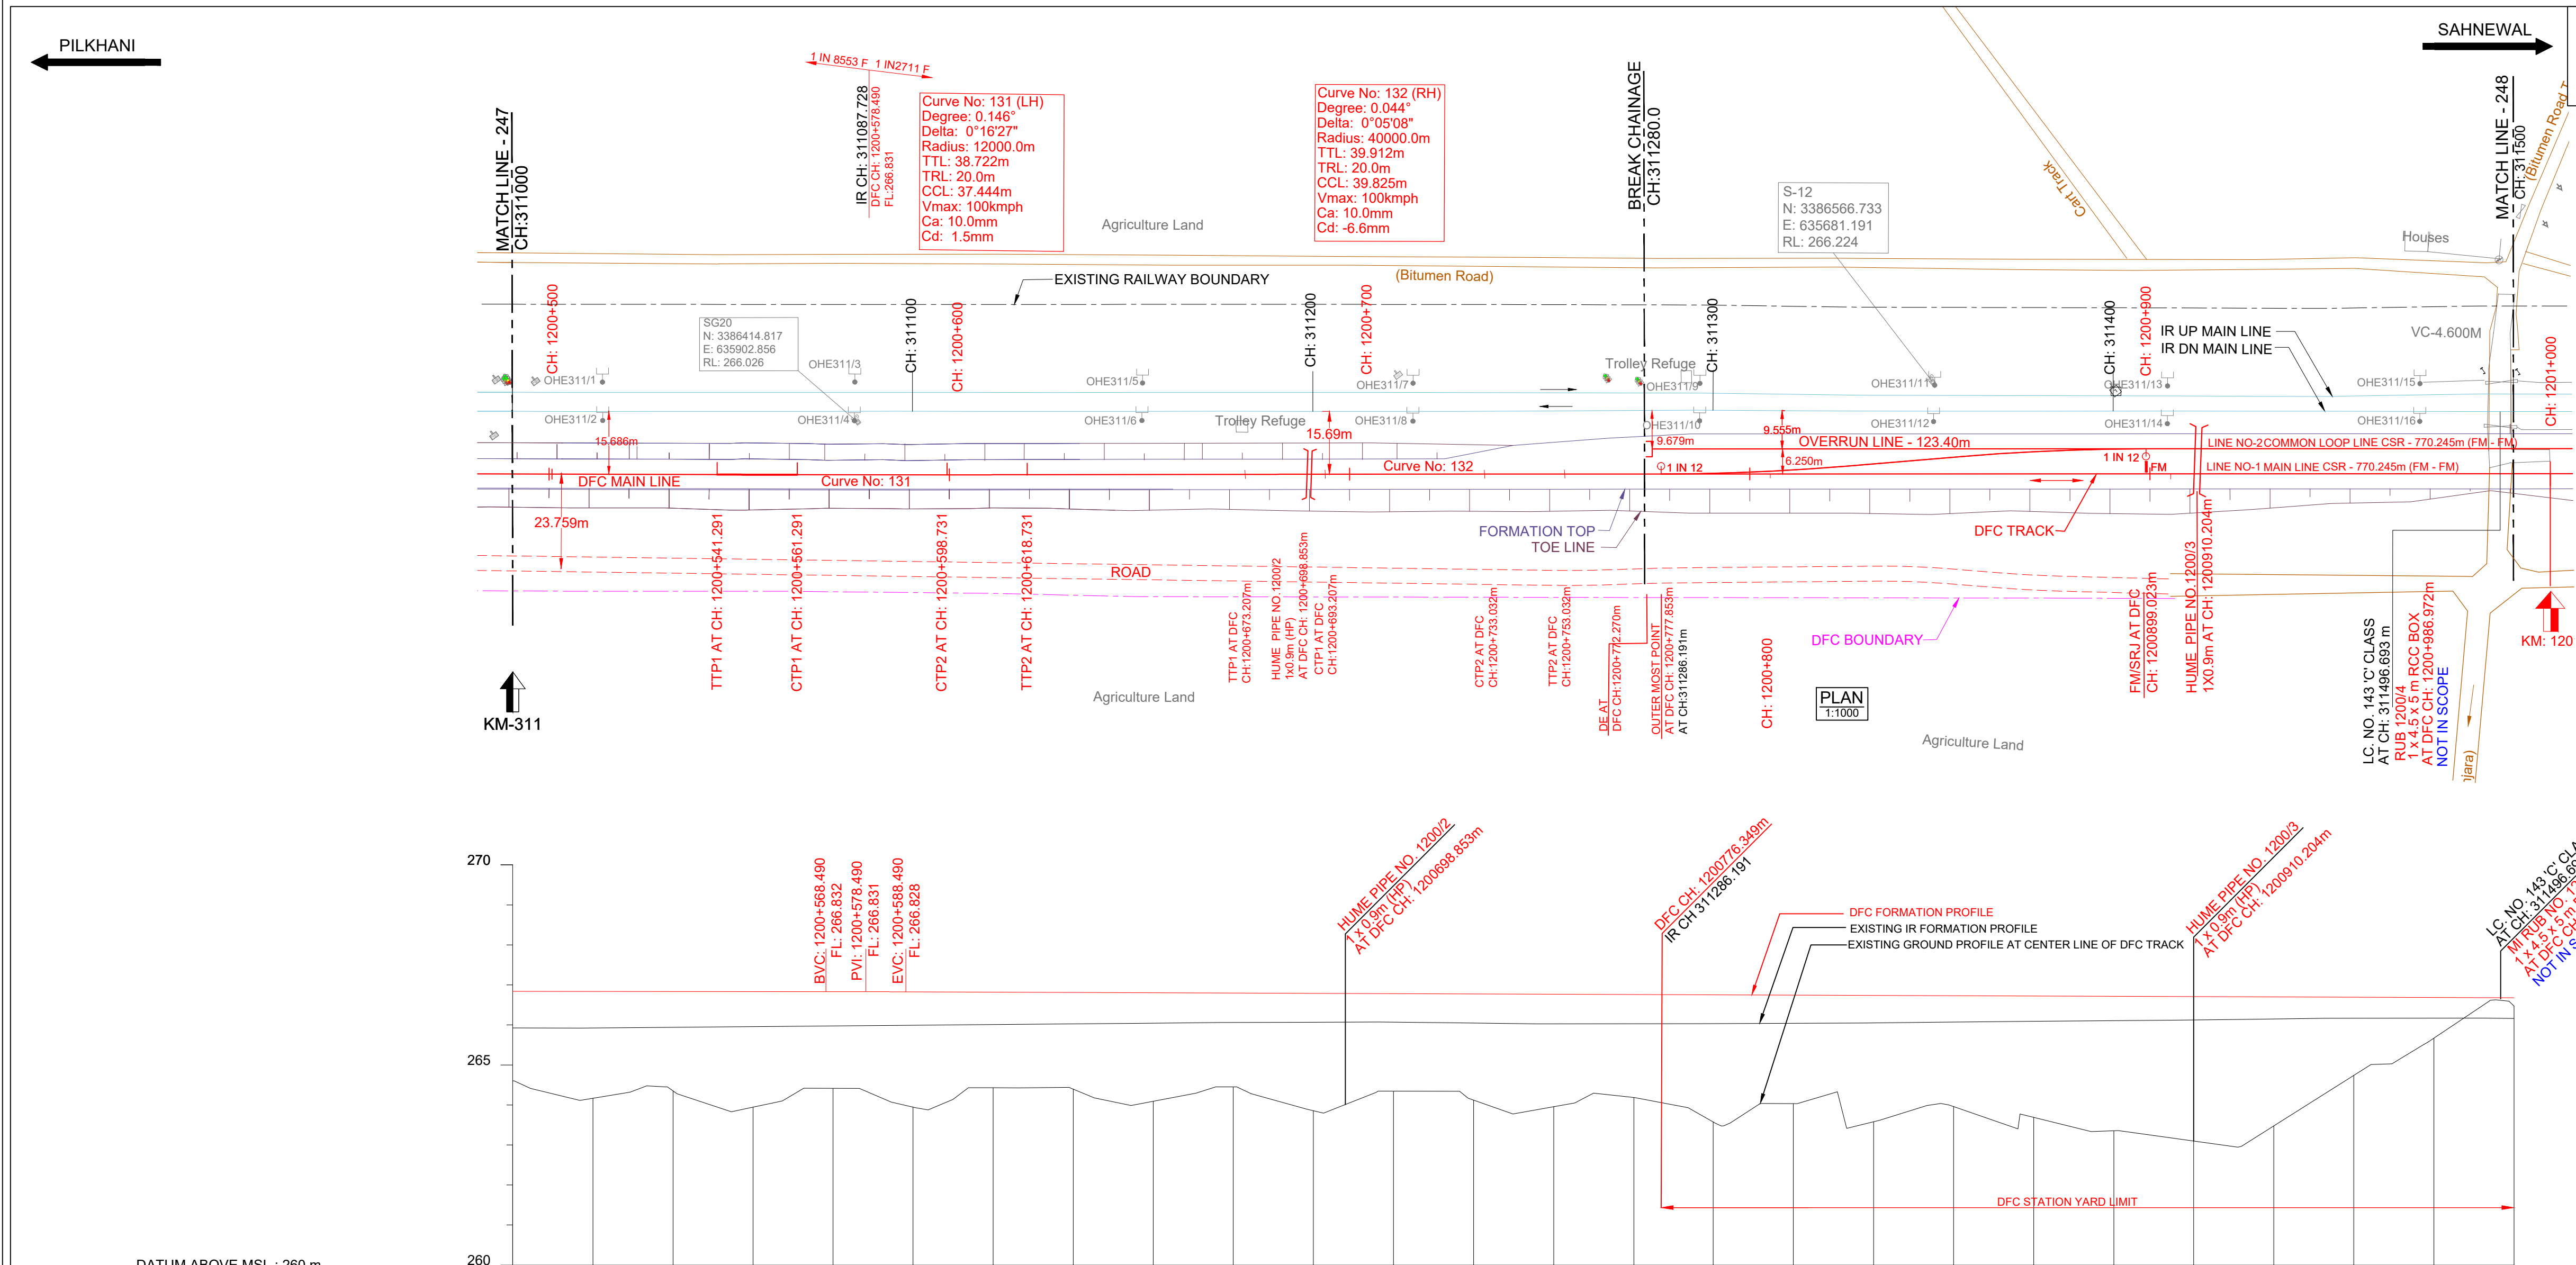

HORIZONTAL ALIGNMENT	TL=20 R=-12000 CC=37.444 TL=20 L=54.486 m TL=20 R=40000 CC=39.825 TL=20 L=867.010 m																		
VERTICAL ALIGNMENT	L=1485.963m 1 IN 8552.720 F L=20.0 m R=79391 m L=2139.573 m 1 IN 2711.213 F																		
TRACK DISTANCE FROM EXISTING NEAREST IR DN MAIN LINE TO DFC MAIN LINE	15.683	15.671	15.746	15.820	15.875	15.892	15.858	15.818	15.803	15.776	15.715	15.668	15.673	15.759	15.852	15.905	15.794	15.895	15.688
HEIGHT OF BANKING(+)/ DEPTH OF CUTTING(-) (PFL-GL)	+2.239	+2.672	+2.484	+2.890	+2.418	+2.880	+2.391	+2.416	+2.711	+2.345	+2.932	+2.437	+2.656	+2.810	+2.574	+3.179	+2.712	+3.157	+3.035
EXG GROUND LEVEL AT CENTER LINE OF DFC TRACK (GL)	264.603	264.167	264.353	263.945	264.414	263.947	264.429	264.396	264.094	264.452	263.858	264.346	264.119	263.958	264.187	263.574	263.619	263.581	263.689
EXG GROUND LEVEL AT TOE LOCATION OF DFC TRACK	264.362	264.307	264.302	264.107	264.320	264.257	264.376	264.222	264.074	264.159	263.934	263.845	263.890	263.890	263.900	263.626	263.579	263.557	263.557
DIFFERENCE BETWEEN DFC FORMATION LEVEL AND EXG.FORMATION LEVEL (PFL-EFL)	0.916	0.916	0.898	0.879	0.857	0.835	0.810	0.785	0.761	0.737	0.722	0.713	0.729	0.740	0.732	0.721	0.705	0.686	0.659
DFC FORMATION LEVEL (PFL)	265.842	265.839	265.837	265.835	265.832	265.827	265.820	265.812	265.805	265.797	265.790	265.783	265.775	265.768	265.761	265.753	265.746	265.738	265.724
EXG. FORMATION LEVEL OF EXG IR DN MAIN LINE (EFL)	265.925	265.923	265.939	265.958	265.975	265.992	266.010	266.027	266.044	266.060	266.068	266.070	266.046	266.028	266.029	266.032	266.041	266.052	266.072
DIFFERENCE BETWEEN DFC RAIL LEVEL AND EXG. RAIL LEVEL (PRL - ERL)	0.956	0.956	0.938	0.919	0.898	0.876	0.850	0.826	0.801	0.778	0.763	0.754	0.770	0.781	0.772	0.762	0.745	0.727	0.707
DFC RAIL LEVEL (PRL)	267.554	267.552	267.550	267.547	267.545	267.540	267.532	267.525	267.518	267.510	267.503	267.495	267.468	267.481	267.473	267.466	267.459	267.451	267.444
EXG.RAIL LEVEL OF NEAREST IR DN MAIN LINE(ERL)	266.598	266.595	266.611	266.628	266.647	266.664	266.682	266.699	266.716	266.732	266.740	266.742	266.718	266.700	266.701	266.704	266.713	266.724	266.744
EQUIVALENT CHAINAGE ON DFC TRACK	1200490.3	1200510.3	1200530.3	1200550.3	1200570.3	1200590.3	1200610.3	1200630.3	1200650.3	1200670.3	1200690.3	1200710.3	1200730.3	1200750.3	1200770.3	1200790.3	1200810.3	1200830.3	1200850.3
EXISTING IR CHAINAGE	311000.0	311020.0	311040.0	311060.0	311080.0	311100.0	311120.0	311140.0	311160.0	311180.0	311200.0	311220.0	311240.0	311260.0	311280.0	311300.0	311320.0	311340.0	311360.0

L - SECTION

NOTE:-

- DFCC WORKS ARE SHOWN IN RED.
- IR NEW WORKS ARE SHOWN IN VIOLET.
- ALL DIMENSIONS ARE SHOWN IN METRES.
- THIS DRAWING IS PREPARED BASED ON LATEST SURVEY DATA HELD ON APRIL-2022. GTS BENCH MARK OF 261.850M CONSIDERED ON TOP OF CANAL BRIDGE ABUTMENT AT DORAHA VILLAGE ALONG THE NH1.
- DFC NEW CHAINAGE OF 1075.950M IS WITH REFERENCE TO THE IR KM OF 187.500KM END OF KM OF CP-303(SECTION P-3 PILKHANI END) AGAINST THE EXISTING DFC CHAINAGE. 116277.742M ISSUED VIDE LETTER NO. COM/DFCC/MB/SURVEY/2021-301-230116-011173 DT. 17.01.2023
- BALLAST PROFILE HAS BEEN PROVIDED ACCORDING TO THE CLAUSE 1.11.3 OF STANDARD SCHEDULE OF DIMENSION(EASTERN CORRIDOR) & THE BALLAST CUSHION DIMENSION SHOWN IN 35CM ON GE-14 PARA 17. SPECIFICATIONS & RECOMMENDATIONS 2. TWO LAYER SYSTEM FIG.10.

REFERENCE DRAWINGS :-

- FOR KEY PLAN REFER DRAWING NO. 301-2/AL/0001
- FOR LEGEND AND ABBREVIATIONS REFER DRAWING NO. 301-2/AL/1000
- FOR TYPICAL SECTION OF BALLAST PROFILE (FL-RL) REFER DRG. NO. 301-2/TK/TFD/004 (TR.1952)

0	12.09.2024	SUBMISSION OF AS-BUILT DRAWING	FOR APPROVAL
REV.	DATE	REVISION DETAILS	PURPOSE OF ISSUE

LEGEND:

IR TRACK

DFCC TRACK

DFCC FUTURE PROPOSALS

STRUCTURE / BUILDING

DFCC TOE LINE

DFCC FORMATION

RETAINING WALL

ROAD

STREAM, DRAIN, NALA, CANAL.

FENCE

POWER LINES

TBM

ELECTRIC POLE/OHE MAST

IR RAILWAY BOUNDARY

DFCC BOUNDARY

SCALE

HOR - 1:1000

0 10 20 30 40m

VER - 1:100

0 1 2 3 4m

SHEET SIZE : A1

TYPICAL SECTION

TRACK STRUCTURE

RAIL SECTION: 60Kg/m (UIC 60Kg/m)	Difference between FL- RL (Below Rail Seat)	
DFC LINE: 60Kg/m (UIC 60Kg/m)	IR Line	DFC
IR MAIN LINE: 52Kg/m	172mm	172mm
RUBBER PAD	6mm	10mm
SLEEPER DEPTH	210mm	210mm
BALLAST CUSHION	300mm	350mm
Total Depth (FL TO RL)	688mm	742mm

OWNER

DEDICATED FREIGHT CORRIDOR CORPORATION OF INDIA LTD.

(A GOVERNMENT OF INDIA ENTERPRISE)

PROJECT OFFICE(AMBALA UNIT): OLD RAILWAY COLONY (NEAR ANAND MARKET),AMBALA CANTT.-133001.

CORPORATE IDENTITY NO. : U60232DL2006GGI155068

ENGINEER:

DB

DB Engineering & Consulting GmbH

Deutsche Bahn Engineering & Consulting GmbH

CONTRACTOR:

GIL - TPL JV

GAR

TATA

SUBMITTED BY	GIL - TPL JV		
	DATED	NAME	SIGNATURE
PREPARED BY			
CHECKED BY	12.09.2024	VIJAY PRATAP	
APPROVED BY	12.09.2024	PARASURAM KOTYADA	
APPROVED BY	DEUTSCHE BAHN ENGINEERING & CONSULTING GMBH		
	DATED	NAME	SIGNATURE
Sr. DE./CHIEF ENGINEER		SURESH K.YALANGI	
CHIEF TRACK ENGINEER		RAJ PAL SINGH	
T.L.		H.D. VIDJAK	

STAMP

A

AS-BUILT DRAWING

TR. Ref.....

ENGINEER Sign.:

EMPLOYER (DFCCIL):

DEDICATED FREIGHT CORRIDOR CORPORATION OF INDIA LTD.

AS BUILT DRAWING

TITLE

AS-BUILT PLAN AND PROFILE

DFCC APPR. NO. -

ENGG. APPR. NO. -

DRG. NO. -301-2/AL/A/1248

SHEET NO. : 1 OF 1

DATE : 12.09.2024

STATUS

A

FROM IR KM: 311.000 TO 311.500

DFC KM: 1200.490 TO 1200.990

TR.