
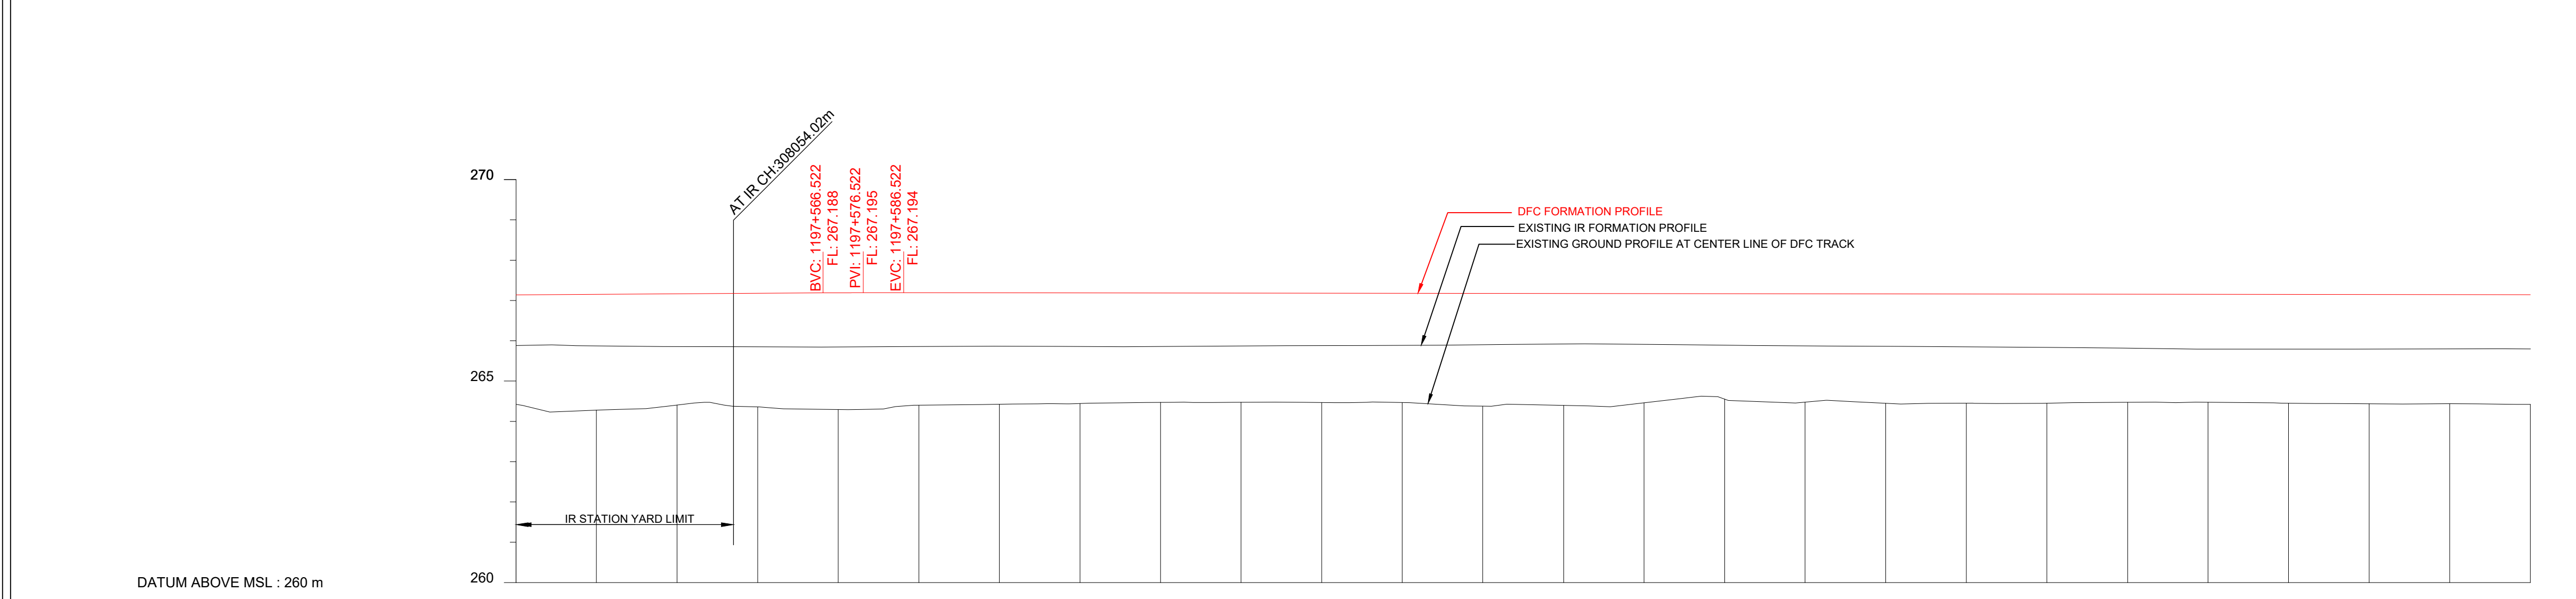


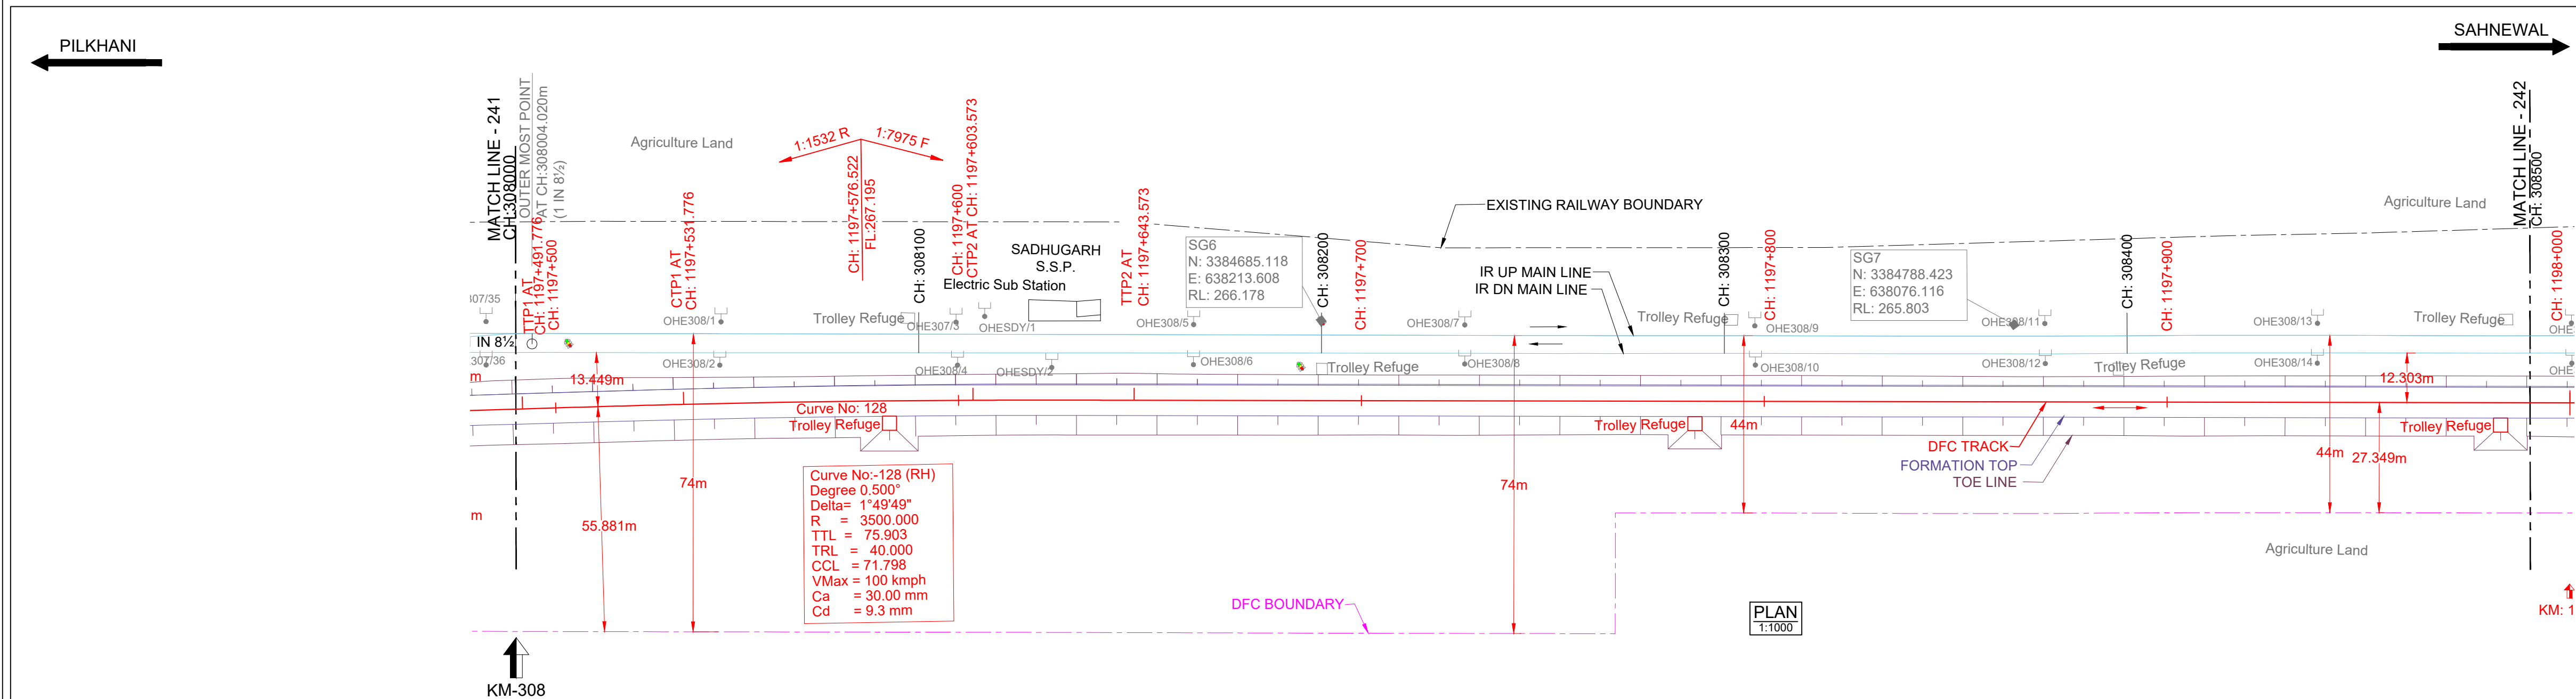

DATUM ABOVE MSL : 260 m

HORIZONTAL ALIGNMENT	TL=40 R = 3500 CC = 71.798 TL=40 L = 2263.954 m																			
VERTICAL ALIGNMENT	L=786.074 m 1 IN 1532.390 R L=20.0 m R=25707 m L=1476.005 m 1 IN 7974.823 F																			
TRACK DISTANCE FROM EXISTING NEAREST IR DN MAIN LINE TO DFC MAIN LINE	14.050	13.455	12.881	12.428	12.089	11.862	11.750	11.737	11.756	11.771	11.785	11.798	11.796	11.890	11.906	11.929	12.099	12.251	12.276	12.333
HEIGHT OF BANKING(+) / DEPTH OF CUTTING(-) (PFL-GL)	+2.717	+2.872	+2.760	+2.819	+2.898	+2.792	+2.767	+2.745	+2.715	+2.711	+2.714	+2.710	+2.800	+2.714	+2.712	+2.709	+2.684	+2.679	+2.701	+2.722
EXG GROUND LEVEL AT CENTER LINE OF DFC TRACK (GL)	264.422	264.280	264.405	264.359	264.293	264.401	264.424	264.443	264.471	264.472	264.467	264.468	264.376	264.449	264.449	264.449	264.472	264.474	264.450	264.437
EXG GROUND LEVEL AT TOE LOCATION OF DFC TRACK	264.497	264.468	264.480	264.455	264.378	264.445	264.489	264.482	264.488	264.490	264.513	264.542	264.524	264.597	264.595	264.624	264.611	264.579	264.618	264.600
DIFFERENCE BETWEEN DFC FORMATION LEVEL AND EXG.FORMATION LEVEL.(PFL-EFL)	1.257	1.280	1.310	1.327	1.344	1.337	1.327	1.331	1.328	1.311	1.300	1.292	1.274	1.300	1.312	1.324	1.340	1.358	1.356	1.352
DFC FORMATION LEVEL (PFL)	267.139	267.152	267.165	267.178	267.191	267.193	267.191	267.188	267.186	267.183	267.181	267.178	267.176	267.163	267.161	267.158	267.156	267.153	267.151	267.148
EXG. FORMATION LEVEL OF EXG IR DN MAIN LINE (EFL)	265.882	265.872	265.855	265.851	265.847	265.856	265.864	265.857	265.858	265.872	265.881	265.886	265.902	265.883	265.849	265.834	265.816	265.795	265.795	265.796
DIFFERENCE BETWEEN DFC RAIL LEVEL AND EXG. RAIL LEVEL (PRL - ERL)	1.298	1.320	1.351	1.368	1.395	1.378	1.367	1.372	1.368	1.352	1.340	1.333	1.315	1.341	1.352	1.365	1.381	1.399	1.397	1.394
DFC RAIL LEVEL (PRL)	267.852	267.865	267.878	267.891	267.904	267.906	267.904	267.901	267.899	267.886	267.884	267.879	267.876	267.876	267.874	267.871	267.869	267.866	267.864	267.859
EXG.RAIL LEVEL OF NEAREST IR DN MAIN LINE(ERL)	266.554	266.544	266.527	266.523	266.519	266.528	266.536	266.529	266.530	266.544	266.553	266.558	266.574	266.535	266.521	266.506	266.488	266.467	266.467	266.471
EQUIVALENT CHAINAGE ON DFC TRACK	308000.0	308002.0	308004.0	308006.0	308008.0	308010.0	308012.0	308014.0	308016.0	308018.0	308020.0	308022.0	308024.0	308026.0	308028.0	308030.0	308032.0	308034.0	308036.0	308038.0
EXISTING IR CHAINAGE	308000.0	308020.0	308040.0	308060.0	308080.0	308100.0	308120.0	308140.0	308160.0	308180.0	308200.0	308220.0	308240.0	308260.0	308280.0	308300.0	308320.0	308340.0	308360.0	308380.0

L - SECTION

NOTE:-

- DFCC WORKS ARE SHOWN IN RED.
- IR NEW WORKS ARE SHOWN IN VIOLET.
- ALL DIMENSIONS ARE SHOWN IN METRES.
- THIS DRAWING IS PREPARED BASED ON LATEST SURVEY DATA HELD ON APRIL-2022. GTS BENCH MARK OF 261.850M CONSIDERED ON TOP OF CANAL BRIDGE ABUTMENT AT DORAHA VILLAGE ALONG THE NH1.
- DFC NEW CHAINAGE OF 1075.950M IS WITH REFERENCE TO THE IR KM OF 187.500KM END OF KM OF CP-303(SECTION P-3 PILKHANI END) AGAINST THE EXISTING DFC CHAINAGE. 116277.742M ISSUED VIDE LETTER NO. COM/DFCC/UM/SURVEY/2021-301-230116-011173.DT. 17.01.2023.
- BALLAST PROFILE HAS BEEN PROVIDED ACCORDING TO THE CLAUSE 1.11.3 OF STANDARD SCHEDULE OF DIMENSION(EASTERN CORRIDOR) & THE BALLAST CUSHION DIMENSION SHOWN IN 35CM ON GE-14 PARA 17. SPECIFICATIONS & RECOMMENDATIONS 2. TWO LAYER SYSTEM FIG.10.

REFERENCE DRAWINGS :-

- FOR KEY PLAN REFER DRAWING NO. 301-2/AL/0001
- FOR LEGEND AND ABBREVIATIONS REFER DRAWING NO. 301-2/AL/1000
- FOR TYPICAL SECTION OF BALLAST PROFILE (FL-RL) REFER DRG. NO. 301-2/TK/TFDI-004 (TR.1952)

012.09.2024SUBMISSION OF AS-BUILT DRAWINGFOR APPROVAL

REV. DATE REVISION DETAILS PURPOSE OF ISSUE

SCALE
HOR - 1:1000
VER - 1:100
SHEET SIZE : A1

LEGEND:

- IR TRACK
- DFCC TRACK
- DFCC FUTURE PROPOSALS
- STRUCTURE / BUILDING
- DFCC TOE LINE
- DFCC FORMATION
- RETAINING WALL
- ROAD
- STREAM, DRAIN, NALA, CANAL.
- FENCE
- POWER LINES
- TBM
- ELECTRIC POLE/OHE MAST
- IR RAILWAY BOUNDARY
- DFCC BOUNDARY

TYPICAL SECTION

TRACK STRUCTURE

RAIL SECTION: 60Kg/m (UIC 60Kg/m)	Difference between FL- RL (Below Rail Seat)	
DFC LINE: 60Kg/m (UIC 60Kg/m)	IR Line	DFC
IR MAIN LINE: 52Kg/m	172mm	172mm
RUBBER PAD	6mm	10mm
SLEEPER DEPTH	210mm	210mm
BALLAST CUSHION	300mm	350mm
Total Depth (FL TO RL)	688mm	742mm

OWNER
DEDICATED FREIGHT CORRIDOR CORPORATION OF INDIA LTD.
(A GOVERNMENT OF INDIA ENTERPRISE)
PROJECT OFFICE (AMBALA UNIT): OLD RAILWAY COLONY (NEAR ANAND MARKET), AMBALA CANTT-133001.
CORPORATE IDENTITY NO. : U60232DL2006GGI155068

ENGINEER:
DB Engineering & Consulting GmbH
Deutsche Bahn Engineering & Consulting GmbH

CONTRACTOR:
GIL - TPL JV
GAR TATA

SUBMITTED BY	GIL - TPL JV		
PREPARED BY	DATED	NAME	SIGNATURE
CHECKED BY	12.09.2024	VIJAY PRATAP	
APPROVED BY	12.09.2024	PARASURAM KOTYADA	
APPROVED BY	DEUTSCHE BAHN ENGINEERING & CONSULTING GMBH		
	DATED	NAME	SIGNATURE
Sr. DE./CHIEF ENGINEER		SURESH K.YALANGI	
CHIEF TRACK ENGINEER		RAJ PAL SINGH	
T.L.		H.D. VIDJAK	

STAMP
A AS-BUILT DRAWING
TR. Ref.:.....
ENGINEER Sign.:.....

EMPLOYER (DFCCIL): DEDICATED FREIGHT CORRIDOR CORPORATION OF INDIA LTD.

AS BUILT DRAWING

TITLE AS-BUILT PLAN AND PROFILE	DFCC APPR. NO. - ENGG. APPR. NO. -
FROM IR KM: 308.000 TO 308.500 DFC KM: 1197.490 TO 1197.990	DRG. NO. - 301-2/AL/A/1242 SHEET NO. : 1 OF 1 DATE : 12.09.2024
	STATUS A

TR.