
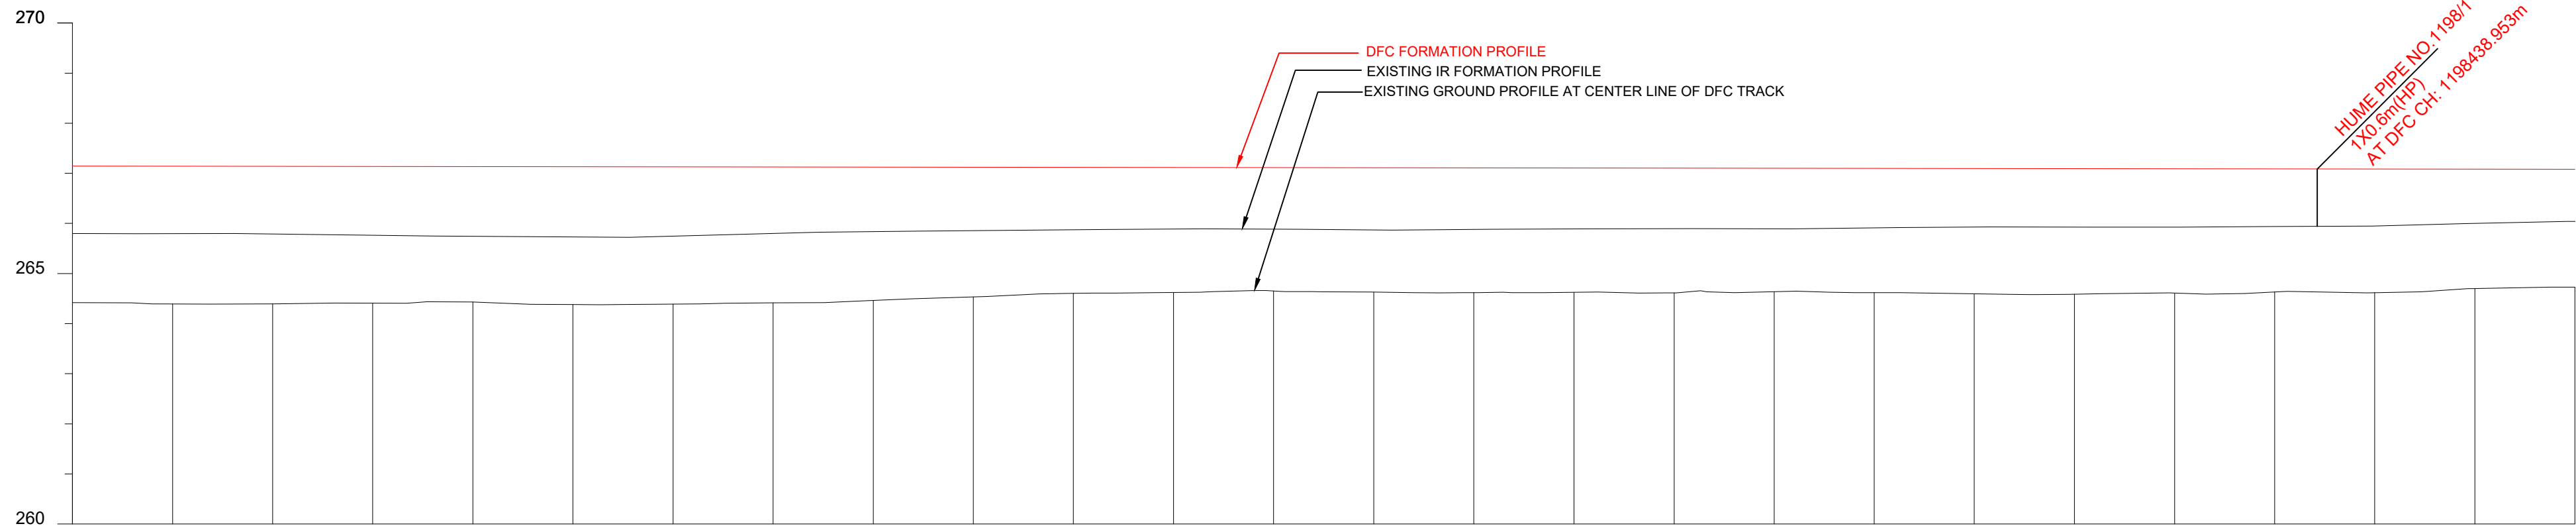


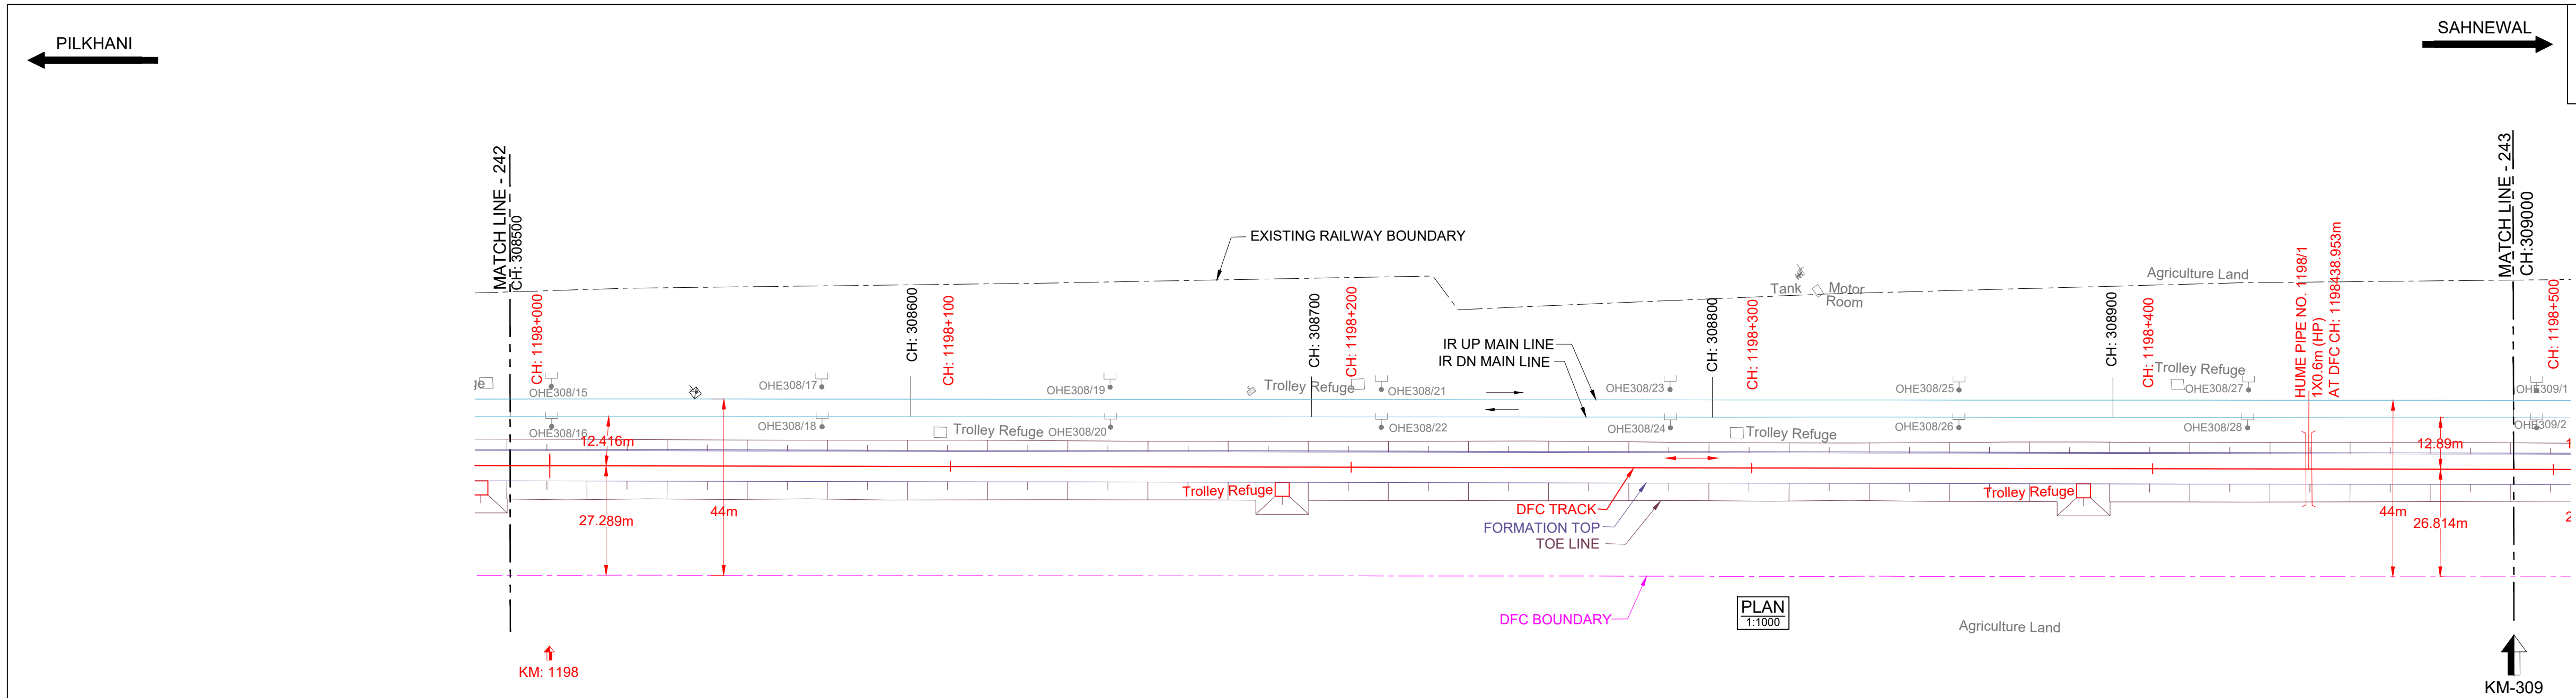


DATUM ABOVE MSL : 260 m

HORIZONTAL ALIGNMENT	L = 2263.954m																			
VERTICAL ALIGNMENT	L=1476.005 m 1 IN 7974.823 F																			
TRACK DISTANCE FROM EXISTING NEAREST IR DN MAIN LINE TO DFC MAIN LINE	12.333	12.333	12.333	12.333	12.333	12.333	12.333	12.333	12.333	12.333	12.333	12.333	12.333	12.333	12.333	12.333	12.333	12.333	12.333	12.333
HEIGHT OF BANKING(+) / DEPTH OF CUTTING(-) (PFL-GL)	+2.722	+2.722	+2.722	+2.722	+2.722	+2.722	+2.722	+2.722	+2.722	+2.722	+2.722	+2.722	+2.722	+2.722	+2.722	+2.722	+2.722	+2.722	+2.722	+2.722
EXG GROUND LEVEL AT CENTER LINE OF DFC TRACK (GL)	264.421	264.421	264.421	264.421	264.421	264.421	264.421	264.421	264.421	264.421	264.421	264.421	264.421	264.421	264.421	264.421	264.421	264.421	264.421	264.421
EXG GROUND LEVEL AT TOE LOCATION OF DFC TRACK	264.590	264.590	264.590	264.590	264.590	264.590	264.590	264.590	264.590	264.590	264.590	264.590	264.590	264.590	264.590	264.590	264.590	264.590	264.590	264.590
DIFFERENCE BETWEEN DFC FORMATION LEVEL AND EXG.FORMATION LEVEL (PFL-EFL)	1.345	1.345	1.345	1.345	1.345	1.345	1.345	1.345	1.345	1.345	1.345	1.345	1.345	1.345	1.345	1.345	1.345	1.345	1.345	1.345
DFC FORMATION LEVEL (PFL)	267.143	267.143	267.143	267.143	267.143	267.143	267.143	267.143	267.143	267.143	267.143	267.143	267.143	267.143	267.143	267.143	267.143	267.143	267.143	267.143
EXG. FORMATION LEVEL OF EXG IR DN MAIN LINE (EFL)	265.798	265.798	265.798	265.798	265.798	265.798	265.798	265.798	265.798	265.798	265.798	265.798	265.798	265.798	265.798	265.798	265.798	265.798	265.798	265.798
DIFFERENCE BETWEEN DFC RAIL LEVEL AND EXG. RAIL LEVEL (PRL - ERL)	1.386	1.386	1.386	1.386	1.386	1.386	1.386	1.386	1.386	1.386	1.386	1.386	1.386	1.386	1.386	1.386	1.386	1.386	1.386	1.386
DFC RAIL LEVEL (PRL)	267.856	267.856	267.856	267.856	267.856	267.856	267.856	267.856	267.856	267.856	267.856	267.856	267.856	267.856	267.856	267.856	267.856	267.856	267.856	267.856
SAHNEWAL

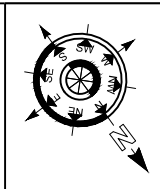

NOTE:-


1. DFC WORKS ARE SHOWN IN RED.
2. IR NEW WORKS ARE SHOWN IN VIOLET.
3. ALL DIMENSIONS ARE SHOWN IN METRES.
4. THIS DRAWING IS PREPARED BASED ON LATEST SURVEY DATA HELD ON APRIL-2022. GTS BENCH MARK OF 261.850M CONSIDERED ON TOP OF CANAL BRIDGE ABUTMENT AT DORANA VILLAGE ALONG THE NH1.
5. DFC NEW CHAINAGE OF 1075.950M IS WITH REFERENCE TO THE IR KM OF 187.500KM END OF KM OF CP-303(SECTION P-3 PILKHANI END) AGAINST THE EXISTING DFC CHAINAGE. 116277.742M ISSUED VIDE LETTER NO. COM/DFCC/UMS/SURVEY/2021-301-230116-011173 DT. 17.01.2023.
6. BALLAST PROFILE HAS BEEN PROVIDED ACCORDING TO THE CLAUSE 1.11.3 OF STANDARD SCHEDULE OF DIMENSION(EASTERN CORRIDOR) & THE BALLAST CUSHION DIMENSION SHOWN IN 35CM ON GE-14 PARA 17. SPECIFICATIONS & RECOMMENDATIONS 2. TWO LAYER SYSTEM FIG.10.

REFERENCE DRAWINGS :-

1. FOR KEY PLAN REFER DRAWING NO. 301-2/AL/0001
2. FOR LEGEND AND ABBREVIATIONS REFER DRAWING NO. 301-2/AL/1000
3. FOR TYPICAL SECTION OF BALLAST PROFILE (FL-RL) REFER DRG. NO. 301-2/TK/TFD/-004 (TR.1952)

REV.	DATE	REVISION DETAILS	PURPOSE OF ISSUE
0	12.09.2024	SUBMISSION OF AS-BUILT DRAWING	FOR APPROVAL

SCALE		LEGEND:	
HOR - 1:1000 VER - 1:100 SHEET SIZE : A1		IR TRACK DFCC TRACK DFCC FUTURE PROPOSALS STRUCTURE / BUILDING DFCC TOE LINE DFCC FORMATION RETAINING WALL ROAD STREAM, DRAIN, NALA, CANAL. POWER LINES TBM ELECTRIC POLE/OHE MAST IR RAILWAY BOUNDARY DFCC BOUNDARY	

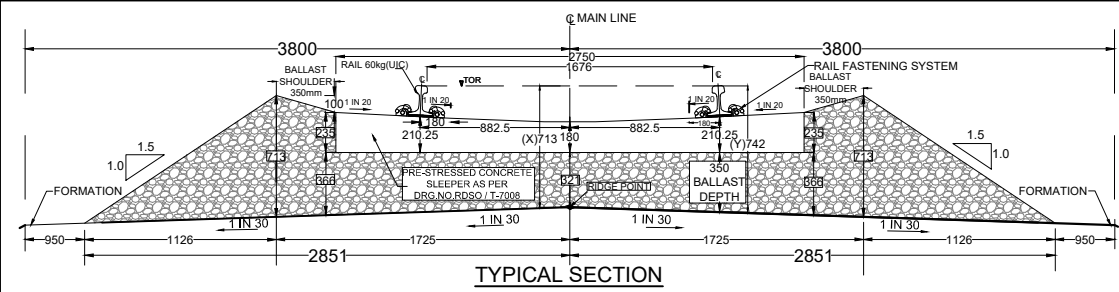

TRACK STRUCTURE		
RAIL SECTION: 60Kg/m (UIC 60Kg/m) DFC LINE: 60Kg/m (UIC 60Kg/m) IR MAIN LINE: 52Kg/m	Difference between FL- RL (Below Rail Seat)	
	IR Line	DFC
RUBBER PAD	172mm	172mm
SLEEPER DEPTH	6mm	10mm
BALLAST CUSHION	210mm	210mm
Total Depth (FL TO RL)	300mm	350mm

OWNER
DEDICATED FREIGHT CORRIDOR CORPORATION OF INDIA LTD.
(A GOVERNMENT OF INDIA ENTERPRISE)
PROJECT OFFICE(AMBALA UNIT): OLD RAILWAY COLONY (NEAR ANAND MARKET),AMBALA CANTT.-133001.
CORPORATE IDENTITY NO. : U60232DL2006GGI155068

ENGINEER:
DB Engineering & Consulting GmbH
Deutsche Bahn Engineering & Consulting GmbH

CONTRACTOR:
GIL - TPL JV
GAR TATA

SUBMITTED BY	GIL - TPL JV		
	DATED	NAME	SIGNATURE
PREPARED BY			
CHECKED BY	12.09.2024	VIJAY PRATAP	
APPROVED BY	12.09.2024	PARASURAM KOTYADA	

APPROVED BY	DEUTSCHE BAHN ENGINEERING & CONSULTING GMBH		
	DATED	NAME	SIGNATURE
Sr. DE./CHIEF ENGINEER		SURESH K.YALANGI	
CHIEF TRACK ENGINEER		RAJ PAL SINGH	
T.L.		H.D. VIDJAK	

STAMP	A AS-BUILT DRAWING TR. Ref.:..... ENGINEER Sign.:.....		
EMPLOYER (DFCCIL):	DEDICATED FREIGHT CORRIDOR CORPORATION OF INDIA LTD.		

AS BUILT DRAWING			
TITLE AS-BUILT PLAN AND PROFILE		DFCC APPR. NO. - ENGG. APPR. NO. -	
FROM IR KM: 308.500 TO 309.000 DFC KM: 1197.990 TO 1198.490		DRG. NO. - 301-2/AL/A/1243 SHEET NO. : 1 OF 1 DATE : 12.09.2024	
		STATUS A	

TR.