


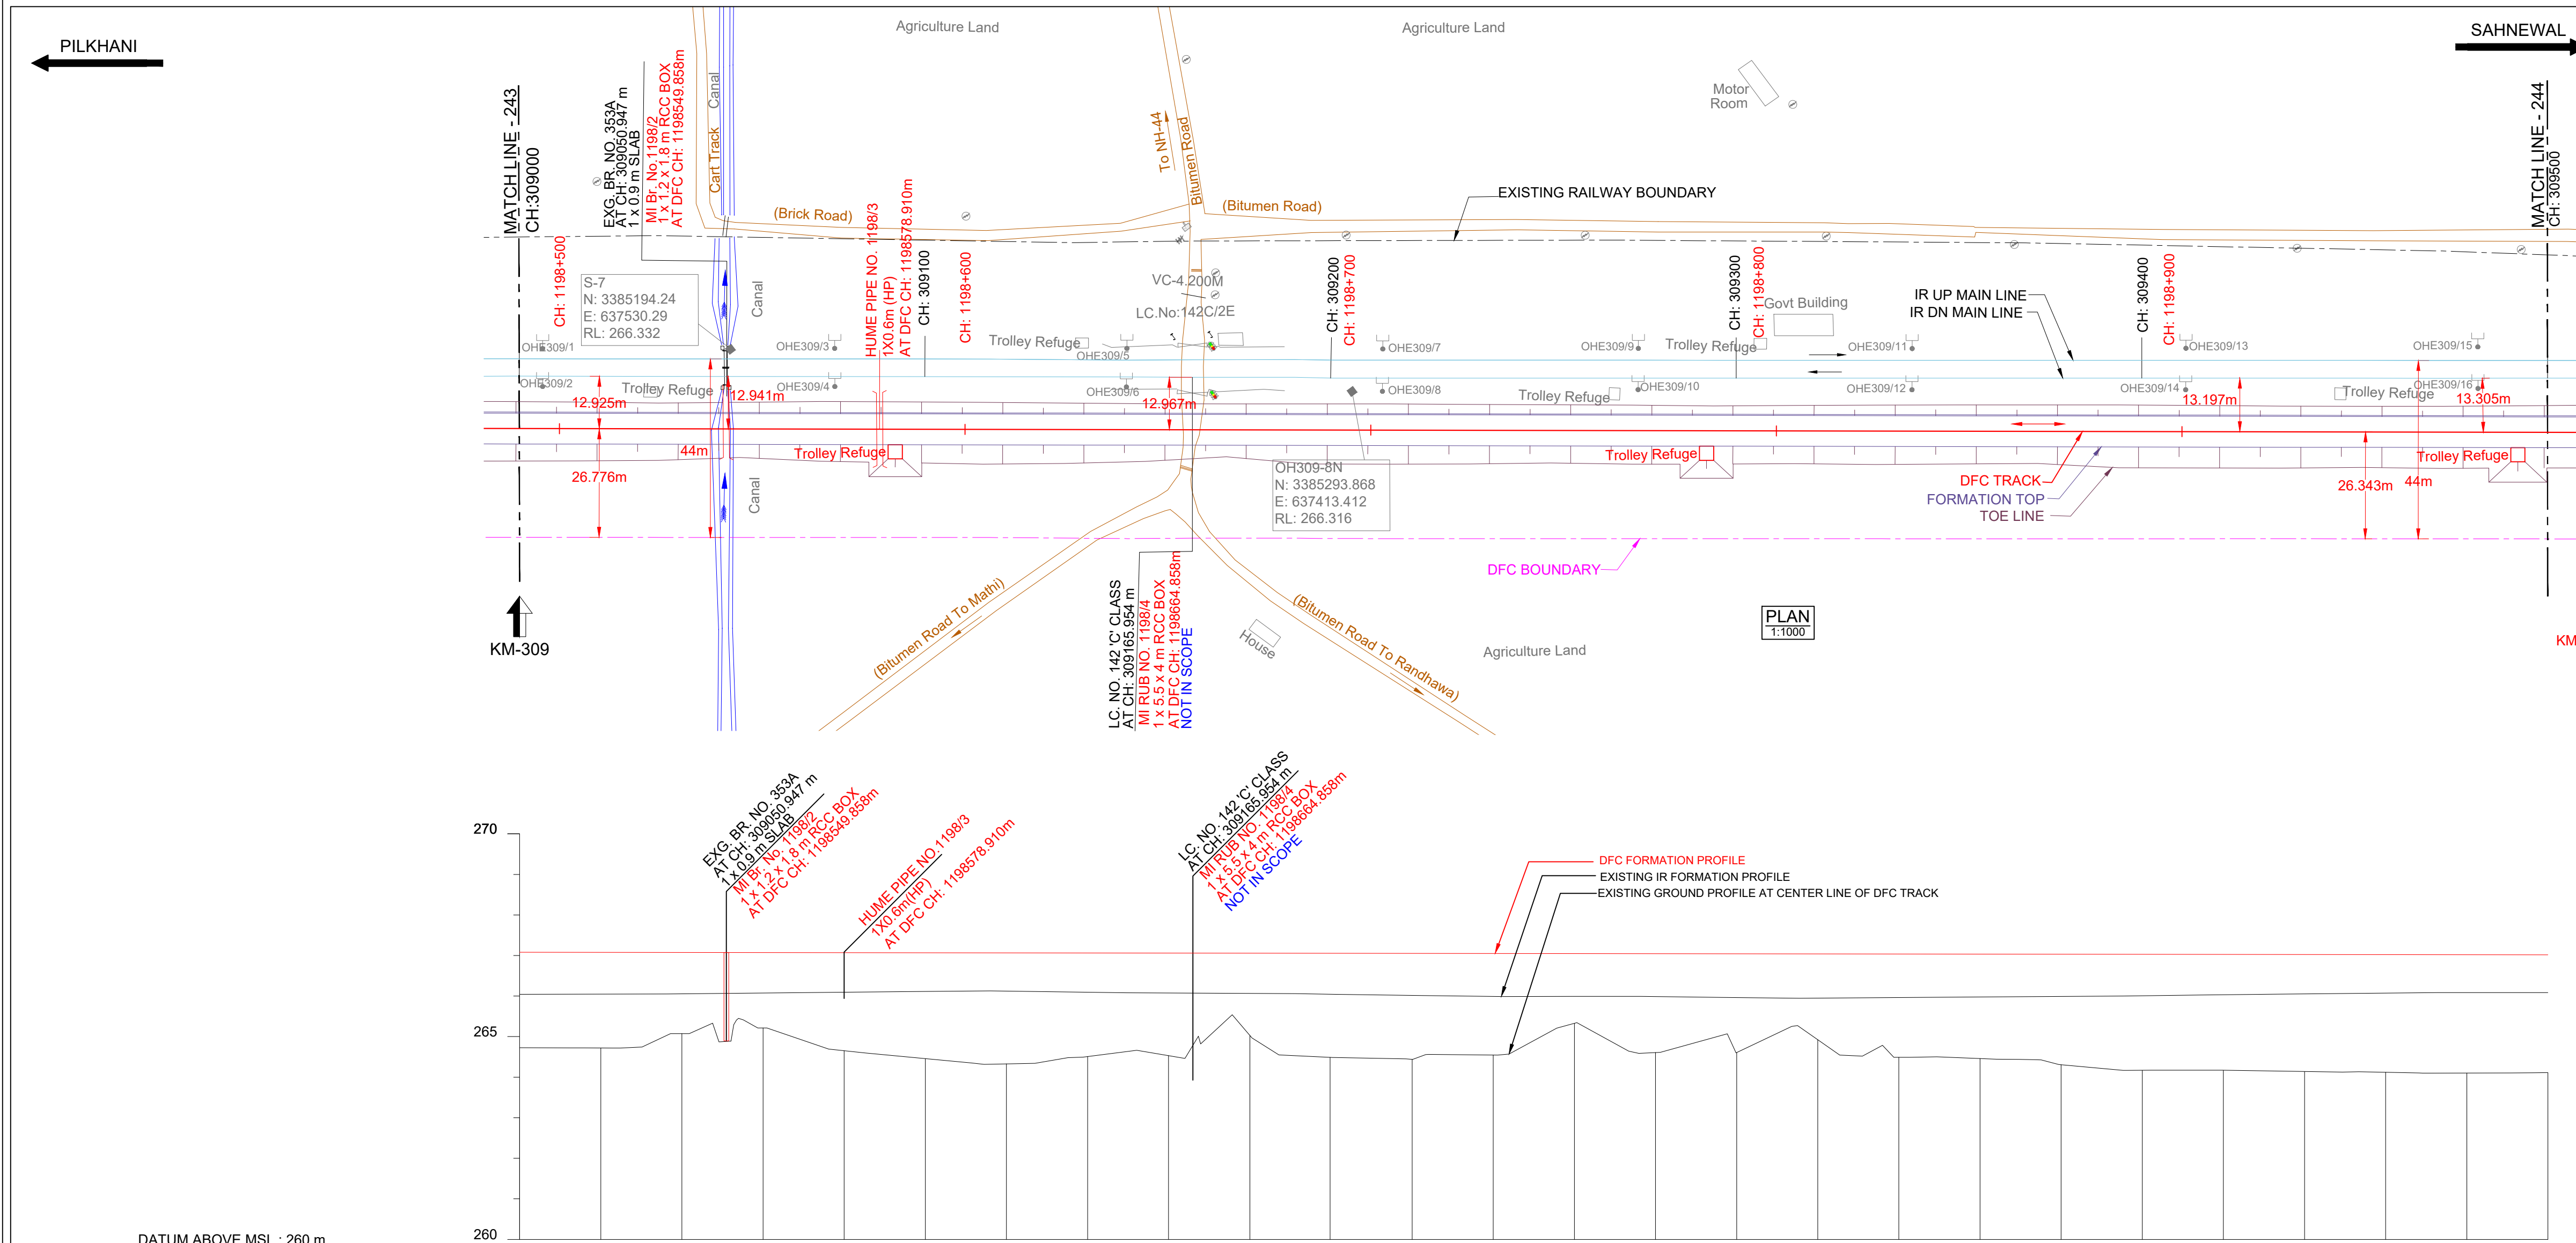

DIRECTION OF TRAVEL : EAST	
HORIZONTAL ALIGNMENT	L = 2263.954 m
VERTICAL ALIGNMENT	L=1476.005 m 1 IN 7974.823 F
TRACK DISTANCE FROM EXISTING NEAREST IR DN MAIN LINE TO DFC MAIN LINE	12.922 12.925 12.931 12.949 12.968 12.986 13.003 13.012 12.984 12.973 12.819 12.844 12.888 12.917 12.945 12.977 13.010 13.046 13.082 13.118 13.153 13.189 13.223 13.254 13.290 13.335
HEIGHT OF BANKING(+) / DEPTH OF CUTTING(-) (PFL-GL)	+2.354 +2.357 +2.002 +1.859 +2.416 +2.811 +2.737 +2.553 +2.528 +2.028 +2.565 +2.811 +2.502 +1.718 +2.438 +2.437 +2.116 +2.549 +2.575 +2.726 +2.860 +2.856 +2.885 +2.903 +2.918 +2.906
EXG GROUND LEVEL AT CENTER LINE OF DFC TRACK (GL)	264.726 264.721 265.073 265.215 264.654 264.457 264.328 264.510 264.532 265.030 264.490 264.442 264.548 265.330 264.607 264.606 264.924 264.489 264.480 264.307 264.170 264.140 264.120 264.102 264.112
EXG GROUND LEVEL AT TOE LOCATION OF DFC TRACK	264.695 264.747 264.911 265.044 264.688 264.523 264.423 264.574 264.933 265.100 264.475 264.491 264.546 264.615 264.532 264.567 264.589 264.555 264.636 264.541 264.171 264.194 264.235 264.174 264.235
DIFFERENCE BETWEEN DFC FORMATION LEVEL AND EXG.FORMATION LEVEL (PFL-EFL)	1.038 1.029 1.019 0.997 0.974 0.952 0.943 0.969 0.984 0.992 1.012 1.035 1.057 1.055 1.057 1.079 1.090 1.073 1.056 1.042 1.024 0.997 0.972 0.949 0.933 0.931
DFC FORMATION LEVEL (PFL)	267.080 267.078 267.075 267.073 267.070 267.068 267.065 267.063 267.060 267.058 267.055 267.053 267.050 267.048 267.045 267.043 267.040 267.038 267.035 267.033 267.030 267.028 267.025 267.023 267.020 267.018
EXG. FORMATION LEVEL OF EXG IR DN MAIN LINE (EFL)	266.042 266.049 266.056 266.076 266.096 266.116 266.122 266.094 266.076 266.066 266.043 266.018 265.993 265.993 265.988 265.964 265.950 265.965 265.979 265.991 266.006 266.031 266.053 266.074 266.087
DIFFERENCE BETWEEN DFC RAIL LEVEL AND EXG. RAIL LEVEL (PRL - ERL)	1.080 1.070 1.061 1.038 1.015 0.993 0.984 1.010 1.026 1.033 1.053 1.076 1.098 1.095 1.099 1.119 1.131 1.114 1.097 1.083 1.065 1.038 1.013 0.990 0.974 0.972
DFC RAIL LEVEL (PRL)	267.793 267.791 267.788 267.786 267.783 267.781 267.778 267.776 267.773 267.771 267.768 267.766 267.763 267.761 267.758 267.756 267.753 267.751 267.748 267.746 267.741 267.738 267.736 267.733 267.731 267.731
EXG.RAIL LEVEL OF NEAREST IR DN MAIN LINE(ERL)	266.714 266.721 266.728 266.748 266.768 266.788 266.794 266.766 266.748 266.738 266.715 266.690 266.665 266.665 266.660 266.636 266.622 266.637 266.651 266.663 266.678 266.703 266.725 266.746 266.759
EQUIVALENT CHAINAGE ON DFC TRACK	309000.0 309020.0 309040.0 309060.0 309080.0 309100.0 309120.0 309140.0 309160.0 309180.0 309200.0 309220.0 309240.0 309260.0 309280.0 309300.0 309320.0 309340.0 309360.0 309380.0 309400.0 309420.0 309440.0 309460.0 309480.0 309500.0
EXISTING IR CHAINAGE	309000.0 309020.0 309040.0 309060.0 309080.0 309100.0 309120.0 309140.0 309160.0 309180.0 309200.0 309220.0 309240.0 309260.0 309280.0 309300.0 309320.0 309340.0 309360.0 309380.0 309400.0 309420.0 309440.0 309460.0 309480.0 309500.0

L - SECTION

NOTE:-

- DFCC WORKS ARE SHOWN IN RED.
- IR NEW WORKS ARE SHOWN IN VIOLET.
- ALL DIMENSIONS ARE SHOWN IN METRES.
- THIS DRAWING IS PREPARED BASED ON LATEST SURVEY DATA HELD ON APRIL-2022. GTS BENCH MARK OF 261.850M CONSIDERED ON TOP OF CANAL BRIDGE ABUTMENT AT DORAH VILLAGE ALONG THE NH1.
- DFC NEW CHAINAGE OF 1075.950M IS WITH REFERENCE TO THE IR KM OF 187.500KM END OF KM OF CP-303(SECTION P-3 PILKHANI END) AGAINST THE EXISTING DFC CHAINAGE. 116277.742M ISSUED VIDE LETTER NO. COM/DFCC/UM/SURVEY/2021-301-230116-011173 DT. 17.01.2023.
- BALLAST PROFILE HAS BEEN PROVIDED ACCORDING TO THE CLAUSE 1.11.3 OF STANDARD SCHEDULE OF DIMENSION(EASTERN CORRIDOR) & THE BALLAST CUSHION DIMENSION SHOWN IN 35CM ON GE-14 PARA 17. SPECIFICATIONS & RECOMMENDATIONS 2. TWO LAYER SYSTEM FIG.10.

REFERENCE DRAWINGS :-

- FOR KEY PLAN REFER DRAWING NO. 301-2/AL/0001
- FOR LEGEND AND ABBREVIATIONS REFER DRAWING NO. 301-2/AL/1000
- FOR TYPICAL SECTION OF BALLAST PROFILE (FL-RL) REFER DRG. NO. 301-2/TK/TFD/-004 (TR.1952)

012.09.2024SUBMISSION OF AS-BUILT DRAWINGFOR APPROVAL

REV. DATE REVISION DETAILS PURPOSE OF ISSUE

SCALE
HOR - 1:1000
VER - 1:100
SHEET SIZE : A1

LEGEND:

- IR TRACK
- DFCC TRACK
- DFCC FUTURE PROPOSALS
- STRUCTURE / BUILDING
- DFCC TOE LINE
- DFCC FORMATION
- RETAINING WALL
- ROAD
- STREAM, DRAIN, NALA, CANAL.
- FENCE
- POWER LINES
- TBM
- ELECTRIC POLE/OHE MAST
- IR RAILWAY BOUNDARY
- DFCC BOUNDARY

TYPICAL SECTION

TRACK STRUCTURE

RAIL SECTION: 60Kg/m (UIC 60Kg/m)	Difference between FL- RL (Below Rail Seat)	
DFC LINE: 60Kg/m (UIC 60Kg/m)	IR Line	DFC
IR MAIN LINE: 52Kg/m	172mm	172mm
RUBBER PAD	6mm	10mm
SLEEPER DEPTH	210mm	210mm
BALLAST CUSHION	300mm	350mm
Total Depth (FL TO RL)	688mm	742mm

OWNER

DEDICATED FREIGHT CORRIDOR CORPORATION OF INDIA LTD.
(A GOVERNMENT OF INDIA ENTERPRISE)
PROJECT OFFICE/AMBALA UNIT: OLD RAILWAY COLONY (NEAR ANAND MARKET),AMBALA CANTT-133001.
CORPORATE IDENTITY NO. : U60232DL2006GGI155068

ENGINEER:

DB Engineering & Consulting GmbH
Deutsche Bahn Engineering & Consulting GmbH

CONTRACTOR:

GIL - TPL JV
GAR TATA

SUBMITTED BY	GIL - TPL JV		
	DATED	NAME	SIGNATURE
PREPARED BY			
CHECKED BY	12.09.2024	VIJAY PRATAP	
APPROVED BY	12.09.2024	PARASURAM KOTYADA	
APPROVED BY	DEUTSCHE BAHN ENGINEERING & CONSULTING GMBH		
	DATED	NAME	SIGNATURE
Sr. DE./CHIEF ENGINEER		SURESH K.YALANGI	
CHIEF TRACK ENGINEER		RAJ PAL SINGH	
T.L.		H.D. VIDJAK	

STAMP

A AS-BUILT DRAWING
TR. Ref.:.....
ENGINEER Sign.:.

EMPLOYER (DFCCIL):

DEDICATED FREIGHT CORRIDOR CORPORATION OF INDIA LTD.

AS BUILT DRAWING

TITLE
AS-BUILT PLAN AND PROFILE
FROM IR KM: 309.000 TO 309.500
DFC KM: 1198.490 TO 1198.990

DFCC APPR. NO. -
ENGG. APPR. NO. -
DRG. NO. -301-2/AL/A/1244
SHEET NO.: 1 OF 1
DATE : 12.09.2024

STATUS
A

TR.