


PILKHANI

SAHNEWAL

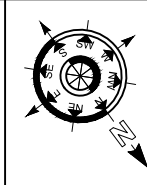

NOTE:-

1. DFCC WORKS ARE SHOWN IN **RED**.
2. IR NEW WORKS ARE SHOWN IN **VIOLET**.
3. ALL DIMENSIONS ARE SHOWN IN METRES.
4. THIS DRAWING IS PREPARED BASED ON LATEST SURVEY DATA HELD ON APRIL-2022. GTS BENCH MARK OF 261.850M CONSIDERED ON TOP OF CANAL BRIDGE ABUTMENT AT DORAHA VILLAGE ALONG THE NH1.
5. DFC NEW CHAINAGE OF 1075.950M IS WITH REFERENCE TO THE IR KM OF 187.500KM END OF KM OF CP-303(SECTION P-3 PILKHANI END) AGAINST THE EXISTING DFC CHAINAGE. 116277.742M ISSUED VIDE LETTER NO. COM/DFCC/UM/SURVEY/2021-301-230116-011173 DT. 17.01.2023.
6. BALLAST PROFILE HAS BEEN PROVIDED ACCORDING TO THE CLAUSE 1.11.3 OF STANDARD SCHEDULE OF DIMENSION(EASTERN CORRIDOR) & THE BALLAST CUSHION DIMENSION SHOWN IN 35CM ON GE-14 PARA 17. SPECIFICATIONS & RECOMMENDATIONS 2. TWO LAYER SYSTEM FIG.10.


DRG NO. - 301-2/AL/A/1247

REFERENCE DRAWINGS :-

1. FOR KEY PLAN REFER DRAWING NO. 301-2/AL/0001
2. FOR LEGEND AND ABBREVIATIONS REFER DRAWING NO. 301-2/AL/1000
3. FOR TYPICAL SECTION OF BALLAST PROFILE (FL-RL) REFER DRG. NO. 301-2/TK/TFD/-004 (TR.1952)

REV.	DATE	REVISION DETAILS	PURPOSE OF ISSUE
0	12.09.2024	SUBMISSION OF AS-BUILT DRAWING	FOR APPROVAL

SCALE		LEGEND:	
HOR - 1:1000 VER - 1:100 SHEET SIZE - A1		IR TRACK DFCC TRACK DFCC FUTURE PROPOSALS STRUCTURE / BUILDING DFCC TOE LINE DFCC FORMATION RETAINING WALL ROAD STREAM, DRAIN, NALA, CANAL. FENCE POWER LINES TBM ELECTRIC POLE/OHE MAST IR RAILWAY BOUNDARY DFCC BOUNDARY	

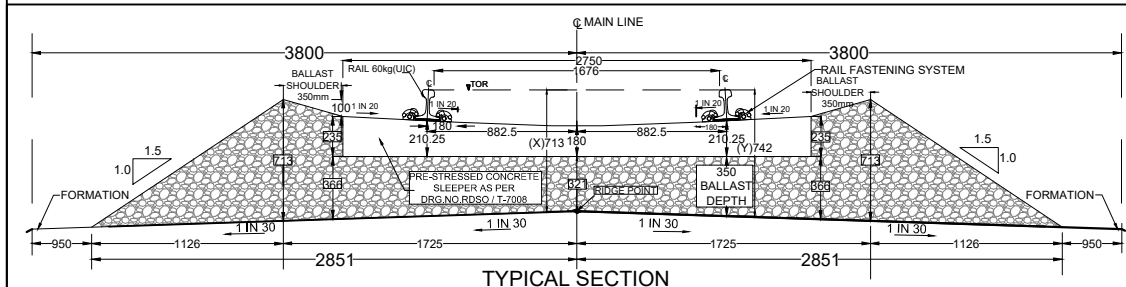

TRACK STRUCTURE		
RAIL SECTION: 60Kg/m (UIC 60Kg/m) DFC LINE: 60Kg/m (UIC 60Kg/m) IR MAIN LINE: 52Kg/m	Difference between FL- RL (Below Rail Seat)	
	IR Line	DFC
RUBBER PAD	172mm	172mm
SLEEPER DEPTH	210mm	210mm
BALLAST CUSHION	300mm	350mm
Total Depth (FL TO RL)	688mm	742mm

OWNER	DEDICATED FREIGHT CORRIDOR CORPORATION OF INDIA LTD. (A GOVERNMENT OF INDIA ENTERPRISE) PROJECT OFFICE (AMBALA UNIT): OLD RAILWAY COLONY (NEAR ANAND MARKET), AMBALA CANTT-133001. CORPORATE IDENTITY NO. : U60232DL2006GGI155068
-------	--

ENGINEER:	DB Engineering & Consulting GmbH Deutsche Bahn Engineering & Consulting GmbH
-----------	--

CONTRACTOR:	GIL - TPL JV GAR TATA
-------------	--


SUBMITTED BY	GIL - TPL JV		
	DATED	NAME	SIGNATURE
PREPARED BY	12.09.2024	VIJAY PRATAP	
CHECKED BY	12.09.2024	PARASURAM KOTYADA	
APPROVED BY	12.09.2024	PARASURAM KOTYADA	

APPROVED BY	DEUTSCHE BAHN ENGINEERING & CONSULTING GMBH		
	DATED	NAME	SIGNATURE
Sr. DE./CHIEF ENGINEER		SURESH K.YALANGI	
CHIEF TRACK ENGINEER		RAJ PAL SINGH	
T.L.		H.D. VIDJAK	

STAMP	A AS-BUILT DRAWING TR. Ref.:..... ENGINEER Sign.:.....
EMPLOYER (DFCCIL):	DEDICATED FREIGHT CORRIDOR CORPORATION OF INDIA LTD.

AS BUILT DRAWING		
TITLE	DFCC APPR. NO. - ENGG. APPR. NO. - DRG. NO. - 301-2/AL/A/1247 SHEET NO. : 1 OF 1 DATE : 12.09.2024	STATUS A
FROM IR KM: 310.500 TO 311.000 DFC KM: 1199.990 TO 1200.490		

TR.

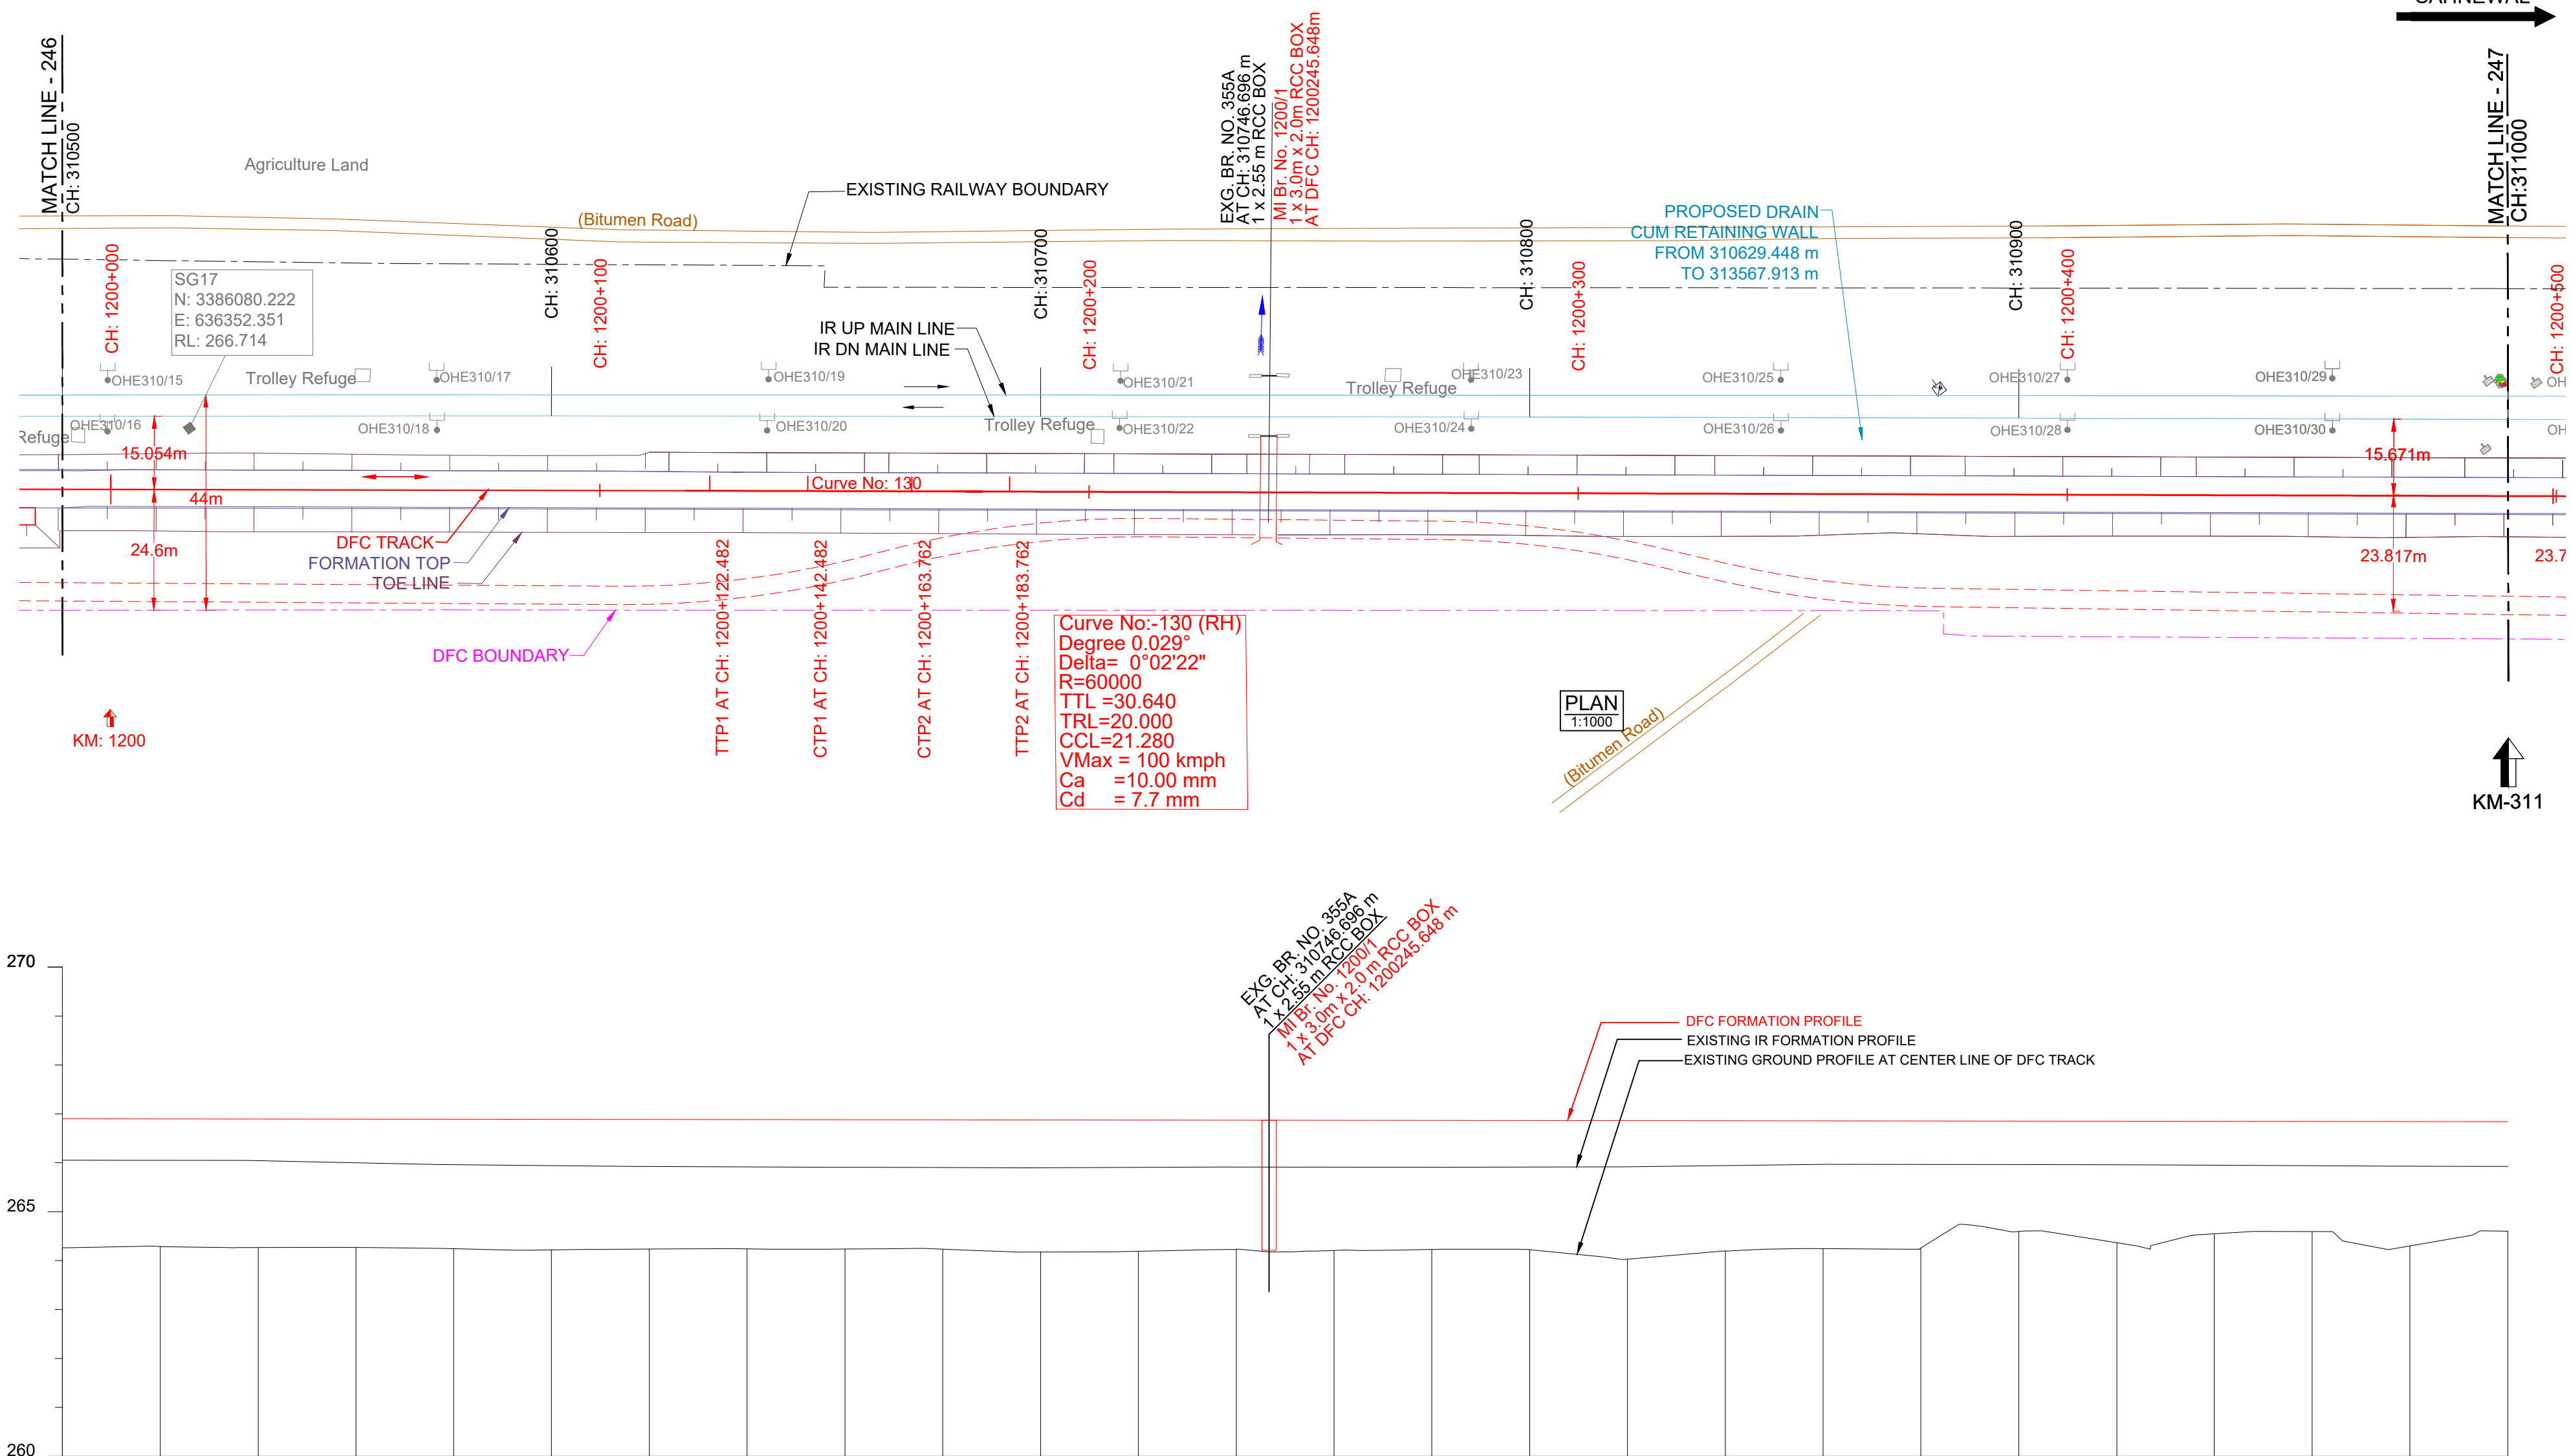

DATUM ABOVE MSL : 260 m

HORIZONTAL ALIGNMENT	L = 154.488m TL = 20 R = 60000 CC = 21.280 TL = 20 L = 357.529 m																											
VERTICAL ALIGNMENT	L=1485.963m 1 IN 8552.720 F																											
TRACK DISTANCE FROM EXISTING NEAREST IR DN MAIN LINE TO DFC MAIN LINE	14.937	14.937	14.989	15.045	15.133	15.211	15.236	15.261	15.282	15.306	15.340	15.376	15.404	15.432	15.463	15.495	15.541	15.589	15.606	15.623	15.634	15.644	15.565	15.679	15.673	15.668	15.663	
HEIGHT OF BANKING(+) / DEPTH OF CUTTING(-) (PFL-GL)	+2.637	+2.637	+2.610	+2.629	+2.625	+2.649	+2.668	+2.650	+2.644	+2.643	+2.646	+2.701	+2.684	+2.641	+2.663	+2.638	+2.641	+2.835	+2.664	+2.664	+2.612	+2.598	+2.556	+2.487	+2.302	+2.253	+2.543	+2.239
EXG GROUND LEVEL AT CENTER LINE OF DFC TRACK (GL)	264.263	264.263	264.288	264.266	264.268	264.242	264.220	264.236	264.240	264.238	264.233	264.176	264.190	264.231	264.207	264.229	264.224	264.196	264.196	264.196	264.246	264.258	264.597	264.364	264.547	264.593	264.603	
EXG GROUND LEVEL AT TOE LOCATION OF DFC TRACK	264.292	264.292	264.284	264.234	264.261	264.262	264.251	264.272	264.276	264.261	264.244	264.207	264.198	264.213	264.224	264.261	264.219	264.138	264.180	264.180	264.334	264.494	264.260	264.315	264.347	264.311	264.362	
DIFFERENCE BETWEEN DFC FORMATION LEVEL AND EXG.FORMATION LEVEL (PFL-EFL)	0.849	0.849	0.848	0.852	0.884	0.932	0.947	0.961	0.967	0.973	0.975	0.978	0.966	0.958	0.959	0.959	0.953	0.945	0.917	0.889	0.891	0.889	0.889	0.892	0.898	0.905	0.916	
DFC FORMATION LEVEL (PFL)	265.900	265.900	266.898	266.895	266.893	266.891	266.888	266.886	266.884	266.881	266.879	266.877	266.874	266.872	266.870	266.867	266.865	266.863	266.860	266.860	266.858	266.856	266.853	266.851	266.849	266.846	266.842	
EXG. FORMATION LEVEL OF EXG IR DN MAIN LINE (EFL)	266.051	266.051	266.050	266.043	266.099	266.959	266.941	266.925	266.917	266.908	266.904	266.899	266.908	266.914	266.911	266.908	266.912	266.918	266.943	266.943	266.967	266.965	266.964	266.959	266.951	266.941	266.926	
DIFFERENCE BETWEEN DFC RAIL LEVEL AND EXG. RAIL LEVEL (PRL - ERL)	0.890	0.890	0.889	0.893	0.934	0.972	0.988	1.002	1.007	1.014	1.016	1.018	1.007	0.998	0.999	1.000	0.993	0.986	0.958	0.958	0.932	0.931	0.930	0.933	0.938	0.946	0.956	
DFC RAIL LEVEL (PRL)	267.613	267.613	267.610	267.608	267.606	267.603	267.601	267.599	267.596	267.594	267.592	267.589	267.587	267.585	267.582	267.58	267.578	267.575	267.573	267.573	267.564	267.568	267.566	267.564	267.561	267.559	267.554	
EXG.RAIL LEVEL OF NEAREST IR DN MAIN LINE(ERL)	266.723	266.723	266.722	266.715	266.671	266.631	266.613	266.597	266.589	266.580	266.576	266.571	266.580	266.586	266.583	266.580	266.584	266.590	266.615	266.615	266.639	266.637	266.636	266.631	266.623	266.613	266.598	
EQUIVALENT CHAINAGE ON DFC TRACK	1199990.3	1199990.3	1200010.3	1200030.3	1200050.3	1200070.3	1200090.3	1200110.3	1200130.3	1200150.3	1200170.3	1200190.2	1200210.2	1200230.3	1200250.3	1200270.3	1200290.3	1200310.2	1200330.2	1200350.2	1200370.2	1200390.2	1200410.3	1200430.2	1200450.2	1200470.2	1200490.3	
EXISTING IR CHAINAGE	310500.0	310500.0	310520.0	310540.0	310560.0	310580.0	310600.0	310620.0	310640.0	310660.0	310680.0	310700.0	310720.0	310740.0	310760.0	310780.0	310800.0	310820.0	310840.0	310860.0	310880.0	310900.0	310920.0	310940.0	310960.0	310980.0	311000.0	

L - SECTION