


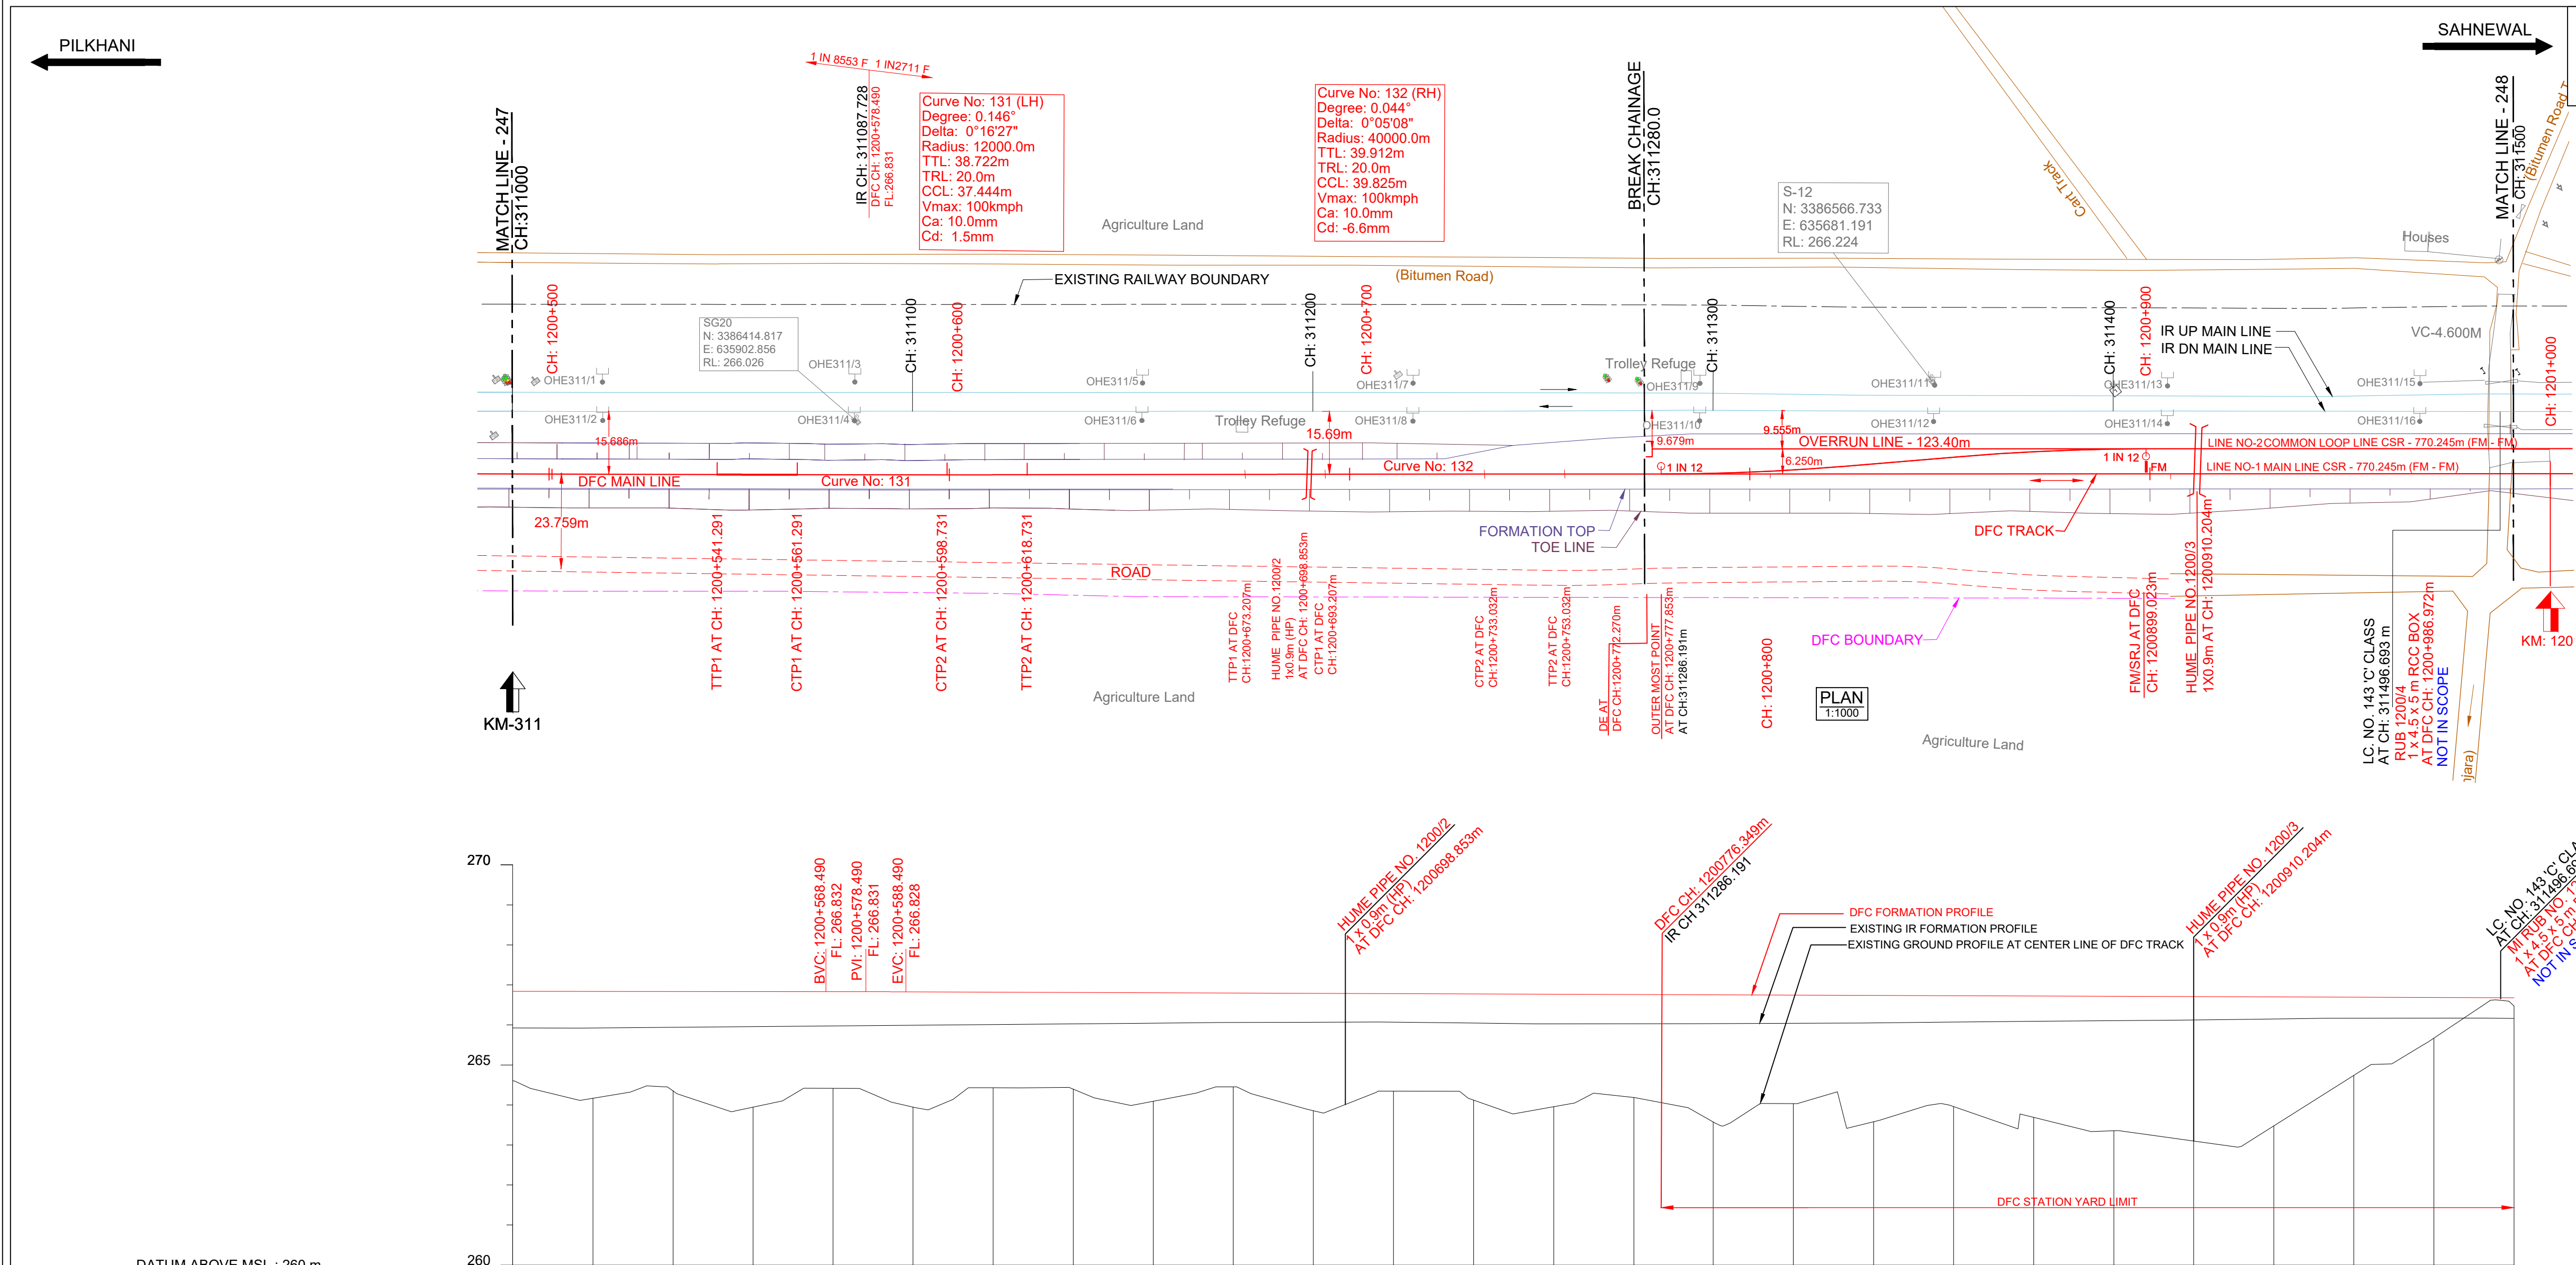

DATUM ABOVE MSL : 260 m

HORIZONTAL ALIGNMENT	TL=20 R = -12000 CC = 37.444 TL=20 L = 54.486 m TL=20 R = 40000 CC = 39.825 TL=20 L = 867.010 m																																																		
VERTICAL ALIGNMENT	L=1485.963m 1 IN 8552.720 F L=20.0 m R=79391 m L=2139.573 m 1 IN 2711.213 F																																																		
TRACK DISTANCE FROM EXISTING NEAREST IR DN MAIN LINE TO DFC MAIN LINE	15.683		15.671		15.746		15.820		15.875		15.892		15.858		15.818		15.803		15.776		15.715		15.668		15.673		15.759		15.852		15.905		15.794		15.695		15.688		15.681		15.685		15.645		15.606		15.571		15.550		
HEIGHT OF BANKING(+) / DEPTH OF CUTTING(-) (PFL-GL)	+2.239		+2.672		+2.484		+2.890		+2.418		+2.880		+2.391		+2.416		+2.711		+2.345		+2.932		+2.437		+2.656		+2.574		+3.179		+2.712		+3.157		+3.035		+3.359		+3.611		+3.224		+1.954		+1.019		+0.208				
EXG GROUND LEVEL AT CENTER LINE OF DFC TRACK (GL)	264.603		264.167		264.353		263.945		264.414		263.947		264.429		264.396		264.094		264.452		263.858		264.346		264.119		264.187		263.574		263.619		263.557		263.689		263.516		263.357		263.098		264.740		265.668		266.471				
EXG GROUND LEVEL AT TOE LOCATION OF DFC TRACK	264.362		264.307		264.302		264.107		264.320		264.257		264.376		264.222		264.074		264.159		263.934		263.845		263.890		263.900		263.626		263.626		263.557		263.795		263.516		264.213		264.805		265.348		266.005		266.471				
DIFFERENCE BETWEEN DFC FORMATION LEVEL AND EXG.FORMATION LEVEL (PFL-EFL)	0.916		0.916		0.898		0.879		0.857		0.835		0.810		0.785		0.761		0.737		0.722		0.713		0.729		0.732		0.721		0.705		0.686		0.659		0.608		0.584		0.552		0.527		0.518		0.517				
DFC FORMATION LEVEL (PFL)	265.842		265.839		265.837		265.835		265.832		265.827		265.820		265.812		265.805		265.797		265.790		265.783		265.775		265.761		265.753		265.746		265.738		265.724		265.716		265.709		265.702		265.694		265.687		265.679				
EXG. FORMATION LEVEL OF EXG IR DN MAIN LINE (EFL)	265.926		265.923		265.939		265.956		265.975		265.992		266.010		266.027		266.044		266.060		266.068		266.070		266.046		266.029		266.032		266.041		266.052		266.072		266.108		266.125		266.150		266.167		266.169		266.162				
DIFFERENCE BETWEEN DFC RAIL LEVEL AND EXG. RAIL LEVEL (PRL - ERL)	0.956		0.956		0.938		0.919		0.898		0.876		0.850		0.826		0.801		0.778		0.763		0.754		0.770		0.772		0.762		0.745		0.727		0.700		0.649		0.625		0.593		0.568		0.558						
DFC RAIL LEVEL (PRL)	267.554		267.552		267.550		267.547		267.545		267.540		267.532		267.525		267.518		267.510		267.503		267.495		267.488		267.481		267.473		267.466		267.459		267.444		267.429		267.422		267.414		267.407		267.400		267.392				
EXG.RAIL LEVEL OF NEAREST IR DN MAIN LINE(ERL)	266.598		266.595		266.611		266.628		266.647		266.664		266.682		266.699		266.716		266.732		266.740		266.742		266.718		266.701		266.704		266.713		266.724		266.733		266.750		266.757		266.763		266.769		266.784		266.789				
EQUIVALENT CHAINAGE ON DFC TRACK	1200490.3		1200510.3		1200530.3		1200550.3		1200570.3		1200590.3		1200610.3		1200630.3		1200650.3		1200670.3		1200690.3		1200710.3		1200730.3		1200750.3		1200770.3		1200790.2		1200810.2		1200830.3		1200850.3		1200870.3		1200890.3		1200910.2		1200930.2		1200950.2		1200970.2		
EXISTING IR CHAINAGE	311000.0		311020.0		311040.0		311060.0		311080.0		311100.0		311120.0		311140.0		311160.0		311180.0		311200.0		311220.0		311240.0		311260.0		311280.0		311300.0		311320.0		311340.0		311360.0		311380.0		311400.0		311420.0		311440.0		311460.0		311480.0		311500.0

L - SECTION

NOTE:-

- DFCC WORKS ARE SHOWN IN RED.
- IR NEW WORKS ARE SHOWN IN VIOLET.
- ALL DIMENSIONS ARE SHOWN IN METRES.
- THIS DRAWING IS PREPARED BASED ON LATEST SURVEY DATA HELD ON APRIL-2022. GTS BENCH MARK OF 261.850M CONSIDERED ON TOP OF CANAL BRIDGE ABUTMENT AT DORAHA VILLAGE ALONG THE NH1.
- DFC NEW CHAINAGE OF 1075.950M IS WITH REFERENCE TO THE IR KM OF 187.500KM END OF KM OF CP-303(SECTION P-3 PILKHANI END) AGAINST THE EXISTING DFC CHAINAGE. 116277.742M ISSUED VIDE LETTER NO. COM/DFCC/MB/SURVEY/2021-301-230116-011173.DT. 17.01.2023
- BALLAST PROFILE HAS BEEN PROVIDED ACCORDING TO THE CLAUSE 1.11.3 OF STANDARD SCHEDULE OF DIMENSION(EASTERN CORRIDOR) & THE BALLAST CUSHION DIMENSION SHOWN IN 35CM ON GE-14 PARA 17. SPECIFICATIONS & RECOMMENDATIONS 2. TWO LAYER SYSTEM FIG.10.

REFERENCE DRAWINGS :-

- FOR KEY PLAN REFER DRAWING NO. 301-2/AL/0001
- FOR LEGEND AND ABBREVIATIONS REFER DRAWING NO. 301-2/AL/1000
- FOR TYPICAL SECTION OF BALLAST PROFILE (FL-RL) REFER DRG. NO. 301-2/TK/TFD/004 (TR.1952)

0	12.09.2024	SUBMISSION OF AS-BUILT DRAWING	FOR APPROVAL
REV.	DATE	REVISION DETAILS	PURPOSE OF ISSUE

LEGEND:

IR TRACK

DFCC TRACK

DFCC FUTURE PROPOSALS

STRUCTURE / BUILDING

DFCC TOE LINE

DFCC FORMATION

RETAINING WALL

ROAD

STREAM, DRAIN, NALA, CANAL.

FENCE

POWER LINES

TBM

ELECTRIC POLE/OHE MAST

IR RAILWAY BOUNDARY

DFCC BOUNDARY

SCALE

HOR - 1:1000

VER - 1:100

SHEET SIZE : A1

TYPICAL SECTION

TRACK STRUCTURE

RAIL SECTION: 60Kg/m (UIC 60Kg/m)	Difference between FL- RL (Below Rail Seat)	
DFC LINE: 60Kg/m (UIC 60Kg/m)	IR Line	DFC
IR MAIN LINE: 52Kg/m	172mm	172mm
RUBBER PAD	6mm	10mm
SLEEPER DEPTH	210mm	210mm
BALLAST CUSHION	300mm	350mm
Total Depth (FL TO RL)	688mm	742mm

OWNER

DEDICATED FREIGHT CORRIDOR CORPORATION OF INDIA LTD.

(A GOVERNMENT OF INDIA ENTERPRISE)

PROJECT OFFICE/AMBALA UNIT: OLD RAILWAY COLONY (NEAR ANAND MARKET),AMBALA CANTT-133001.

CORPORATE IDENTITY NO. : U60232DL2006GGI155068

ENGINEER:

DB Engineering & Consulting GmbH

Deutsche Bahn Engineering & Consulting GmbH

CONTRACTOR:

GIL - TPL JV

GAR

TATA

SUBMITTED BY	GIL - TPL JV		
PREPARED BY	DATED	NAME	SIGNATURE
CHECKED BY	12.09.2024	VIJAY PRATAP	
APPROVED BY	12.09.2024	PARASURAM KOTYADA	
APPROVED BY	DEUTSCHE BAHN ENGINEERING & CONSULTING GMBH		
	DATED	NAME	SIGNATURE
Sr. DE./CHIEF ENGINEER		SURESH K.YALANGI	
CHIEF TRACK ENGINEER		RAJ PAL SINGH	
T.L.		H.D. VIDJAK	

STAMP

A

AS-BUILT DRAWING

TR. Ref.....

ENGINEER Sign.:

EMPLOYER (DFCCIL):

DEDICATED FREIGHT CORRIDOR CORPORATION OF INDIA LTD.

TITLE

AS-BUILT PLAN AND PROFILE

FROM IR KM: 311.000 TO 311.500

DFC KM: 1200.490 TO 1200.990

DFCC APPR. NO. -

ENGG. APPR. NO. -

DRG. NO. -301-2/AL/A/1248

SHEET NO. : 1 OF 1

DATE : 12.09.2024

STATUS

A

TR.