




DEDICATED FREIGHT CORRIDOR CORPORATION OF INDIA LTD.
(A GOVERNMENT OF INDIA ENTERPRISE)

EASTERN DEDICATED FREIGHT CORRIDOR
SAHNEWAL TO PILKHANI SECTION
CONTRACT PACKAGE - 301

PLAN & PROFILE OF AS BUILT DRAWINGS FOR DFC MAIN LINE

IR CHAINAGE FROM 311.500 KM TO 315.000 KM
DFCC CHAINAGE FROM KM 1200.990 TO KM 1204.477

DESIGN CONSULTANT


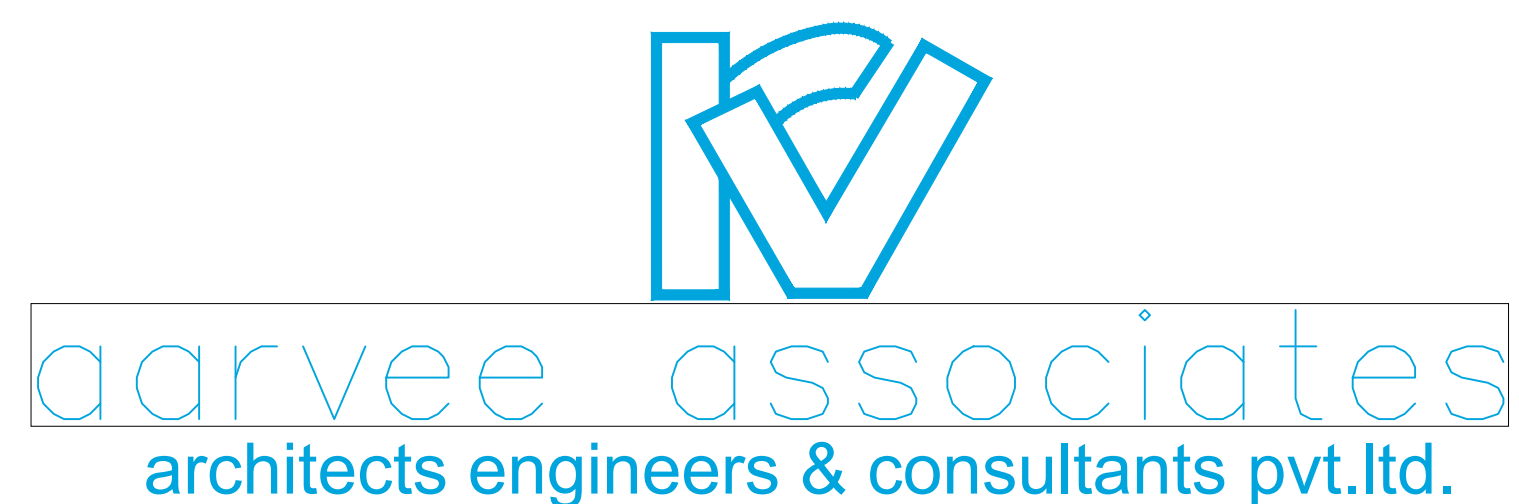


ENGINEER



CONTRACTOR CLIENT
GIL - TPL JV



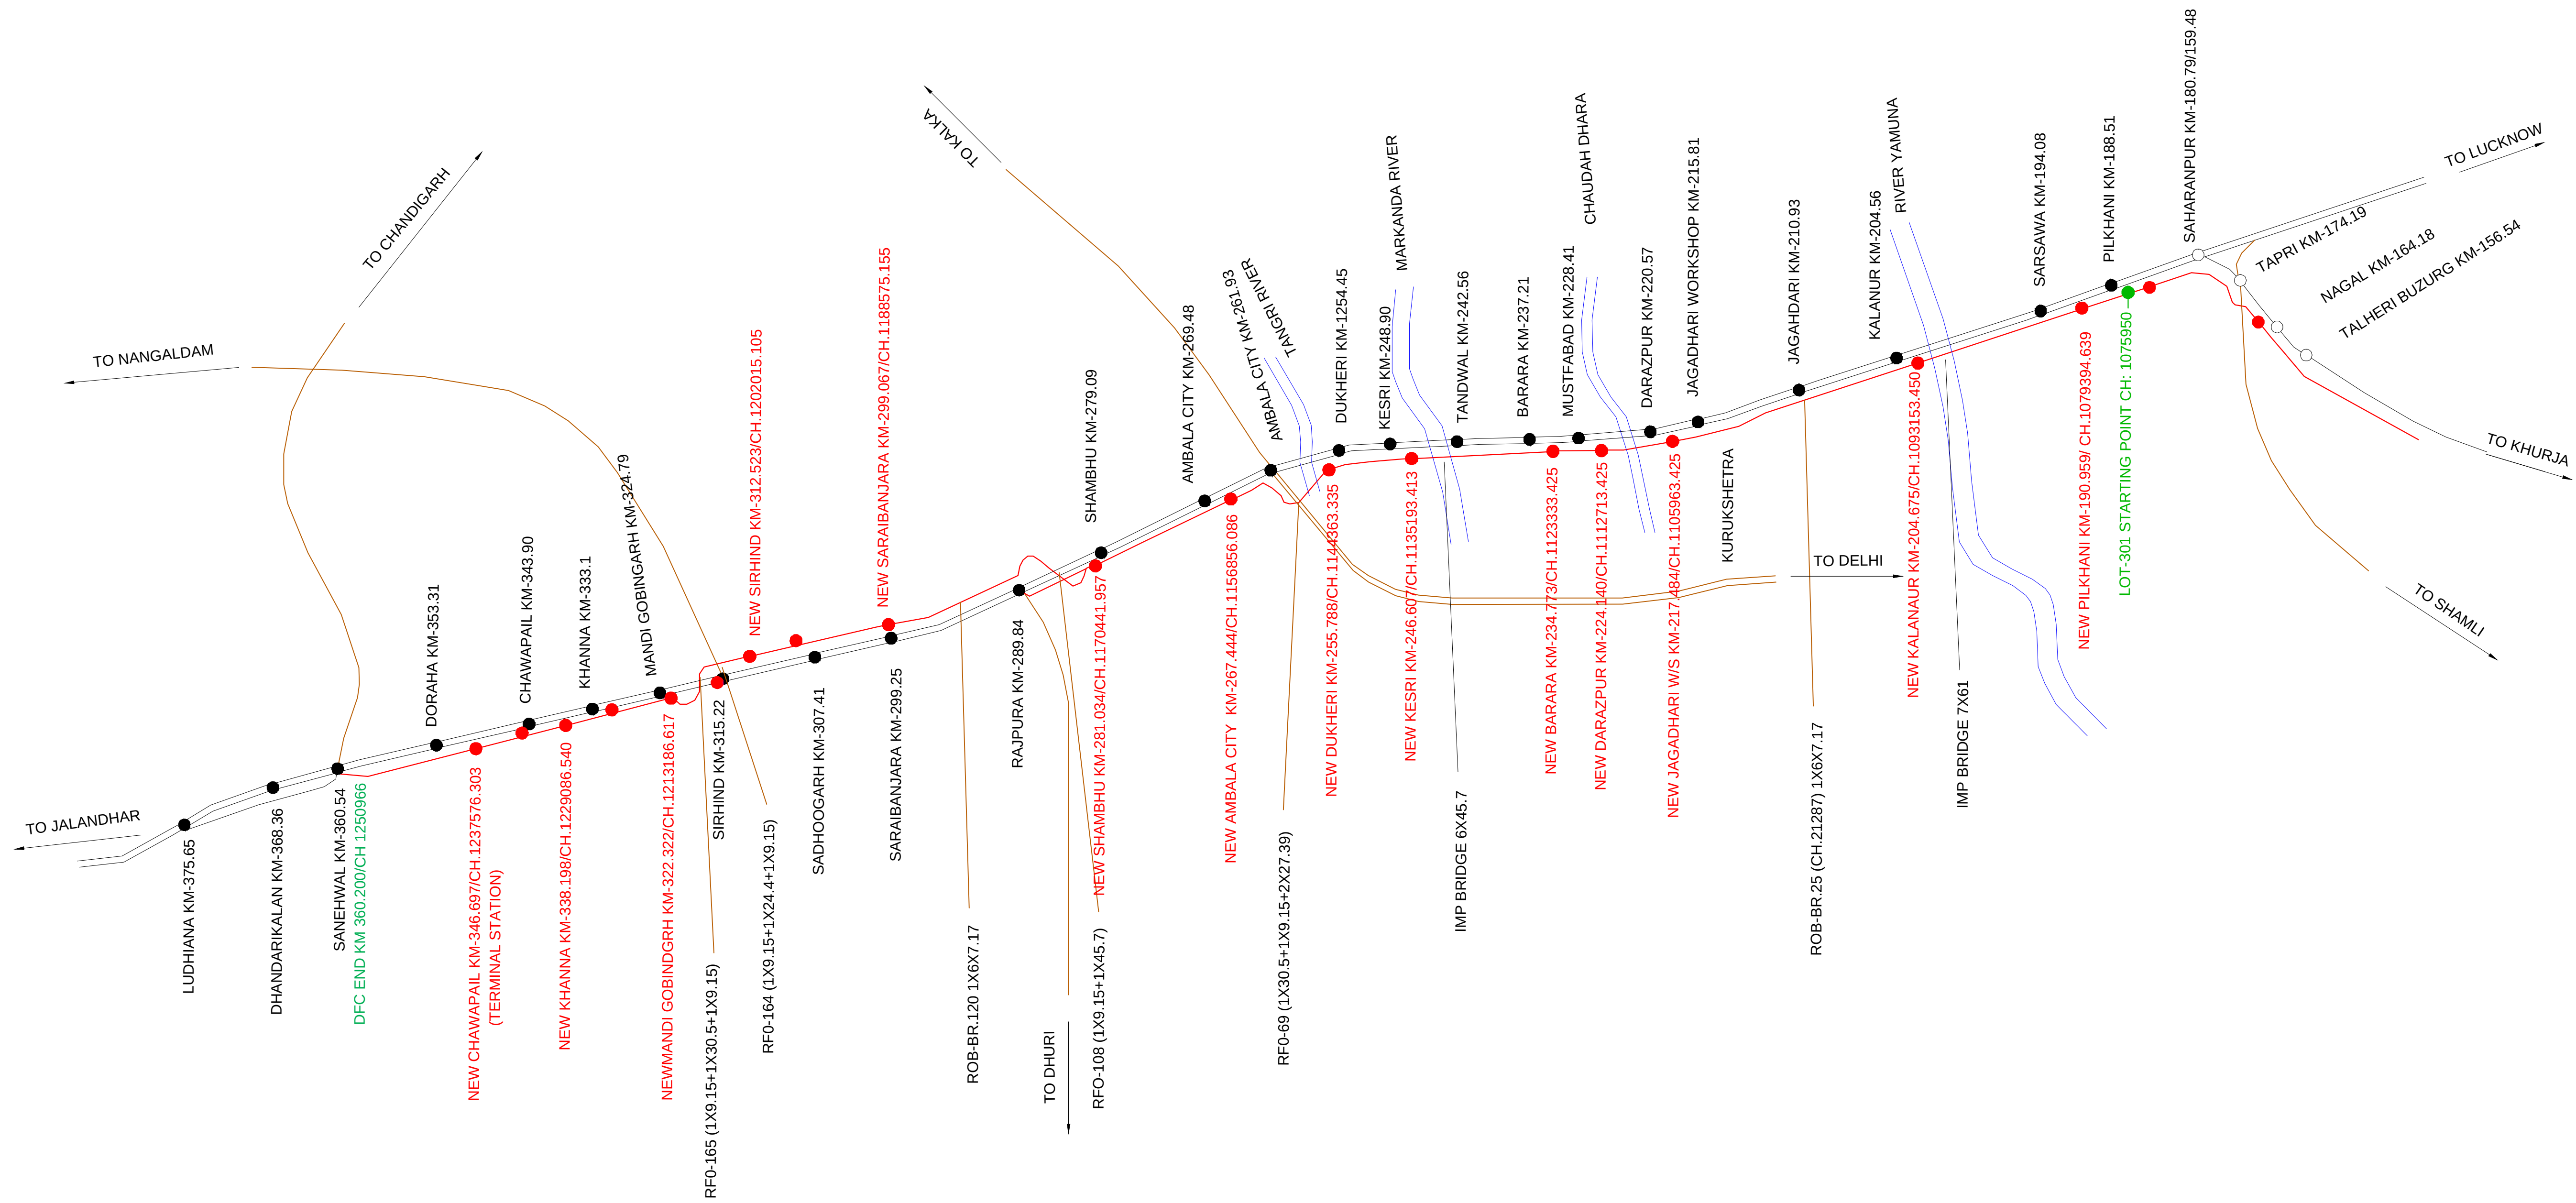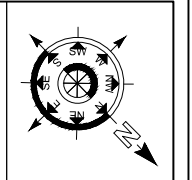

																																																																																																																																																																																																																																																																																																																																																																																																																																																																																																																																																																																																																																																																																																																																																																																																																																																																																																																																																																																																																																																																																																																																																																																																																																																																																																																																																																																																																																																																																										</
--	--	----

DESIGN CONSULTANT

aarvee associates
architects engineers & consultants Pvt.Ltd.

CONTRACTOR

GIL - TPL JV

ENGINEER

DB Engineering &
Consulting GmbH

OWNER

उत्तर प्रदेश रेलवे कोरपोरेशन लिमिटेड

DEDICATED FREIGHT CORRIDOR CORPORATION OF INDIA LTD.
(A GOVERNMENT OF INDIA ENTERPRISE)
PROJECT OFFICE(AMBALA UNIT): OLD RAILWAY COLONY (NEAR
ANAND MARKET),AMBALA CANTT-133001.
CORPORATE IDENTITY NO. : U60232DL2006GOI155068

PROJECT
EASTERN DEDICATED FREIGHT CORRIDOR
SAHNEWAL TO PILKHANI
CONTRACT PACKAGE - 301


TITLE
ALIGNMENT DRAWINGS
KEY PLAN

DFCC APPR. NO. -
ENGG. APPR. NO. -
DRG. NO. - 301-2/AL/0001
SHEET NO. : 1 OF 1
DATE : 15-06-2024
REV. No. 0
STATUS A


LEGEND	
EXISTING IR TRACK	
DFC TRACK	
DFC FUTURE PROPOSALS	
IR PROPOSALS	
TOE LINE	
FORMATION CESS	
RETAINING WALL	
DRAIN CUM RETAINING WALL	
ROAD	
STREAM, DRAIN, NALA, CANAL.	
FENCE	
POWER LINES	
GPS POINTS	
ELECTRIC POLE/OHE MAST	
EXISTING RAILWAY BOUNDARY	
DFC BOUNDARY	
DISMANTLED WORKS	
IOCL PIPE LINE	
IOCL ROW	
SIGNALLING CABLE PIPE	

ABBREVIATIONS		
1.	BL	- BED LEVEL
2.	BVC	- BEGIN OF VERTICAL CURVE
3.	Ca	- APPLIED CANT
4.	CCL	- CIRCULAR CURVE LENGTH
5.	CTP1	- COMMON TANGENT POINT
6.	CTP2	- COMMON TANGENT POINT
7.	DEGREE	- DEGREE OF CURVE
8.	DE	- DEAD END
9.	ECL	- EXISTING CLEARANCE
10.	EFB	- EXISTING FREE BOARD
11.	EFL	- EXISTING FORMATION LEVEL
12.	ERL	- EXISTING RAIL LEVEL
13.	ESL	- EXISTING SOFFIT LEVEL
14.	EVC	- END OF VERTICAL CURVE
15.	EVCL	- EXISTING VERTICAL CLEARANCE
16.	F/CSB	- FROM CENTER LINE OF STN BLDG
17.	FM	- FOULING MARK
18.	FSL	- FULL SUPPLY LEVEL
19.	HFL	- HIGH FLOOD LEVEL
20.	L	- STRAIGHT LENGTH
21.	LH	- LEFT HANDED
22.	LHS	- LIMITED HEIGHT SUBWAY
23.	PCL	- PROPOSED CLEARANCE
24.	PFB	- PROPOSED FREE BOARD
25.	PFL	- PROPOSED FORMATION LEVEL
26.	PRL	- PROPOSED RAIL LEVEL
27.	PSL	- PROPOSED SOFFIT LEVEL
28.	PVCL	- PROPOSED VERTICAL CLEARANCE
29.	PVI	- POINT OF VERTICAL INTERSECTION
30.	R	- RADIUS
31.	REV.BL	- REVISED BED LEVEL
32.	RH	- RIGHT HANDED
33.	Rr	- RESULTANT RADIUS
34.	SE	- SUPER ELEVATION
35.	SRJ	- STOCK RAIL JOINT
36.	TS	- TRAP SWITCH
37.	TTL	- TOTAL TANGENT LENGTH
38.	TTP1	- TRANSITION TANGENT POINT
39.	TTP2	- TRANSITION TANGENT POINT
40.	TL	- TRANSITION LENGTH
41.	DELTA	- DEFLECTION ANGLE

				SCALE	DESIGN CONSULTANT	CONTRACTOR	ENGINEER	OWNER	PROJECT	TITLE	DFCC APPR. NO. -			
				NOT TO SCALE	 aarvee associates architects engineers & consultants pvt.ltd.	  GIL - TPL JV	 DB Engineering & Consulting GmbH	 डेडीकेटर गैरट करपोरेटर	DEDICATED FREIGHT CORRIDOR CORPORATION OF INDIA LTD. (A GOVERNMENT OF INDIA ENTERPRISE) PROJECT OFFICE(AMBALA UNIT): OLD RAILWAY COLONY (NEAR ANAND MARKET),AMBALA CANTT-133001. CORPORATE IDENTITY NO. : U60232DL2006GOI155068	EASTERN DEDICATED FREIGHT CORRIDOR SAHNEWAL TO PILKHANI CONTRACT PACKAGE - 301	ALIGNMENT DRAWINGS LEGEND AND ABBREVIATIONS	ENG. APPR. NO. -		
														DRG. NO. - 301-2/AL/1000
REV.	DATE	REVISION DETAILS	PURPOSE OF ISSUE								SHEET NO. : 1 OF 1	REV. No.	STATUS	
											DATE : 15-06-2024	0	A	

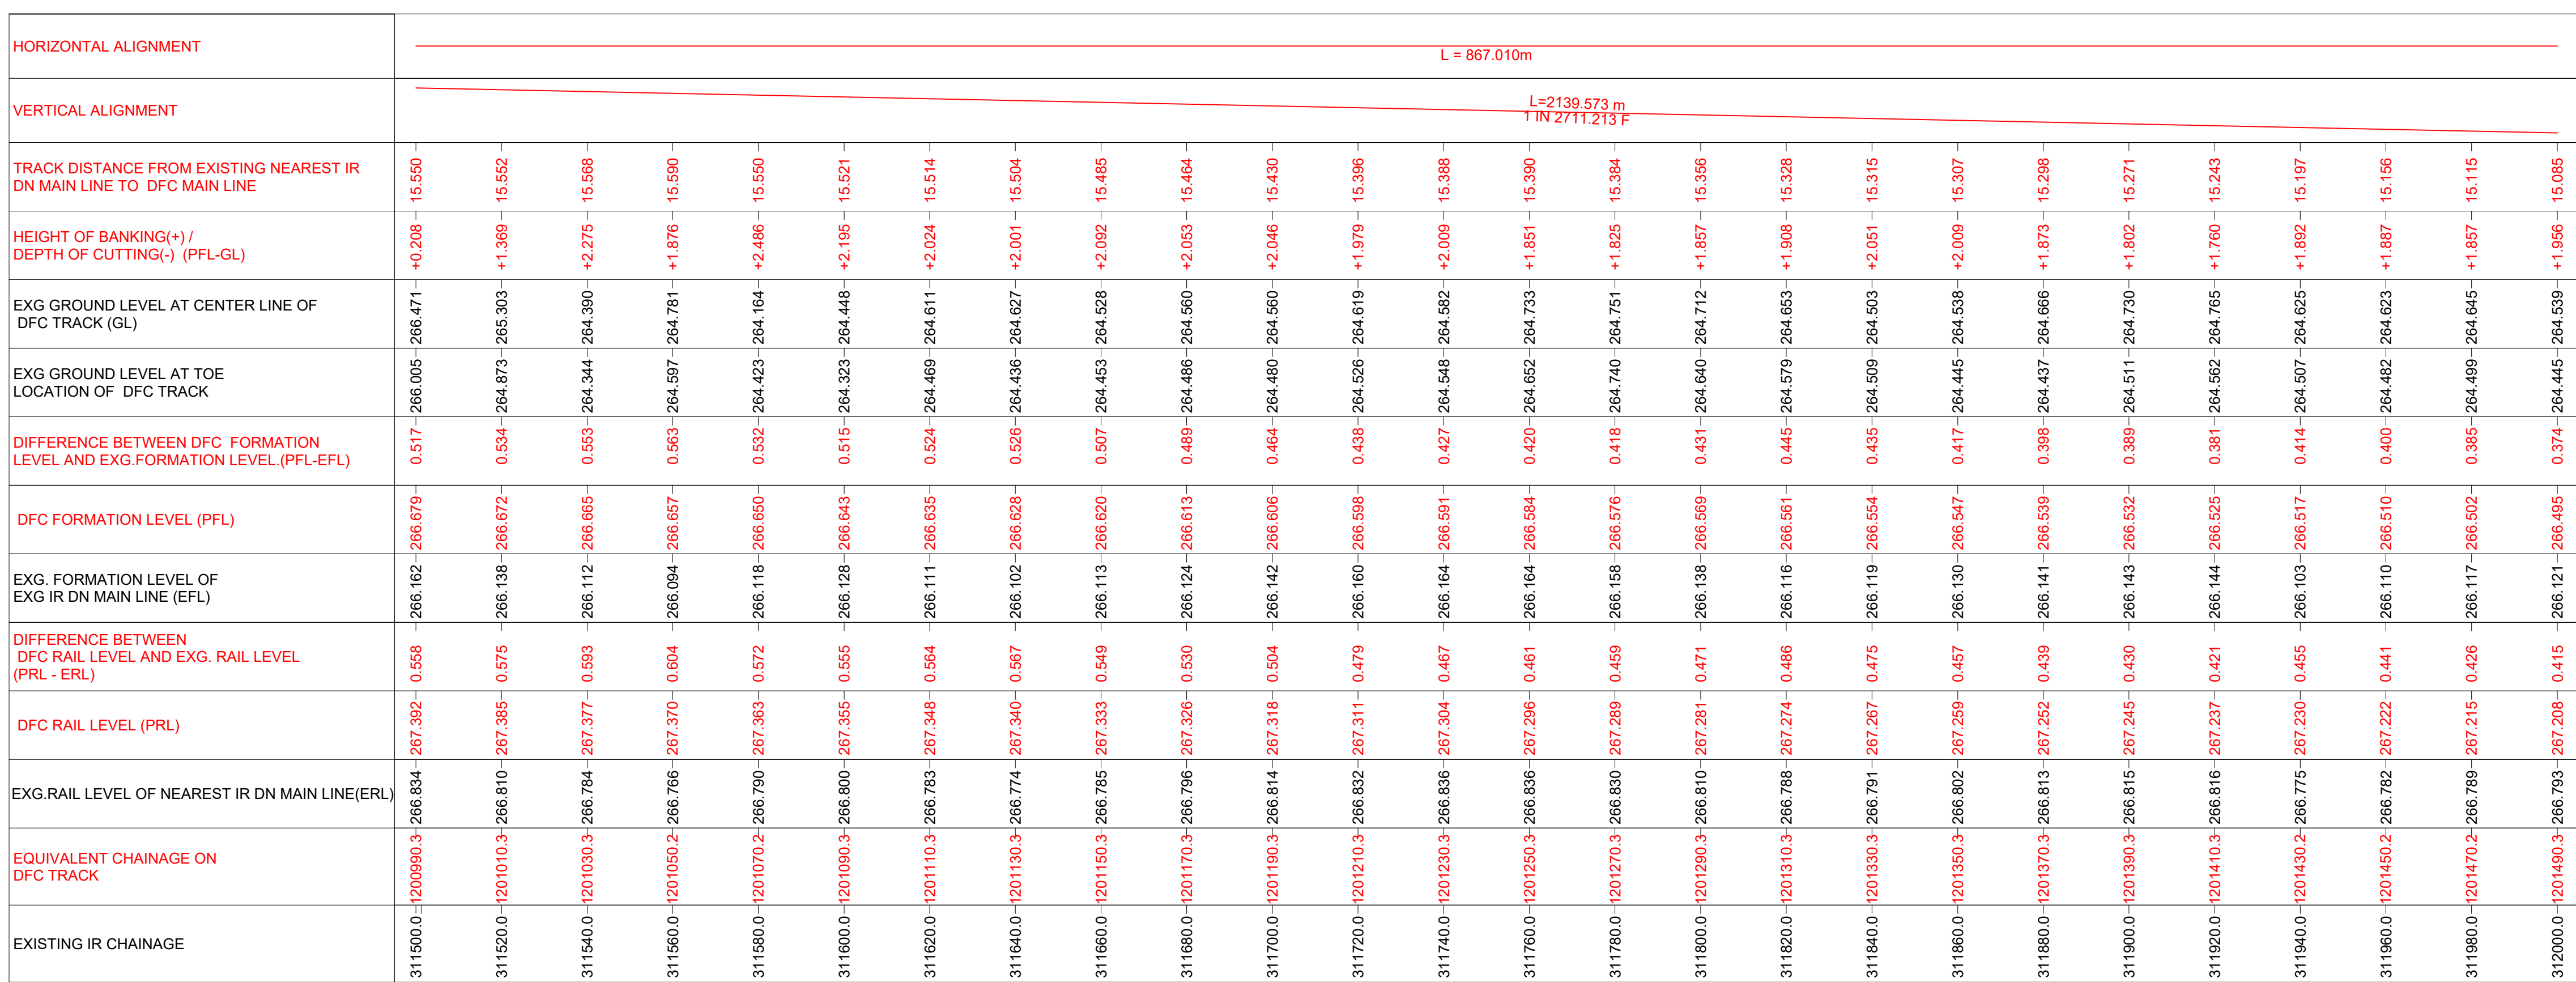

L - SECTION

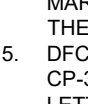

GOVERNMENT OF KARNATAKA
KARNATAKA P.W.D.

NOTE:-

1. DFC WORKS ARE SHOWN IN **RED**.
2. IR NEW WORKS ARE SHOWN IN **VIOLET**.
3. ALL DIMENSIONS ARE SHOWN IN METRES.
4. THIS DRAWING IS PREPARED BASED ON LATEST SURVEY DATA HELD ON APRIL-2022. GTS BENCH MARK OF 261.850M CONSIDERED ON TOP OF CANAL BRIDGE ABUTMENT AT DORAHA VILLAGE ALONG THE NH1.
5. DFC NEW CHAINAGE OF 1075.950M IS WITH REFERENCE TO THE IR KM OF 187.500KM END OF KM OF CP-303/SECTION P-3 PILKHANI END) AGAINST THE EXISTING DFC CHAINAGE. 116277.742M ISSUED VIDE LETTER NO. CGMDFCC/JUMBS/SURVEY/2021-301-2301-16-0113 DT. 17.01.2023.
6. BALLAST PROFILE HAS BEEN PROVIDED ACCORDING TO THE CLAUSE 1.11.3 OF STANDARD SCHEDULE OF DIMENSIONS(EASTERN CORRIDOR) & THE BALLAST CUSHION DIMENSION SHOWN IN 35CM ON GE-14 PARA 17. SPECIFICATIONS & RECOMMENDATIONS 2. TWO LAYER SYSTEM FIG.10.


REFERENCE DRAWINGS :-

1. FOR KEY PLAN REFER DRAWING NO. 301-2/AL/0001
2. FOR LEGEND AND ABBREVIATIONS REFER DRAWING NO. 301-2/AL/1000
3. FOR TYPICAL SECTION OF BALLAST PROFILE (FL-RL) REFER DRG. NO. 301-2/T/TFD/-004 (TR.1952)

0	14.09.2024	SUBMISSION OF AS-BUILT DRAWING	FOR APPROVAL
REV.	DATE	REVISION DETAILS	PURPOSE OF ISSUE

SCALE

HOR - 1:1000

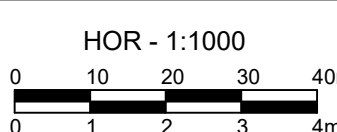


VER - 1:100

SHEET SIZE : A1

LEGEND:

IR TRACK	
DFCC TRACK	
DFCC FUTURE PROPOSALS	
STRUCTURE / BUILDING	
DFCC TOE LINE	
DFCC FORMATION	
RETAINING WALL	
ROAD	
STREAM, DRAIN, NALA, CANAL	
FENCE	
POWER LINES	
TBM	
ELECTRIC POLE/OHE MAST	
IR RAILWAY BOUNDARY	
DFCC BOUNDARY	

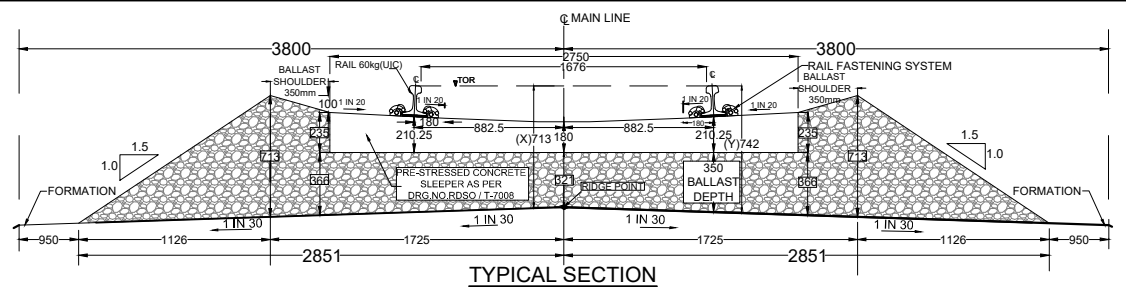

TRACK STRUCTURE		
RAIL SECTION: 60Kg/m (UIC 60Kg/m) DFC LINE: 60Kg/m (UIC 60Kg/m) IR MAIN LINE: 52Kg/m	Difference between FL- RL (Below Rail Seat)	
	IR Line	DFC
	172mm	172mm
RUBBER PAD	6mm	10mm
SLEEPER DEPTH	210mm	210mm
BALLAST CUSHION	300mm	350mm
Total Depth (FL TO RL)	688mm	742mm

OWNER

**DEDICATED FREIGHT CORRIDOR CORPORATION OF INDIA LTD.**
(A GOVERNMENT OF INDIA ENTERPRISE)
PROJECT OFFICE (AMBALA UNIT): OLD RAILWAY COLONY (NEAR
ANAND MARKET), AMBALA CANTT-133001.
CORPORATE IDENTITY NO. : U60232DL2006GO1155068

ENGINEER:

 DB Engineering &
Consulting GmbH
Deutsche Bahn Engineering & Consulting GmbH

CONTRACTOR: GIL - TPL JV



 

SUBMITTED BY	GIL - TPL JV		
	DATED	NAME	SIGNATURE
PREPARED BY			
CHECKED BY	14.09.2024	VIJAY PRATAP	
APPROVED BY	14.09.2024	PARASURAM KOTYADA	

APPROVED BY	DEUTSCHE BAHN ENGINEERING & CONSULTING GMBH		
	DATED	NAME	SIGNATURE
Sr. DE./CHIEF ENGINEER		SURESH K.YALANGI	
CHIEF TRACK ENGINEER		RAJ PAL SINGH	
T.L.		H.D. VIDJAK	

STAMP	A AS-BUILT DRAWING TR. Ref..... ENGINEER Sign.:		
	EMPLOYER (DFCCIL):	DEDICATED FREIGHT CORRIDOR CORPORATION OF INDIA LTD.	

AS BUILT DRAWING	
TITLE AS-BUILT PLAN AND PROFILE FROM IR KM: 311.500 TO 312.000 DFC KM: 1200.990 TO 1201.490	DFCC APPR. NO. - _____
	ENGG. APPR. NO. - _____
	DRG. NO. -301-2/AL/A/1249
	SHEET NO. : 1 OF 1 DATE : 14.09.2024
STATUS A	

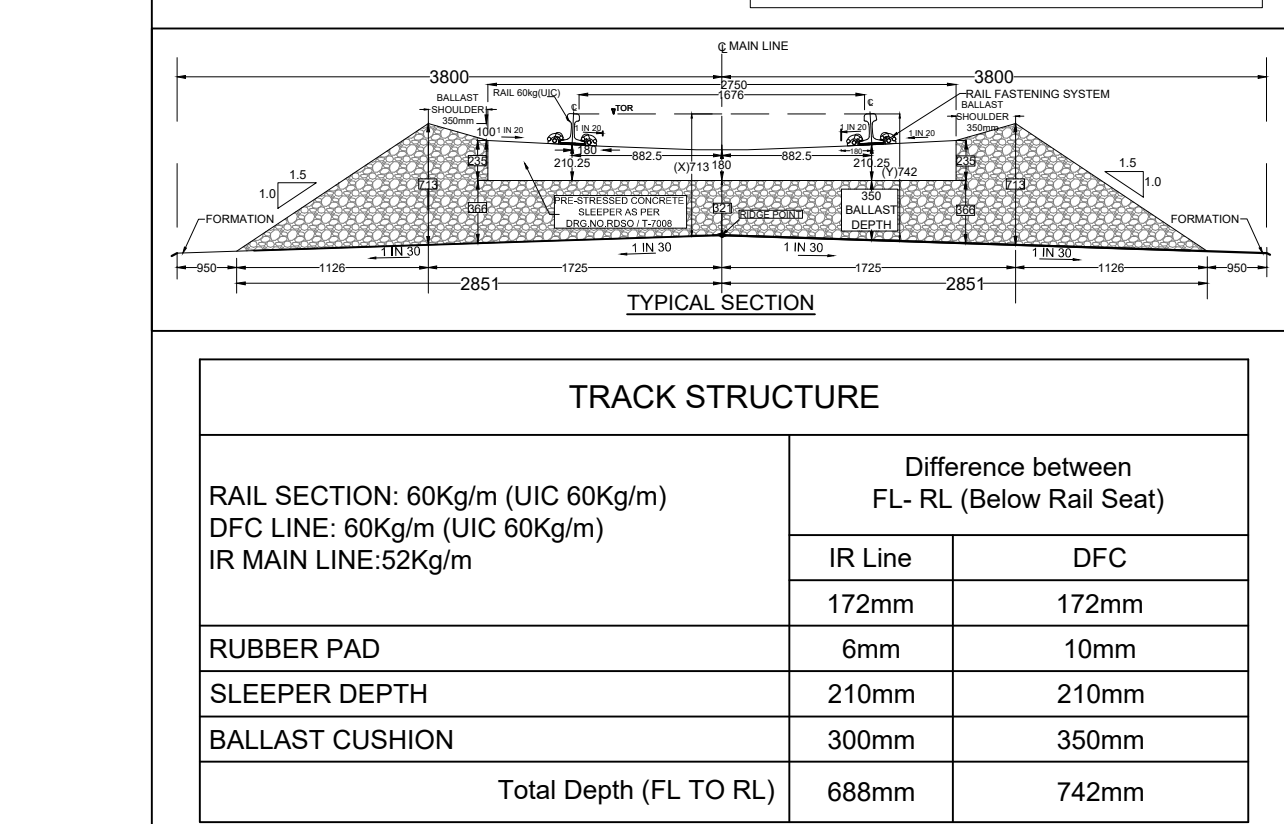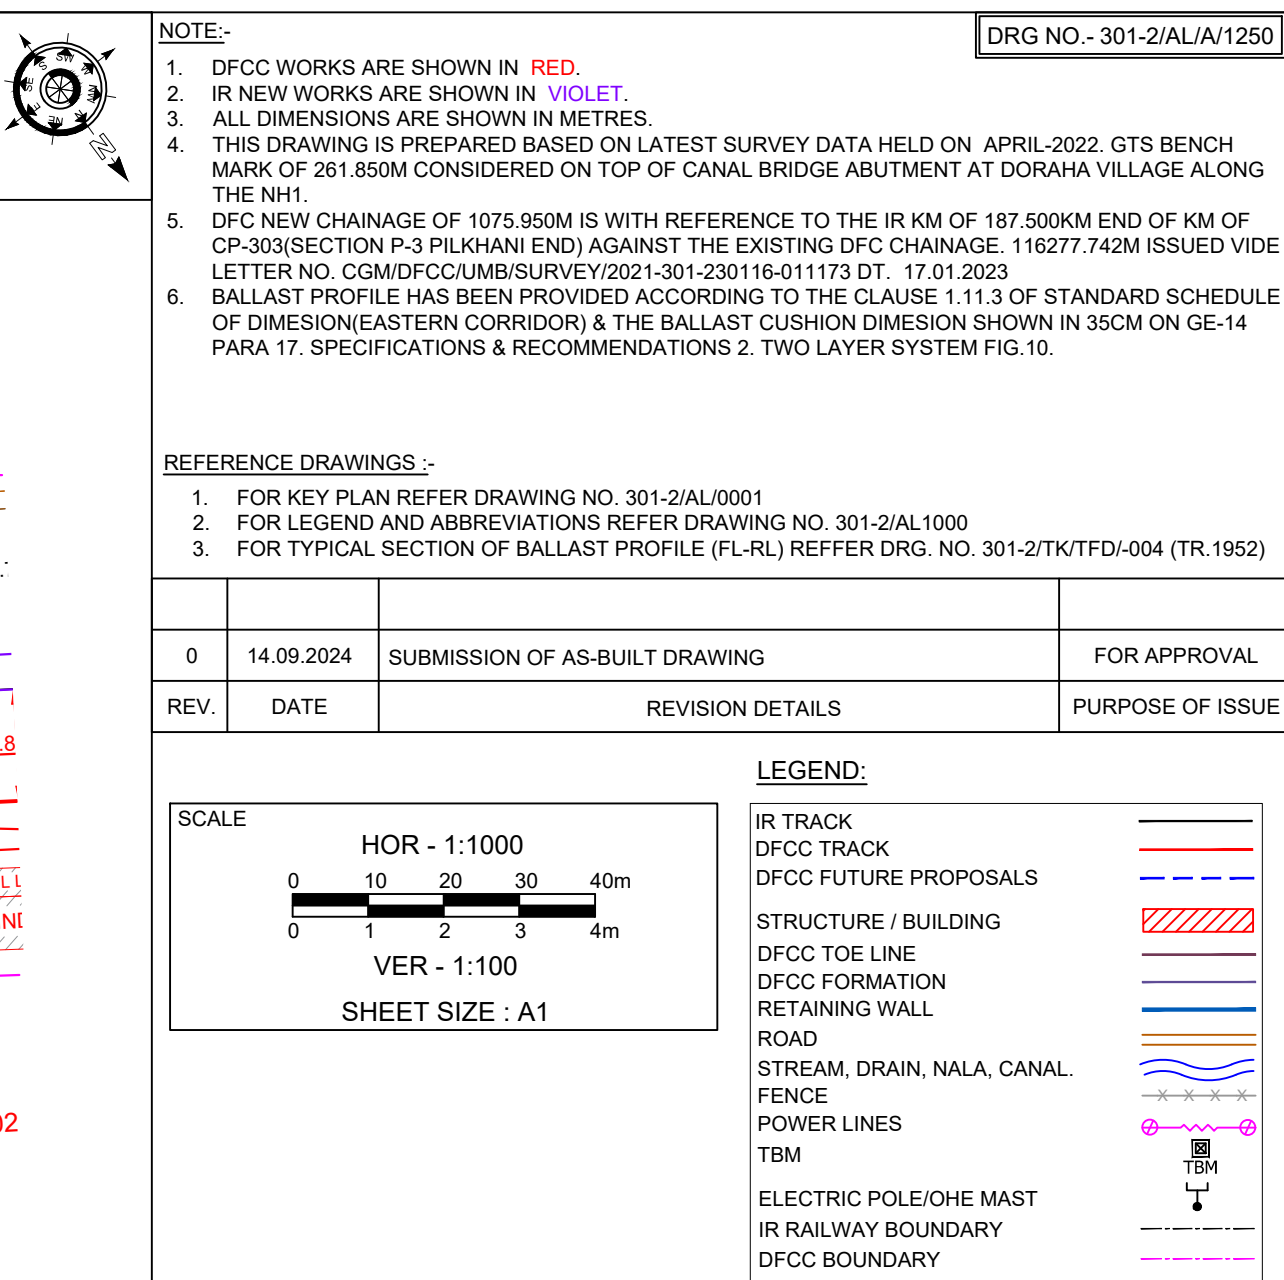

OWNER

 **महाराष्ट्र फ्रीट्रेड कॉर्पोरेशन**


DEDICATED FREIGHT CORRIDOR CORPORATION OF INDIA LTD.
(A GOVERNMENT OF INDIA ENTERPRISE)
PROJECT OFFICE/AMBALA UNIT: OLD RAILWAY COLONY (NEAR
ANAND MARKET) AMBALA CANTT-133001.
CORPORATE IDENTITY NO. : U60232DL2006GOI155068

ENGINEER:		DB Engineering & Consulting GmbH Deutsche Bahn Engineering & Consulting GmbH		
CONTRACTOR:		GIL - TPL JV 		
SUBMITTED BY	GIL - TPL JV			
	DATED	NAME	SIGNATURE	
PREPARED BY	14.09.2024	VIJAY PRATAP		
CHECKED BY	14.09.2024	PARASURAM KOTYADA		
APPROVED BY				
APPROVED BY	DEUTSCHE BAHN ENGINEERING & CONSULTING GMBH			
	DATED	NAME	SIGNATURE	
Sr. DE/CHIEF ENGINEER		SURESH K.YALANGI		
CHIEF TRACK ENGINEER		RAJ PAL SINGH		
T.L.		H.D. VIDJAK		

STAMP	A AS-BUILT DRAWING TR. Ref..... ENGINEER Sign.:		
	EMPLOYER (DFCCIL): DEDICATED FREIGHT CORRIDOR CORPORATION OF INDIA LTD.		
AS BUILT DRAWING			
TITLE AS-BUILT PLAN AND PROFILE FROM IR KM: 312.000 TO 312.500 DFC KM: 1201.490 TO 1201.990	DFCC APPR. NO. - ENGG. APPR. NO. - DRG. NO. -301-2/ALJA/1250 SHEET NO. : 1 OF 1 DATE : 14.09.2024		
	STATUS A		

TR.

PILKHANI

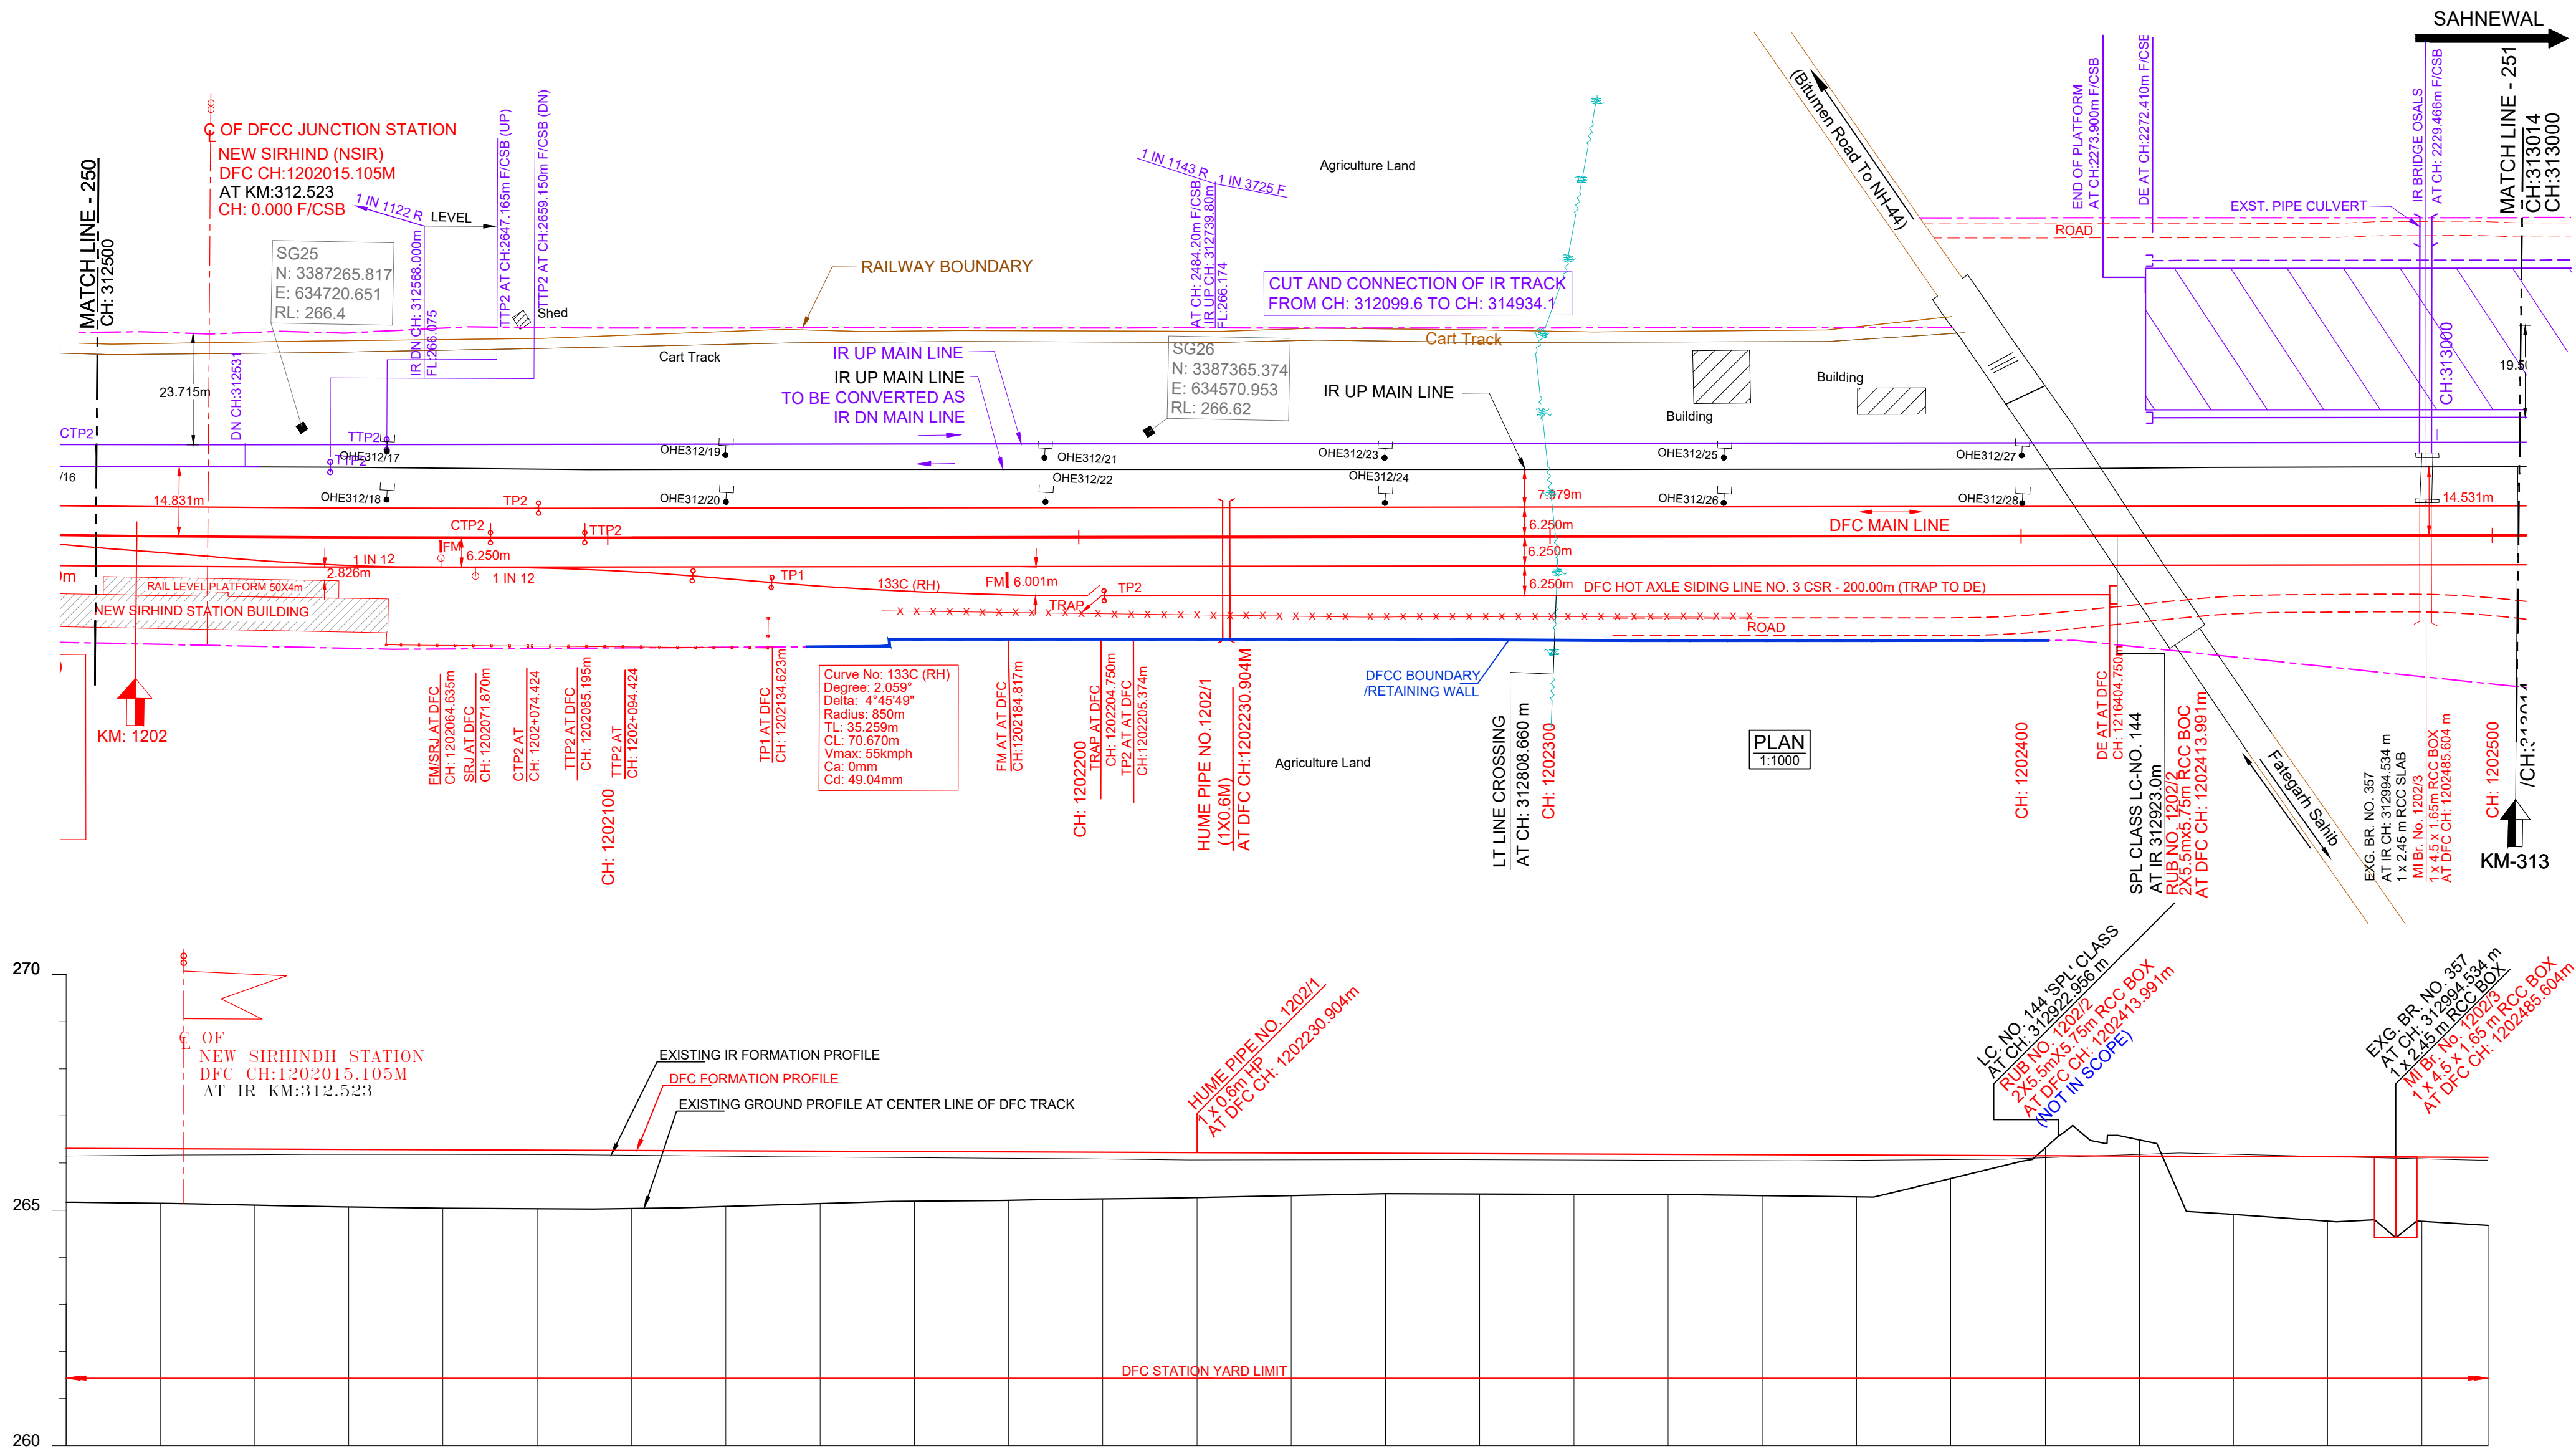

DATUM ABOVE MSL : 260 m

HORIZONTAL ALIGNMENT	R = 8000m		TL = 20m		L = 1181.717m	
VERTICAL ALIGNMENT					L = 2139.573 m 1 IN 2711.213 F	
TRACK DISTANCE FROM EXISTING NEAREST IR DN MAIN LINE TO DFC MAIN LINE	10.260	10.308	10.407	10.412	10.281	10.100
HEIGHT OF BANKING(+) / DEPTH OF CUTTING(-) (PFL-GL)	+1.143	+1.158	+1.190	+1.221	+1.240	+1.243
EXG GROUND LEVEL AT CENTER LINE OF DFC TRACK (GL)	-265.167	-265.145	-265.108	-265.087	-265.041	-265.030
EXG GROUND LEVEL AT TOE LOCATION OF DFC TRACK	-264.858	-264.781	-264.816	-264.803	-264.764	-264.771
DIFFERENCE BETWEEN DFC FORMATION LEVEL AND EXG.FORMATION LEVEL (PFL-EFL)	0.161	0.137	0.118	0.104	0.098	0.093
DFC FORMATION LEVEL (PFL)	-266.310	-266.303	-266.296	-266.288	-266.281	-266.273
EXG. FORMATION LEVEL OF EXG IR DN MAIN LINE (EFL)	-266.149	-266.166	-266.178	-266.184	-266.183	-266.180
DIFFERENCE BETWEEN DFC RAIL LEVEL AND EXG. RAIL LEVEL (PRL - ERL)	0.203	0.178	0.158	0.145	0.139	0.134
DFC RAIL LEVEL (PRL)	-267.023	-267.016	-267.008	-267.001	-266.994	-266.986
EXG.RAIL LEVEL OF NEAREST IR DN MAIN LINE(ERL)	-266.821	-266.838	-266.850	-266.856	-266.855	-266.852
EQUIVALENT CHAINAGE ON DFC TRACK	201990.6	202010.4	202030.5	202050.5	202070.5	202090.6
EXISTING IR CHAINAGE	312500.0	312520.0	312540.0	312560.0	312580.0	312600.0

L - SECTION



- NOTE:-
- DFCC WORKS ARE SHOWN IN RED.
 - IR NEW WORKS ARE SHOWN IN VIOLET.
 - ALL DIMENSIONS ARE SHOWN IN METRES.
 - THIS DRAWING IS PREPARED BASED ON LATEST SURVEY DATA HELD ON APRIL-2022. GTS BENCH MARK OF 261.850M CONSIDERED ON TOP OF CANAL BRIDGE ABUTMENT AT DORAH VILLAGE ALONG THE NH1.
 - DFC NEW CHAINAGE OF 1075.950M IS WITH REFERENCE TO THE IR KM OF 187.500KM END OF KM OF CP-303(SECTION P-3 PILKHANI END) AGAINST THE EXISTING DFC CHAINAGE. 116277.742M ISSUED VIDE LETTER NO. COM/DFCC/MB/SURVEY/2021-301-230116-01173 DT. 17.01.2023
 - BALLAST PROFILE HAS BEEN PROVIDED ACCORDING TO THE CLAUSE 1.11.3 OF STANDARD SCHEDULE OF DIMENSION(EASTERN CORRIDOR) & THE BALLAST CUSHION DIMENSION SHOWN IN 35CM ON GE-14 PARA 17. SPECIFICATIONS & RECOMMENDATIONS 2. TWO LAYER SYSTEM FIG.10.

REFERENCE DRAWINGS :-


- FOR KEY PLAN REFER DRAWING NO. 301-2/AL/0001
- FOR LEGEND AND ABBREVIATIONS REFER DRAWING NO. 301-2/AL/1000
- FOR TYPICAL SECTION OF BALLAST PROFILE (FL-RL) REFER DRG. NO. 301-2/TK/TFD/-004 (TR.1952)

0	14.09.2024	SUBMISSION OF AS-BUILT DRAWING	FOR APPROVAL
REV.	DATE	REVISION DETAILS	PURPOSE OF ISSUE

LEGEND:

IR TRACK
DFCC TRACK
DFCC FUTURE PROPOSALS
STRUCTURE / BUILDING
DFCC TOE LINE
DFCC FORMATION
RETAINING WALL
ROAD
STREAM, DRAIN, NALA, CANAL.
FENCE
POWER LINES
TBM
ELECTRIC POLE/OHE MAST
IR RAILWAY BOUNDARY
DFCC BOUNDARY

SCALE
HOR - 1:1000
VER - 1:100
SHEET SIZE : A1

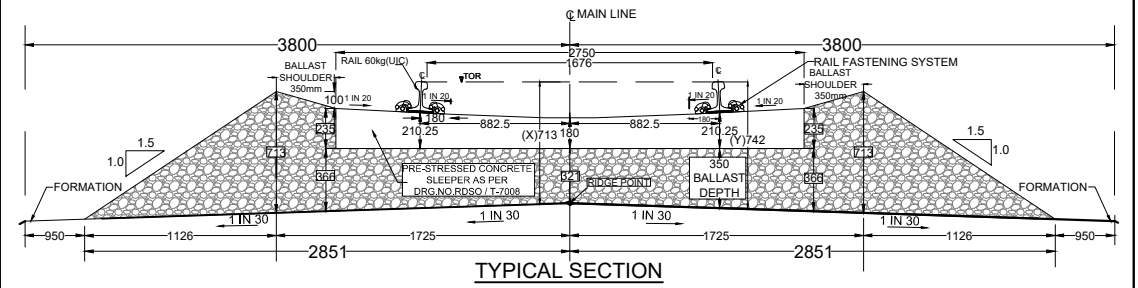

TRACK STRUCTURE		
RAIL SECTION: 60Kg/m (UIC 60Kg/m) DFC LINE: 60Kg/m (UIC 60Kg/m) IR MAIN LINE: 52Kg/m	Difference between FL- RL (Below Rail Seat)	
	IR Line	DFC
RUBBER PAD	172mm	172mm
SLEEPER DEPTH	6mm	10mm
BALLAST CUSHION	210mm	210mm
Total Depth (FL TO RL)	300mm	350mm
	688mm	742mm

OWNER
DEDICATED FREIGHT CORRIDOR CORPORATION OF INDIA LTD.
(A GOVERNMENT OF INDIA ENTERPRISE)
PROJECT OFFICE(AMBALA UNIT): OLD RAILWAY COLONY (NEAR ANAND MARKET),AMBALA CANTT-133001.
CORPORATE IDENTITY NO. : U60232DL2006GGI155068

ENGINEER:
DB Engineering & Consulting GmbH
Deutsche Bahn Engineering & Consulting GmbH

CONTRACTOR:
GIL - TPL JV
GAR TATA

SUBMITTED BY	GIL - TPL JV		
	DATED	NAME	SIGNATURE
PREPARED BY			
CHECKED BY	14.09.2024	VIJAY PRATAP	
APPROVED BY	14.09.2024	PARASURAM KOTYADA	



APPROVED BY	DEUTSCHE BAHN ENGINEERING & CONSULTING GMBH		
	DATED	NAME	SIGNATURE
Sr. DE./CHIEF ENGINEER		SURESH K.YALANGI	
CHIEF TRACK ENGINEER		RAJ PAL SINGH	
T.L.		H.D. VIDJAK	

STAMP	A AS-BUILT DRAWING TR. Ref.:..... ENGINEER Sign.:.....		
EMPLOYER (DFCCIL):	DEDICATED FREIGHT CORRIDOR CORPORATION OF INDIA LTD.		

AS BUILT DRAWING			
TITLE AS-BUILT PLAN AND PROFILE		DFCC APPR. NO. - ENGG. APPR. NO. -	
FROM IR KM: 312.500 TO 313.000 DFC KM: 1201.990 TO 1202.505		DRG. NO. -301-2/AL/A/1251 SHEET NO. : 1 OF 1 DATE : 14.09.2024	
		STATUS A	

TR.


PILKHANI

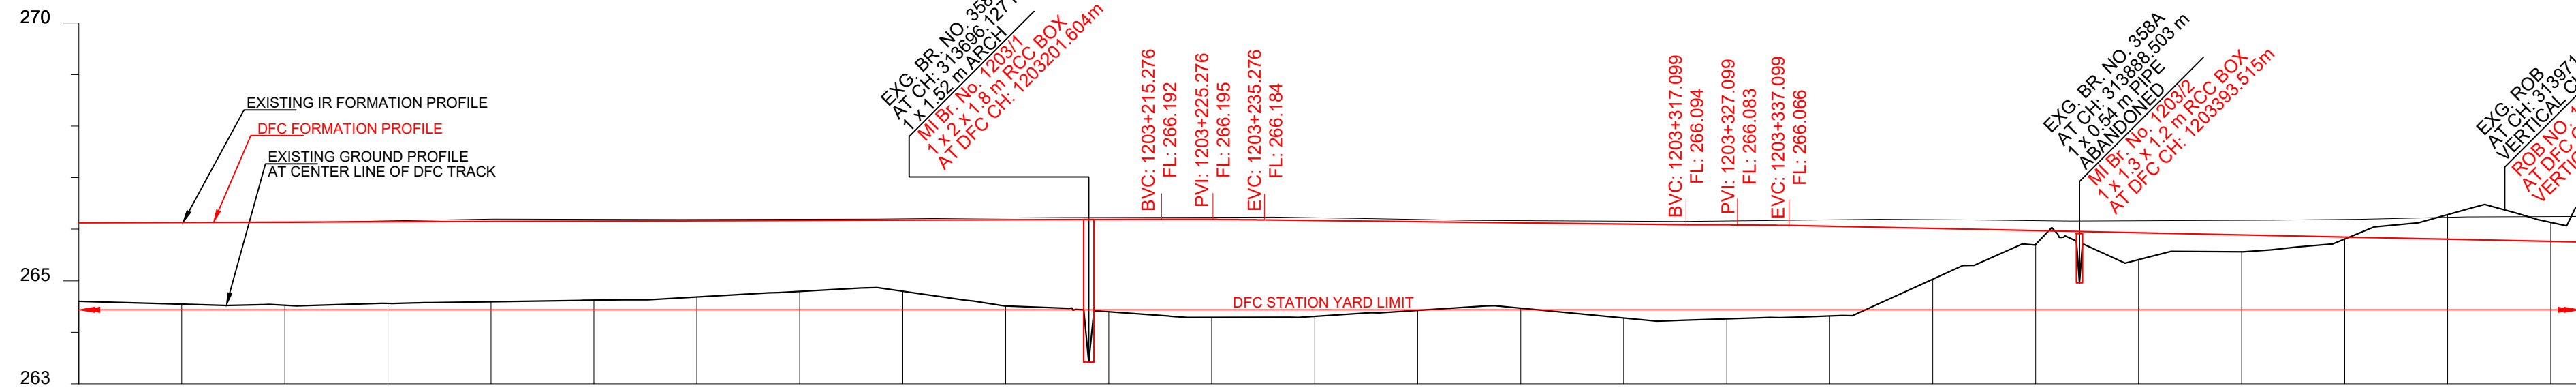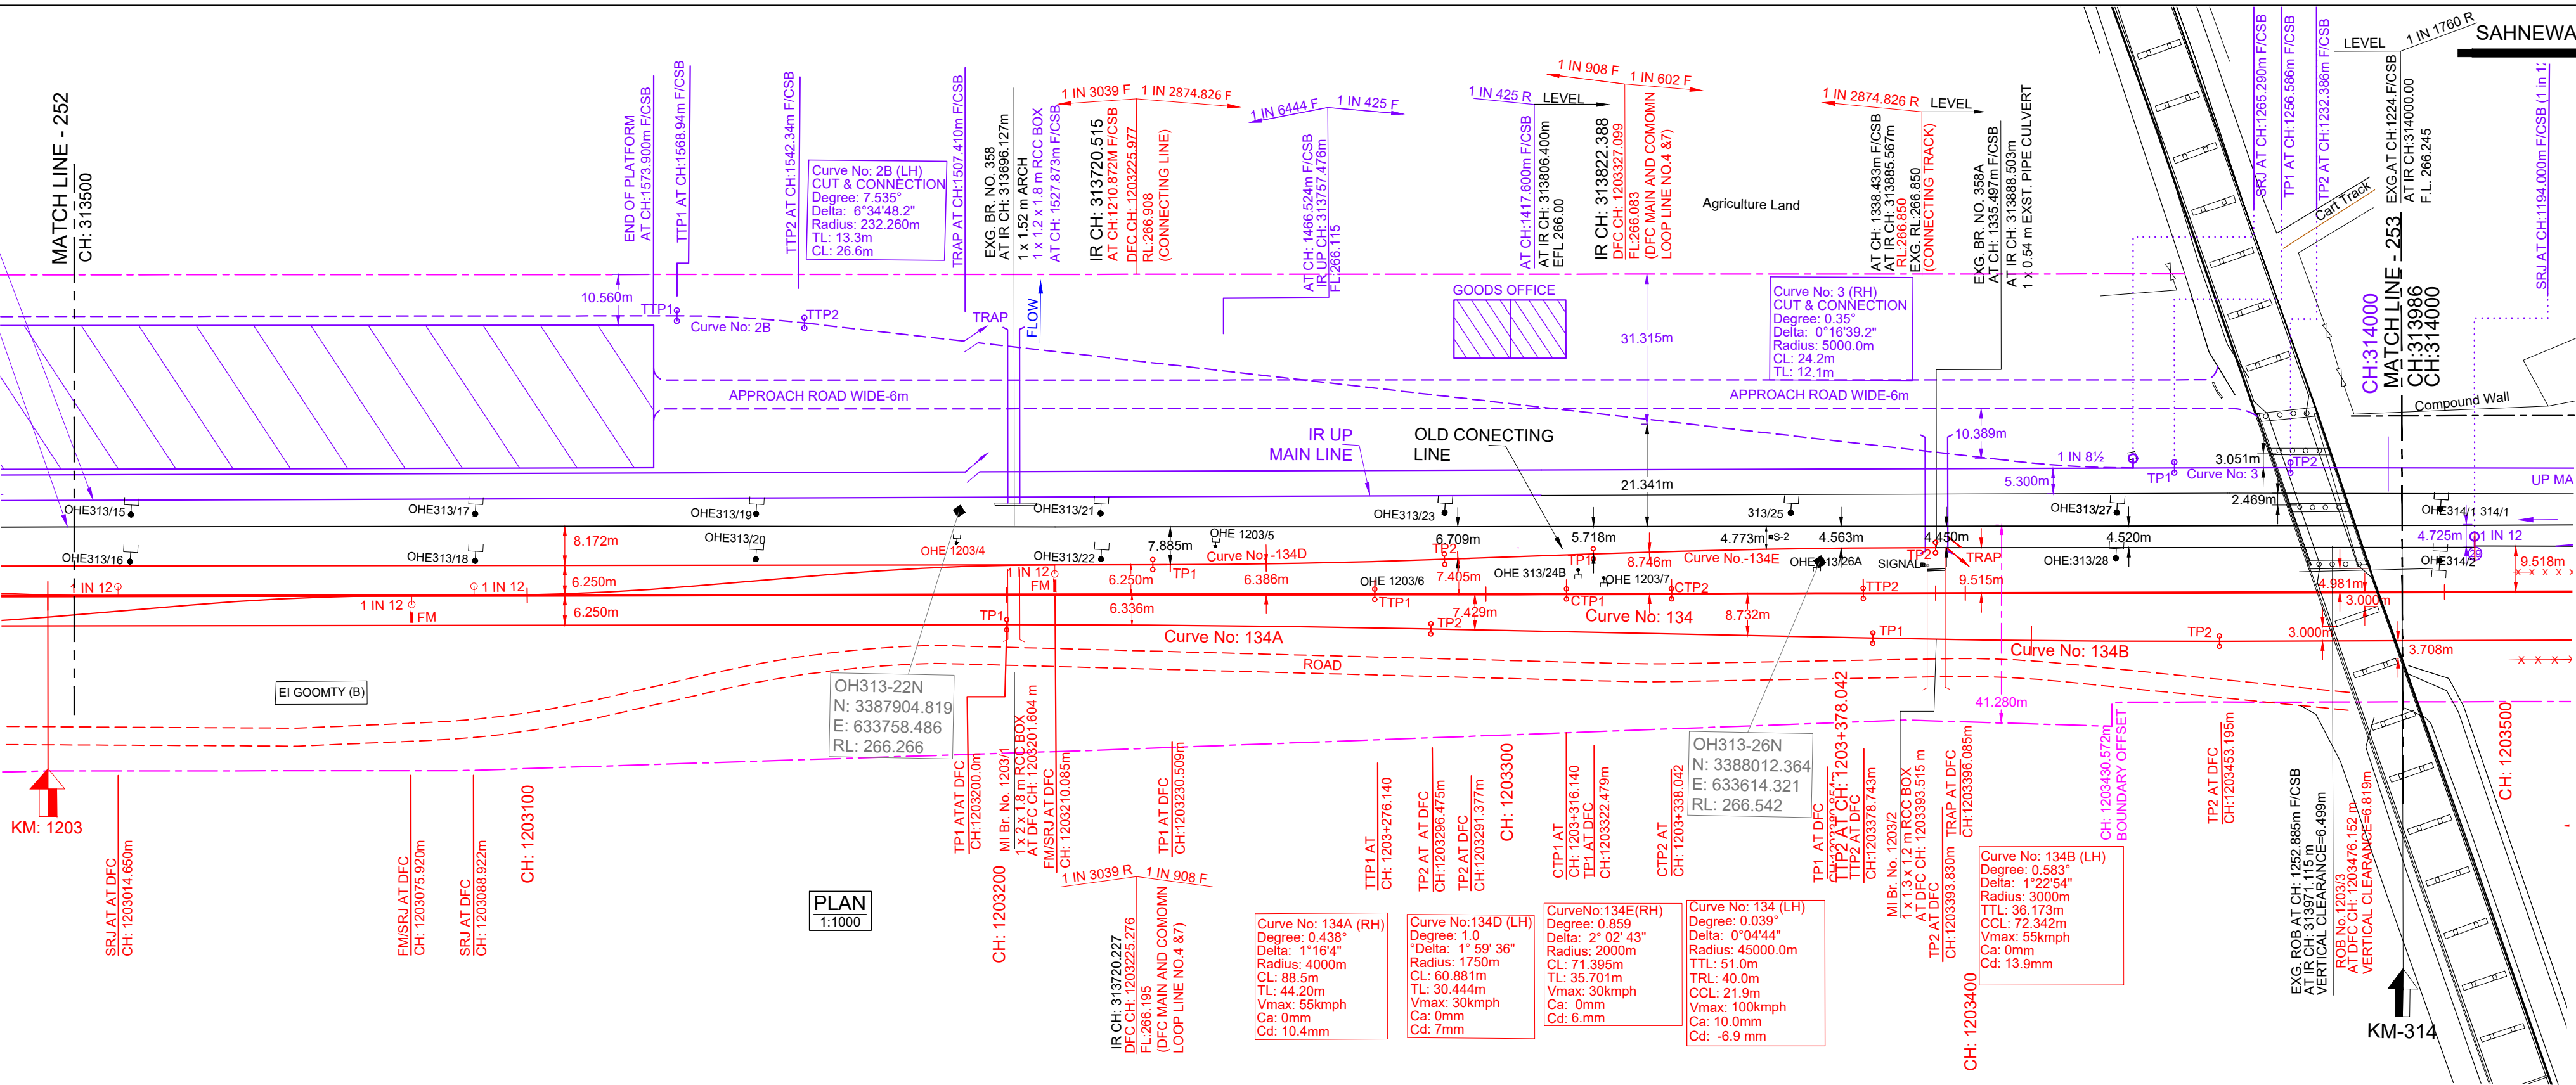

DATUM ABOVE MSL : 263 m

HORIZONTAL ALIGNMENT	L=1181.717m TL=40m R=45000m TL=40m L=432.594m																			
VERTICAL ALIGNMENT	L=467.213 m 1 IN 3038.795 R L=81.823 m 1 IN 908.177 F L=20.0 m R=13984 m L=20.0 m R=35690 m L=182.550 m 1 IN 801.872 F																			
TRACK DISTANCE FROM EXISTING NEAREST IR DN MAIN LINE TO DFC MAIN LINE	9.906	9.876	9.847	9.883	9.942	9.958	9.967	9.952	9.936	9.923	9.913	9.907	9.902	9.901	9.893	9.876	9.854	9.825	9.789	9.750
HEIGHT OF BANKING(+) / DEPTH OF CUTTING(-) (PFL-GL)	+1.522	+1.583	+1.613	+1.582	+1.557	+1.533	+1.478	+1.376	+1.379	+1.671	+1.790	+1.902	+1.855	+1.704	+1.630	+1.788	+1.770	+1.679	+0.935	9.750
EXG GROUND LEVEL AT CENTER LINE OF DFC TRACK (GL)	-264.001	-264.546	-264.523	-264.560	-264.592	-264.623	-264.684	-264.793	-264.796	-264.511	-264.325	-264.288	-264.307	-264.425	-264.466	-264.274	-264.259	-264.316	-265.027	-265.409
EXG GROUND LEVEL AT TOE LOCATION OF DFC TRACK	-264.610	-264.572	-264.599	-264.563	-264.572	-264.600	-264.593	-264.613	-264.596	-264.493	-264.325	-264.181	-263.964	-264.023	-264.018	-264.094	-264.172	-264.259	-265.067	-265.409
DIFFERENCE BETWEEN DFC FORMATION LEVEL AND EXG.FORMATION LEVEL (PFL-EFL)	-0.002	0.003	0.010	-0.018	-0.046	-0.035	-0.025	-0.023	-0.025	-0.035	-0.040	-0.042	-0.059	-0.059	-0.070	-0.093	-0.129	-0.185	-0.221	-0.289
DFC FORMATION LEVEL (PFL)	-266.123	-266.126	-266.136	-266.142	-266.149	-266.156	-266.162	-266.169	-266.175	-266.182	-266.188	-266.190	-266.162	-266.129	-266.096	-266.062	-266.029	-265.995	-265.962	-265.929
EXG. FORMATION LEVEL OF EXG IR DN MAIN LINE (EFL)	-266.125	-266.126	-266.126	-266.180	-266.195	-266.191	-266.187	-266.192	-266.200	-266.217	-266.228	-266.232	-266.221	-266.188	-266.166	-266.155	-266.158	-266.164	-266.183	-266.164
DIFFERENCE BETWEEN DFC RAIL LEVEL AND EXG. RAIL LEVEL (PRL - ERL)	-0.039	0.045	0.051	0.024	-0.005	0.006	0.017	0.018	0.016	0.006	0.002	0.005	-0.007	0.004	0.004	-0.006	-0.032	-0.086	-0.122	-0.169
DFC RAIL LEVEL (PRL)	-266.836	-266.842	-266.849	-266.856	-266.862	-266.869	-266.875	-266.882	-266.888	-266.895	-266.902	-266.908	-266.896	-266.864	-266.842	-266.820	-266.798	-266.766	-266.733	-266.697
EXG.RAIL LEVEL OF NEAREST IR DN MAIN LINE(ERL)	-266.797	-266.798	-266.798	-266.832	-266.867	-266.863	-266.859	-266.864	-266.872	-266.889	-266.900	-266.904	-266.893	-266.860	-266.838	-266.827	-266.830	-266.836	-266.855	-266.836
EQUIVALENT CHAINAGE ON DFC TRACK	313500.0	313520.0	313540.0	313560.0	313580.0	313600.0	313620.0	313640.0	313660.0	313680.0	313700.0	313720.0	313740.0	313760.0	313780.0	313800.0	313820.0	313840.0	313860.0	313880.0
EXISTING IR CHAINAGE	313500.0	313520.0	313540.0	313560.0	313580.0	313600.0	313620.0	313640.0	313660.0	313680.0	313700.0	313720.0	313740.0	313760.0	313780.0	313800.0	313820.0	313840.0	313860.0	313880.0

L - SECTION

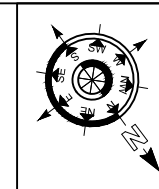

- NOTE:-
1. DFC WORKS ARE SHOWN IN RED.
 2. IR NEW WORKS ARE SHOWN IN VIOLET.
 3. ALL DIMENSIONS ARE SHOWN IN METRES.
 4. THIS DRAWING IS PREPARED BASED ON LATEST SURVEY DATA HELD ON APRIL-2022. GTS BENCH MARK OF 261.850M CONSIDERED ON TOP OF CANAL BRIDGE ABUTMENT AT DORAHA VILLAGE ALONG THE NH1.
 5. DFC NEW CHAINAGE OF 1075.950M IS WITH REFERENCE TO THE IR KM OF 187.500KM END OF KM OF CP-303(SECTION P-3 PILKHANI END) AGAINST THE EXISTING DFC CHAINAGE. 116277.742M ISSUED VIDE LETTER NO. COM/DFCC/CLUB/SURVEY/2021-301-2301/16-01/173 DT. 17.01.2023.
 6. BALLAST PROFILE HAS BEEN PROVIDED ACCORDING TO THE CLAUSE 1.11.3 OF STANDARD SCHEDULE OF DIMENSION(EASTERN CORRIDOR) & THE BALLAST CUSHION DIMENSION SHOWN IN 35CM ON GE-14 PARA 17. SPECIFICATIONS & RECOMMENDATIONS 2. TWO LAYER SYSTEM FIG.10.

- REFERENCE DRAWINGS :-
1. FOR KEY PLAN REFER DRAWING NO. 301-2/AL/0001
 2. FOR LEGEND AND ABBREVIATIONS REFER DRAWING NO. 301-2/AL/1000
 3. FOR TYPICAL SECTION OF BALLAST PROFILE (FL-RL) REFER DRG. NO. 301-2/TK/TFD/004 (TR.1952)

REV.	DATE	REVISION DETAILS	PURPOSE OF ISSUE
0	14.09.2024	SUBMISSION OF AS-BUILT DRAWING	FOR APPROVAL

LEGEND:


SCALE

HOR - 1:1000

VER - 1:100

SHEET SIZE : A1

IR TRACK
DFCC TRACK
DFCC FUTURE PROPOSALS
STRUCTURE / BUILDING
DFCC TOE LINE
DFCC FORMATION
RETAINING WALL
ROAD
STREAM, DRAIN, NALA, CANAL.
FENCE
POWER LINES
TBM
ELECTRIC POLE/OHE MAST
IR RAILWAY BOUNDARY
DFCC BOUNDARY

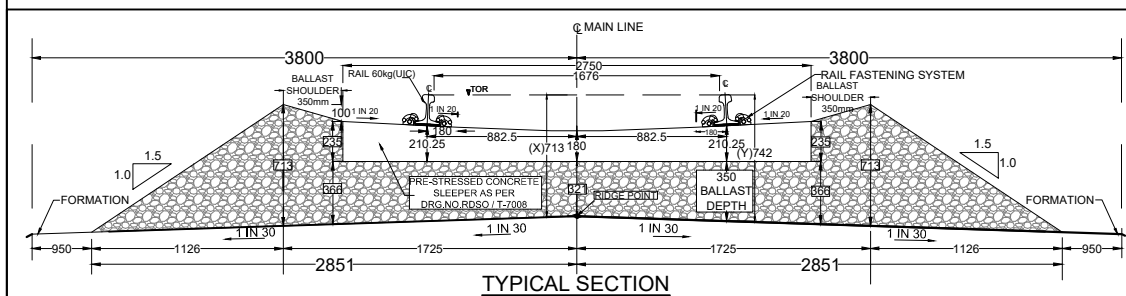

TRACK STRUCTURE		
RAIL SECTION: 60Kg/m (UIC 60Kg/m) DFC LINE: 60Kg/m (UIC 60Kg/m) IR MAIN LINE: 52Kg/m	Difference between FL- RL (Below Rail Seat)	
	IR Line	DFC
RUBBER PAD	172mm	172mm
SLEEPER DEPTH	6mm	10mm
BALLAST CUSHION	210mm	210mm
	300mm	350mm
Total Depth (FL TO RL)	688mm	742mm

OWNER

DEDICATED FREIGHT CORRIDOR CORPORATION OF INDIA LTD.

(A GOVERNMENT OF INDIA ENTERPRISE)

PROJECT OFFICE:AMBALA UNIT: OLD RAILWAY COLONY (NEAR ANAND MARKET),AMBALA CANTT-133001.

CORPORATE IDENTITY NO. : U60232DL2006G01155068

ENGINEER:

DB Engineering & Consulting GmbH

Deutsche Bahn Engineering & Consulting GmbH

CONTRACTOR:

GIL - TPL JV

GAR TATA


SUBMITTED BY	GIL - TPL JV		
	DATED	NAME	SIGNATURE
PREPARED BY			
CHECKED BY	14.09.2024	VIJAY PRATAP	
APPROVED BY	14.09.2024	PARASURAM KOTYADA	


APPROVED BY	DEUTSCHE BAHN ENGINEERING & CONSULTING GMBH		
	DATED	NAME	SIGNATURE
Sr. DE./CHIEF ENGINEER		SURESH K.YALANGI	
CHIEF TRACK ENGINEER		RAJ PAL SINGH	
T.L.		H.D. VIDJAK	

STAMP	A AS-BUILT DRAWING TR. Ref.:..... ENGINEER Sign.:.		
EMPLOYER (DFCCIL):	DEDICATED FREIGHT CORRIDOR CORPORATION OF INDIA LTD.		

AS BUILT DRAWING			
TITLE	AS-BUILT PLAN AND PROFILE	DFCC APPR. NO. -	
		ENGG. APPR. NO. -	
		DRG. NO. - 301-2/AL/A/1253	
		SHEET NO. : 1 OF 1	
		DATE : 14.09.2024	
			STATUS
			A

TR.

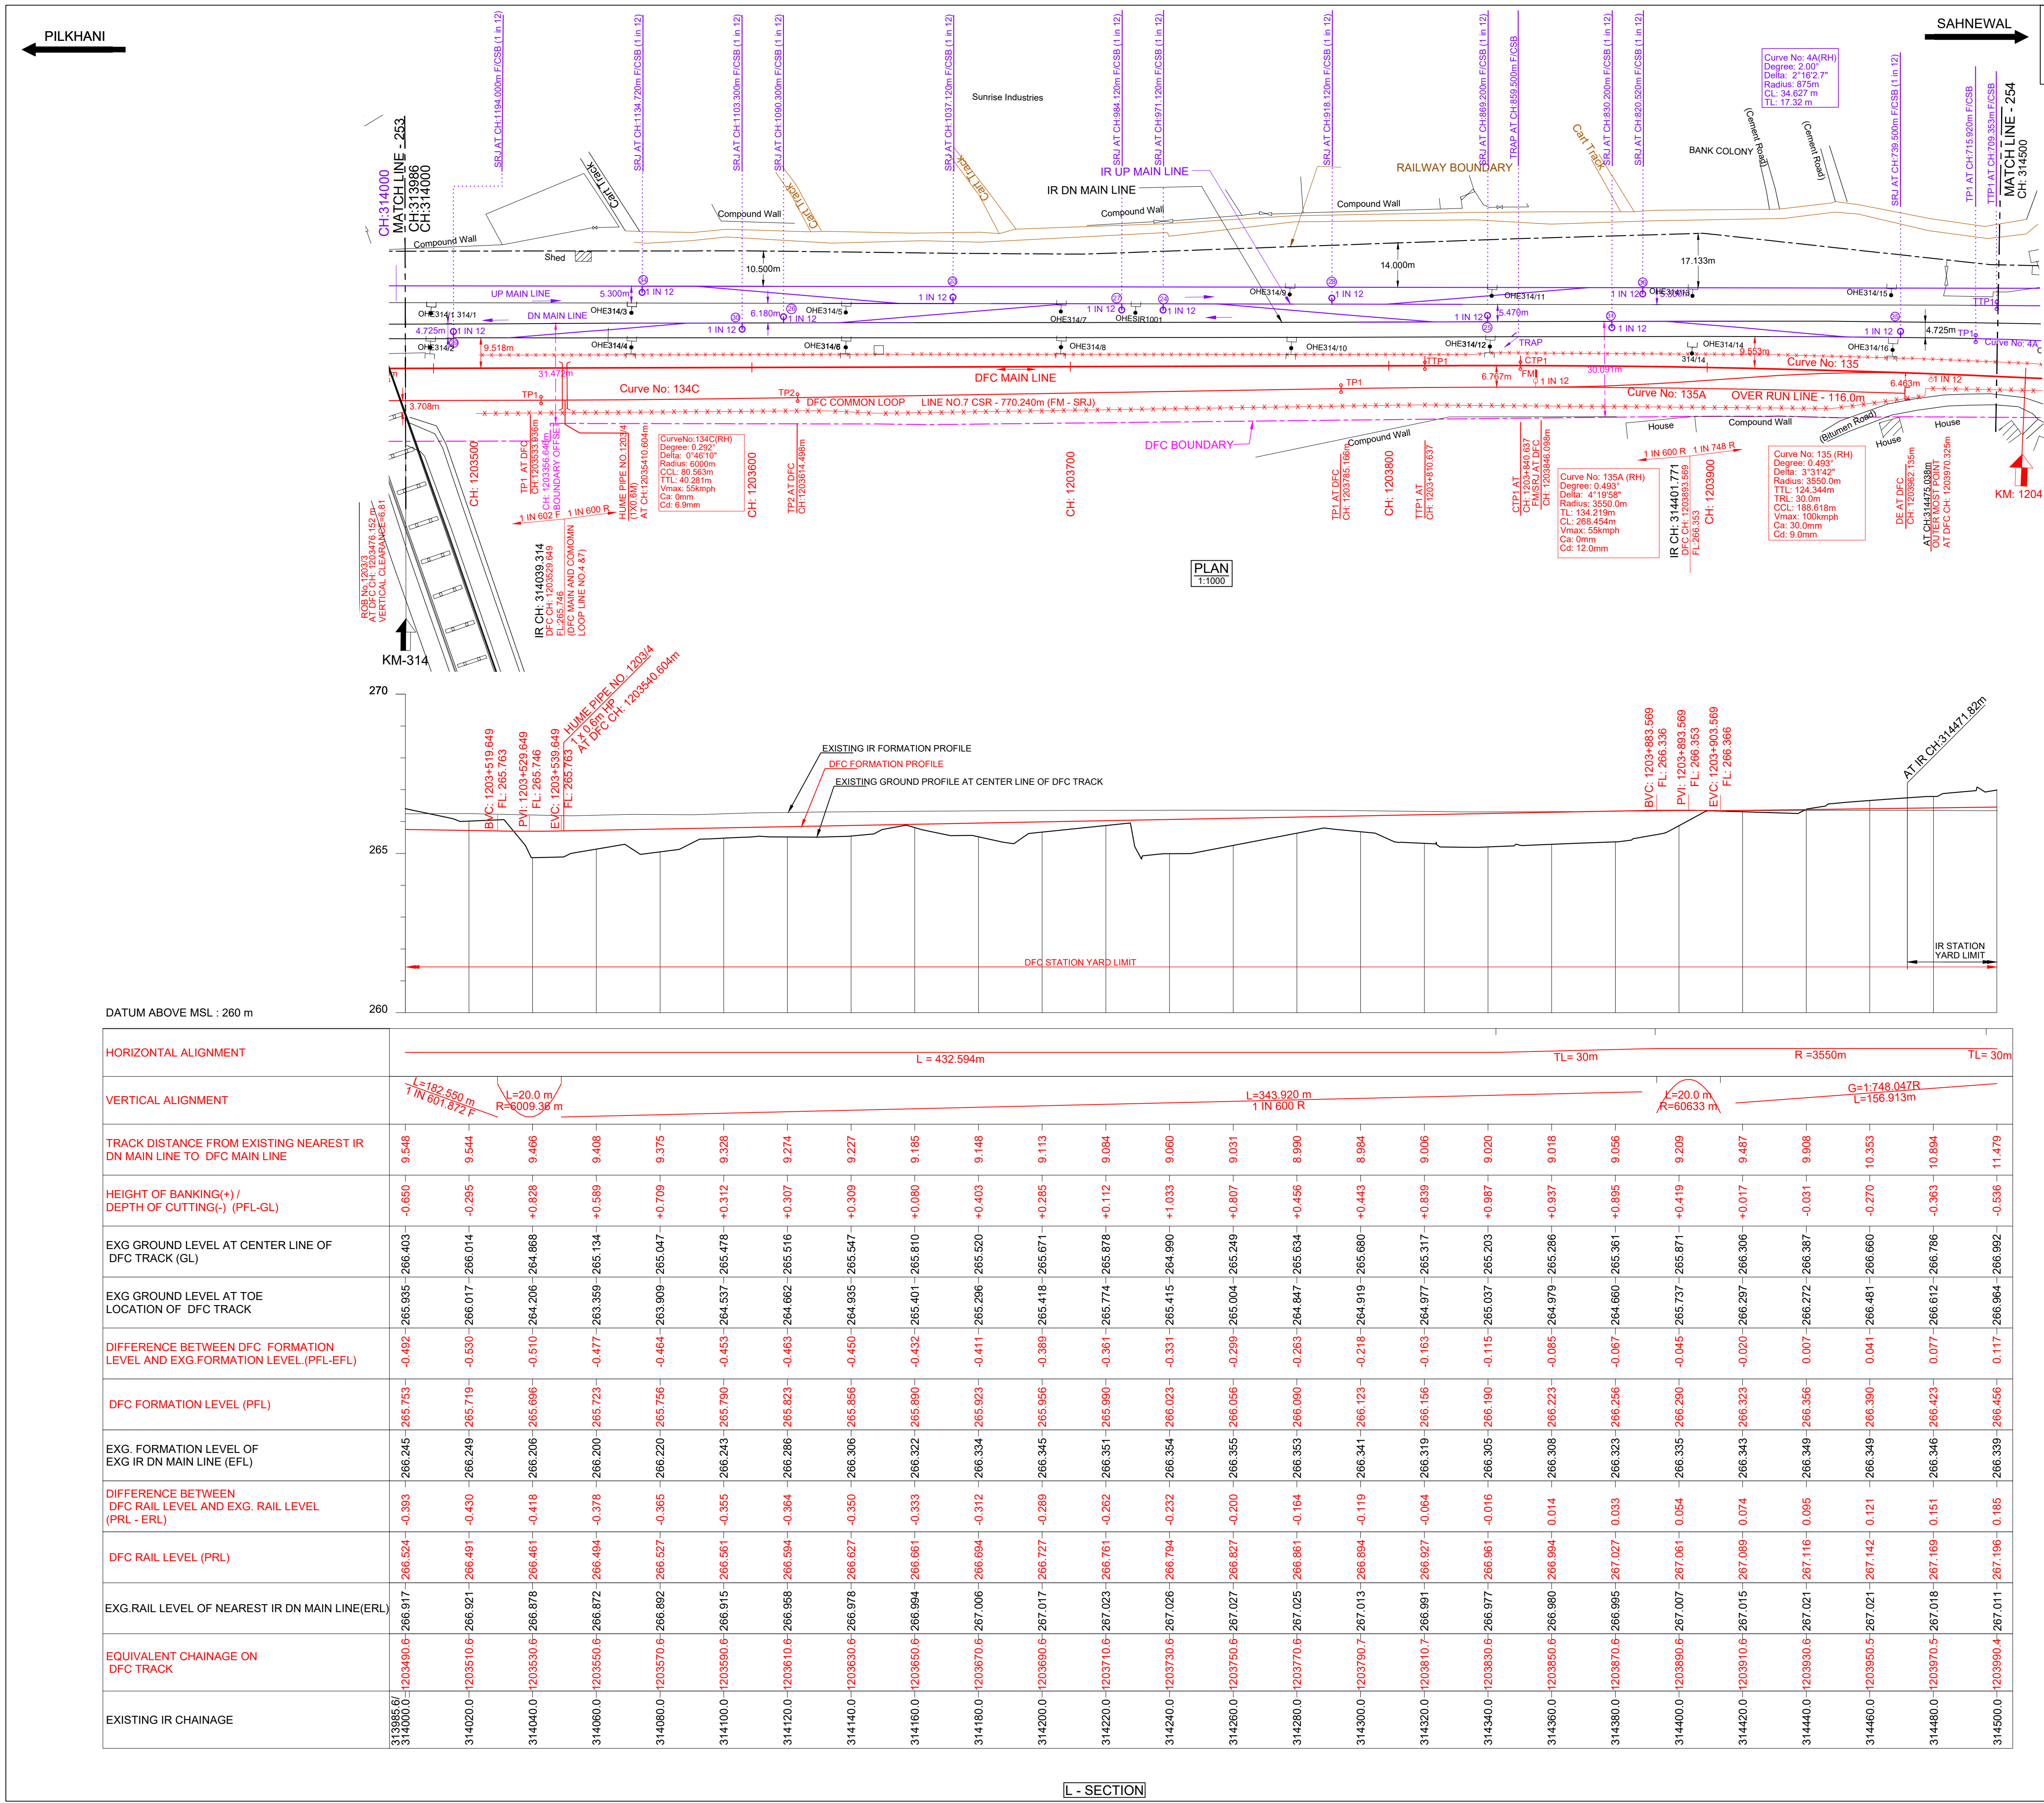

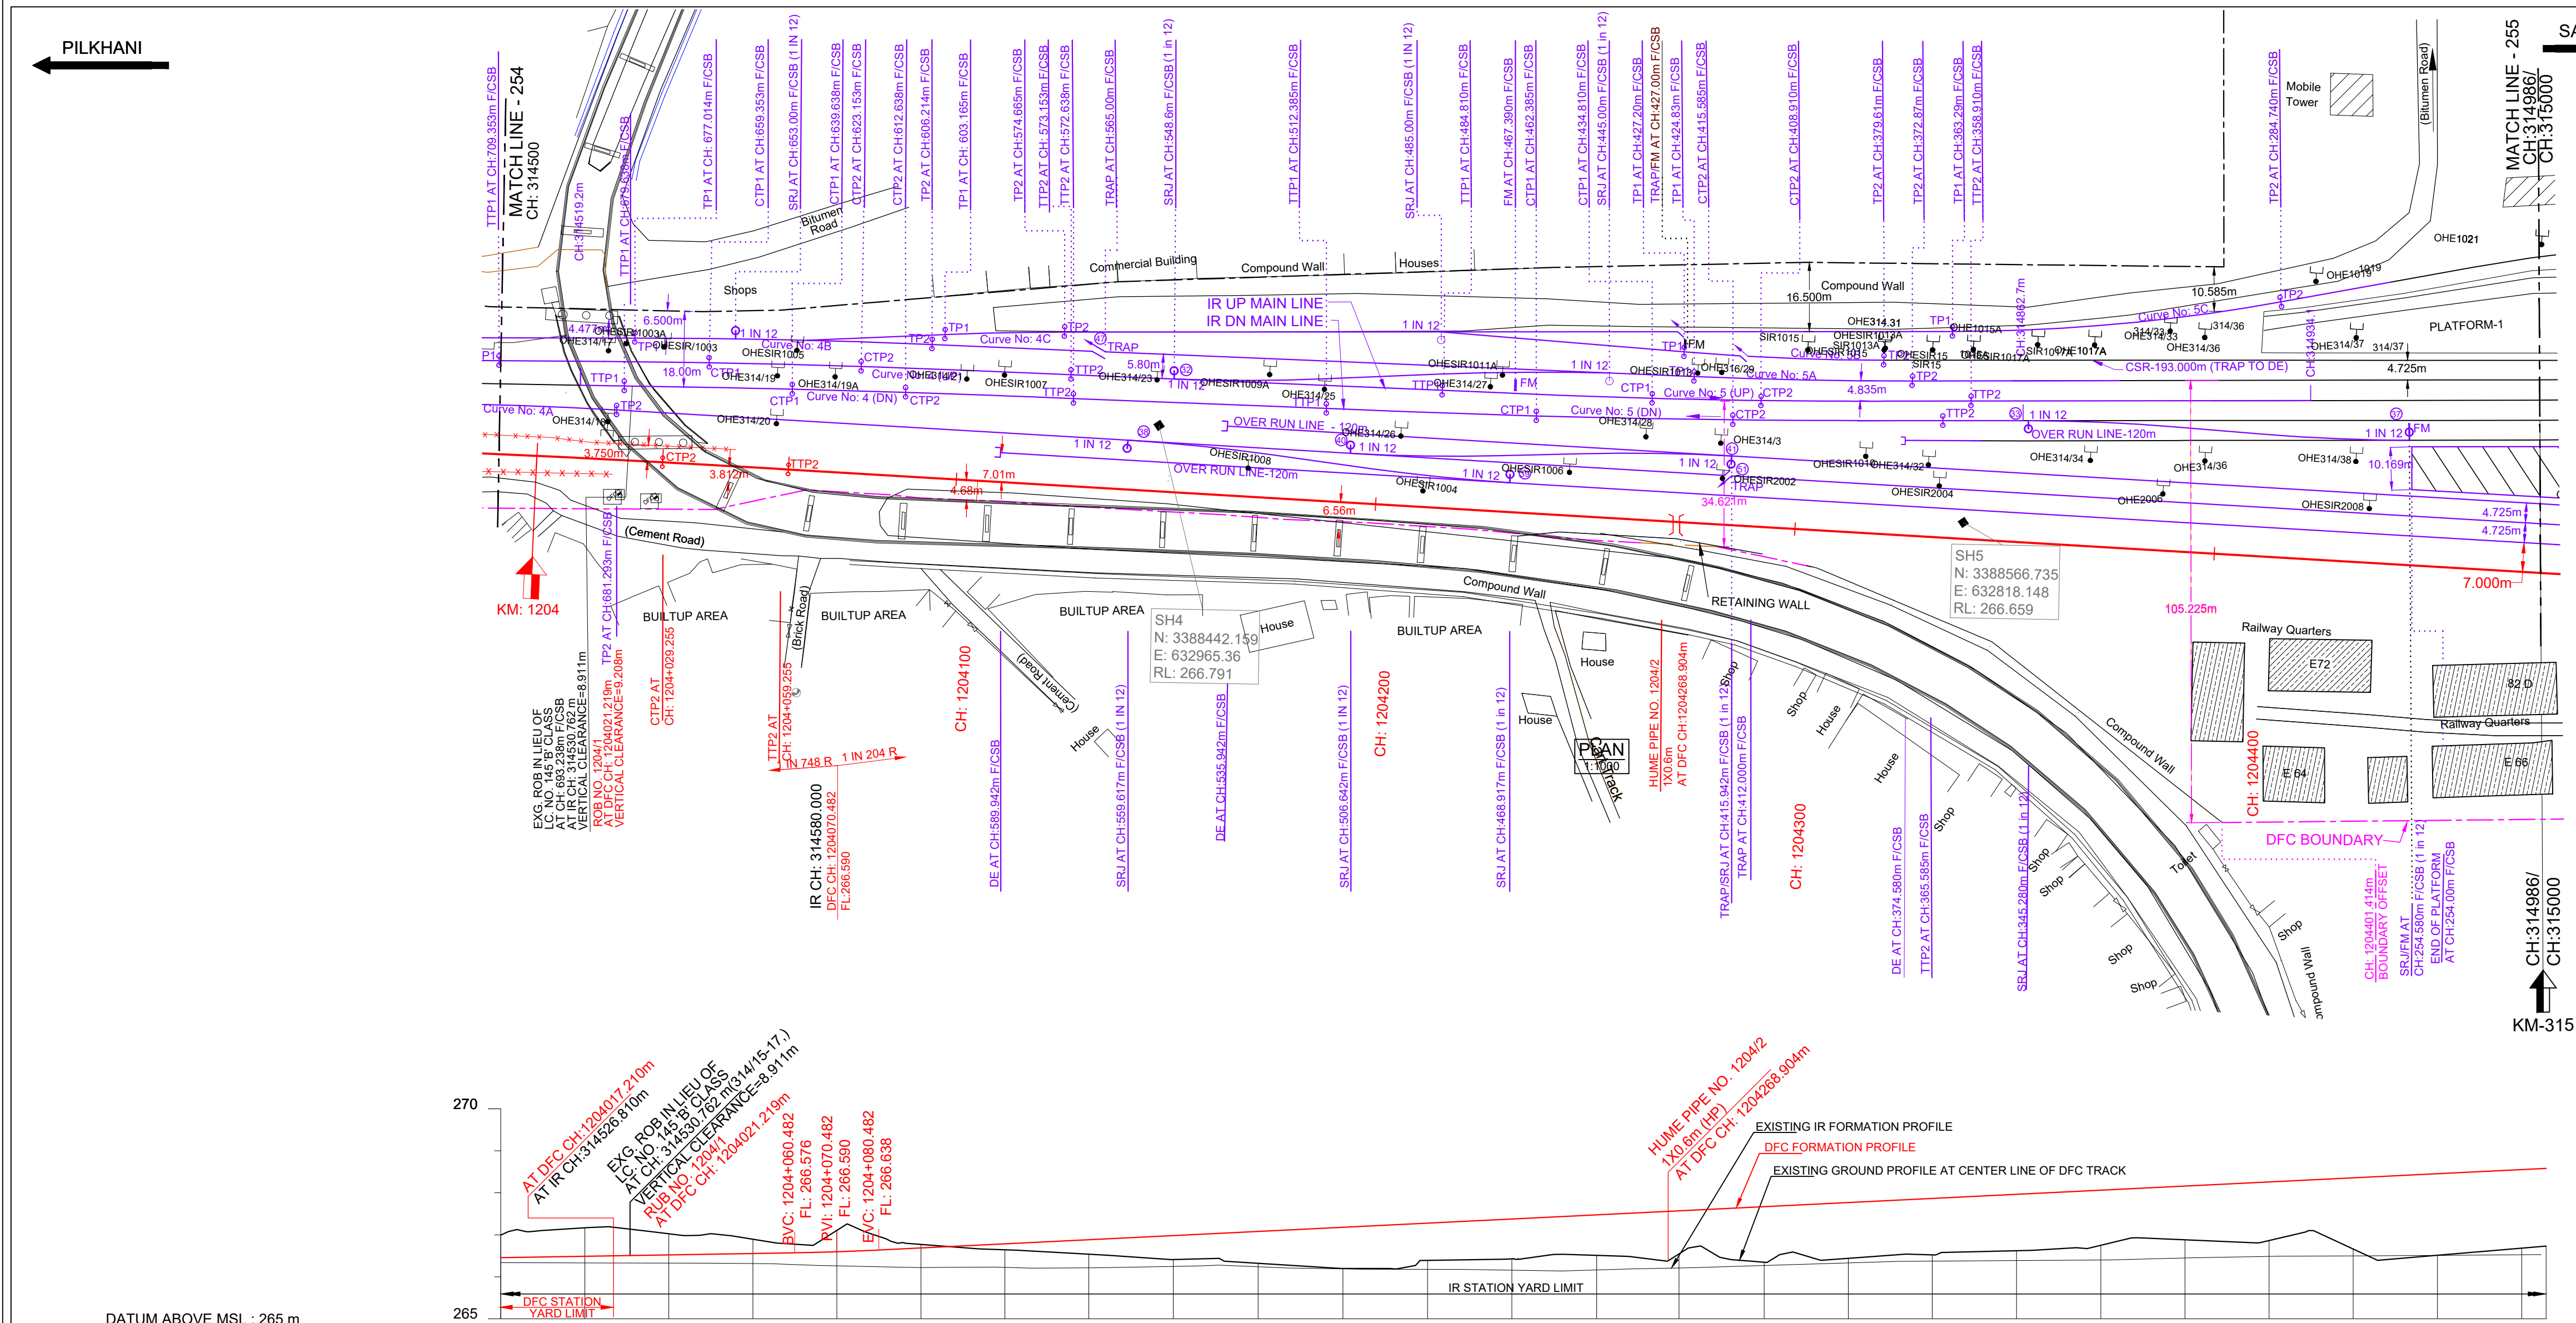


DATUM ABOVE MSL : 265 m

HORIZONTAL ALIGNMENT	TL= 30m L = 654.990m																		
VERTICAL ALIGNMENT	G=1:748.047 L=156.913m L=20.0 m R=5621 m G=1:204.286 F L=1887.555m																		
TRACK DISTANCE FROM EXISTING NEAREST IR DN MAIN LINE TO DFC MAIN LINE	11.479	-11.479	-12.165	-12.880	-13.633	-14.350	-15.070	-15.820	-16.455	-17.169	-18.044	-20.323	-21.572	-22.897	-24.063	-25.255	-26.463	-28.829	-30.031
HEIGHT OF BANKING(+) / DEPTH OF CUTTING(-) (PFL-GL)	-0.536	-0.536	-0.670	-0.503	-0.338	-0.509	-0.085	-0.140	-0.344	-0.568	-0.758	-0.885	-0.949	-0.964	-1.025	-1.322	-1.529	-1.342	-1.279
EXG GROUND LEVEL AT CENTER LINE OF DFC TRACK (GL)	266.992	266.992	267.169	267.026	266.894	267.107	266.773	266.645	266.539	266.413	266.322	266.393	266.427	266.511	266.546	266.348	266.439	266.622	266.762
EXG GROUND LEVEL AT TOE LOCATION OF DFC TRACK	266.964	266.964	267.169	267.101	267.013	266.847	266.684	266.762	266.630	266.515	266.422	266.358	266.348	266.038	266.086	266.482	266.521	266.613	266.681
DIFFERENCE BETWEEN DFC FORMATION LEVEL AND EXG.FORMATION LEVEL (PFL-EFL)	0.117	0.117	0.160	0.198	0.241	0.336	0.488	0.561	0.668	0.733	0.840	1.100	1.218	1.314	1.361	1.402	1.438	1.579	1.661
DFC FORMATION LEVEL (PFL)	266.456	266.456	266.490	266.523	266.556	266.598	266.688	266.785	266.883	266.981	267.080	267.276	267.376	267.475	267.571	267.670	267.766	267.964	268.160
EXG. FORMATION LEVEL OF EXG IR DN MAIN LINE (EFL)	266.339	266.339	266.330	266.325	266.315	266.262	266.220	266.224	266.215	266.248	266.240	266.178	266.158	266.161	266.210	266.288	266.330	266.373	266.401
DIFFERENCE BETWEEN DFC RAIL LEVEL AND EXG. RAIL LEVEL (PRL - ERL)	0.185	0.185	0.220	0.251	0.288	0.368	0.509	0.603	0.710	0.775	0.881	1.141	1.259	1.355	1.402	1.443	1.479	1.620	1.703
DFC RAIL LEVEL (PRL)	267.196	267.196	267.222	267.249	267.276	267.302	267.401	267.498	267.596	267.695	267.794	267.991	268.089	268.188	268.284	268.383	268.481	268.579	268.775
EXG.RAIL LEVEL OF NEAREST IR DN MAIN LINE(ERL)	267.011	267.011	267.002	266.997	266.987	266.934	266.892	266.896	266.887	266.920	266.912	266.850	266.830	266.833	266.882	266.940	267.002	267.057	267.073
EQUIVALENT CHAINAGE ON DFC TRACK	1203990.0	1204010.4	1204030.4	1204050.5	1204070.4	1204090.4	1204110.4	1204130.4	1204150.5	1204170.7	1204190.9	1204211.1	1204231.1	1204251.3	1204270.9	1204291.2	1204311.2	1204331.2	1204351.2
EXISTING IR CHAINAGE	314500.0	314520.0	314540.0	314560.0	314580.0	314600.0	314620.0	314640.0	314660.0	314680.0	314700.0	314720.0	314740.0	314760.0	314780.0	314800.0	314820.0	314840.0	314860.0

L - SECTION

SAHNEWAL

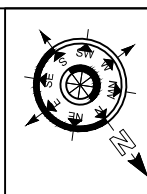

NOTE:-

1. DFC WORKS ARE SHOWN IN RED.
2. IR NEW WORKS ARE SHOWN IN VIOLET.
3. ALL DIMENSIONS ARE SHOWN IN METRES.
4. THIS DRAWING IS PREPARED BASED ON LATEST SURVEY DATA HELD ON APRIL-2022. GTS BENCH MARK OF 261.85M CONSIDERED ON TOP OF CANAL BRIDGE ABUTMENT AT DORANA VILLAGE ALONG THE NH1.
5. DFC NEW CHAINAGE OF 1075.950M IS WITH REFERENCE TO THE IR KM OF 187.500KM END OF KM OF CP-303(SECTION P-3 PILKHANI END) AGAINST THE EXISTING DFC CHAINAGE. 116277.742M ISSUED VIDE LETTER NO. COM/DFCC/MB/SURVEY/2021-301-2301/16-011/73 DT. 17.01.2023.
6. BALLAST PROFILE HAS BEEN PROVIDED ACCORDING TO THE CLAUSE 1.11.3 OF STANDARD SCHEDULE OF DIMENSION(EASTERN CORRIDOR) & THE BALLAST CUSHION DIMENSION SHOWN IN 35CM ON GE-14 PARA 17. SPECIFICATIONS & RECOMMENDATIONS 2. TWO LAYER SYSTEM FIG.10.

REFERENCE DRAWINGS :-

1. FOR KEY PLAN REFER DRAWING NO. 301-2/AL/0001
2. FOR LEGEND AND ABBREVIATIONS REFER DRAWING NO. 301-2/AL/1000
3. FOR TYPICAL SECTION OF BALLAST PROFILE (FL-RL) REFER DRG. NO. 301-2/TK/TFD/-004 (TR.1952)

REV.	DATE	REVISION DETAILS	PURPOSE OF ISSUE
0	14.09.2024	SUBMISSION OF AS-BUILT DRAWING	FOR APPROVAL

LEGEND:


SCALE

HOR - 1:1000

VER - 1:100

SHEET SIZE : A1

IR TRACK
DFCC TRACK
DFCC FUTURE PROPOSALS
STRUCTURE / BUILDING
DFCC TOE LINE
DFCC FORMATION
RETAINING WALL
ROAD
STREAM, DRAIN, NALA, CANAL.
FENCE
POWER LINES
TBM
ELECTRIC POLE/OHE MAST
IR RAILWAY BOUNDARY
DFCC BOUNDARY

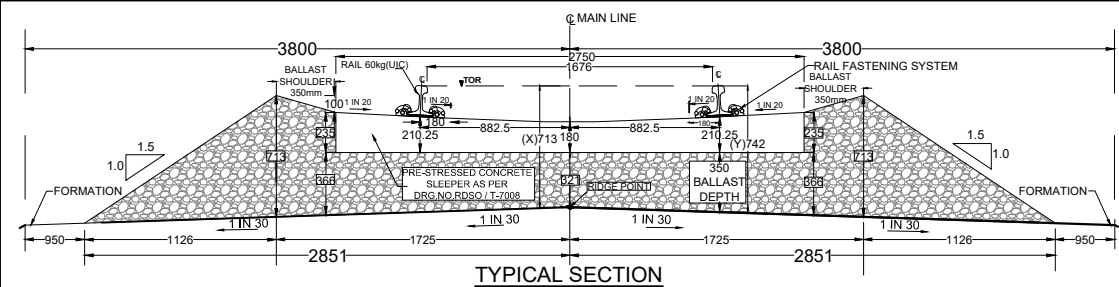

TRACK STRUCTURE		
RAIL SECTION: 60Kg/m (UIC 60Kg/m) DFC LINE: 60Kg/m (UIC 60Kg/m) IR MAIN LINE: 52Kg/m	Difference between FL- RL (Below Rail Seat)	
	IR Line	DFC
RUBBER PAD	172mm	172mm
SLEEPER DEPTH	6mm	10mm
BALLAST CUSHION	210mm	210mm
	300mm	350mm
Total Depth (FL TO RL)	688mm	742mm

OWNER: DEDICATED FREIGHT CORRIDOR CORPORATION OF INDIA LTD. (A GOVERNMENT OF INDIA ENTERPRISE)
PROJECT OFFICE (AMBALA UNIT): OLD RAILWAY COLONY (NEAR ANAND MARKET), AMBALA CANTT-133001.
CORPORATE IDENTITY NO. : U60232DL2006GG01155068

ENGINEER: DB Engineering & Consulting GmbH
Deutsche Bahn Engineering & Consulting GmbH

CONTRACTOR: GIL - TPL JV
GAR TATA

SUBMITTED BY	GIL - TPL JV		
PREPARED BY	DATED	NAME	SIGNATURE
CHECKED BY	14.09.2024	VIJAY PRATAP	
APPROVED BY	14.09.2024	PARASURAM KOTYADA	

APPROVED BY	DEUTSCHE BAHN ENGINEERING & CONSULTING GMBH		
Sr. DE./CHIEF ENGINEER	DATED	NAME	SIGNATURE
CHIEF TRACK ENGINEER		SURESH K.YALANGI	
T.L.		RAJ PAL SINGH	
		H.D. VIDJAK	

STAMP	A AS-BUILT DRAWING TR. Ref:..... ENGINEER Sign.:.....		
EMPLOYER (DFCCIL):	DEDICATED FREIGHT CORRIDOR CORPORATION OF INDIA LTD.		

AS BUILT DRAWING			
TITLE	AS-BUILT PLAN AND PROFILE	DFCC APPR. NO. -	
	FROM IR KM: 314.500 TO 315.000	ENGG. APPR. NO. -	
	DFC KM: 1203.990 TO 1204.477	DRG. NO. - 301-2/AL/A/1255	
		SHEET NO. : 1 OF 1	STATUS
		DATE : 14.09.2024	A

TR.