
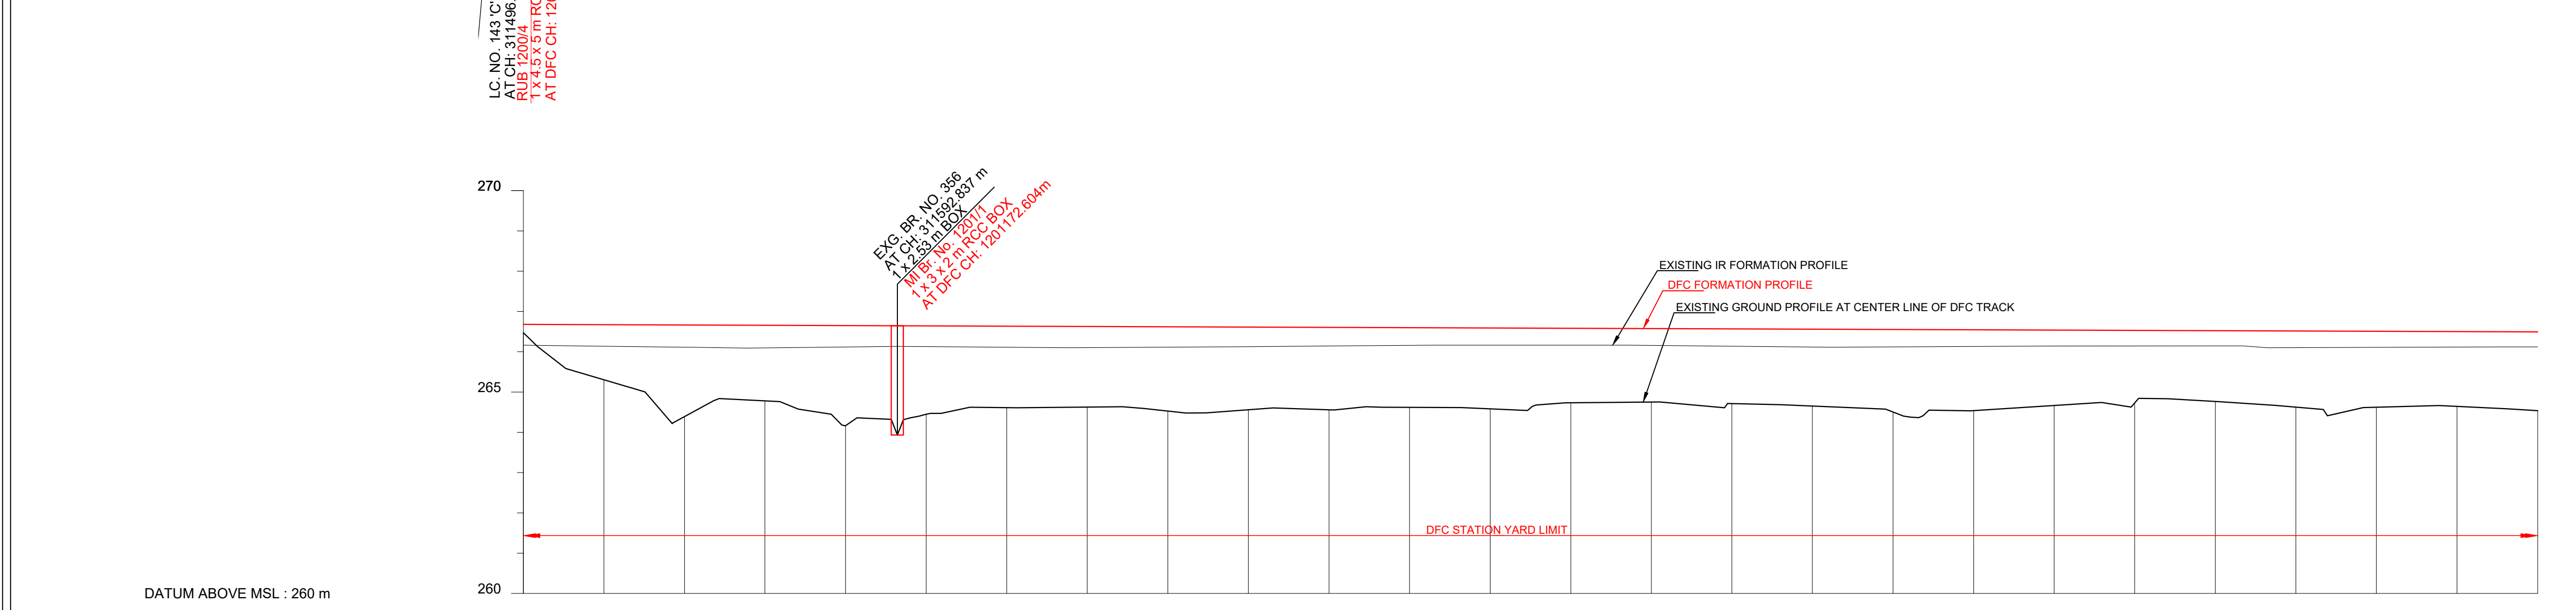


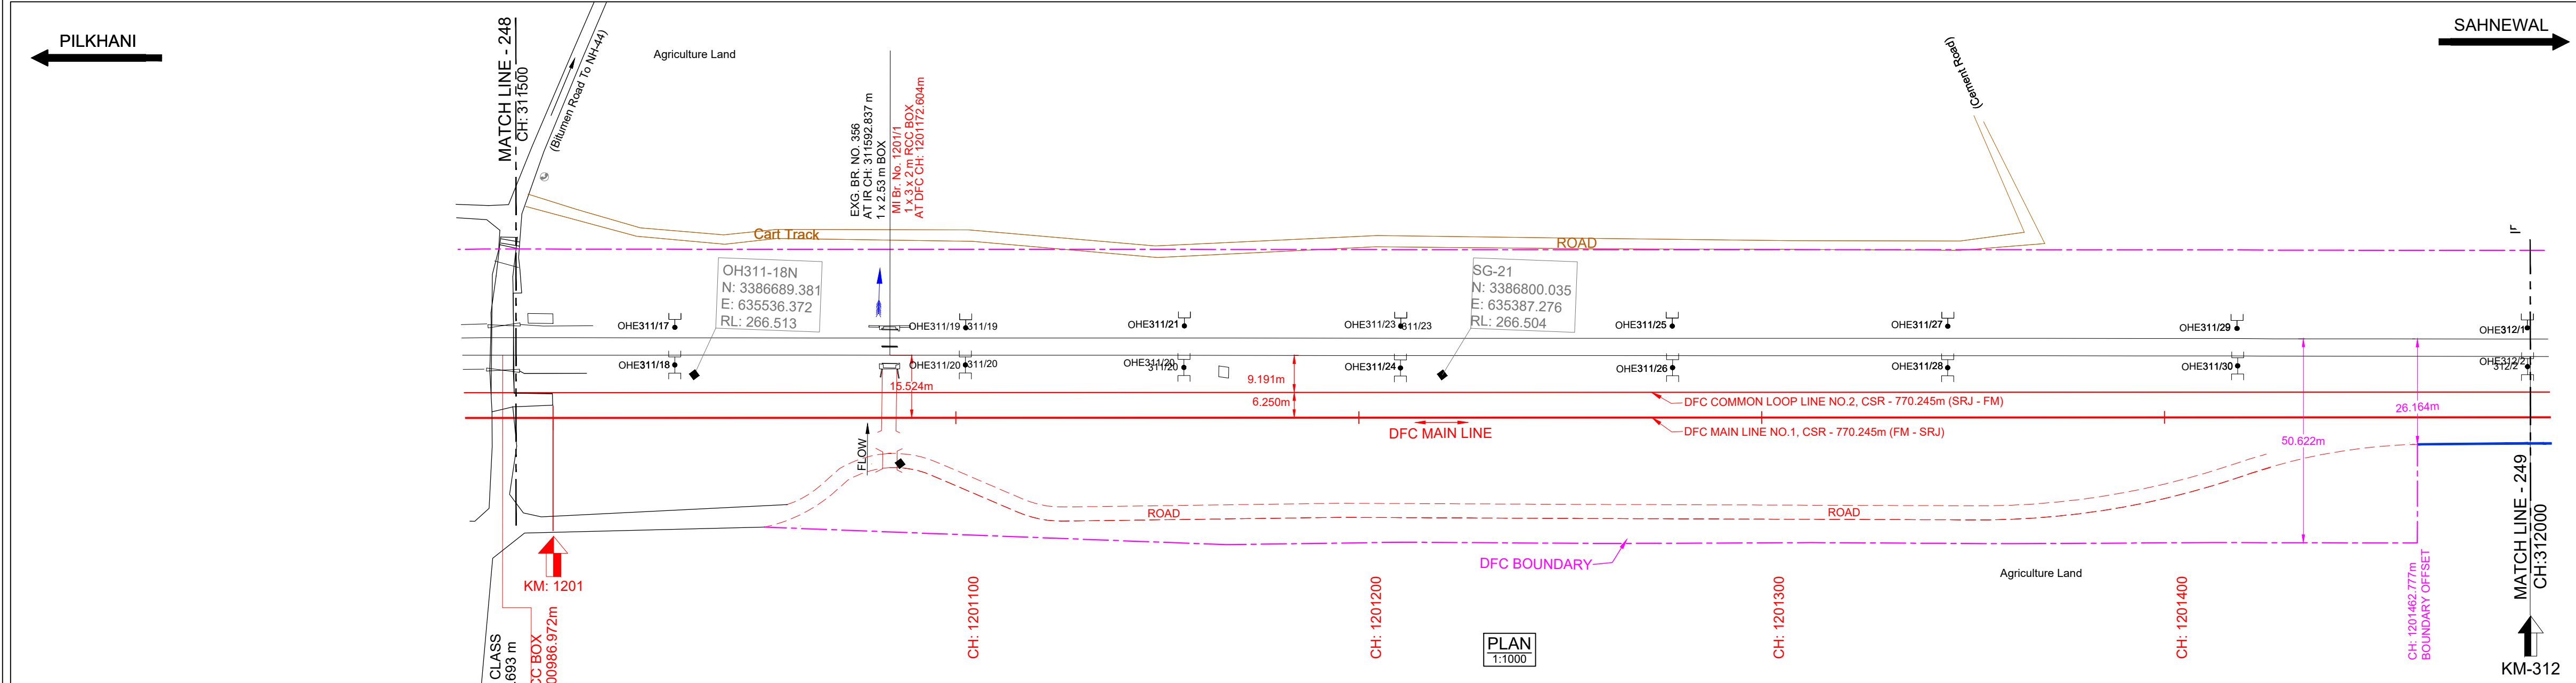

| HORIZONTAL ALIGNMENT                                                     | L = 867.010m                    |           |           |           |           |           |           |           |           |           |           |           |           |           |           |
|--------------------------------------------------------------------------|---------------------------------|-----------|-----------|-----------|-----------|-----------|-----------|-----------|-----------|-----------|-----------|-----------|-----------|-----------|-----------|
| VERTICAL ALIGNMENT                                                       | L=2139.573 m<br>1 IN 2711:213 F |           |           |           |           |           |           |           |           |           |           |           |           |           |           |
| TRACK DISTANCE FROM EXISTING NEAREST IR DN MAIN LINE TO DFC MAIN LINE    | 15.550                          | 15.550    | 15.552    | 15.558    | 15.590    | 15.550    | 15.521    | 15.514    | 15.504    | 15.485    | 15.464    | 15.430    | 15.396    | 15.388    | 15.390    |
| HEIGHT OF BANKING(+) / DEPTH OF CUTTING(-) (PFL-GL)                      | +0.208                          | +1.369    | +2.275    | +1.876    | +2.486    | +2.195    | +2.024    | +2.001    | +2.092    | +2.053    | +2.046    | +1.979    | +1.851    | +1.825    | +1.802    |
| EXG GROUND LEVEL AT CENTER LINE OF DFC TRACK (GL)                        | 266.471                         | 266.303   | 264.390   | 264.781   | 264.164   | 264.448   | 264.611   | 264.627   | 264.528   | 264.560   | 264.560   | 264.526   | 264.733   | 264.751   | 264.730   |
| EXG GROUND LEVEL AT TOE LOCATION OF DFC TRACK                            | 266.005                         | 264.873   | 264.344   | 264.597   | 264.423   | 264.323   | 264.469   | 264.436   | 264.453   | 264.486   | 264.480   | 264.526   | 264.652   | 264.740   | 264.511   |
| DIFFERENCE BETWEEN DFC FORMATION LEVEL AND EXG.FORMATION LEVEL (PFL-EFL) | 0.517                           | 0.534     | 0.553     | 0.563     | 0.532     | 0.515     | 0.524     | 0.526     | 0.507     | 0.489     | 0.464     | 0.438     | 0.420     | 0.418     | 0.389     |
| DFC FORMATION LEVEL (PFL)                                                | 266.679                         | 266.672   | 266.665   | 266.657   | 266.650   | 266.643   | 266.635   | 266.628   | 266.620   | 266.613   | 266.606   | 266.598   | 266.584   | 266.576   | 266.539   |
| EXG. FORMATION LEVEL OF EXG IR DN MAIN LINE (EFL)                        | 266.162                         | 266.138   | 266.112   | 266.094   | 266.118   | 266.128   | 266.111   | 266.102   | 266.113   | 266.124   | 266.142   | 266.160   | 266.184   | 266.158   | 266.141   |
| DIFFERENCE BETWEEN DFC RAIL LEVEL AND EXG. RAIL LEVEL (PRL - ERL)        | 0.558                           | 0.575     | 0.593     | 0.604     | 0.572     | 0.555     | 0.564     | 0.567     | 0.549     | 0.530     | 0.504     | 0.479     | 0.461     | 0.459     | 0.439     |
| DFC RAIL LEVEL (PRL)                                                     | 267.392                         | 267.395   | 267.377   | 267.370   | 267.363   | 267.355   | 267.348   | 267.340   | 267.333   | 267.326   | 267.318   | 267.311   | 267.296   | 267.289   | 267.252   |
| EXG.RAIL LEVEL OF NEAREST IR DN MAIN LINE(ERL)                           | 266.834                         | 266.810   | 266.784   | 266.766   | 266.790   | 266.800   | 266.783   | 266.774   | 266.785   | 266.796   | 266.814   | 266.832   | 266.836   | 266.830   | 266.813   |
| EQUIVALENT CHAINAGE ON DFC TRACK                                         | 120090.3                        | 1201010.3 | 1201030.3 | 1201050.2 | 1201070.2 | 1201090.3 | 1201110.3 | 1201130.3 | 1201150.3 | 1201170.3 | 1201190.3 | 1201210.3 | 1201230.3 | 1201250.3 | 1201270.3 |
| EXISTING IR CHAINAGE                                                     | 311500.0                        | 311520.0  | 311540.0  | 311560.0  | 311580.0  | 311600.0  | 311620.0  | 311640.0  | 311660.0  | 311680.0  | 311700.0  | 311720.0  | 311740.0  | 311760.0  | 311780.0  |

L - SECTION

NOTE:-

- DFCC WORKS ARE SHOWN IN RED.
- IR NEW WORKS ARE SHOWN IN VIOLET.
- ALL DIMENSIONS ARE SHOWN IN METRES.
- THIS DRAWING IS PREPARED BASED ON LATEST SURVEY DATA HELD ON APRIL-2022. GTS BENCH MARK OF 261.850M CONSIDERED ON TOP OF CANAL BRIDGE ABUTMENT AT DORAHA VILLAGE ALONG THE NH1.
- DFC NEW CHAINAGE OF 1075.950M IS WITH REFERENCE TO THE IR KM OF 187.500KM END OF KM OF CP-303(SECTION P-3 PILKHANI END) AGAINST THE EXISTING DFC CHAINAGE. 116277.742M ISSUED VIDE LETTER NO. COM/DFCC/UM/SURVEY/2021-301-230116-011173 DT. 17.01.2023.
- BALLAST PROFILE HAS BEEN PROVIDED ACCORDING TO THE CLAUSE 1.11.3 OF STANDARD SCHEDULE OF DIMENSION(EASTERN CORRIDOR) & THE BALLAST CUSHION DIMESION SHOWN IN 35CM ON GE-14 PARA 17. SPECIFICATIONS & RECOMMENDATIONS 2. TWO LAYER SYSTEM FIG.10.

REFERENCE DRAWINGS :-

- FOR KEY PLAN REFER DRAWING NO. 301-2/AL/0001
- FOR LEGEND AND ABBREVIATIONS REFER DRAWING NO. 301-2/AL/1000
- FOR TYPICAL SECTION OF BALLAST PROFILE (FL-RL) REFFER DRG. NO. 301-2/TK/TFD/004 (TR.1952)

014.09.2024SUBMISSION OF AS-BUILT DRAWINGFOR APPROVAL

REV. DATE REVISION DETAILS PURPOSE OF ISSUE

SCALE  
HOR - 1:1000  
VER - 1:100  
SHEET SIZE : A1

LEGEND:

- IR TRACK
- DFCC TRACK
- DFCC FUTURE PROPOSALS
- STRUCTURE / BUILDING
- DFCC TOE LINE
- DFCC FORMATION
- RETAINING WALL
- ROAD
- STREAM, DRAIN, NALA, CANAL.
- FENCE
- POWER LINES
- TBM
- ELECTRIC POLE/OHE MAST
- IR RAILWAY BOUNDARY
- DFCC BOUNDARY

TRACK STRUCTURE

|                                   |                                             |       |
|-----------------------------------|---------------------------------------------|-------|
| RAIL SECTION: 60Kg/m (UIC 60Kg/m) | Difference between FL- RL (Below Rail Seat) |       |
| DFC LINE: 60Kg/m (UIC 60Kg/m)     | IR Line                                     | DFC   |
| IR MAIN LINE :52Kg/m              | 172mm                                       | 172mm |
| RUBBER PAD                        | 6mm                                         | 10mm  |
| SLEEPER DEPTH                     | 210mm                                       | 210mm |
| BALLAST CUSHION                   | 300mm                                       | 350mm |
| Total Depth (FL TO RL)            | 688mm                                       | 742mm |

OWNER

DEDICATED FREIGHT CORRIDOR CORPORATION OF INDIA LTD.  
(A GOVERNMENT OF INDIA ENTERPRISE)  
PROJECT OFFICE(AMBALA UNIT): OLD RAILWAY COLONY (NEAR ANAND MARKET),AMBALA CANTT.-133001.  
CORPORATE IDENTITY NO. : U60232DL2006GGI155068

ENGINEER:

DB Engineering & Consulting GmbH  
Deutsche Bahn Engineering & Consulting GmbH

CONTRACTOR:

GIL - TPL JV

|              |              |                   |           |
|--------------|--------------|-------------------|-----------|
| SUBMITTED BY | GIL - TPL JV |                   |           |
| PREPARED BY  | DATED        | NAME              | SIGNATURE |
| CHECKED BY   | 14.09.2024   | VIJAY PRATAP      |           |
| APPROVED BY  | 14.09.2024   | PARASURAM KOTYADA |           |

|                        |                                             |                  |           |
|------------------------|---------------------------------------------|------------------|-----------|
| APPROVED BY            | DEUTSCHE BAHN ENGINEERING & CONSULTING GMBH |                  |           |
|                        | DATED                                       | NAME             | SIGNATURE |
| Sr. DE./CHIEF ENGINEER |                                             | SURESH K.YALANGI |           |
| CHIEF TRACK ENGINEER   |                                             | RAJ PAL SINGH    |           |
| T.L.                   |                                             | H.D. VIDJAK      |           |

STAMP

AS-BUILT DRAWING  
TR. Ref.:.....  
ENGINEER Sign.:.

EMPLOYER (DFCCIL):

DEDICATED FREIGHT CORRIDOR CORPORATION OF INDIA LTD.

AS BUILT DRAWING

TITLE

AS-BUILT PLAN AND PROFILE

DFCC APPR. NO. -  
ENGG. APPR. NO. -  
DRG. NO. -301-2/AL/A/1249  
SHEET NO. : 1 OF 1  
DATE : 14.09.2024

STATUS  
A

FROM IR KM: 311.500 TO 312.000  
DFC KM: 1200.990 TO 1201.490

TR.