


PILKHANI

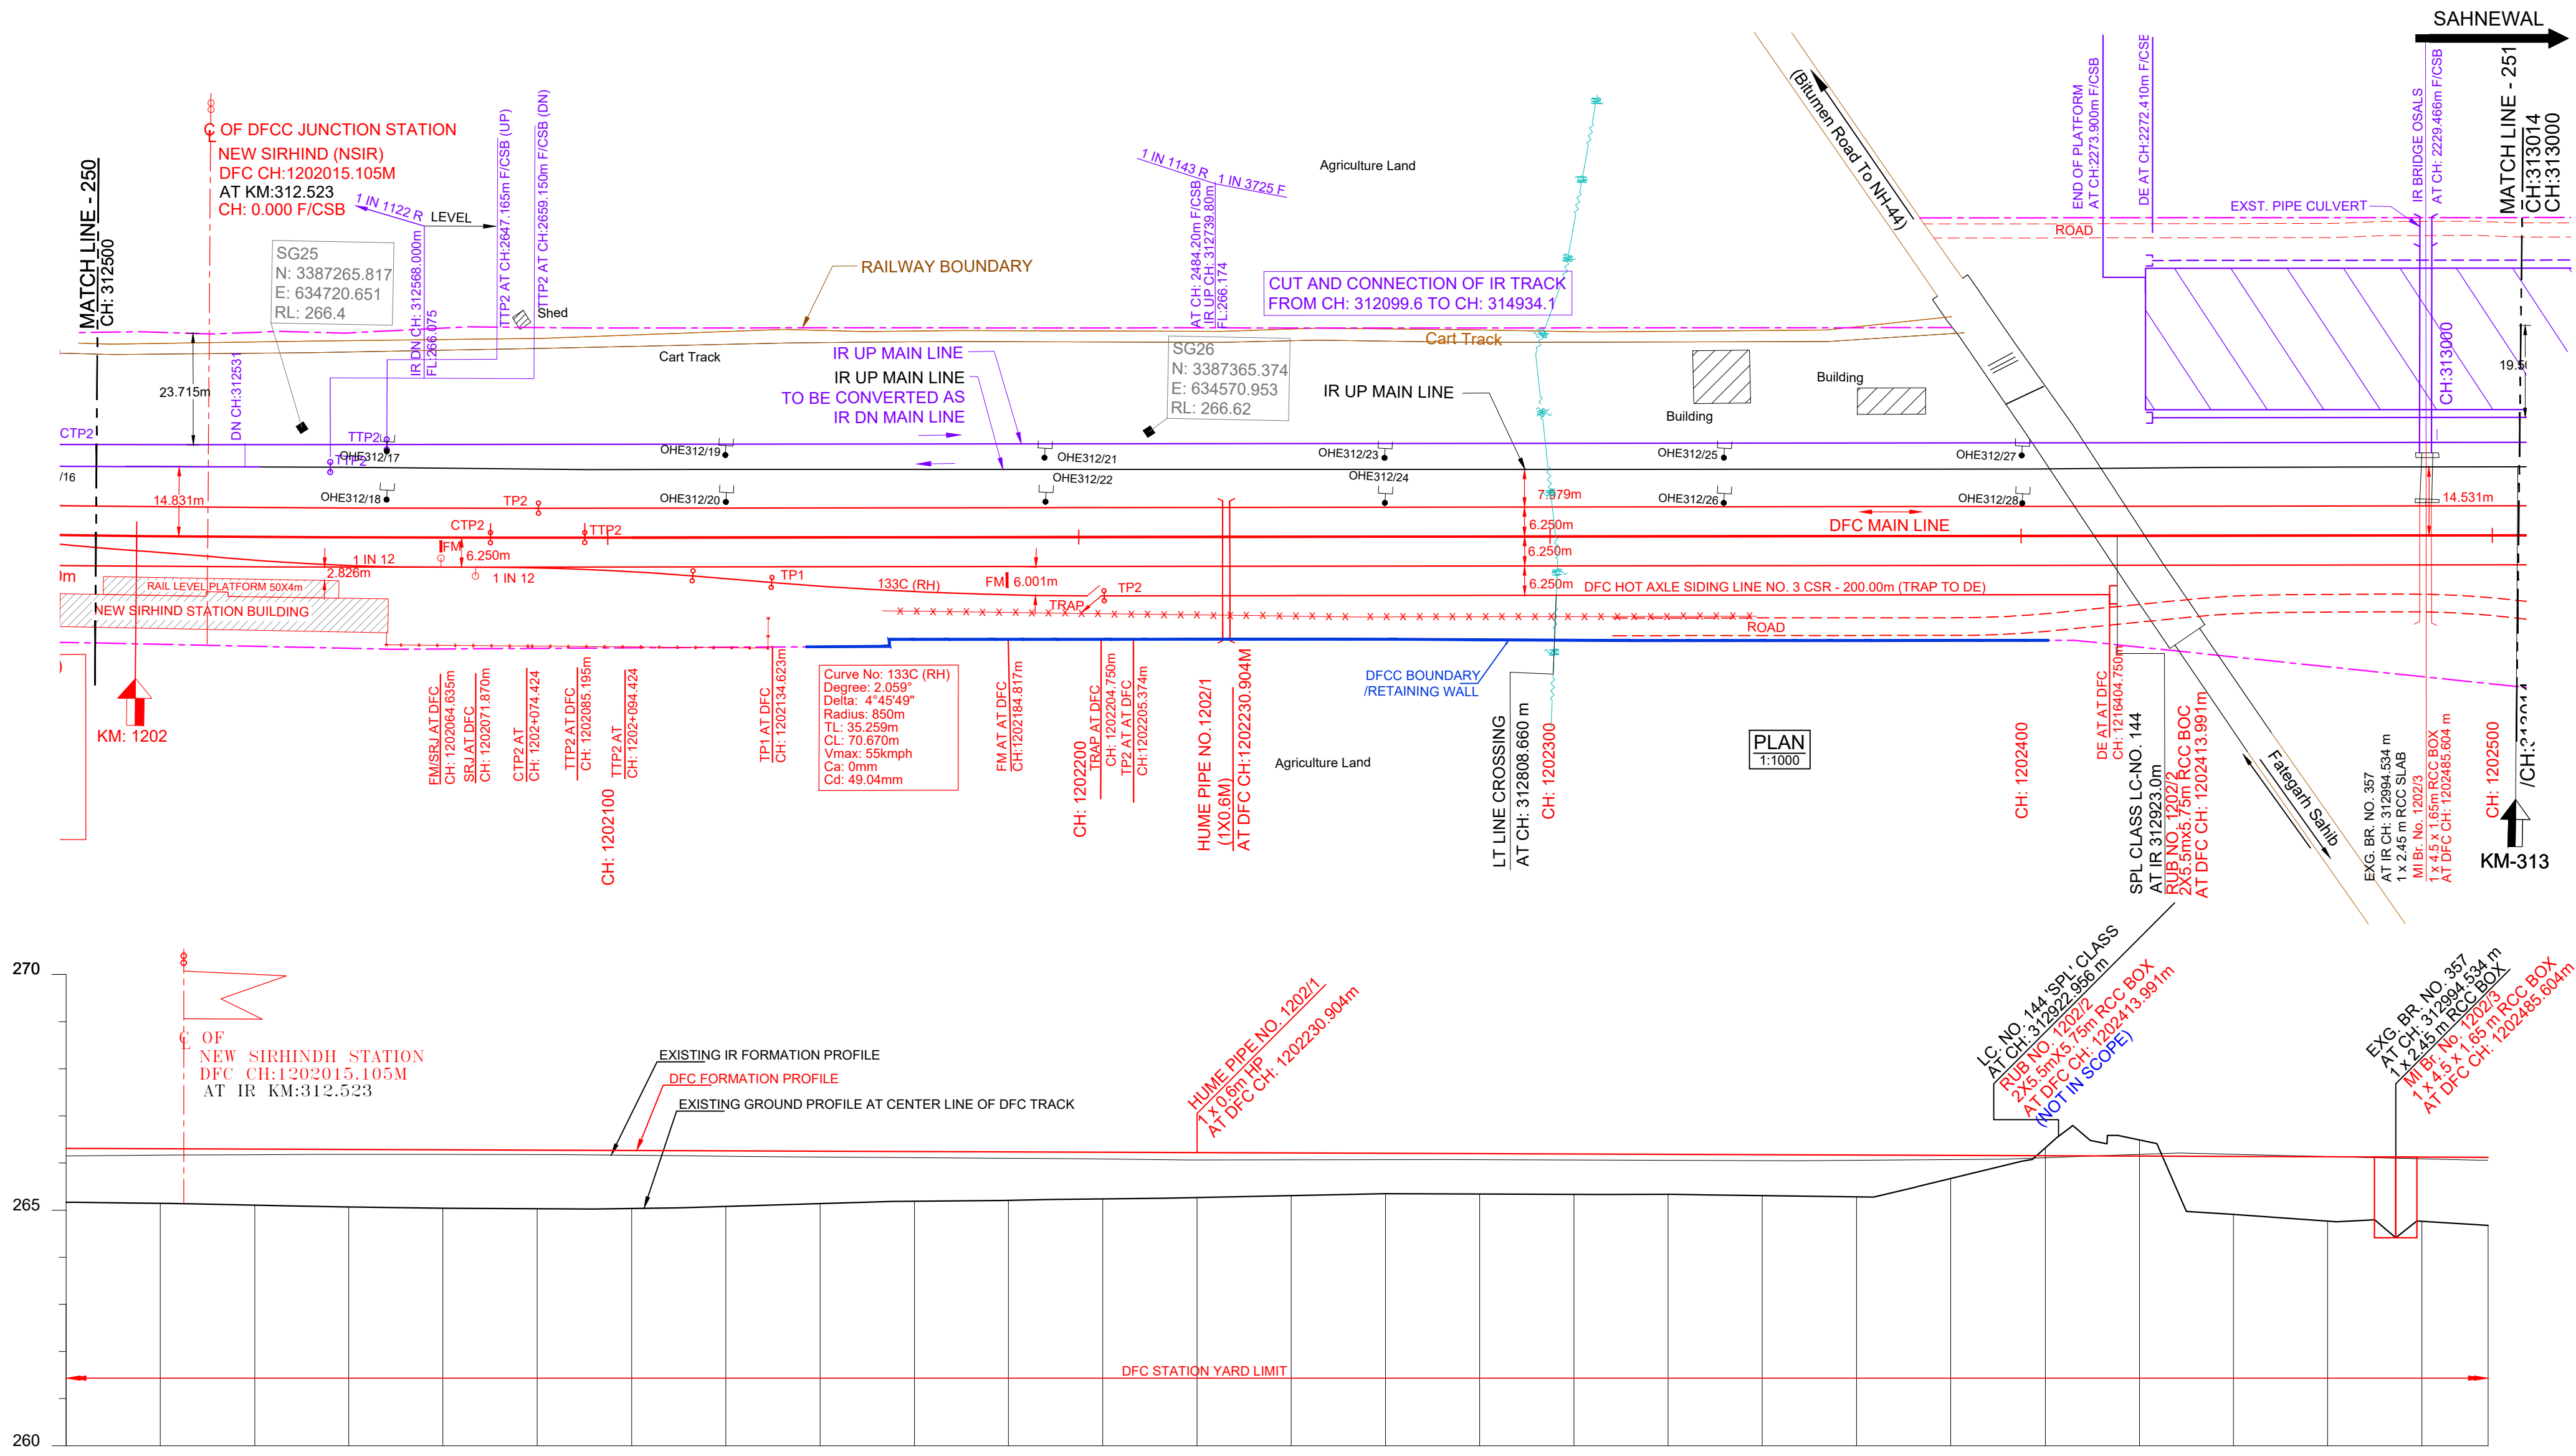

DATUM ABOVE MSL : 260 m

HORIZONTAL ALIGNMENT	R = 8000m		TL = 20m		L = 1181.717m	
VERTICAL ALIGNMENT					L = 2139.573 m 1 IN 2711.213 F	
TRACK DISTANCE FROM EXISTING NEAREST IR DN MAIN LINE TO DFC MAIN LINE	10.260	10.308	10.407	10.412	10.281	10.100
HEIGHT OF BANKING(+) / DEPTH OF CUTTING(-) (PFL-GL)	+1.143	+1.158	+1.190	+1.221	+1.240	+1.243
EXG GROUND LEVEL AT CENTER LINE OF DFC TRACK (GL)	-265.167	-265.145	-265.108	-265.087	-265.041	-265.030
EXG GROUND LEVEL AT TOE LOCATION OF DFC TRACK	-264.858	-264.781	-264.816	-264.803	-264.764	-264.771
DIFFERENCE BETWEEN DFC FORMATION LEVEL AND EXG.FORMATION LEVEL (PFL-EFL)	0.161	0.137	0.118	0.104	0.098	0.093
DFC FORMATION LEVEL (PFL)	-266.310	-266.303	-266.296	-266.288	-266.281	-266.273
EXG. FORMATION LEVEL OF EXG IR DN MAIN LINE (EFL)	-266.149	-266.166	-266.178	-266.184	-266.183	-266.180
DIFFERENCE BETWEEN DFC RAIL LEVEL AND EXG. RAIL LEVEL (PRL - ERL)	0.203	0.178	0.158	0.145	0.139	0.134
DFC RAIL LEVEL (PRL)	-267.023	-267.016	-267.008	-267.001	-266.994	-266.986
EXG.RAIL LEVEL OF NEAREST IR DN MAIN LINE(ERL)	-266.821	-266.838	-266.850	-266.856	-266.855	-266.852
EQUIVALENT CHAINAGE ON DFC TRACK	201990.6	202010.4	202030.5	202050.5	202070.5	202090.6
EXISTING IR CHAINAGE	312500.0	312520.0	312540.0	312560.0	312580.0	312600.0

L - SECTION



- NOTE:-
- DFCC WORKS ARE SHOWN IN RED.
 - IR NEW WORKS ARE SHOWN IN VIOLET.
 - ALL DIMENSIONS ARE SHOWN IN METRES.
 - THIS DRAWING IS PREPARED BASED ON LATEST SURVEY DATA HELD ON APRIL-2022. GTS BENCH MARK OF 261.850M CONSIDERED ON TOP OF CANAL BRIDGE ABUTMENT AT DORAH VILLAGE ALONG THE NH1.
 - DFC NEW CHAINAGE OF 1075.950M IS WITH REFERENCE TO THE IR KM OF 187.500KM END OF KM OF CP-303(SECTION P-3 PILKHANI END) AGAINST THE EXISTING DFC CHAINAGE. 116277.742M ISSUED VIDE LETTER NO. COM/DFCC/UM/SURVEY/2021-301-230116-01173 DT. 17.01.2023
 - BALLAST PROFILE HAS BEEN PROVIDED ACCORDING TO THE CLAUSE 1.11.3 OF STANDARD SCHEDULE OF DIMENSION(EASTERN CORRIDOR) & THE BALLAST CUSHION DIMENSION SHOWN IN 35CM ON GE-14 PARA 17. SPECIFICATIONS & RECOMMENDATIONS 2. TWO LAYER SYSTEM FIG.10.

REFERENCE DRAWINGS :-


- FOR KEY PLAN REFER DRAWING NO. 301-2/AL/0001
- FOR LEGEND AND ABBREVIATIONS REFER DRAWING NO. 301-2/AL/1000
- FOR TYPICAL SECTION OF BALLAST PROFILE (FL-RL) REFER DRG. NO. 301-2/TK/TFD/-004 (TR.1952)

0	14.09.2024	SUBMISSION OF AS-BUILT DRAWING	FOR APPROVAL
REV.	DATE	REVISION DETAILS	PURPOSE OF ISSUE

LEGEND:

IR TRACK
DFCC TRACK
DFCC FUTURE PROPOSALS
STRUCTURE / BUILDING
DFCC TOE LINE
DFCC FORMATION
RETAINING WALL
ROAD
STREAM, DRAIN, NALA, CANAL.
FENCE
POWER LINES
TBM
ELECTRIC POLE/OHE MAST
IR RAILWAY BOUNDARY
DFCC BOUNDARY

SCALE
HOR - 1:1000
VER - 1:100
SHEET SIZE : A1

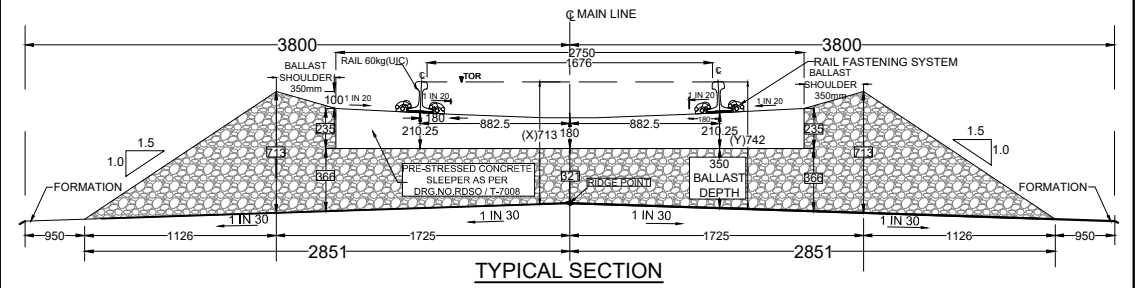

TRACK STRUCTURE		
RAIL SECTION: 60Kg/m (UIC 60Kg/m) DFC LINE: 60Kg/m (UIC 60Kg/m) IR MAIN LINE: 52Kg/m	Difference between FL- RL (Below Rail Seat)	
	IR Line	DFC
RUBBER PAD	172mm	172mm
SLEEPER DEPTH	6mm	10mm
BALLAST CUSHION	210mm	210mm
Total Depth (FL TO RL)	300mm	350mm
	688mm	742mm

OWNER
DEDICATED FREIGHT CORRIDOR CORPORATION OF INDIA LTD.
(A GOVERNMENT OF INDIA ENTERPRISE)
PROJECT OFFICE(AMBALA UNIT): OLD RAILWAY COLONY (NEAR ANAND MARKET),AMBALA CANTT-133001.
CORPORATE IDENTITY NO. : U60232DL2006GGI155068

ENGINEER:
DB Engineering & Consulting GmbH
Deutsche Bahn Engineering & Consulting GmbH

CONTRACTOR:
GIL - TPL JV
GAR TATA

SUBMITTED BY	GIL - TPL JV		
	DATED	NAME	SIGNATURE
PREPARED BY			
CHECKED BY	14.09.2024	VIJAY PRATAP	
APPROVED BY	14.09.2024	PARASURAM KOTYADA	

APPROVED BY	DEUTSCHE BAHN ENGINEERING & CONSULTING GMBH		
	DATED	NAME	SIGNATURE
Sr. DE./CHIEF ENGINEER		SURESH K.YALANGI	
CHIEF TRACK ENGINEER		RAJ PAL SINGH	
T.L.		H.D. VIDJAK	

STAMP	A AS-BUILT DRAWING TR. Ref.:..... ENGINEER Sign.:.....		
EMPLOYER (DFCCIL):	DEDICATED FREIGHT CORRIDOR CORPORATION OF INDIA LTD.		

AS BUILT DRAWING			
TITLE AS-BUILT PLAN AND PROFILE		DFCC APPR. NO. - ENGG. APPR. NO. -	
FROM IR KM: 312.500 TO 313.000 DFC KM: 1201.990 TO 1202.505		DRG. NO. -301-2/AL/A/1251 SHEET NO. : 1 OF 1 DATE : 14.09.2024	
		STATUS A	

TR.