
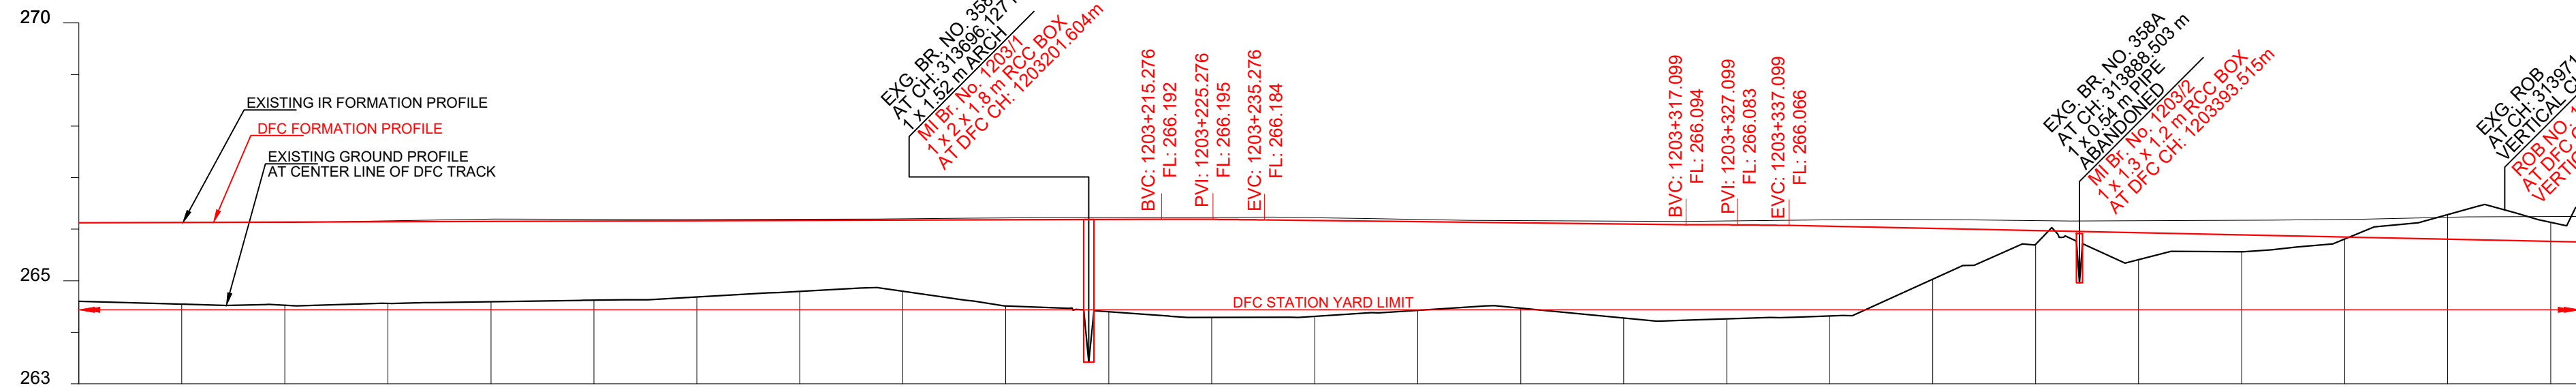


PILKHANI

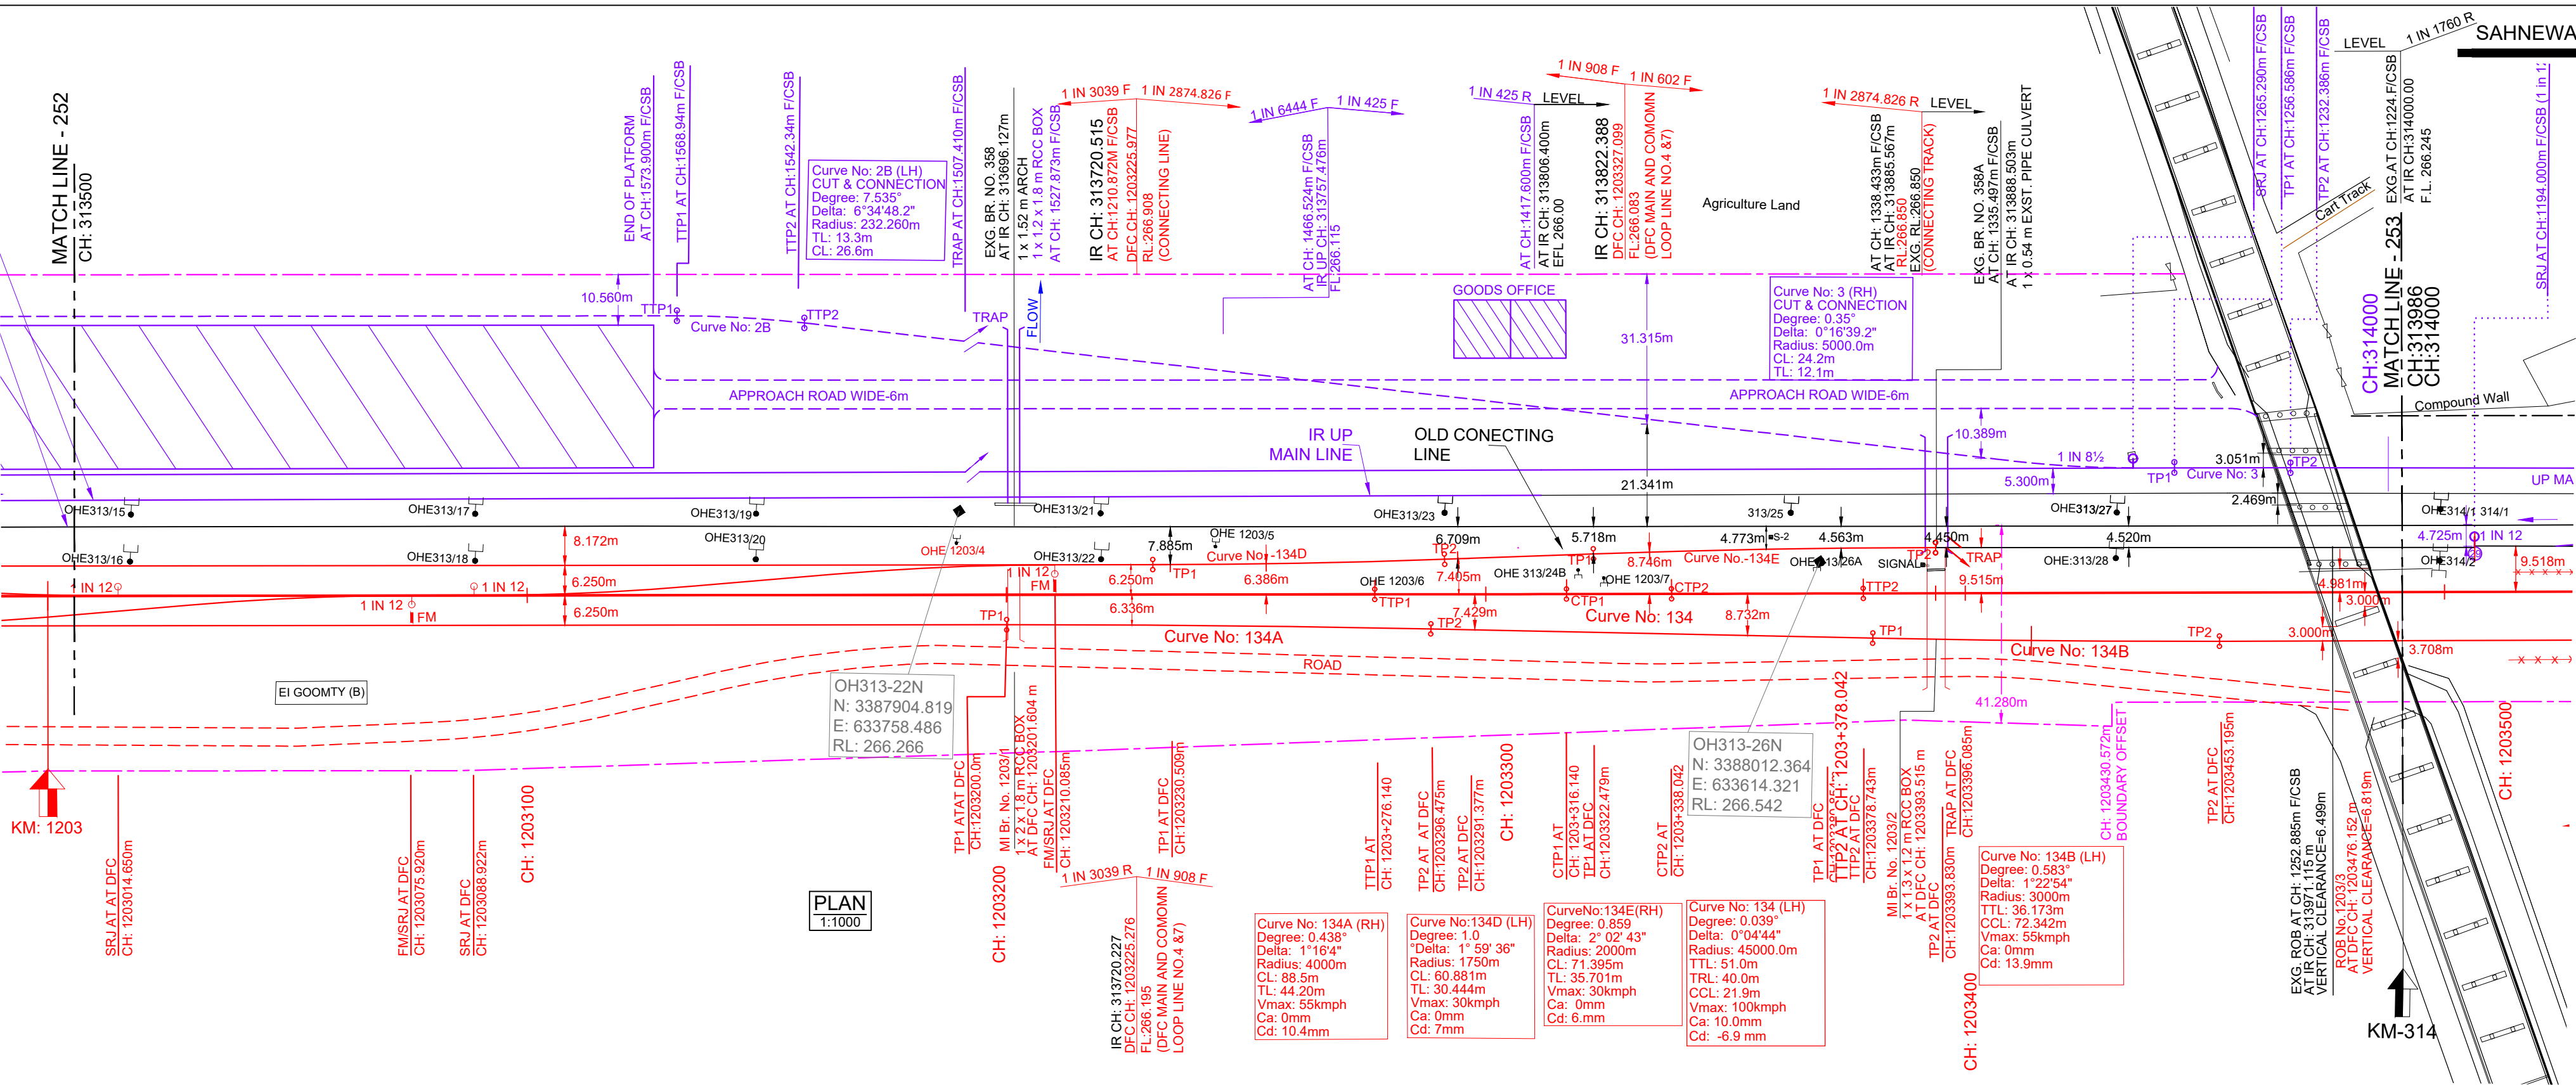

DATUM ABOVE MSL : 263 m

HORIZONTAL ALIGNMENT	L = 1181.717m																			
VERTICAL ALIGNMENT	L=467.213 m 1 IN 3038.795 R																			
TRACK DISTANCE FROM EXISTING NEAREST IR DN MAIN LINE TO DFC MAIN LINE	9.906	9.876	9.847	9.803	9.942	9.958	9.967	9.952	9.936	9.923	9.913	9.907	9.902	9.901	9.893	9.876	9.854	9.825	9.789	9.750
HEIGHT OF BANKING(+) / DEPTH OF CUTTING(-) (PFL-GL)	+1.522	+1.583	+1.613	+1.582	+1.557	+1.533	+1.478	+1.376	+1.379	+1.671	+1.790	+1.902	+1.855	+1.704	+1.630	+1.768	+1.770	+1.679	+0.935	+0.225
EXG GROUND LEVEL AT CENTER LINE OF DFC TRACK (GL)	-264.001	-264.546	-264.523	-264.560	-264.592	-264.623	-264.684	-264.793	-264.796	-264.511	-264.325	-264.288	-264.307	-264.425	-264.466	-264.094	-264.172	-264.259	-265.027	-265.704
EXG GROUND LEVEL AT TOE LOCATION OF DFC TRACK	-264.610	-264.572	-264.599	-264.563	-264.572	-264.600	-264.593	-264.613	-264.596	-264.493	-264.325	-264.181	-263.964	-264.023	-264.018	-264.036	-264.172	-264.259	-265.027	-265.704
DIFFERENCE BETWEEN DFC FORMATION LEVEL AND EXG.FORMATION LEVEL (PFL-EFL)	-0.002	0.003	0.010	-0.018	-0.046	-0.035	-0.025	-0.023	-0.025	-0.035	-0.040	-0.042	-0.059	-0.059	-0.070	-0.093	-0.129	-0.269	-0.221	-0.235
DFC FORMATION LEVEL (PFL)	-266.123	-266.126	-266.136	-266.142	-266.149	-266.156	-266.162	-266.169	-266.175	-266.182	-266.188	-266.190	-266.162	-266.129	-266.096	-266.062	-266.029	-265.895	-265.962	-265.929
EXG. FORMATION LEVEL OF EXG IR DN MAIN LINE (EFL)	-266.125	-266.126	-266.126	-266.180	-266.195	-266.191	-266.187	-266.192	-266.200	-266.217	-266.228	-266.232	-266.221	-266.188	-266.166	-266.155	-266.158	-266.164	-266.164	-266.164
DIFFERENCE BETWEEN DFC RAIL LEVEL AND EXG. RAIL LEVEL (PRL - ERL)	-0.039	0.045	0.051	0.024	-0.005	0.006	0.017	0.018	0.016	0.006	0.002	0.005	-0.007	0.004	0.004	-0.006	-0.032	-0.169	-0.221	-0.136
DFC RAIL LEVEL (PRL)	-266.836	-266.842	-266.849	-266.856	-266.862	-266.869	-266.875	-266.882	-266.888	-266.895	-266.902	-266.908	-266.896	-266.864	-266.842	-266.820	-266.798	-266.836	-266.867	-266.836
EXG.RAIL LEVEL OF NEAREST IR DN MAIN LINE(ERL)	-266.797	-266.798	-266.798	-266.832	-266.867	-266.863	-266.859	-266.864	-266.872	-266.889	-266.900	-266.904	-266.893	-266.860	-266.838	-266.827	-266.830	-266.836	-266.836	-266.836
EQUIVALENT CHAINAGE ON DFC TRACK	313500.0	313520.0	313540.0	313560.0	313580.0	313600.0	313620.0	313640.0	313660.0	313680.0	313700.0	313720.0	313740.0	313760.0	313780.0	313800.0	313820.0	313840.0	313860.0	313880.0
EXISTING IR CHAINAGE	313500.0	313520.0	313540.0	313560.0	313580.0	313600.0	313620.0	313640.0	313660.0	313680.0	313700.0	313720.0	313740.0	313760.0	313780.0	313800.0	313820.0	313840.0	313860.0	313880.0

L - SECTION

NOTE:-

- DFCC WORKS ARE SHOWN IN RED.
- IR NEW WORKS ARE SHOWN IN VIOLET.
- ALL DIMENSIONS ARE SHOWN IN METRES.
- THIS DRAWING IS PREPARED BASED ON LATEST SURVEY DATA HELD ON APRIL-2022. GTS BENCH MARK OF 261.850M CONSIDERED ON TOP OF CANAL BRIDGE ABUTMENT AT DORAH VILLAGE ALONG THE NH1.
- DFC NEW CHAINAGE OF 1075.950M IS WITH REFERENCE TO THE IR KM OF 187.500KM END OF KM OF CP-303(SECTION P-3 PILKHANI END) AGAINST THE EXISTING DFC CHAINAGE. 116277.742M ISSUED VIDE LETTER NO. COM/DFCC/CH/MS/SURVEY/2021-301-2301/16-01/173 DT. 17.01.2023.
- BALLAST PROFILE HAS BEEN PROVIDED ACCORDING TO THE CLAUSE 1.11.3 OF STANDARD SCHEDULE OF DIMENSION(EASTERN CORRIDOR) & THE BALLAST CUSHION DIMENSION SHOWN IN 35CM ON GE-14 PARA 17. SPECIFICATIONS & RECOMMENDATIONS 2. TWO LAYER SYSTEM FIG.10.

REFERENCE DRAWINGS :-

- FOR KEY PLAN REFER DRAWING NO. 301-2/AL/0001
- FOR LEGEND AND ABBREVIATIONS REFER DRAWING NO. 301-2/AL/1000
- FOR TYPICAL SECTION OF BALLAST PROFILE (FL-RL) REFER DRG. NO. 301-2/TK/TFD/004 (TR.1952)

DRG NO. - 301-2/AL/1253

0	14.09.2024	SUBMISSION OF AS-BUILT DRAWING	FOR APPROVAL
REV.	DATE	REVISION DETAILS	PURPOSE OF ISSUE

LEGEND:

SCALE

HOR - 1:1000

VER - 1:100

SHEET SIZE : A1

TRACK STRUCTURE

RAIL SECTION: 60Kg/m (UIC 60Kg/m)	Difference between FL- RL (Below Rail Seat)	
DFC LINE: 60Kg/m (UIC 60Kg/m)	IR Line	DFC
IR MAIN LINE: 52Kg/m	172mm	172mm
RUBBER PAD	6mm	10mm
SLEEPER DEPTH	210mm	210mm
BALLAST CUSHION	300mm	350mm
Total Depth (FL TO RL)	688mm	742mm

OWNER

DEDICATED FREIGHT CORRIDOR CORPORATION OF INDIA LTD.

(A GOVERNMENT OF INDIA ENTERPRISE)

PROJECT OFFICE (AMBALA UNIT): OLD RAILWAY COLONY (NEAR ANAND MARKET), AMBALA CANTT-133001.

CORPORATE IDENTITY NO. : U60232DL20060G0155068

ENGINEER:

DB Engineering & Consulting GmbH

Deutsche Bahn Engineering & Consulting GmbH

CONTRACTOR:

GIL - TPL JV

GAR TATA

SUBMITTED BY	GIL - TPL JV		
PREPARED BY	DATED	NAME	SIGNATURE
CHECKED BY	14.09.2024	VIJAY PRATAP	
APPROVED BY	14.09.2024	PARASURAM KOTYADA	

APPROVED BY

DEUTSCHE BAHN ENGINEERING & CONSULTING GMBH

DATED	NAME	SIGNATURE
Sr. DE./CHIEF ENGINEER	SURESH K.YALANGI	
CHIEF TRACK ENGINEER	RAJ PAL SINGH	
T.L.	H.D. VIDJAK	

STAMP

AS-BUILT DRAWING

TR. Ref.

ENGINEER Sign.:

EMPLOYER (DFCCIL): DEDICATED FREIGHT CORRIDOR CORPORATION OF INDIA LTD.

AS BUILT DRAWING	
TITLE	AS-BUILT PLAN AND PROFILE
DFCC APPR. NO. -	
ENGG. APPR. NO. -	
DRG. NO. - 301-2/AL/1253	
SHEET NO. : 1 OF 1	
DATE : 14.09.2024	
STATUS	A

FROM IR KM: 313.500 TO 314.000

DFC KM: 1203.005 TO 1203.491

TR.