


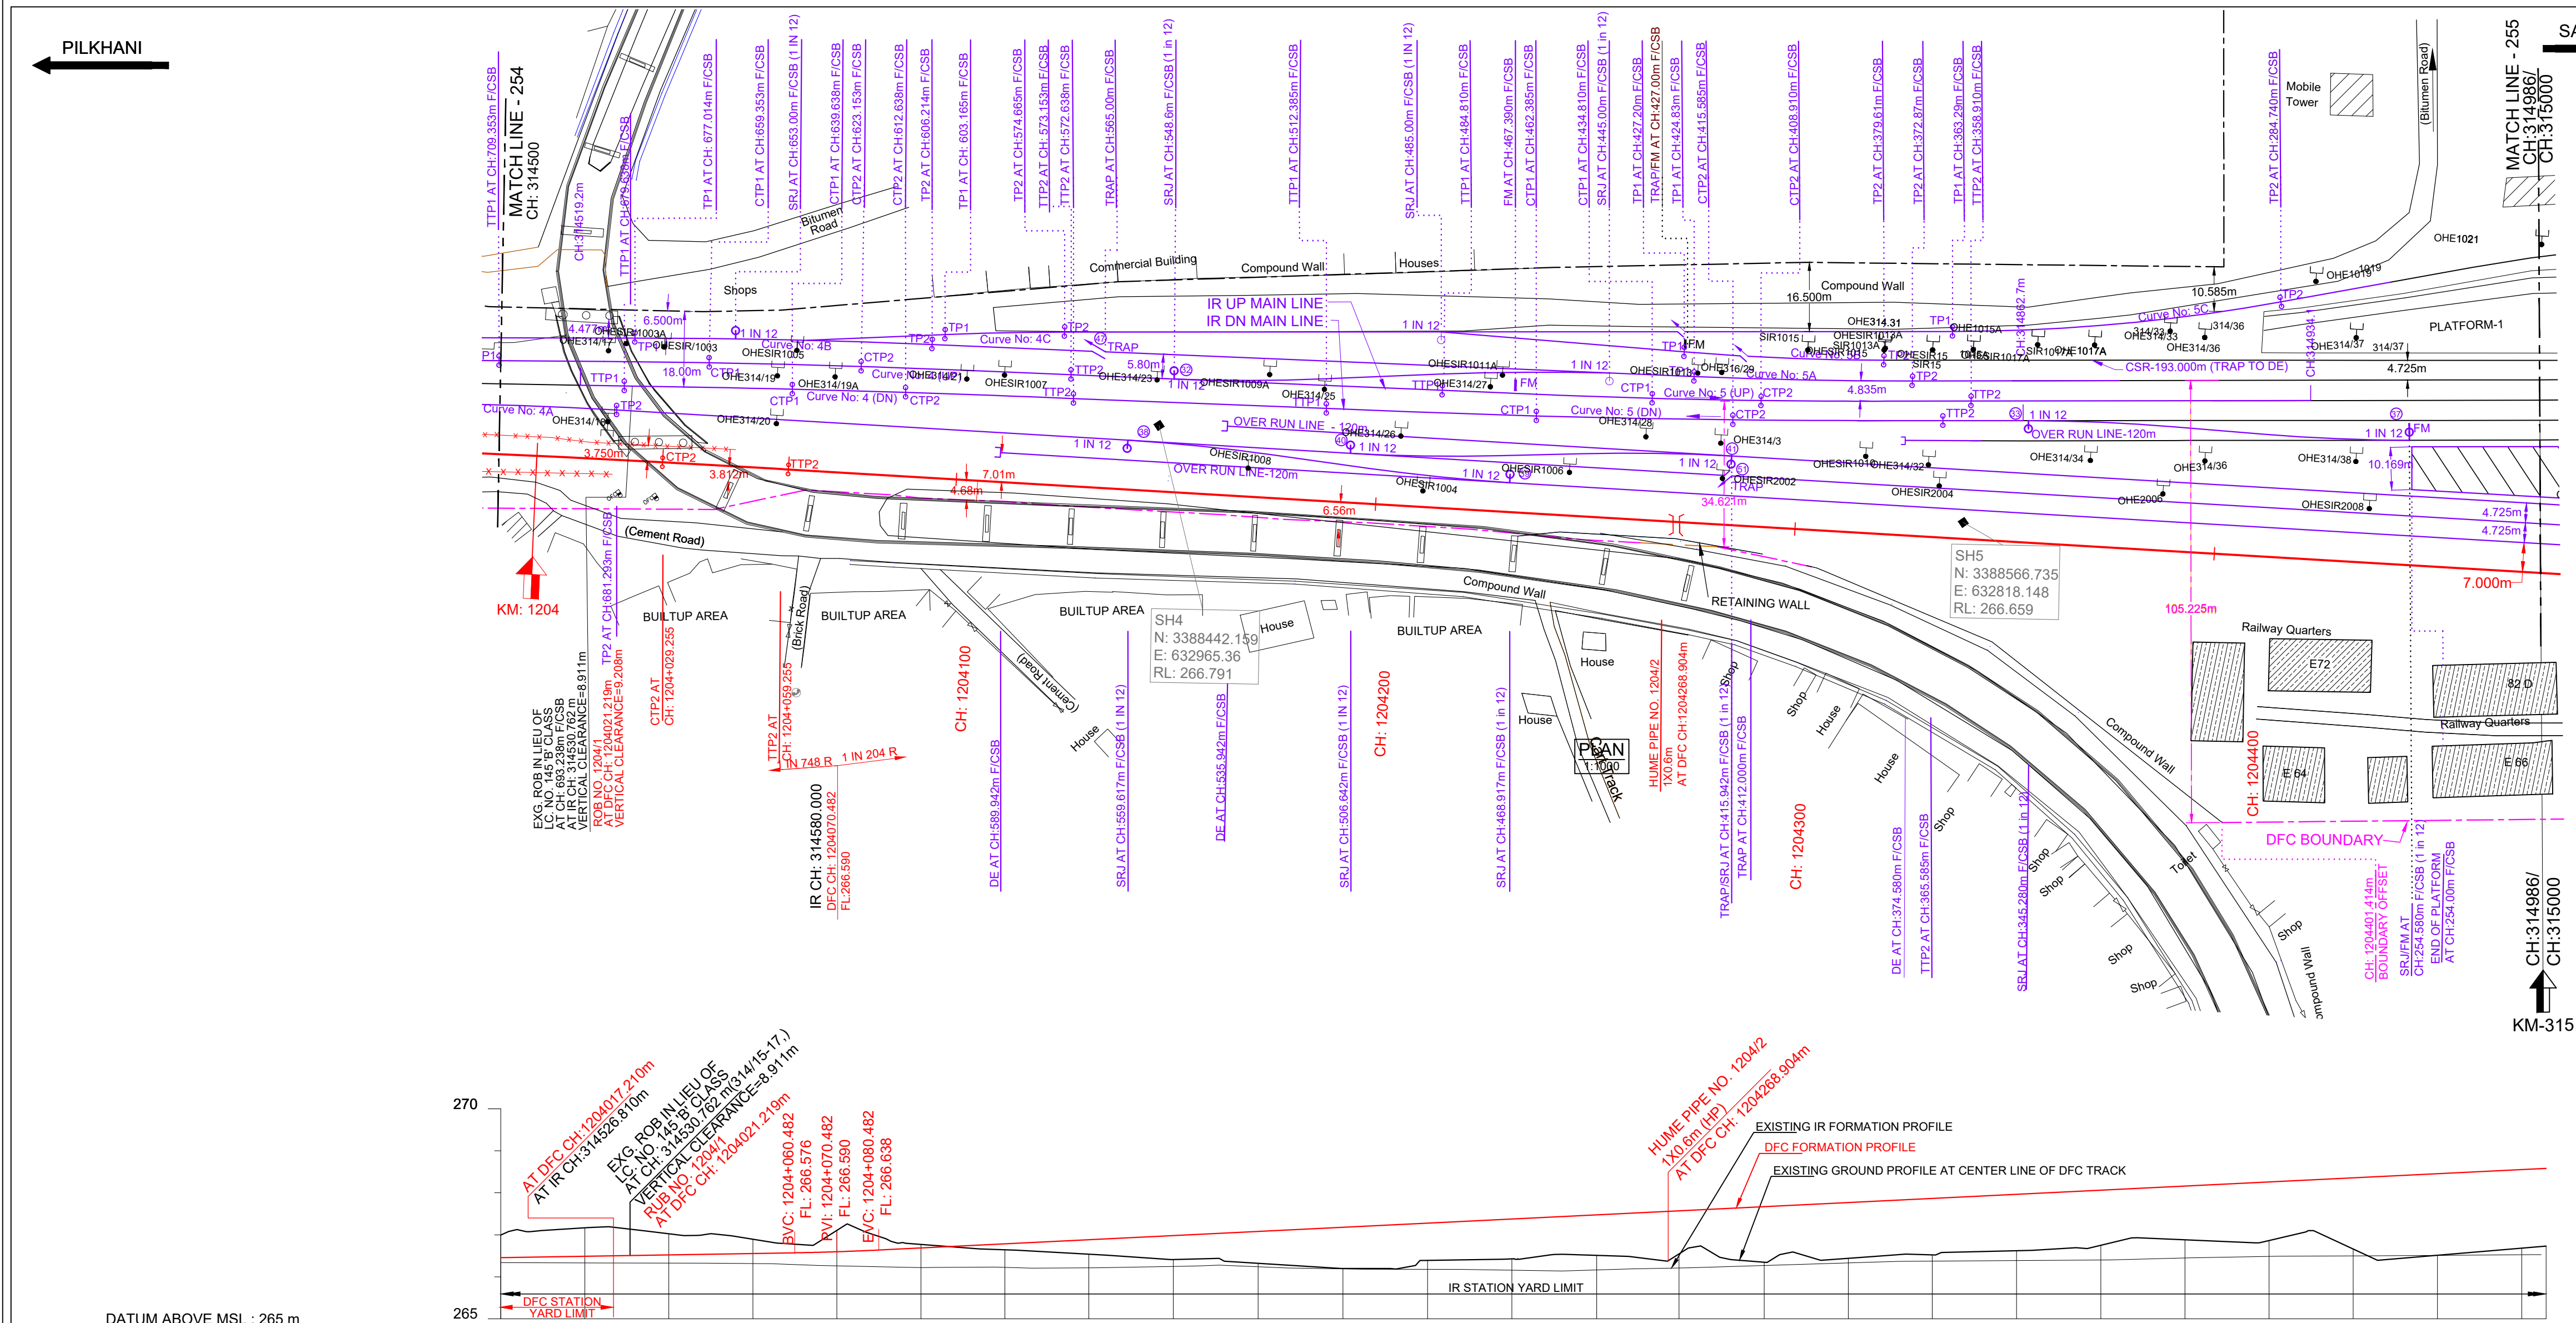

DATUM ABOVE MSL : 265 m

HORIZONTAL ALIGNMENT	TL= 30m L = 654.990m																		
VERTICAL ALIGNMENT	G=1.748.047 L=156.913m L=20.0 m R=5621 m G=1.204.286 R L=1887.555m																		
TRACK DISTANCE FROM EXISTING NEAREST IR DN MAIN LINE TO DFC MAIN LINE	11.479	-11.479	-12.165	-12.880	-13.633	-14.350	-15.070	-15.820	-16.455	-17.169	-17.844	-18.444	-19.119	-19.823	-20.323	-20.897	-21.572	-22.063	-22.656
HEIGHT OF BANKING(+) / DEPTH OF CUTTING(-) (PFL-GL)	-0.536	-0.536	-0.670	-0.503	-0.338	-0.509	-0.085	-0.140	-0.344	-0.568	-0.758	-0.982	-1.199	-1.402	-1.579	-1.734	-1.862	-1.963	-2.038
EXG GROUND LEVEL AT CENTER LINE OF DFC TRACK (GL)	266.992	266.992	267.169	267.026	266.894	267.107	266.773	266.645	266.539	266.413	266.322	266.197	266.082	265.962	265.838	265.714	265.591	265.468	265.345
EXG GROUND LEVEL AT TOE LOCATION OF DFC TRACK	266.964	266.964	267.169	267.101	267.013	266.847	266.684	266.562	266.430	266.315	266.197	266.082	265.962	265.838	265.714	265.591	265.468	265.345	265.222
DIFFERENCE BETWEEN DFC FORMATION LEVEL AND EXG.FORMATION LEVEL (PFL-EFL)	0.117	0.117	0.160	0.198	0.241	0.336	0.488	0.561	0.668	0.733	0.840	0.989	1.100	1.218	1.314	1.361	1.402	1.438	1.463
DFC FORMATION LEVEL (PFL)	266.456	266.456	266.490	266.523	266.556	266.598	266.688	266.785	266.883	266.981	267.080	267.179	267.276	267.376	267.475	267.571	267.666	267.756	267.841
EXG. FORMATION LEVEL OF EXG IR DN MAIN LINE (EFL)	266.339	266.339	266.330	266.325	266.315	266.282	266.220	266.224	266.215	266.248	266.240	266.190	266.178	266.158	266.161	266.210	266.288	266.330	266.339
DIFFERENCE BETWEEN DFC RAIL LEVEL AND EXG. RAIL LEVEL (PRL - ERL)	0.185	0.185	0.220	0.251	0.288	0.368	0.509	0.603	0.710	0.775	0.881	1.030	1.141	1.259	1.355	1.402	1.443	1.479	1.534
DFC RAIL LEVEL (PRL)	267.196	267.196	267.222	267.249	267.276	267.302	267.401	267.498	267.596	267.695	267.794	267.892	267.991	268.089	268.188	268.284	268.383	268.475	268.566
EXG.RAIL LEVEL OF NEAREST IR DN MAIN LINE(ERL)	267.011	267.011	267.002	266.997	266.987	266.934	266.892	266.896	266.887	266.920	266.912	266.862	266.850	266.830	266.833	266.882	266.940	267.003	267.057
EQUIVALENT CHAINAGE ON DFC TRACK	1203990.0	1204010.4	1204030.4	1204050.5	1204070.4	1204090.4	1204110.4	1204130.4	1204150.5	1204170.7	1204190.9	1204210.9	1204231.1	1204251.3	1204270.9	1204291.2	1204311.2	1204331.2	1204351.2
EXISTING IR CHAINAGE	314500.0	314520.0	314540.0	314560.0	314580.0	314600.0	314620.0	314640.0	314660.0	314680.0	314700.0	314720.0	314740.0	314760.0	314780.0	314800.0	314820.0	314840.0	314860.0

L - SECTION

SAHNEWAL



- NOTE:-
1. DFC WORKS ARE SHOWN IN RED.
 2. IR NEW WORKS ARE SHOWN IN VIOLET.
 3. ALL DIMENSIONS ARE SHOWN IN METRES.
 4. THIS DRAWING IS PREPARED BASED ON LATEST SURVEY DATA HELD ON APRIL-2022. GTS BENCH MARK OF 261.85M CONSIDERED ON TOP OF CANAL BRIDGE ABUTMENT AT DORANA VILLAGE ALONG THE NH1.
 5. DFC NEW CHAINAGE OF 1075.950M IS WITH REFERENCE TO THE IR KM OF 187.500KM END OF KM OF CP-303(SECTION P-3 PILKHANI END) AGAINST THE EXISTING DFC CHAINAGE. 116277.742M ISSUED VIDE LETTER NO. COM/DFCC/MB/SURVEY/2021-301-230116-011173.DT. 17.01.2023.
 6. BALLAST PROFILE HAS BEEN PROVIDED ACCORDING TO THE CLAUSE 1.11.3 OF STANDARD SCHEDULE OF DIMENSION(EASTERN CORRIDOR) & THE BALLAST CUSHION DIMENSION SHOWN IN 35CM ON GE-14 PARA 17. SPECIFICATIONS & RECOMMENDATIONS 2. TWO LAYER SYSTEM FIG.10.

- REFERENCE DRAWINGS :-
1. FOR KEY PLAN REFER DRAWING NO. 301-2/AL/0001
 2. FOR LEGEND AND ABBREVIATIONS REFER DRAWING NO. 301-2/AL/1000
 3. FOR TYPICAL SECTION OF BALLAST PROFILE (FL-RL) REFER DRG. NO. 301-2/TK/TFD/004 (TR.1952)

REV.	DATE	REVISION DETAILS	PURPOSE OF ISSUE
0	14.09.2024	SUBMISSION OF AS-BUILT DRAWING	FOR APPROVAL

LEGEND:


SCALE

HOR - 1:1000

VER - 1:100

SHEET SIZE : A1

IR TRACK
DFCC TRACK
DFCC FUTURE PROPOSALS
STRUCTURE / BUILDING
DFCC TOE LINE
DFCC FORMATION
RETAINING WALL
ROAD
STREAM, DRAIN, NALA, CANAL.
FENCE
POWER LINES
TBM
ELECTRIC POLE/OHE MAST
IR RAILWAY BOUNDARY
DFCC BOUNDARY

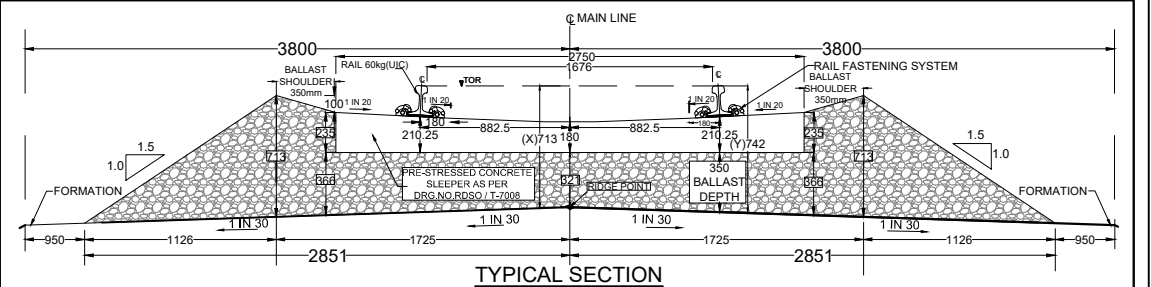

TRACK STRUCTURE		
RAIL SECTION: 60Kg/m (UIC 60Kg/m) DFC LINE: 60Kg/m (UIC 60Kg/m) IR MAIN LINE: 52Kg/m	Difference between FL- RL (Below Rail Seat)	
	IR Line	DFC
RUBBER PAD	172mm	172mm
SLEEPER DEPTH	6mm	10mm
BALLAST CUSHION	210mm	210mm
Total Depth (FL TO RL)	688mm	742mm

OWNER: DEDICATED FREIGHT CORRIDOR CORPORATION OF INDIA LTD. (A GOVERNMENT OF INDIA ENTERPRISE)
PROJECT OFFICE (AMBALA UNIT): OLD RAILWAY COLONY (NEAR ANAND MARKET), AMBALA CANTT-133001.
CORPORATE IDENTITY NO. : U60232DL2006GG01155068

ENGINEER: DB Engineering & Consulting GmbH
Deutsche Bahn Engineering & Consulting GmbH

CONTRACTOR: GIL - TPL JV
GAR TATA

SUBMITTED BY	GIL - TPL JV		
PREPARED BY	DATED	NAME	SIGNATURE
CHECKED BY	14.09.2024	VIJAY PRATAP	
APPROVED BY	14.09.2024	PARASURAM KOTYADA	

APPROVED BY	DEUTSCHE BAHN ENGINEERING & CONSULTING GMBH		
Sr. DE./CHIEF ENGINEER	DATED	NAME	SIGNATURE
CHIEF TRACK ENGINEER		SURESH K.YALANGI	
T.L.		RAJ PAL SINGH	
		H.D. VIDJAK	

STAMP	A AS-BUILT DRAWING TR. Ref:..... ENGINEER Sign.:.....		
EMPLOYER (DFCCIL):	DEDICATED FREIGHT CORRIDOR CORPORATION OF INDIA LTD.		

AS BUILT DRAWING			
TITLE	AS-BUILT PLAN AND PROFILE	DFCC APPR. NO. -	
	FROM IR KM: 314.500 TO 315.000	ENGG. APPR. NO. -	
	DFC KM: 1203.990 TO 1204.477	DRG. NO. - 301-2/AL/A/1255	
		SHEET NO. : 1 OF 1	STATUS
		DATE : 14.09.2024	A

TR.