




DEDICATED FREIGHT CORRIDOR CORPORATION OF INDIA LTD.
(A GOVERNMENT OF INDIA ENTERPRISE)

EASTERN DEDICATED FREIGHT CORRIDOR
SAHNEWAL TO PILKHANI SECTION
CONTRACT PACKAGE - 301

PLAN & PROFILE OF AS BUILT DRAWINGS FOR DFC MAIN LINE

IR CHAINAGE FROM 315.000 KM TO 315.260.4 KM
DFCC CHAINAGE FROM KM 1204.477 TO KM 1204.738
(DETOUR CHAINAGE FROM KM 1204.738 TO KM 1209.405)

DESIGN CONSULTANT


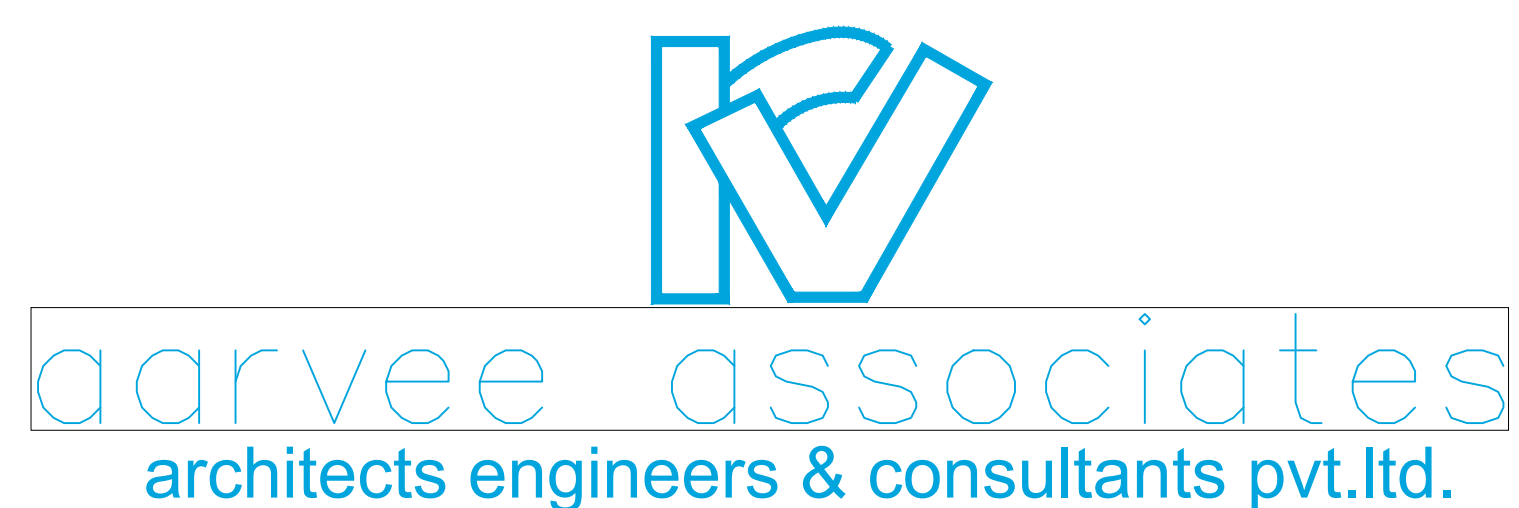


ENGINEER



CONTRACTOR CLIENT
GIL - TPL JV



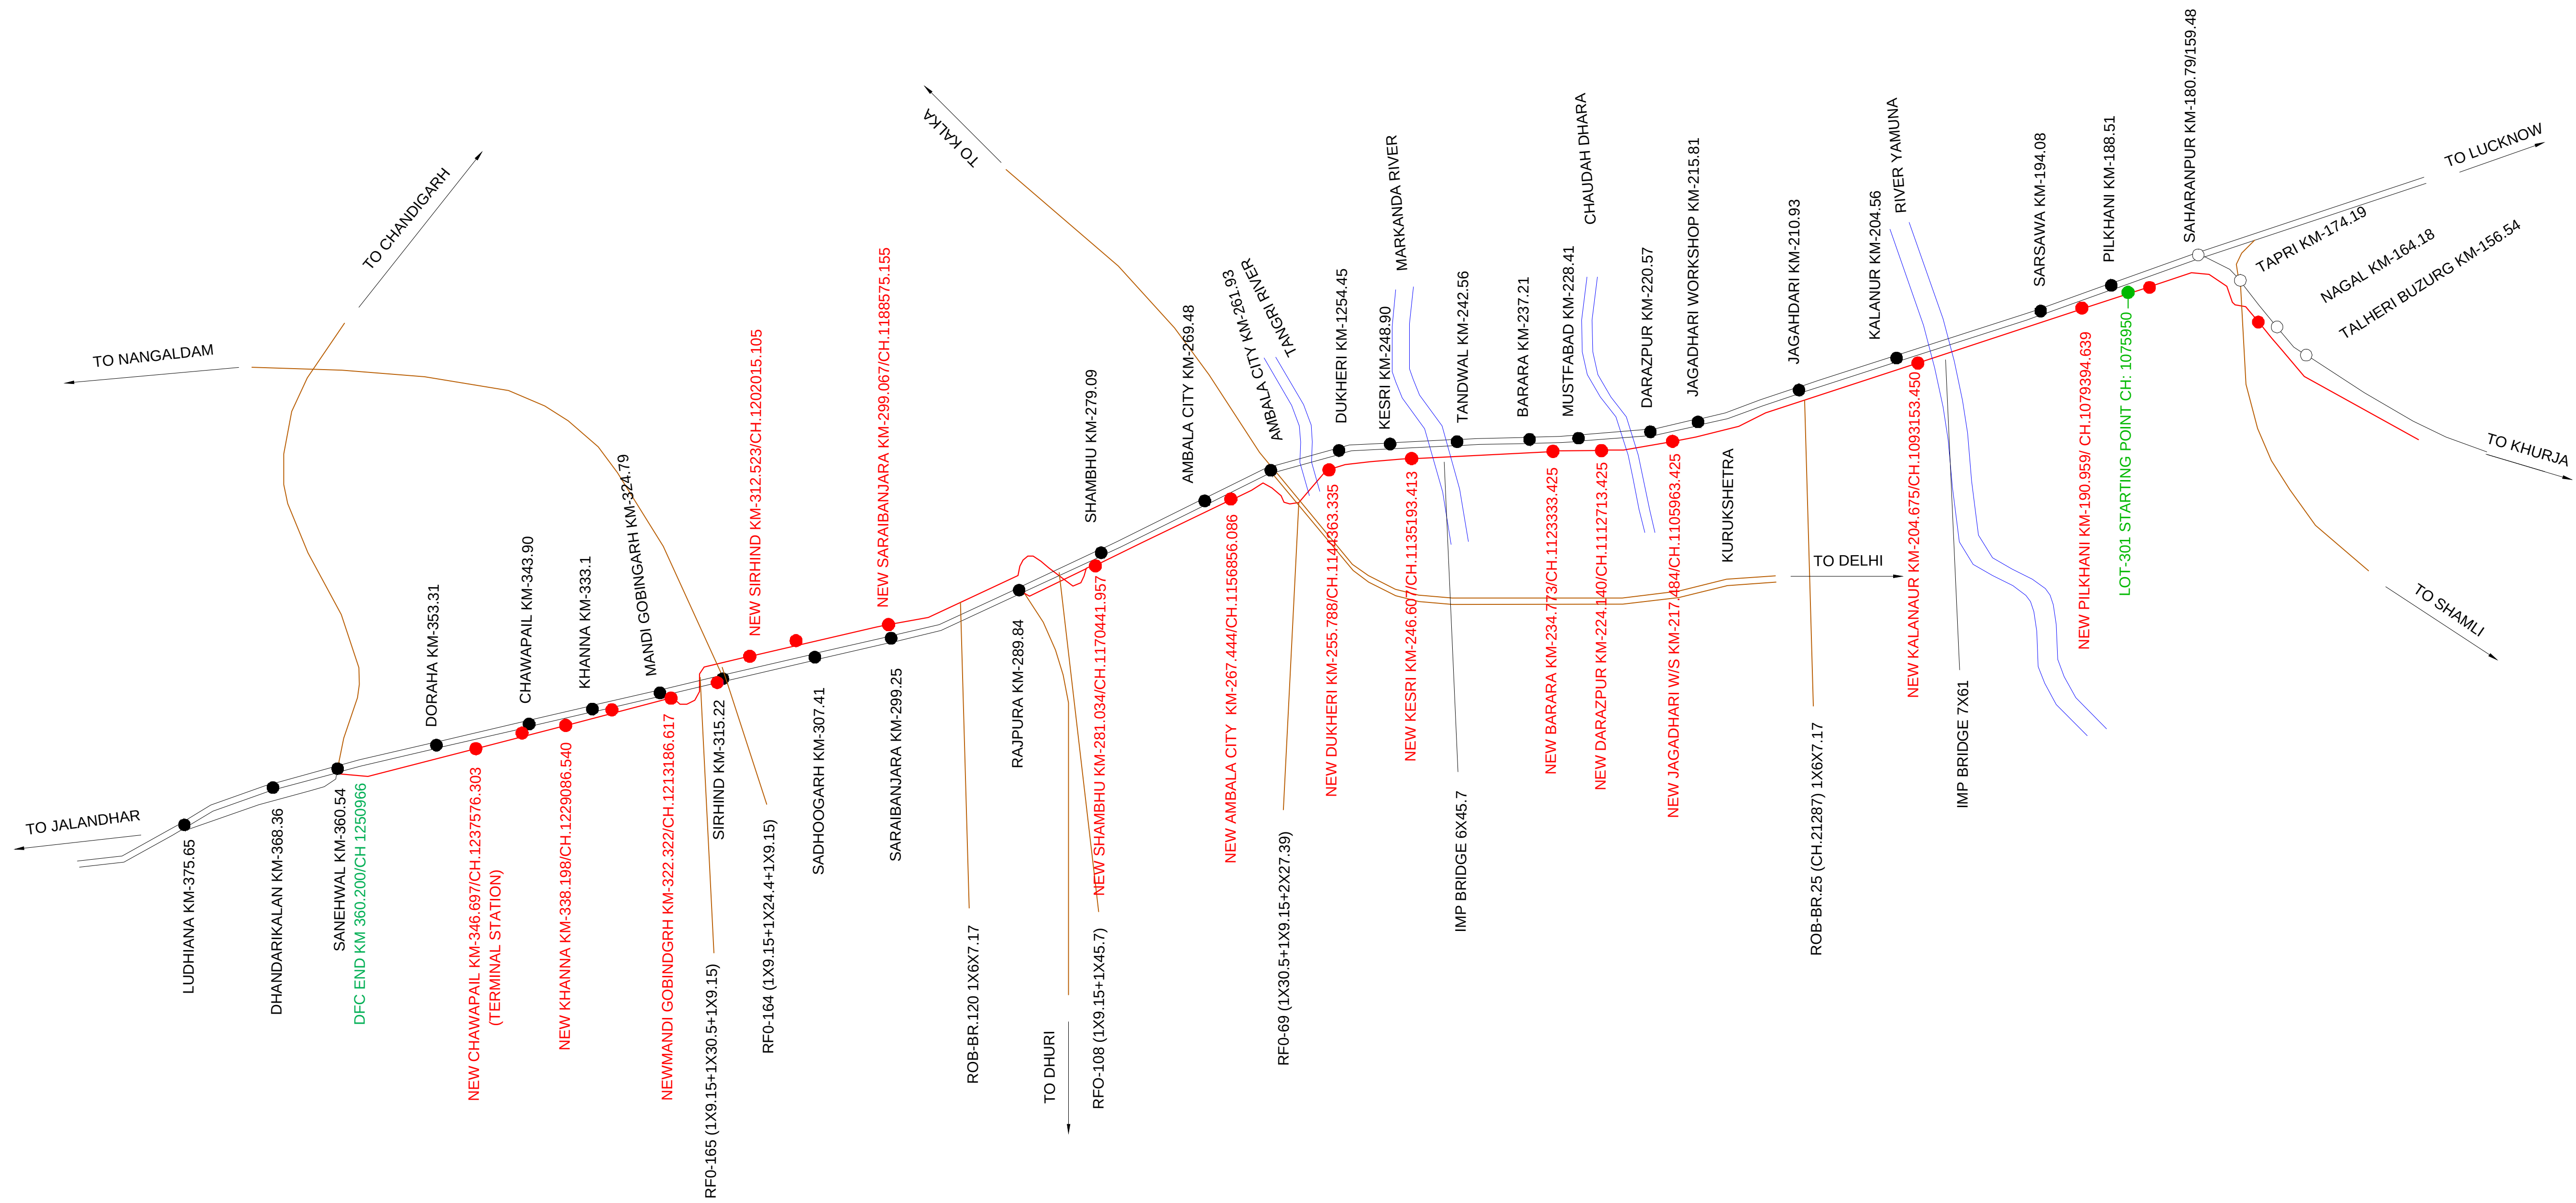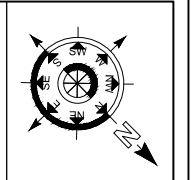

				SCALE NOT TO SCALE	DESIGN CONSULTANT  aarvee associates architects engineers & consultants pvt.ltd.	CONTRACTOR  GIL - TPL JV	ENGINEER  DB Engineering & Consulting GmbH	OWNER  डेडीकेटेड फ्रीट कॉरिडोर	PROJECT DEDICATED FREIGHT CORRIDOR CORPORATION OF INDIA LTD. (A GOVERNMENT OF INDIA ENTERPRISE) PROJECT OFFICE(AMBALA UNIT): OLD RAILWAY COLONY (NEAR ANAND MARKET),AMBALA CANTT-133001. CORPORATE IDENTITY NO. : U60232DL2006GOI155068	TITLE EASTERN DEDICATED FREIGHT CORRIDOR SAHNEWAL TO PILKHANI CONTRACT PACKAGE - 301	ALIGNMENT DRAWINGS KEY PLAN	DFCC APPR. NO. -						
ENGG. APPR. NO. -																		
DRG. NO. - 301-2/AL/0001																		
REV.	DATE	REVISION DETAILS									PURPOSE OF ISSUE							
SHEET NO.: 1 OF 1															REV. No.	STATUS		
DATE: 15-06-2024															0	A		

LEGEND

EXISTING IR TRACK	
DFC TRACK	
DFC FUTURE PROPOSALS	
IR PROPOSALS	
TOE LINE	
FORMATION CESS	
RETAINING WALL	
DRAIN CUM RETAINING WALL	
ROAD	
STREAM, DRAIN, NALA, CANAL.	
FENCE	
POWER LINES	
GPS POINTS	
ELECTRIC POLE/OHE MAST	
EXISTING RAILWAY BOUNDARY	
DFC BOUNDARY	
DISMANTLED WORKS	
IOCL PIPE LINE	
IOCL ROW	
SIGNALLING CABLE PIPE	

ABBREVIATIONS


1.	BL	-	BED LEVEL
2.	BVC	-	BEGIN OF VERTICAL CURVE
3.	Ca	-	APPLIED CANT
4.	CCL	-	CIRCULAR CURVE LENGTH
5.	CTP1	-	COMMON TANGENT POINT
6.	CTP2	-	COMMON TANGENT POINT
7.	DEGREE	-	DEGREE OF CURVE
8.	DE	-	DEAD END
9.	ECL	-	EXISTING CLEARANCE
10.	EFB	-	EXISTING FREE BOARD
11.	EFL	-	EXISTING FORMATION LEVEL
12.	ERL	-	EXISTING RAIL LEVEL
13.	ESL	-	EXISTING SOFFIT LEVEL
14.	EVC	-	END OF VERTICAL CURVE
15.	EVCL	-	EXISTING VERTICAL CLEARANCE
16.	F/CSB	-	FROM CENTER LINE OF STN BLDG
17.	FM	-	FOULING MARK
18.	FSL	-	FULL SUPPLY LEVEL
19.	HFL	-	HIGH FLOOD LEVEL
20.	L	-	STRAIGHT LENGTH
21.	LH	-	LEFT HANDED
22.	LHS	-	LIMITED HEIGHT SUBWAY
23.	PCL	-	PROPOSED CLEARANCE
24.	PFB	-	PROPOSED FREE BOARD
25.	PFL	-	PROPOSED FORMATION LEVEL
26.	PRL	-	PROPOSED RAIL LEVEL
27.	PSL	-	PROPOSED SOFFIT LEVEL
28.	PVCL	-	PROPOSED VERTICAL CLEARANCE
29.	PVI	-	POINT OF VERTICAL INTERSECTION
30.	R	-	RADIUS
31.	REV.BL	-	REVISED BED LEVEL
32.	RH	-	RIGHT HANDED
33.	Rr	-	RESULTANT RADIUS
34.	SE	-	SUPER ELEVATION
35.	SRJ	-	STOCK RAIL JOINT
36.	TS	-	TRAP SWITCH
37.	TTL	-	TOTAL TANGENT LENGTH
38.	TTP1	-	TRANSITION TANGENT POINT
39.	TTP2	-	TRANSITION TANGENT POINT
40.	TL	-	TRANSITION LENGTH
41.	DELTA	-	DEFLECTION ANGLE

[illegible]

PILKHANI

EXISTING RAILWAY BOUNDARY

SAHNEWAL

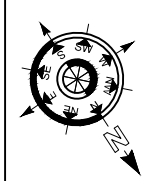

NOTE:-

1. DFCC WORKS ARE SHOWN IN RED.
2. IR NEW WORKS ARE SHOWN IN VIOLET.
3. ALL DIMENSIONS ARE SHOWN IN METRES.
4. THIS DRAWING IS PREPARED BASED ON LATEST SURVEY DATA HELD ON APRIL-2022. GTS BENCH MARK OF 261.850M CONSIDERED ON TOP OF CANAL BRIDGE ABUTMENT AT DORANA VILLAGE ALONG THE NH1.
5. DFC NEW CHAINAGE OF 1075.950M IS WITH REFERENCE TO THE IR KM OF 187.500KM END OF KM OF CP-303(SECTION P-3 PILKHANI END) AGAINST THE EXISTING DFC CHAINAGE. 116277.742M ISSUED VIDE LETTER NO. COM/DFCC/UMS/SURVEY/2021-301-2301/16-01/173.DT. 17.01.2023
6. BALLAST PROFILE HAS BEEN PROVIDED ACCORDING TO THE CLAUSE 1.11.3 OF STANDARD SCHEDULE OF DIMENSION(EASTERN CORRIDOR) & THE BALLAST CUSHION DIMENSION SHOWN IN 35CM ON GE-14 PARA 17. SPECIFICATIONS & RECOMMENDATIONS 2. TWO LAYER SYSTEM FIG.10.

DRG NO.-301-2/AL/A/1255A

REFERENCE DRAWINGS :-

1. FOR KEY PLAN REFER DRAWING NO. 301-2/AL/0001
2. FOR LEGEND AND ABBREVIATIONS REFER DRAWING NO. 301-2/AL/1000
3. FOR TYPICAL SECTION OF BALLAST PROFILE (FL-RL) REFER DRG. NO. 301-2/TK/TFD/004 (TR.1952)


REV.	DATE	REVISION DETAILS	PURPOSE OF ISSUE
0	18.09.2024	SUBMISSION OF AS-BUILT DRAWING	FOR APPROVAL

LEGEND:

IR TRACK
DFCC TRACK
DFCC FUTURE PROPOSALS
STRUCTURE / BUILDING
DFCC TOE LINE
DFCC FORMATION
RETAINING WALL
ROAD
STREAM, DRAIN, NALA, CANAL.
FENCE
POWER LINES
TBM
ELECTRIC POLE/OHE MAST
IR RAILWAY BOUNDARY
DFCC BOUNDARY

SCALE

HOR - 1:1000
VER - 1:100
SHEET SIZE : A1

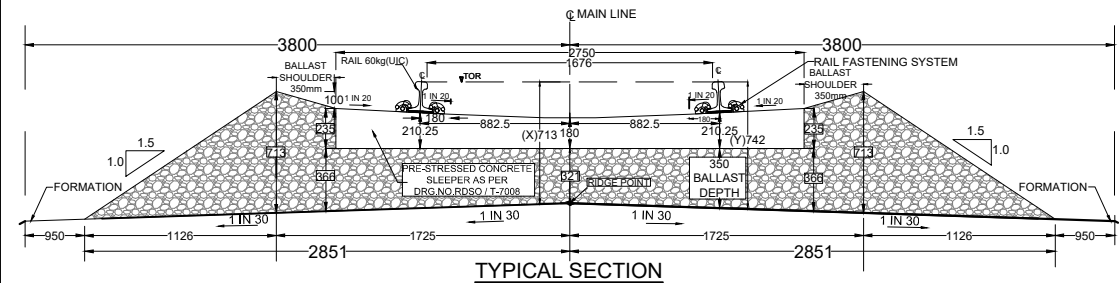

TRACK STRUCTURE		
RAIL SECTION: 60Kg/m (UIC 60Kg/m) DFC LINE: 60Kg/m (UIC 60Kg/m) IR MAIN LINE: 52Kg/m	Difference between FL- RL (Below Rail Seat)	
	IR Line	DFC
RUBBER PAD	172mm	172mm
SLEEPER DEPTH	6mm	10mm
BALLAST CUSHION	210mm	210mm
	300mm	350mm
Total Depth (FL TO RL)	688mm	742mm

OWNER
DEDICATED FREIGHT CORRIDOR CORPORATION OF INDIA LTD.
(A GOVERNMENT OF INDIA ENTERPRISE)
PROJECT OFFICE(AMBALA UNIT): OLD RAILWAY COLONY (NEAR ANAND MARKET),AMBALA CANTT.-133001.
CORPORATE IDENTITY NO. : U60232DL2006GGI155068



ENGINEER:
DB Engineering & Consulting GmbH
Deutsche Bahn Engineering & Consulting GmbH

CONTRACTOR:
GIL - TPL JV
GAR TATA

GIL - TPL JV			
SUBMITTED BY	DATED	NAME	SIGNATURE
PREPARED BY	18.09.2024	VIJAY PRATAP	
CHECKED BY	18.09.2024	PARASURAM KOTYADA	
APPROVED BY	DEUTSCHE BAHN ENGINEERING & CONSULTING GMBH		
	DATED	NAME	SIGNATURE
Sr. DE./CHIEF ENGINEER		SURESH K.YALANGI	
CHIEF TRACK ENGINEER		RAJ PAL SINGH	
T.L.		H.D. VIDJAK	

STAMP	A AS-BUILT DRAWING TR. Ref..... ENGINEER Sign.:		
	EMPLOYER (DFCCIL): DEDICATED FREIGHT CORRIDOR CORPORATION OF INDIA LTD.		

AS BUILT DRAWING			
TITLE AS-BUILT PLAN AND PROFILE FROM IR KM: 315.000 TO 315.260 DFC KM:1204.477 TO 1204.905 (DETOUR START FROM KM:1204.738)		DFCC APPR. NO. - ENGG. APPR. NO. - DRG. NO. -301-2/AL/A/1255A SHEET NO. : 1 OF 1 DATE : 18.09.2024	STATUS A

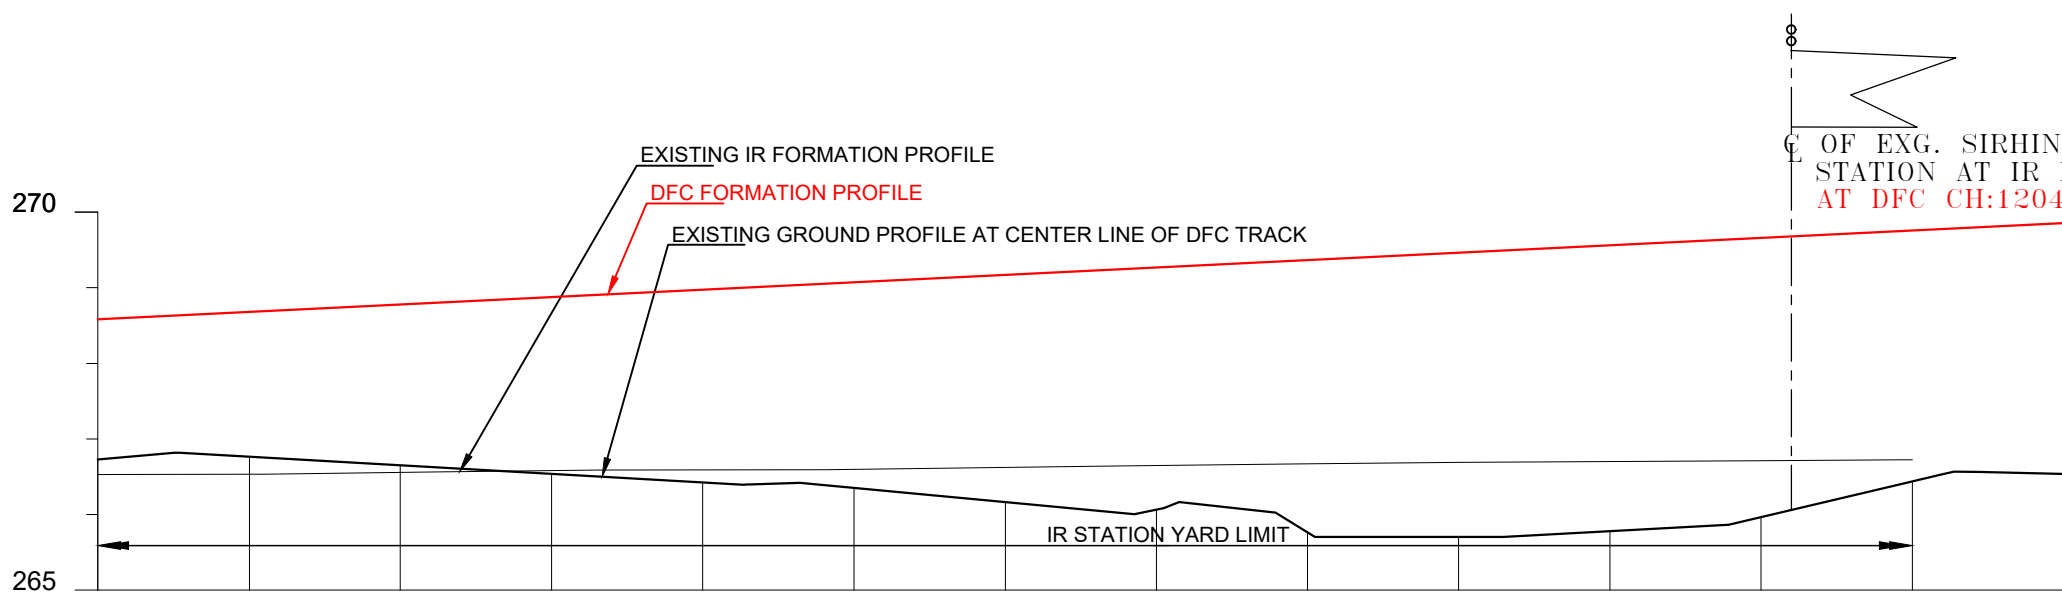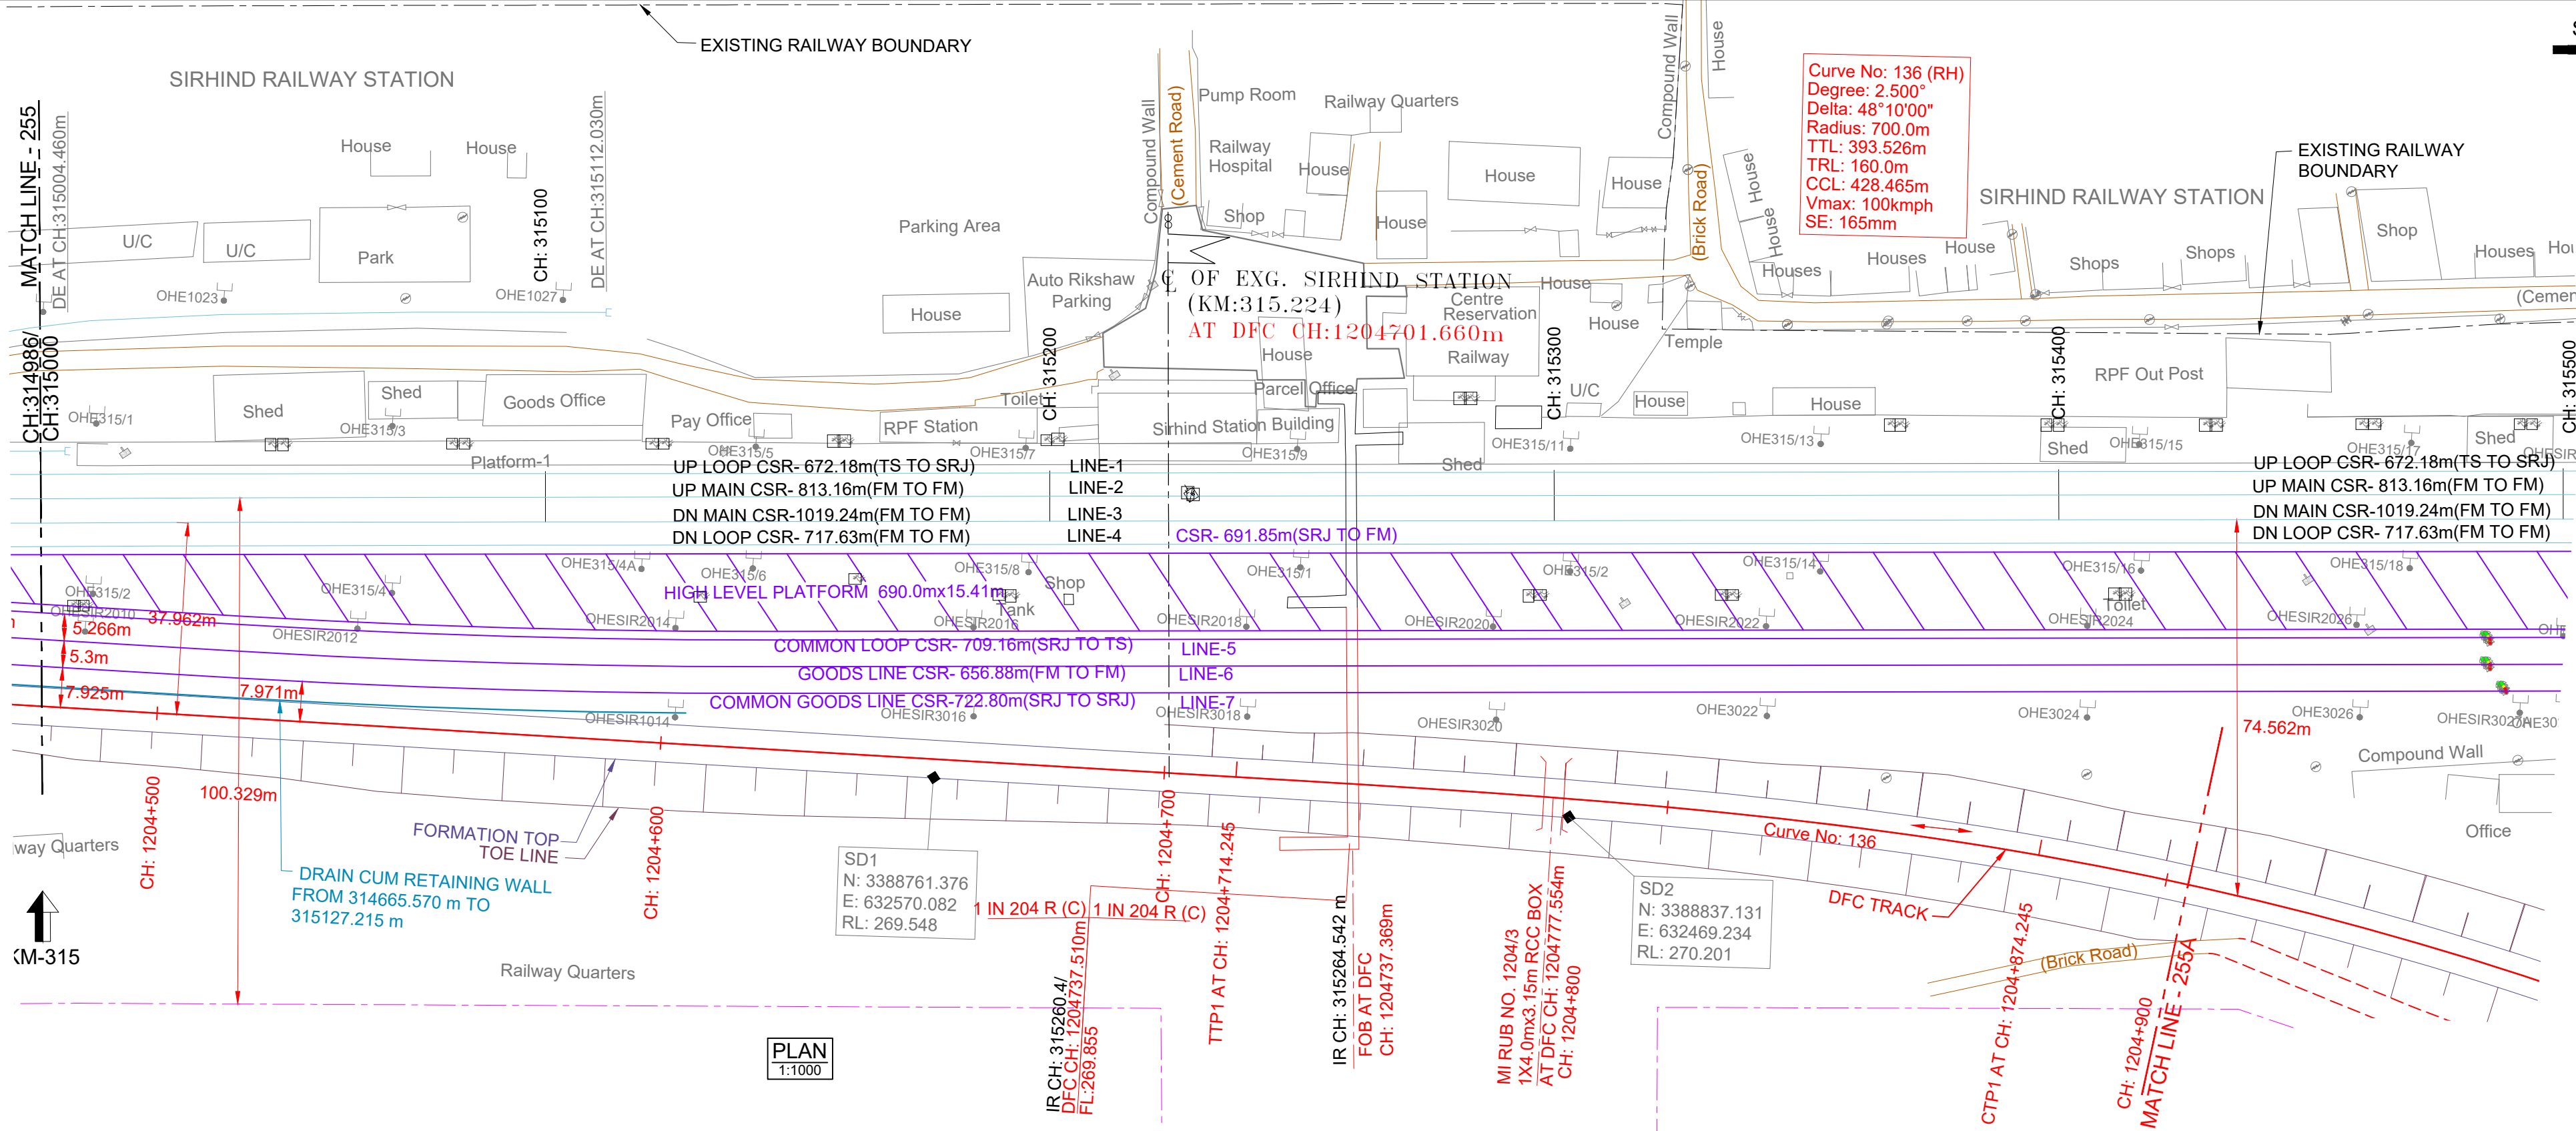

DATUM ABOVE MSL : 265 m

HORIZONTAL ALIGNMENT	L = 654.990m TL= 160m															
VERTICAL ALIGNMENT	L=1887.555 m 1 IN 204.286 R															
TRACK DISTANCE FROM EXISTING NEAREST IR DN MAIN LINE TO DFC MAIN LINE	36.342	37.618	38.837	40.057	41.288	42.478	43.692	44.902	46.106	47.310	48.516	49.721	50.920	52.140	53.349	54.548
HEIGHT OF BANKING(+)/ DEPTH OF CUTTING(-) (PFL-GL)	+1.851	+1.913	+2.125	+2.337	+2.549	+2.718	+3.006	+3.201	+3.610	+3.758	+3.780	+3.689	+3.312	+3.319	+3.319	+3.319
EXG GROUND LEVEL AT CENTER LINE OF DFC TRACK (GL)	266.730	266.766	266.652	266.538	266.424	266.353	266.163	266.066	265.755	265.340	265.705	265.970	266.445	266.536	266.536	266.536
EXG GROUND LEVEL AT TOE LOCATION OF DFC TRACK	265.628	265.276	265.047	264.495	264.180	264.210	264.314	264.506	264.884	265.340	265.796	266.251	266.512	266.464	266.464	266.464
DIFFERENCE BETWEEN DFC FORMATION LEVEL AND EXG.FORMATION LEVEL(PFL-EFL)	2.051	2.145	2.221	2.295	2.384	2.474	2.546	2.620	2.696	2.771	2.858	2.946	3.031	3.120	3.120	3.120
DFC FORMATION LEVEL (PFL)	268.581	268.679	268.777	268.875	268.973	269.071	269.169	269.267	269.365	269.463	269.561	269.659	269.757	269.855	269.855	269.855
EXG. FORMATION LEVEL OF EXG IR DN MAIN LINE (EFL)	266.530	266.534	266.556	266.580	266.589	266.597	266.623	266.647	266.669	266.692	266.703	266.713	266.726	266.737	266.737	266.737
DIFFERENCE BETWEEN DFC RAIL LEVEL AND EXG. RAIL LEVEL (PRL - ERL)	2.092	2.187	2.261	2.336	2.425	2.515	2.588	2.661	2.737	2.812	2.900	2.987	3.073	3.161	3.161	3.161
DFC RAIL LEVEL (PRL)	269.204	269.302	269.49	269.588	269.686	269.784	269.882	269.98	270.078	270.176	270.274	270.372	270.471	270.570	270.570	270.570
EXG.RAIL LEVEL OF NEAREST IR DN MAIN LINE(ERL)	267.202	267.206	267.228	267.252	267.261	267.269	267.295	267.319	267.341	267.364	267.375	267.385	267.398	267.409	267.409	267.409
EQUIVALENT CHAINAGE ON DFC TRACK	1204477.3	1204497.3	1204517.2	1204537.3	1204557.3	1204577.3	1204597.4	1204617.4	1204637.4	1204657.5	1204677.5	1204697.5	1204717.6	1204737.9	1204757.9	1204777.9
EXISTING IR CHAINAGE	314985.7	315000.0	315020.0	315040.0	315060.0	315080.0	315100.0	315120.0	315140.0	315160.0	315180.0	315200.0	315220.0	315240.0	315260.0	315280.0


L - SECTION

DATUM ABOVE MSL : 265 m

HORIZONTAL ALIGNMENT	TL = 160m R =700m															
VERTICAL ALIGNMENT	L=1887.555 m 1 IN 204.286 R															
HEIGHT OF BANKING(+)/ DEPTH OF CUTTING(-) (PFL-GL)	+3.321	+3.370	+3.513	+3.610	+3.699	+3.796	+3.903	+4.297	+4.555	+4.471						
EXG GROUND LEVEL AT CENTER LINE OF DFC TRACK (GL)	266.536	266.520	266.474	266.475	266.484	266.485	266.476	266.180	266.020	266.202						
DFC FORMATION LEVEL (PFL)	269.857	269.890	269.988	270.085	270.183	270.281	270.379	270.477	270.575	270.673						
DFC RAIL LEVEL (PRL)	270.570	270.603	270.701	270.798	270.896	270.994	271.092	271.190	271.288	271.386						
DFC TRACK CHAINAGE	1204737.9	1204744.6	1204764.6	1204784.6	1204804.6	1204824.6	1204844.6	1204864.6	1204884.6	1204904.6						



L - SECTION FOR DETOUR

TR.

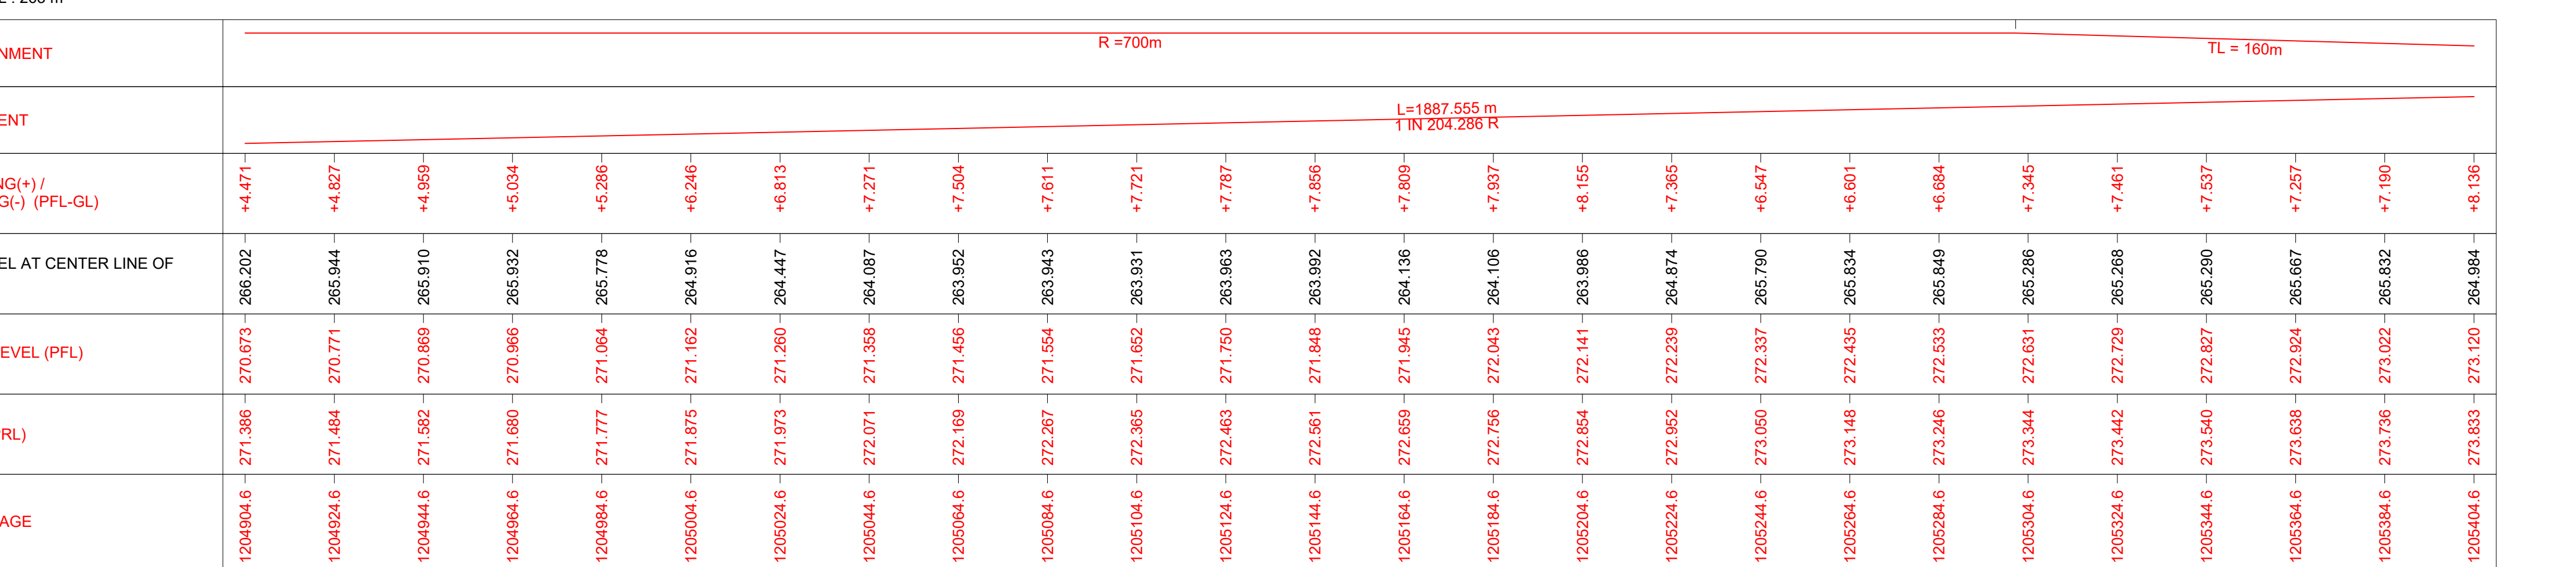

AS BUILT DRAWING		
TITLE AS-BUILT PLAN AND PROFILE DFC KM:1204.905 TO 1205.405 (DETOUR)	DFCC APPR. NO. -	STATUS A
	ENGG. APPR. NO. -	
	DRG. NO. -301-2/AL/A/1255B	
	SHEET NO. : 1 OF 1	
	DATE : 18.09.2024	

TR.

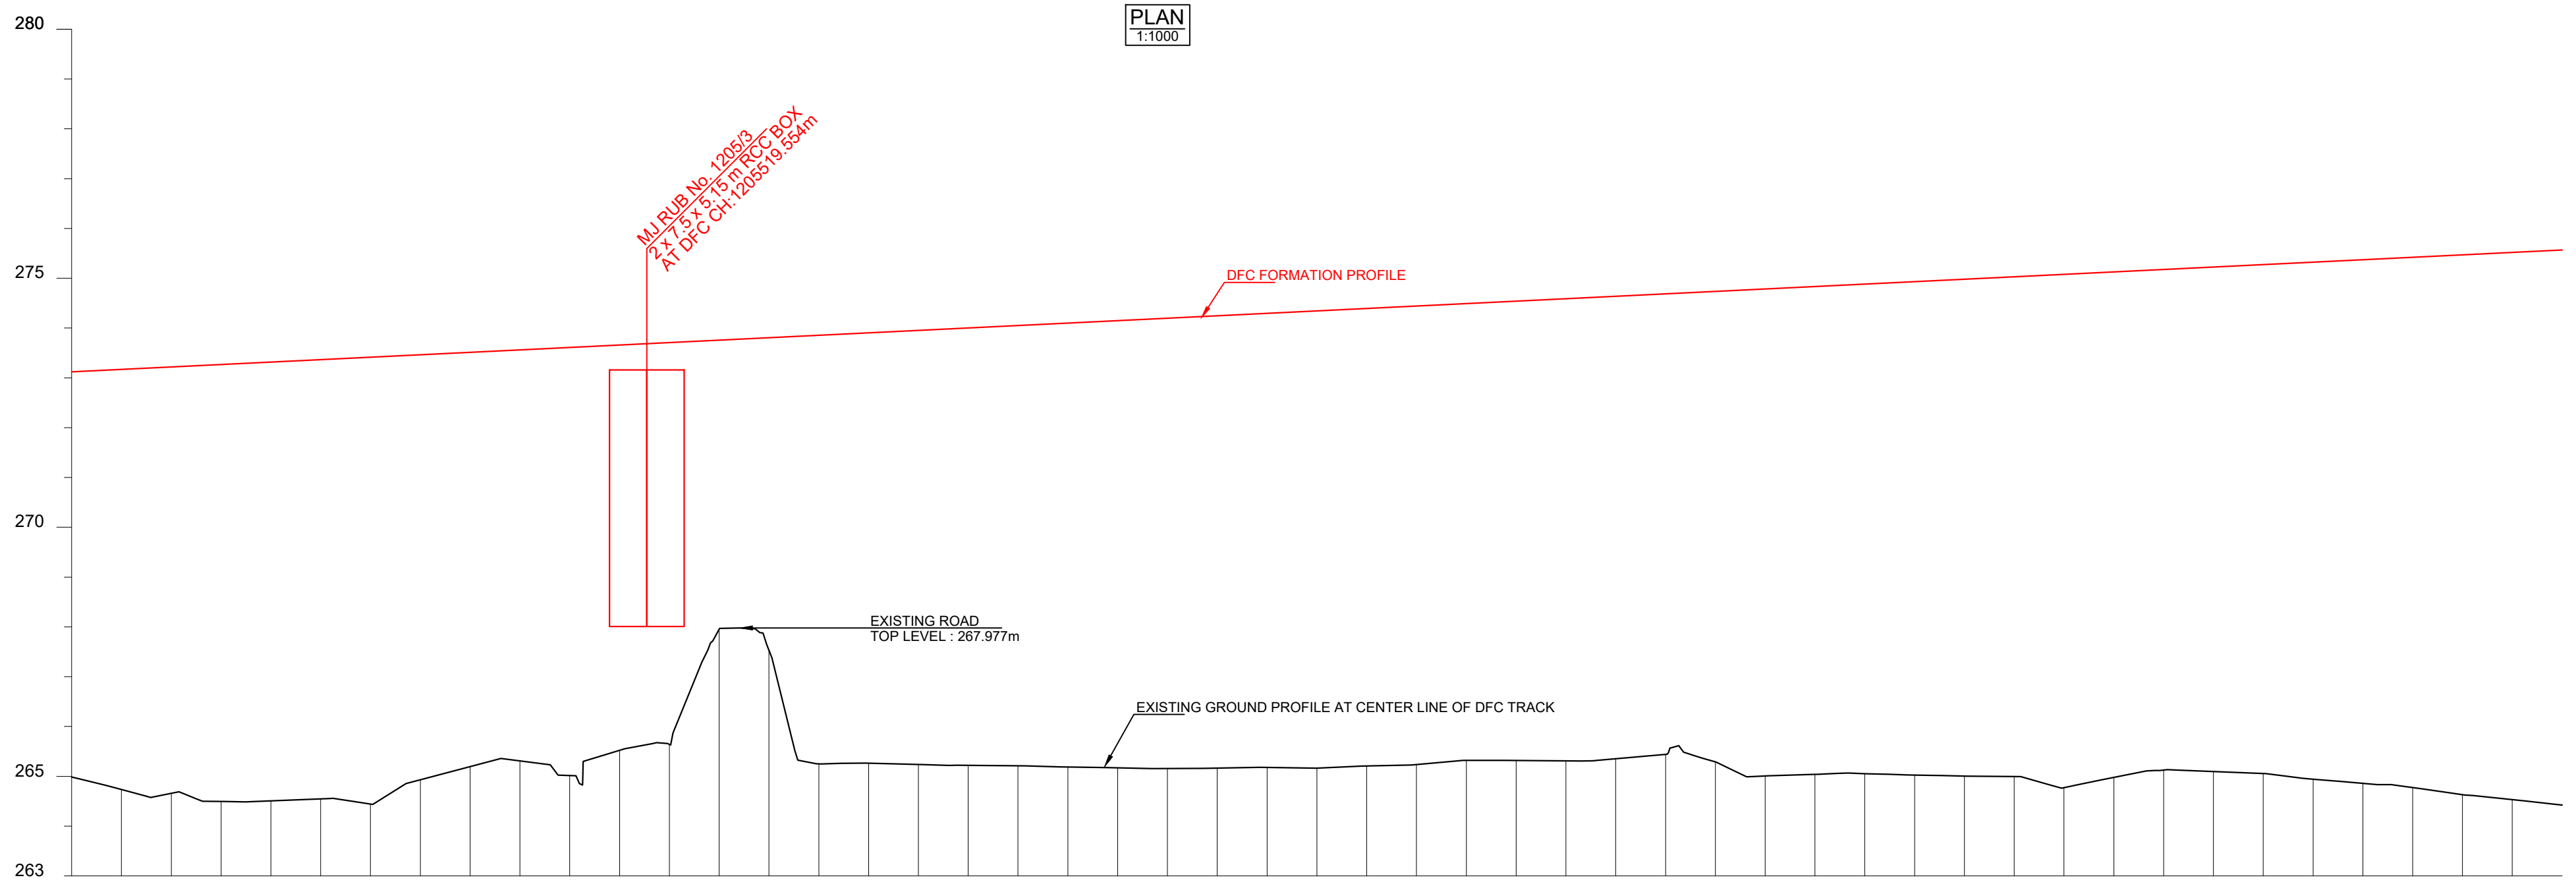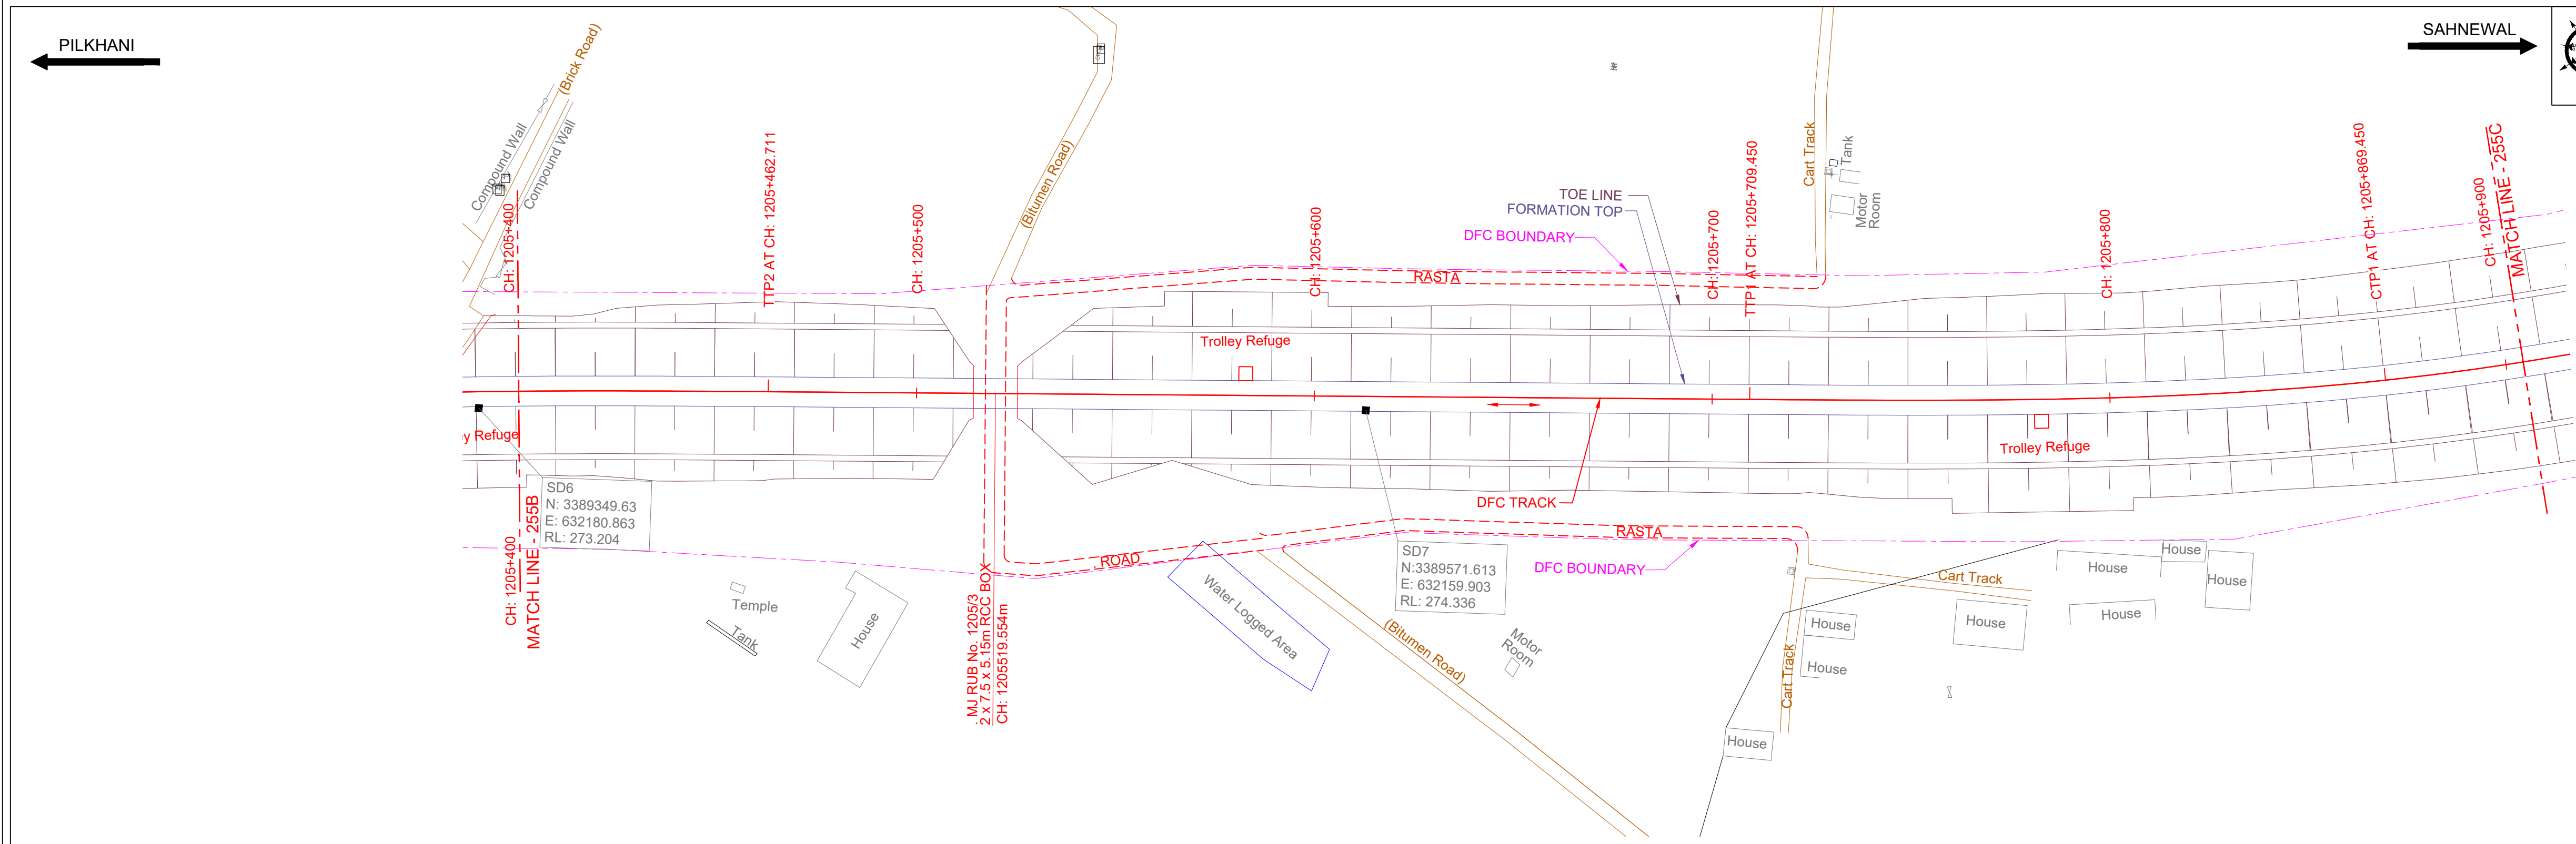

HORIZONTAL ALIGNMENT	TL = 160m L = 246.740m TL = 160m R = 700m																			
VERTICAL ALIGNMENT	L=1887.555 m 1 IN 204.286 R																			
HEIGHT OF BANKING(+) / DEPTH OF CUTTING(-) (PFL-GL)	+8.136	+8.559	+8.808	+8.972	+8.316	+8.595	+8.067	+6.276	+8.640	+8.782	+8.912	+9.041	+9.118	+9.187	+9.170	+9.281	+9.246	+9.779	+9.828	+9.975
EXG GROUND LEVEL AT CENTER LINE OF DFC TRACK (GL)	264.984	264.659	264.508	264.442	265.196	265.015	265.641	267.530	265.263	265.219	265.187	265.156	265.177	265.206	265.321	265.308	265.441	265.006	265.054	265.005
DFC FORMATION LEVEL (PFL)	273.120	273.218	273.316	273.414	273.512	273.610	273.708	273.806	273.903	274.001	274.099	274.197	274.295	274.393	274.491	274.589	274.687	274.785	274.882	274.980
DFC RAIL LEVEL (PRL)	273.033	273.031	274.029	274.127	274.225	274.323	274.421	274.519	274.617	274.715	274.812	274.910	275.008	275.106	275.204	275.302	275.400	275.498	275.596	275.694
DFC TRACK CHAINAGE	1205404.6	1205424.6	1205444.6	1205464.6	1205484.6	1205504.6	1205524.6	1205544.6	1205564.6	1205584.6	1205604.6	1205624.6	1205644.6	1205664.6	1205684.6	1205704.6	1205724.6	1205744.6	1205764.6	1205784.6

L - SECTION

DRG NO.-301-2/AL/A/1255C

NOTE:-

- DFCC WORKS ARE SHOWN IN RED.
- IR NEW WORKS ARE SHOWN IN VIOLET.
- ALL DIMENSIONS ARE SHOWN IN METRES.
- THIS DRAWING IS PREPARED BASED ON LATEST SURVEY DATA HELD ON APRIL-2022. GTS BENCH MARK OF 261.850M CONSIDERED ON TOP OF CANAL BRIDGE ABUTMENT AT DORAHA VILLAGE ALONG THE NH1.
- DFC NEW CHAINAGE OF 1075.950M IS WITH REFERENCE TO THE IR KM OF 187.500KM END OF KM OF CP-303(SECTION P-3 PILKHANI END) AGAINST THE EXISTING DFC CHAINAGE. 116277.742M ISSUED VIDE LETTER NO. COM/DFCC/UM/SURVEY/2021-301-230116-011173.DT. 17.01.2023.
- BALLAST PROFILE HAS BEEN PROVIDED ACCORDING TO THE CLAUSE 1.11.3 OF STANDARD SCHEDULE OF DIMENSION(EASTERN CORRIDOR) & THE BALLAST CUSHION DIMENSION SHOWN IN 35CM ON GE-14 PARA 17. SPECIFICATIONS & RECOMMENDATIONS 2. TWO LAYER SYSTEM FIG.10.

REFERENCE DRAWINGS :-

- FOR KEY PLAN REFER DRAWING NO. 301-2/AL/0001
- FOR LEGEND AND ABBREVIATIONS REFER DRAWING NO. 301-2/AL/1000
- FOR TYPICAL SECTION OF BALLAST PROFILE (FL-RL) REFER DRG. NO. 301-2/TK/TFDI-004 (TR.1952)

018.09.2024SUBMISSION OF AS-BUILT DRAWINGFOR APPROVAL

REV. DATE REVISION DETAILS PURPOSE OF ISSUE

SCALE
HOR - 1:1000
VER - 1:100
SHEET SIZE : A1

LEGEND:

- IR TRACK
- DFCC TRACK
- DFCC FUTURE PROPOSALS
- STRUCTURE / BUILDING
- DFCC TOE LINE
- DFCC FORMATION
- RETAINING WALL
- ROAD
- STREAM, DRAIN, NALA, CANAL.
- FENCE
- POWER LINES
- TBM
- ELECTRIC POLE/OHE MAST
- IR RAILWAY BOUNDARY
- DFCC BOUNDARY

TYPICAL SECTION

TRACK STRUCTURE

RAIL SECTION: 60Kg/m (UIC 60Kg/m)	Difference between FL- RL (Below Rail Seat)	
DFC LINE: 60Kg/m (UIC 60Kg/m)	IR Line	DFC
IR MAIN LINE: 52Kg/m	172mm	172mm
RUBBER PAD	6mm	10mm
SLEEPER DEPTH	210mm	210mm
BALLAST CUSHION	300mm	350mm
Total Depth (FL TO RL)	688mm	742mm

OWNER

DEDICATED FREIGHT CORRIDOR CORPORATION OF INDIA LTD.
(A GOVERNMENT OF INDIA ENTERPRISE)
PROJECT OFFICE:AMBALA UNIT: OLD RAILWAY COLONY (NEAR ANAND MARKET),AMBALA CANTT-133001.
CORPORATE IDENTITY NO. : U60232DL2006GGI155068

ENGINEER:

DB Engineering & Consulting GmbH
Deutsche Bahn Engineering & Consulting GmbH

CONTRACTOR:

GIL - TPL JV
GAR TATA

SUBMITTED BY	GIL - TPL JV		
	DATED	NAME	SIGNATURE
PREPARED BY			
CHECKED BY	18.09.2024	VIJAY PRATAP	
APPROVED BY	18.09.2024	PARASURAM KOTYADA	

APPROVED BY	DEUTSCHE BAHN ENGINEERING & CONSULTING GMBH		
	DATED	NAME	SIGNATURE
Sr. DE./CHIEF ENGINEER		SURESH K.YALANGI	
CHIEF TRACK ENGINEER		RAJ PAL SINGH	
T.L.		H.D. VIDJAK	

STAMP

A AS-BUILT DRAWING
TR. Ref.....
ENGINEER Sign.:

EMPLOYER (DFCCIL):

DEDICATED FREIGHT CORRIDOR CORPORATION OF INDIA LTD.

AS BUILT DRAWING

TITLE
AS-BUILT PLAN AND PROFILE
DFC KM:1205.405 TO 1205.905 (DETOUR)


DFCC APPR. NO. -
ENGG. APPR. NO. -
DRG. NO. -301-2/AL/A/1255C
SHEET NO. : 1 OF 1
DATE : 18.09.2024

STATUS
A

TR.

PILKHANI

SAHNEWAL

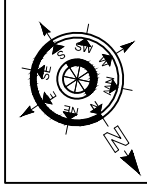

DRG NO.-301-2/AL/A/1256

NOTE:-

1. DFCC WORKS ARE SHOWN IN RED.
2. IR NEW WORKS ARE SHOWN IN VIOLET.
3. ALL DIMENSIONS ARE SHOWN IN METRES.
4. THIS DRAWING IS PREPARED BASED ON LATEST SURVEY DATA HELD ON APRIL-2022. GTS BENCH MARK OF 261.850M CONSIDERED ON TOP OF CANAL BRIDGE ABUTMENT AT DORANA VILLAGE ALONG THE NH1.
5. DFC NEW CHAINAGE OF 1075.950M IS WITH REFERENCE TO THE IR KM OF 187.500KM END OF KM OF CP-303(SECTION P-3 PILKHANI END) AGAINST THE EXISTING DFC CHAINAGE. 116277.742M ISSUED VIDE LETTER NO. COM/DFCC/MB/SURVEY/2021-301-230116-011173.DT. 17.01.2023.
6. BALLAST PROFILE HAS BEEN PROVIDED ACCORDING TO THE CLAUSE 1.11.3 OF STANDARD SCHEDULE OF DIMENSION(EASTERN CORRIDOR) & THE BALLAST CUSHION DIMENSION SHOWN IN 35CM ON GE-14 PARA 17. SPECIFICATIONS & RECOMMENDATIONS 2. TWO LAYER SYSTEM FIG.10.

REFERENCE DRAWINGS:-

1. FOR KEY PLAN REFER DRAWING NO. 301-2/AL/0001
2. FOR LEGEND AND ABBREVIATIONS REFER DRAWING NO. 301-2/AL/1000
3. FOR TYPICAL SECTION OF BALLAST PROFILE (FL-RL) REFER DRG. NO. 301-2/TK/TFD/-004 (TR.1952)

0	18.09.2024	SUBMISSION OF AS-BUILT DRAWING	FOR APPROVAL
REV.	DATE	REVISION DETAILS	PURPOSE OF ISSUE

SCALE

HOR - 1:1000

0 10 20 30 40m

0 1 2 3 4m

VER - 1:100

SHEET SIZE : A1

LEGEND:

IR TRACK

DFCC TRACK

DFCC FUTURE PROPOSALS

STRUCTURE / BUILDING

DFCC TOE LINE

DFCC FORMATION

RETAINING WALL

ROAD

STREAM, DRAIN, NALA, CANAL.

FENCE


POWER LINES

TBM

ELECTRIC POLE/OHE MAST

IR RAILWAY BOUNDARY

DFCC BOUNDARY

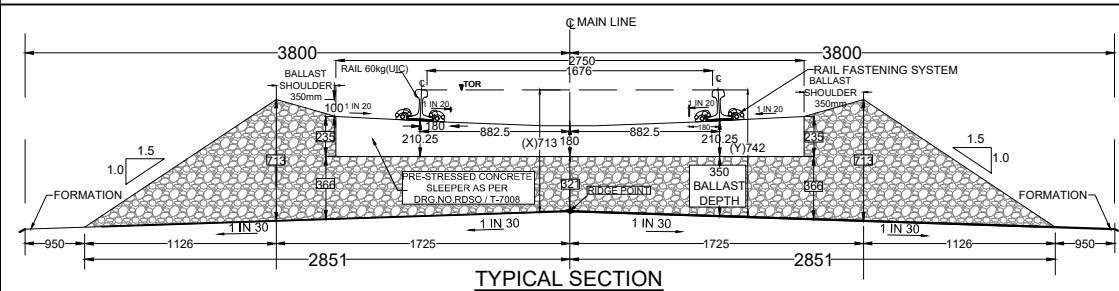

TRACK STRUCTURE		
RAIL SECTION: 60Kg/m (UIC 60Kg/m) DFC LINE: 60Kg/m (UIC 60Kg/m) IR MAIN LINE: 52Kg/m	Difference between FL- RL (Below Rail Seat)	
	IR Line	DFC
RUBBER PAD	172mm	172mm
SLEEPER DEPTH	6mm	10mm
BALLAST CUSHION	210mm	210mm
	300mm	350mm
Total Depth (FL TO RL)	688mm	742mm

OWNER
DEDICATED FREIGHT CORRIDOR CORPORATION OF INDIA LTD.
(A GOVERNMENT OF INDIA ENTERPRISE)
PROJECT OFFICE/AMBALA UNIT: OLD RAILWAY COLONY (NEAR ANAND MARKET), AMBALA CANTT-133001.
CORPORATE IDENTITY NO. : U60232DL2006GGI155068

ENGINEER:
DB Engineering & Consulting GmbH
Deutsche Bahn Engineering & Consulting GmbH

CONTRACTOR:
GIL - TPL JV
GAR TATA

SUBMITTED BY	GIL - TPL JV		
	DATED	NAME	SIGNATURE
PREPARED BY			
CHECKED BY	18.09.2024	VIJAY PRATAP	
APPROVED BY	18.09.2024	PARASURAM KOTYADA	

APPROVED BY	DEUTSCHE BAHN ENGINEERING & CONSULTING GMBH		
	DATED	NAME	SIGNATURE
Sr. DE./CHIEF ENGINEER		SURESH K.YALANGI	
CHIEF TRACK ENGINEER		RAJ PAL SINGH	
T.L.		H.D. VIDJAK	



STAMP

A AS-BUILT DRAWING
TR. Ref.....
ENGINEER Sign.:

EMPLOYER (DFCCIL): DEDICATED FREIGHT CORRIDOR CORPORATION OF INDIA LTD.

AS BUILT DRAWING		
TITLE	DFCC APPR. NO. -	
AS-BUILT PLAN AND PROFILE	ENGG. APPR. NO. -	
DFC KM:1205.905 TO 1206.405 (DETOUR)	DRG. NO. -301-2/AL/A/1256	
	SHEET NO. : 1 OF 1	STATUS
	DATE : 18.09.2024	A



TR.

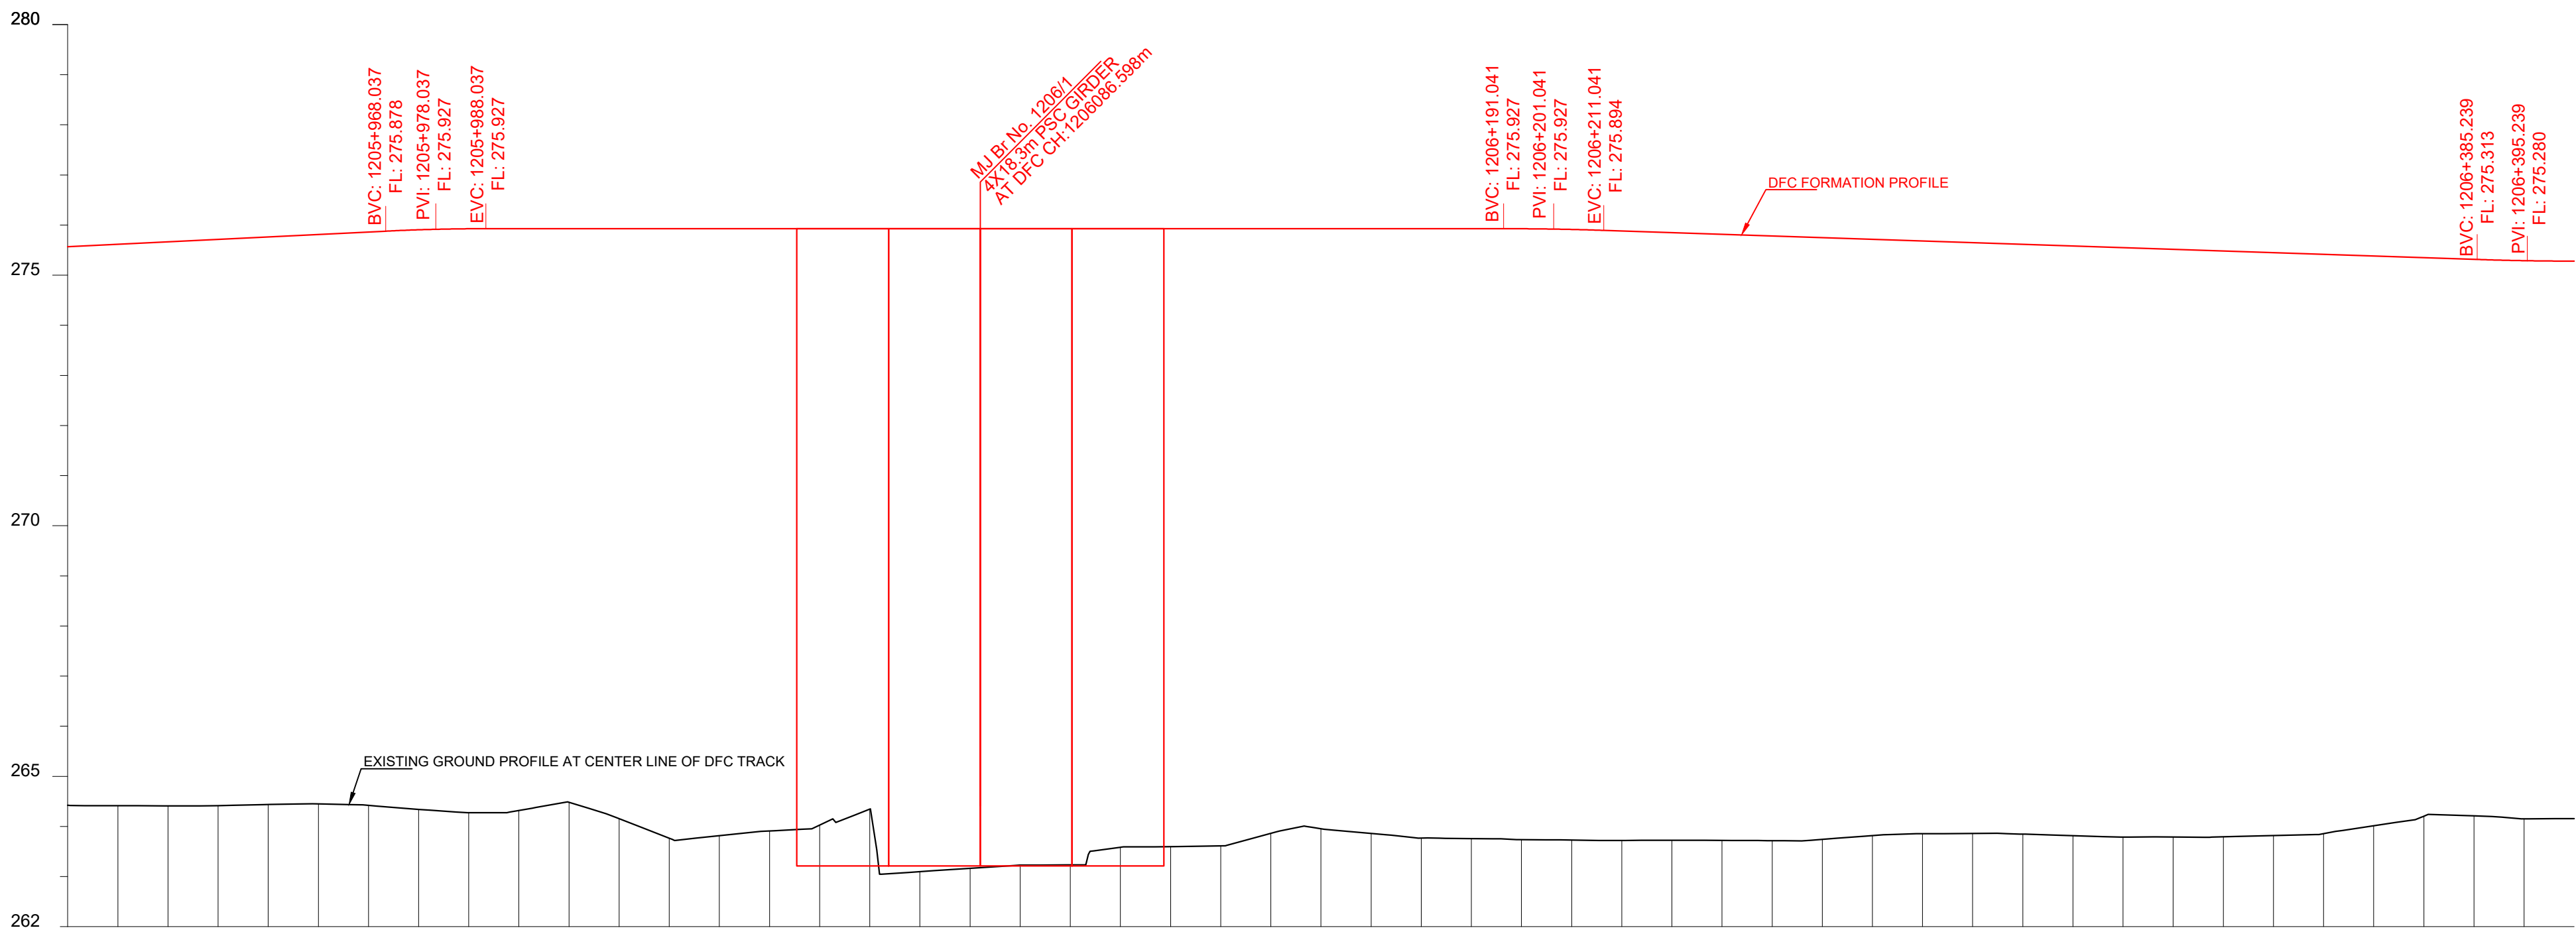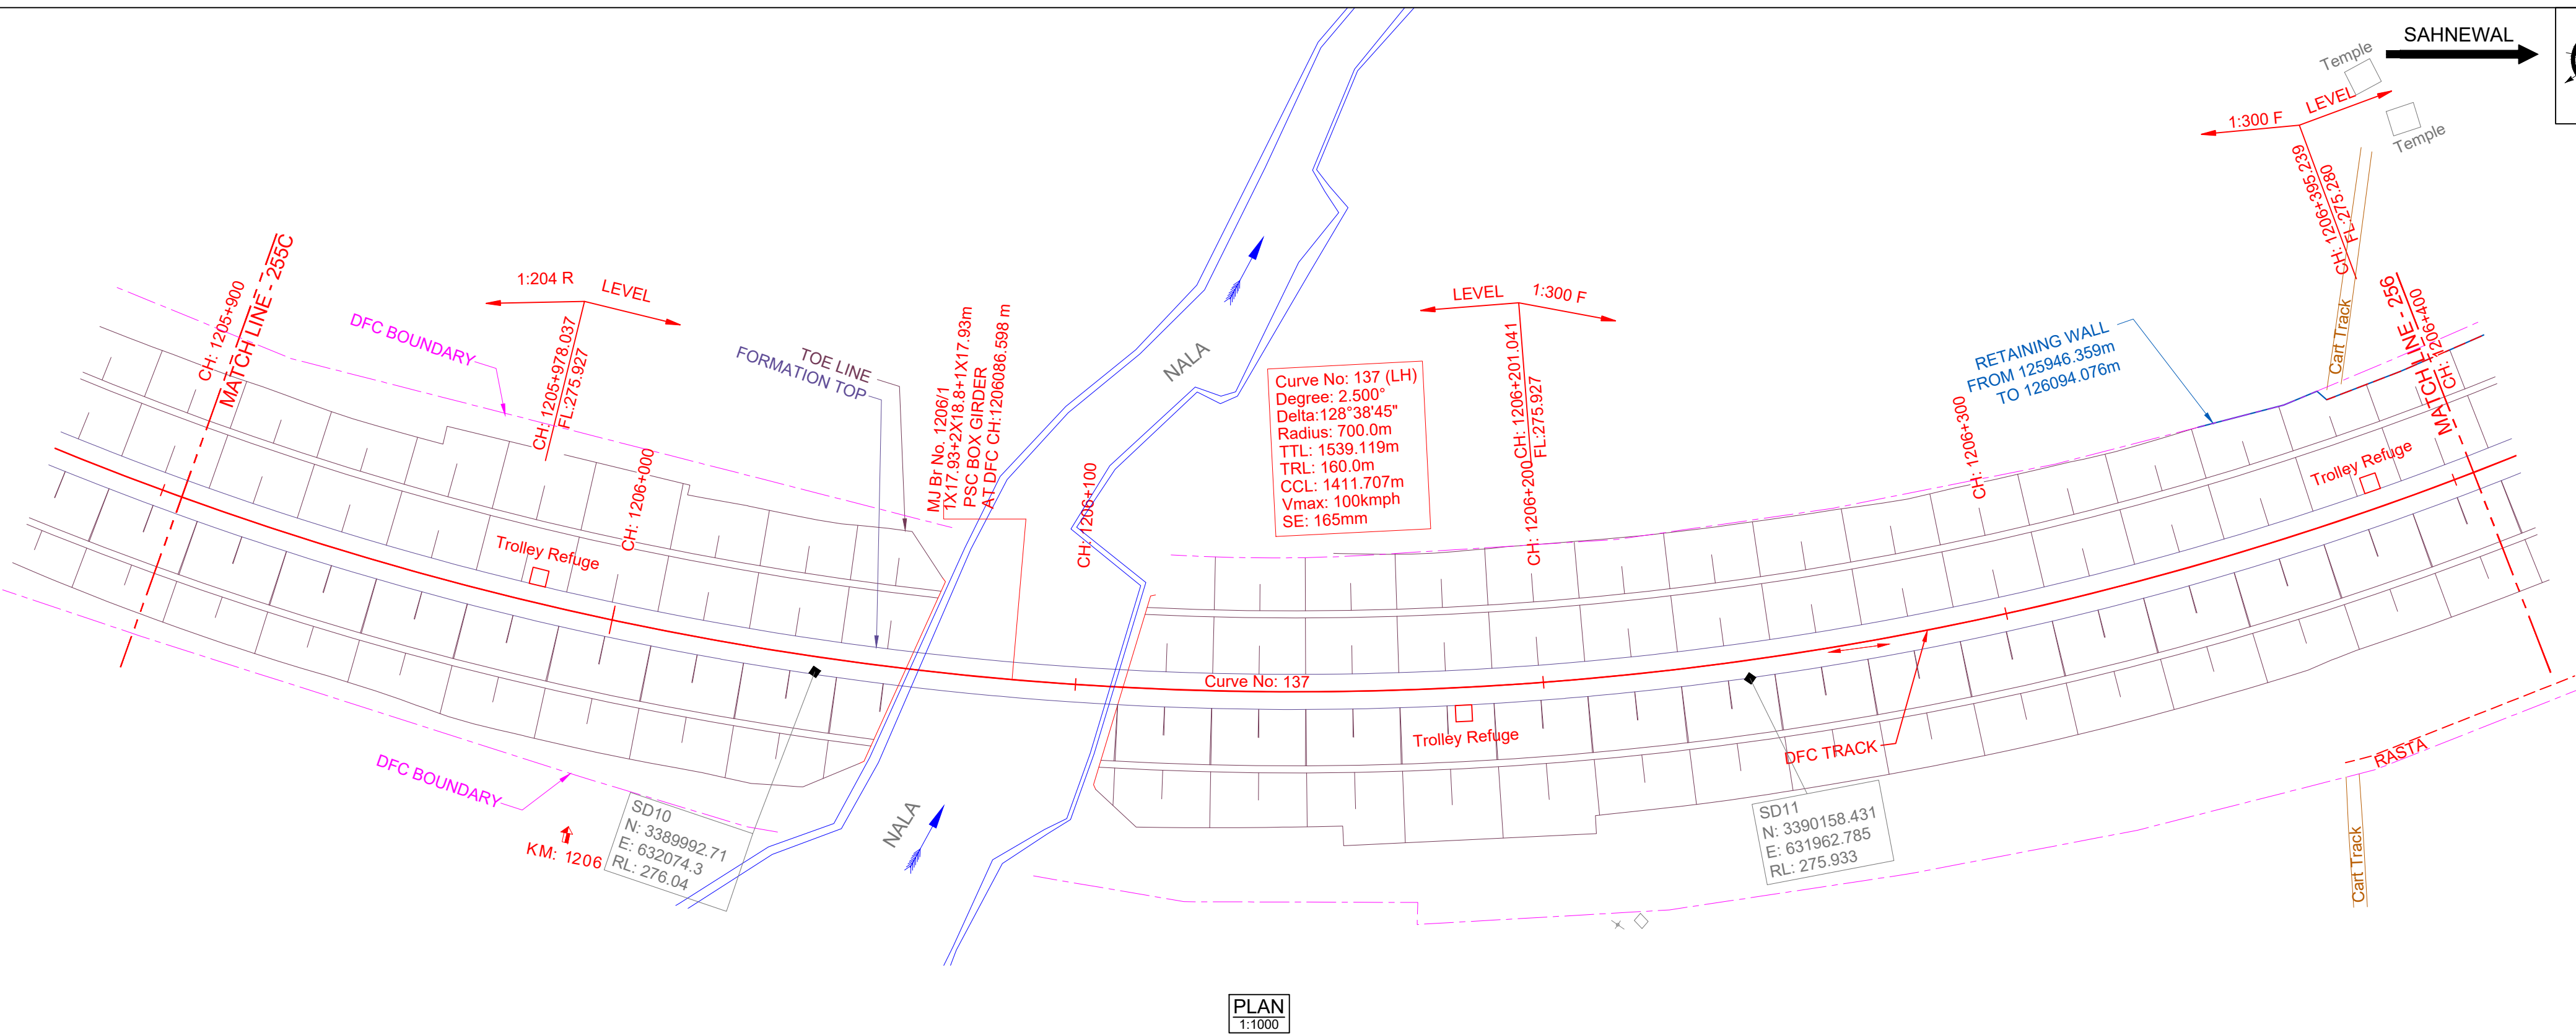

DATUM ABOVE MSL : 262 m

HORIZONTAL ALIGNMENT	R =-700m																											
VERTICAL ALIGNMENT	L=1887.555 m 1 IN 204.286 R L=20.0 m R=4086 m L=203.0 m LEVEL L=20.0 m R=6001 m L=174.198 m 1 IN 300.069 F L=20.0 m R=6001 m																											
HEIGHT OF BANKING(+)/ DEPTH OF CUTTING(-) (PFL-GL)	+11.144	+11.255	+11.327	+11.441	+11.653	+11.443	+12.162	+12.017			+12.329	+12.063	+12.066	+12.169	+12.183	+12.125	+12.065	+11.896	+11.789	+11.766	+11.726	+11.632	+11.368	+11.104	+11.124			
EXG GROUND LEVEL AT CENTER LINE OF DFC TRACK (GL)	264.424	264.411	264.437	264.420	264.273	264.484	263.765	263.910		264.345	263.163	263.232		263.598	263.864	263.861	263.759	263.729	263.724	263.717	263.819	263.860	263.816	263.789	263.817	264.014	264.211	264.156
DFC FORMATION LEVEL (PFL)	275.568	275.666	275.764	275.861	275.926	275.927	275.927	275.927		275.927	275.927	275.927		275.927	275.927	275.912	275.849	275.782	275.715	275.649	275.582	275.515	275.448	275.382	275.315	275.280		
DFC RAIL LEVEL (PRL)	276.281	276.379	276.477	276.575	276.64	276.64	276.64	276.64		276.64	276.64	276.64		276.64	276.64	276.628	276.562	276.495	276.428	276.362	276.295	276.228	276.162	276.095	276.028	275.993		
DFC TRACK CHAINAGE	1205904.6	1205924.6	1205944.6	1205964.6	1205984.6	1206004.6	1206024.6	1206044.6	1206064.6	1206084.6	1206104.6	1206124.6	1206144.6	1206164.6	1206184.6	1206204.6	1206224.6	1206244.6	1206264.6	1206284.6	1206304.6	1206324.6	1206344.6	1206364.6	1206384.6	1206404.6		

L - SECTION

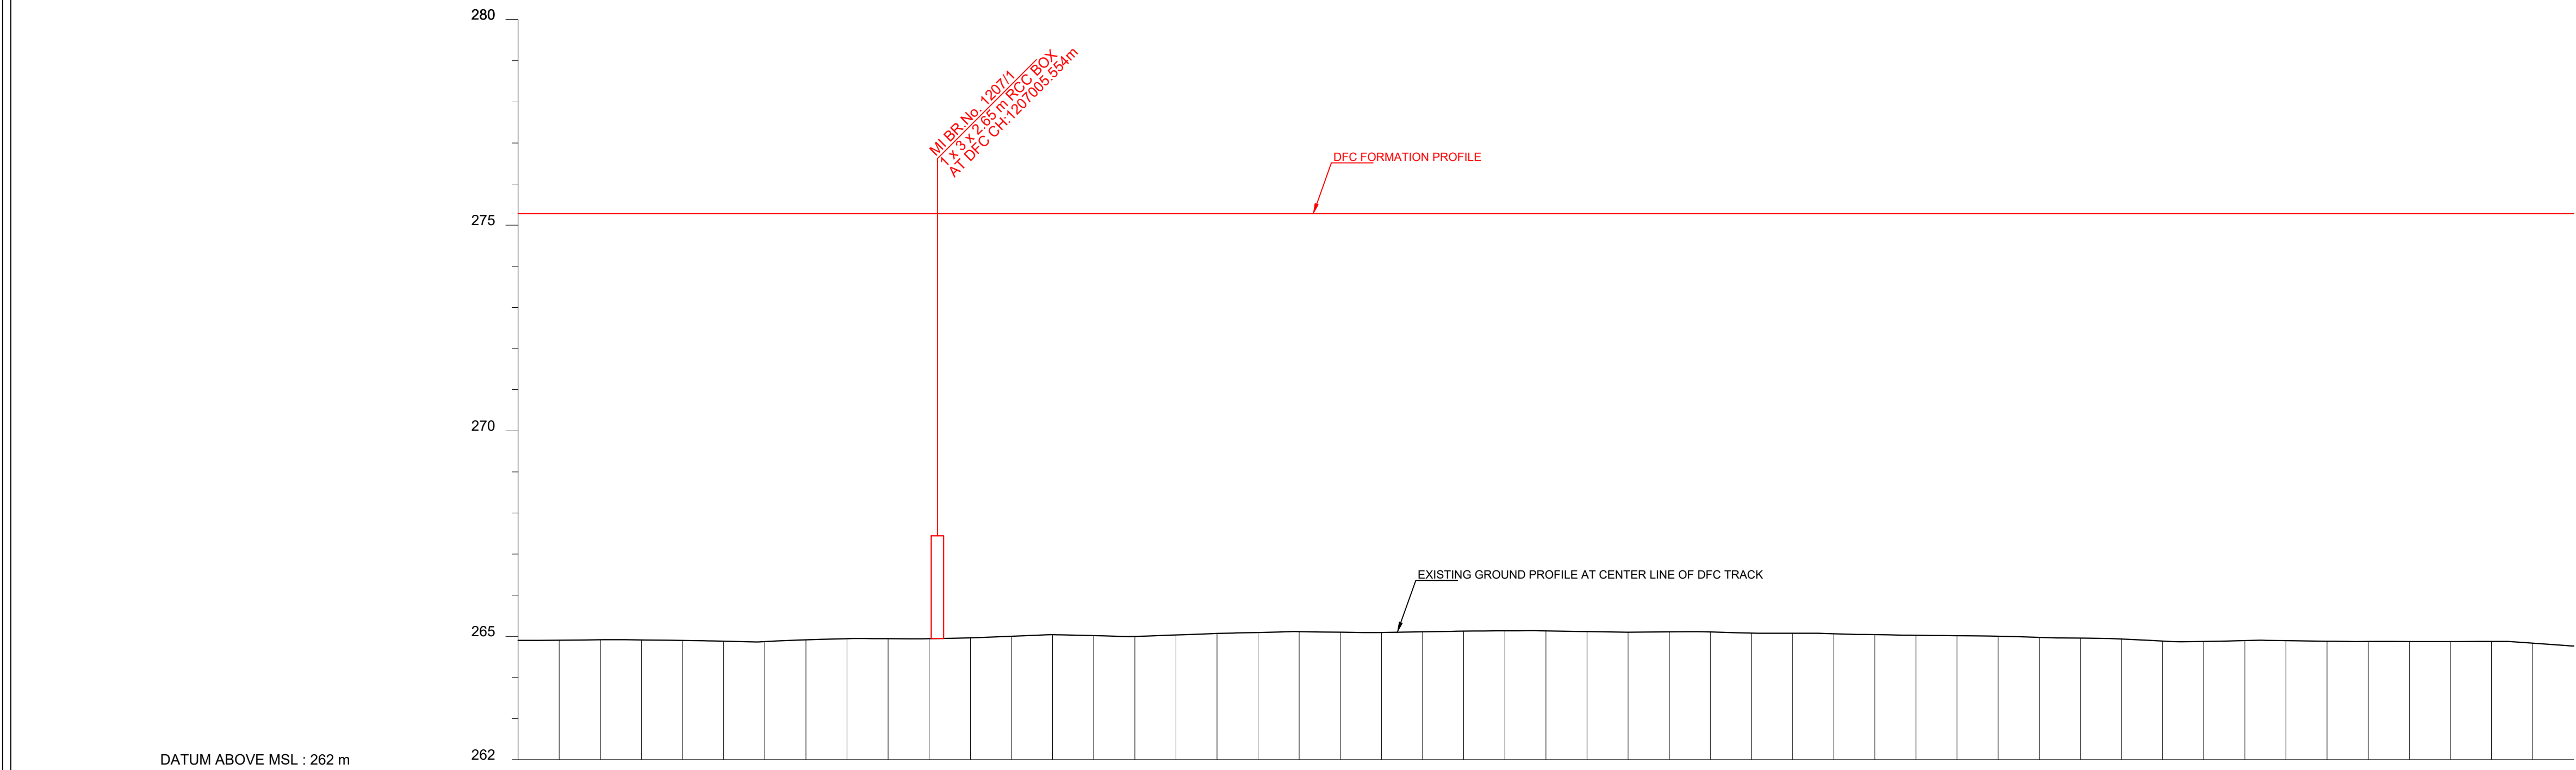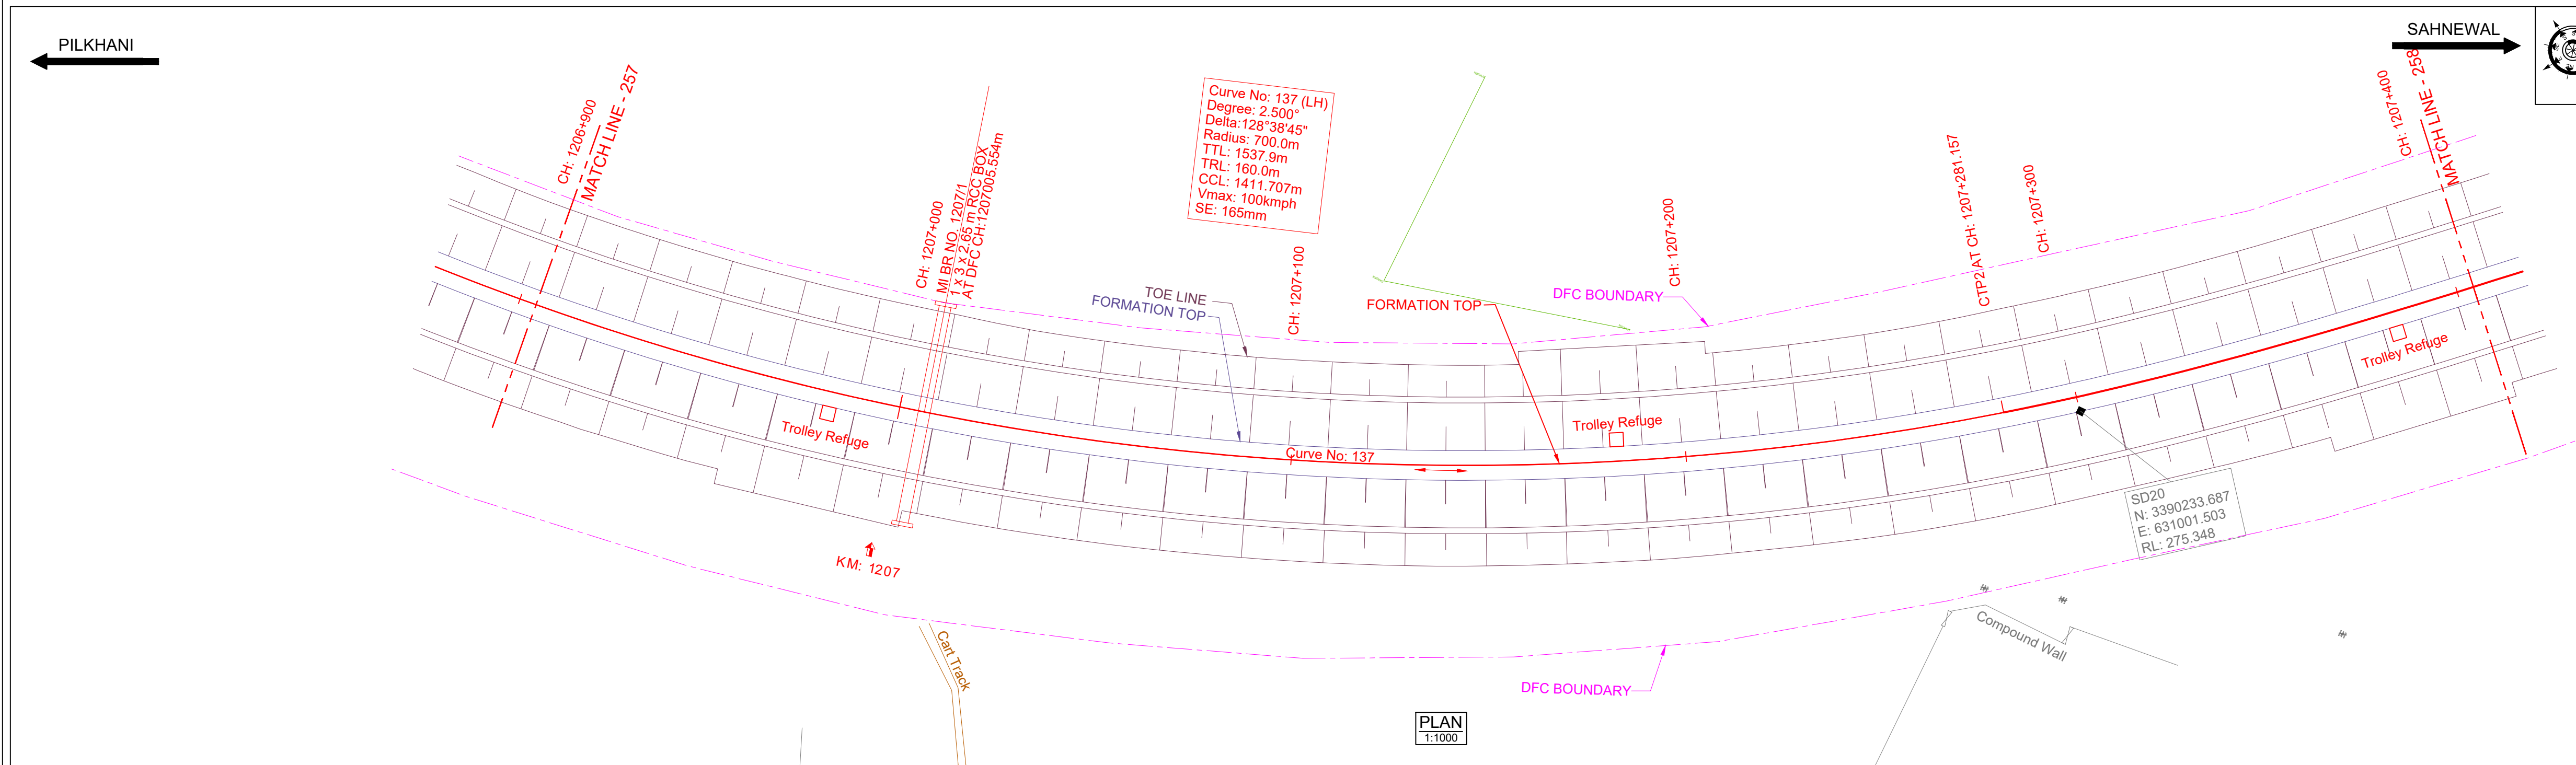

HORIZONTAL ALIGNMENT	R = -700m															TL = 160m										
VERTICAL ALIGNMENT	L=1559.618 m LEVEL																									
HEIGHT OF BANKING(+) / DEPTH OF CUTTING(-) (PFL-GL)	+10.377	+10.364	+10.381	+10.409	+10.336	+10.337	+10.277	+10.264	+10.248	+10.186	+10.180	+10.169	+10.147	+10.165	+10.173	+10.201	+10.217	+10.254	+10.276	+10.325	+10.395	+10.384	+10.398	+10.407	+10.403	+10.515
EXG GROUND LEVEL AT CENTER LINE OF DFC TRACK (GL)	264.903	264.916	264.898	264.871	264.944	264.943	265.003	265.016	265.032	265.094	265.100	265.111	265.133	265.115	265.107	265.079	265.063	265.026	265.004	264.955	264.885	264.896	264.882	264.873	264.877	264.765
DFC FORMATION LEVEL (PFL)	275.280	275.280	DFC RAIL LEVEL (PRL)	275.993	275.993	DFC TRACK CHAINAGE	1206904.6	1206924.6	1206944.6	1206964.6	1206984.6	1207004.6	1207024.6	1207044.6	1207064.6	1207084.6	1207104.6	1207124.6	1207144.6	1207164.6	1207184.6	1207204.6	1207224.6	1207244.6	1207264.6	1207284.6	1207304.6	1207324.6	1207344.6	1207364.6	1207384.6	1207404.6

L - SECTION

- NOTE:-
- DFCC WORKS ARE SHOWN IN RED.
 - IR NEW WORKS ARE SHOWN IN VIOLET.
 - ALL DIMENSIONS ARE SHOWN IN METRES.
 - THIS DRAWING IS PREPARED BASED ON LATEST SURVEY DATA HELD ON APRIL-2022. GTS BENCH MARK OF 261.850M CONSIDERED ON TOP OF CANAL BRIDGE ABUTMENT AT DORAHA VILLAGE ALONG THE NH1.
 - DFC NEW CHAINAGE OF 1075.950M IS WITH REFERENCE TO THE IR KM OF 187.500KM END OF KM OF CP-303(SECTION P-3 PILKHANI END) AGAINST THE EXISTING DFC CHAINAGE. 116277.742M ISSUED VIDE LETTER NO. COM/DFCC/UM/SURVEY/2021-301-23016-011173 DT. 17.01.2023.
 - BALLAST PROFILE HAS BEEN PROVIDED ACCORDING TO THE CLAUSE 1.11.3 OF STANDARD SCHEDULE OF DIMENSION(EASTERN CORRIDOR) & THE BALLAST CUSHION DIMENSION SHOWN IN 35CM ON GE-14 PARA 17. SPECIFICATIONS & RECOMMENDATIONS 2. TWO LAYER SYSTEM FIG.10.

- REFERENCE DRAWINGS :-
- FOR KEY PLAN REFER DRAWING NO. 301-2/AL/0001
 - FOR LEGEND AND ABBREVIATIONS REFER DRAWING NO. 301-2/AL/1000
 - FOR TYPICAL SECTION OF BALLAST PROFILE (FL-RL) REFER DRG. NO. 301-2/TK/TFD/-004 (TR.1952)

0	18.09.2024	SUBMISSION OF AS-BUILT DRAWING	FOR APPROVAL
REV.	DATE	REVISION DETAILS	PURPOSE OF ISSUE

LEGEND:


SCALE

HOR - 1:1000

VER - 1:100

SHEET SIZE : A1

IR TRACK
DFCC TRACK
DFCC FUTURE PROPOSALS
STRUCTURE / BUILDING
DFCC TOE LINE
DFCC FORMATION
RETAINING WALL
ROAD
STREAM, DRAIN, NALA, CANAL.
FENCE
POWER LINES
TBM
ELECTRIC POLE/OHE MAST
IR RAILWAY BOUNDARY
DFCC BOUNDARY

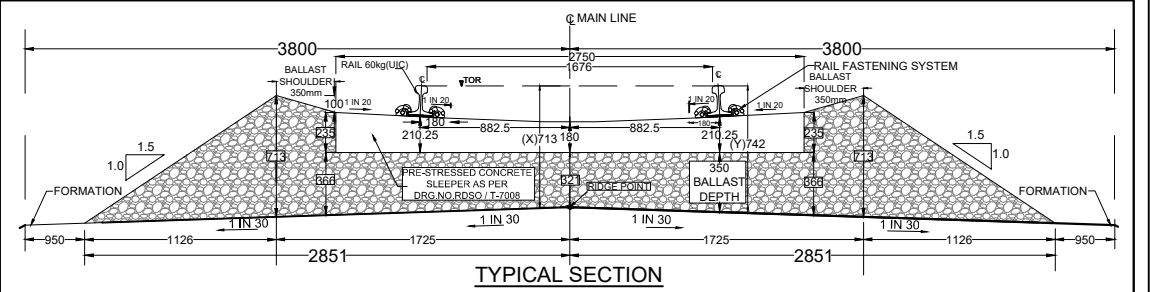

TRACK STRUCTURE		
RAIL SECTION: 60Kg/m (UIC 60Kg/m) DFC LINE: 60Kg/m (UIC 60Kg/m) IR MAIN LINE: 52Kg/m	Difference between FL- RL (Below Rail Seat)	
	IR Line	DFC
RUBBER PAD	172mm	172mm
SLEEPER DEPTH	6mm	10mm
BALLAST CUSHION	210mm	210mm
	300mm	350mm
Total Depth (FL TO RL)	688mm	742mm

OWNER

DEDICATED FREIGHT CORRIDOR CORPORATION OF INDIA LTD.

(A GOVERNMENT OF INDIA ENTERPRISE)

PROJECT OFFICE/AMBALA UNIT: OLD RAILWAY COLONY (NEAR ANAND MARKET), AMBALA CANTT-133001.

CORPORATE IDENTITY NO. : U60232DL2006GGI155068

ENGINEER:

DB Engineering & Consulting GmbH

Deutsche Bahn Engineering & Consulting GmbH

CONTRACTOR:

GIL - TPL JV

GAR TATA



SUBMITTED BY	GIL - TPL JV		
	DATED	NAME	SIGNATURE
PREPARED BY			
CHECKED BY	18.09.2024	VIJAY PRATAP	
APPROVED BY	18.09.2024	PARASURAM KOTYADA	

APPROVED BY	DEUTSCHE BAHN ENGINEERING & CONSULTING GMBH		
	DATED	NAME	SIGNATURE
Sr. DE./CHIEF ENGINEER		SURESH K.YALANGI	
CHIEF TRACK ENGINEER		RAJ PAL SINGH	
T.L.		H.D. VIDJAK	

STAMP	A AS-BUILT DRAWING TR. Ref.:..... ENGINEER Sign.:.		
EMPLOYER (DFCCIL):	DEDICATED FREIGHT CORRIDOR CORPORATION OF INDIA LTD.		

AS BUILT DRAWING			
TITLE		DFCC APPR. NO. -	
AS-BUILT PLAN AND PROFILE		ENGG. APPR. NO. -	
DRG. NO. - 301-2/AL/A/1258		DRG. NO. - 301-2/AL/A/1258	
SHEET NO. : 1 OF 1		STATUS	
DATE : 18.09.2024		A	

TR.

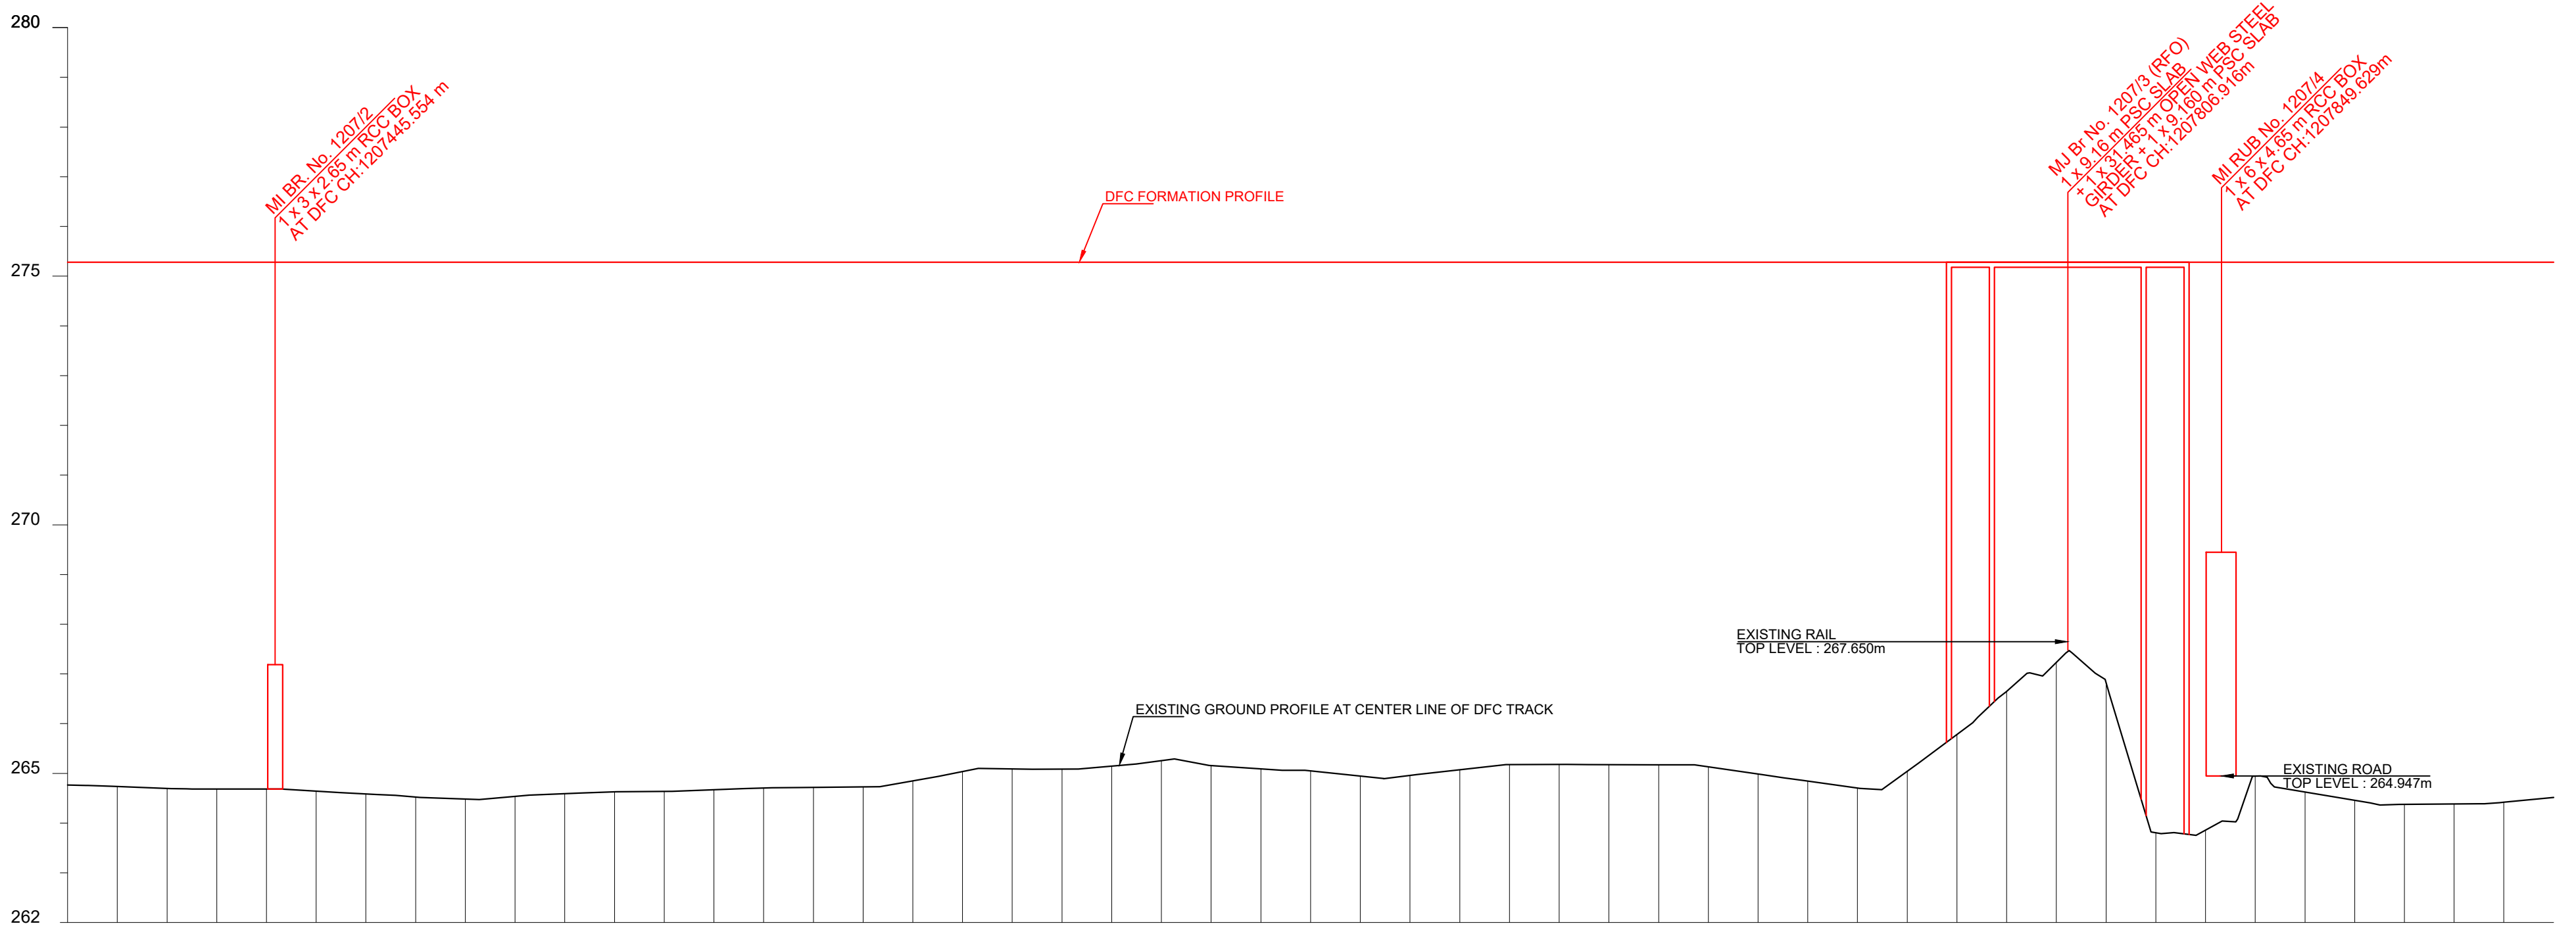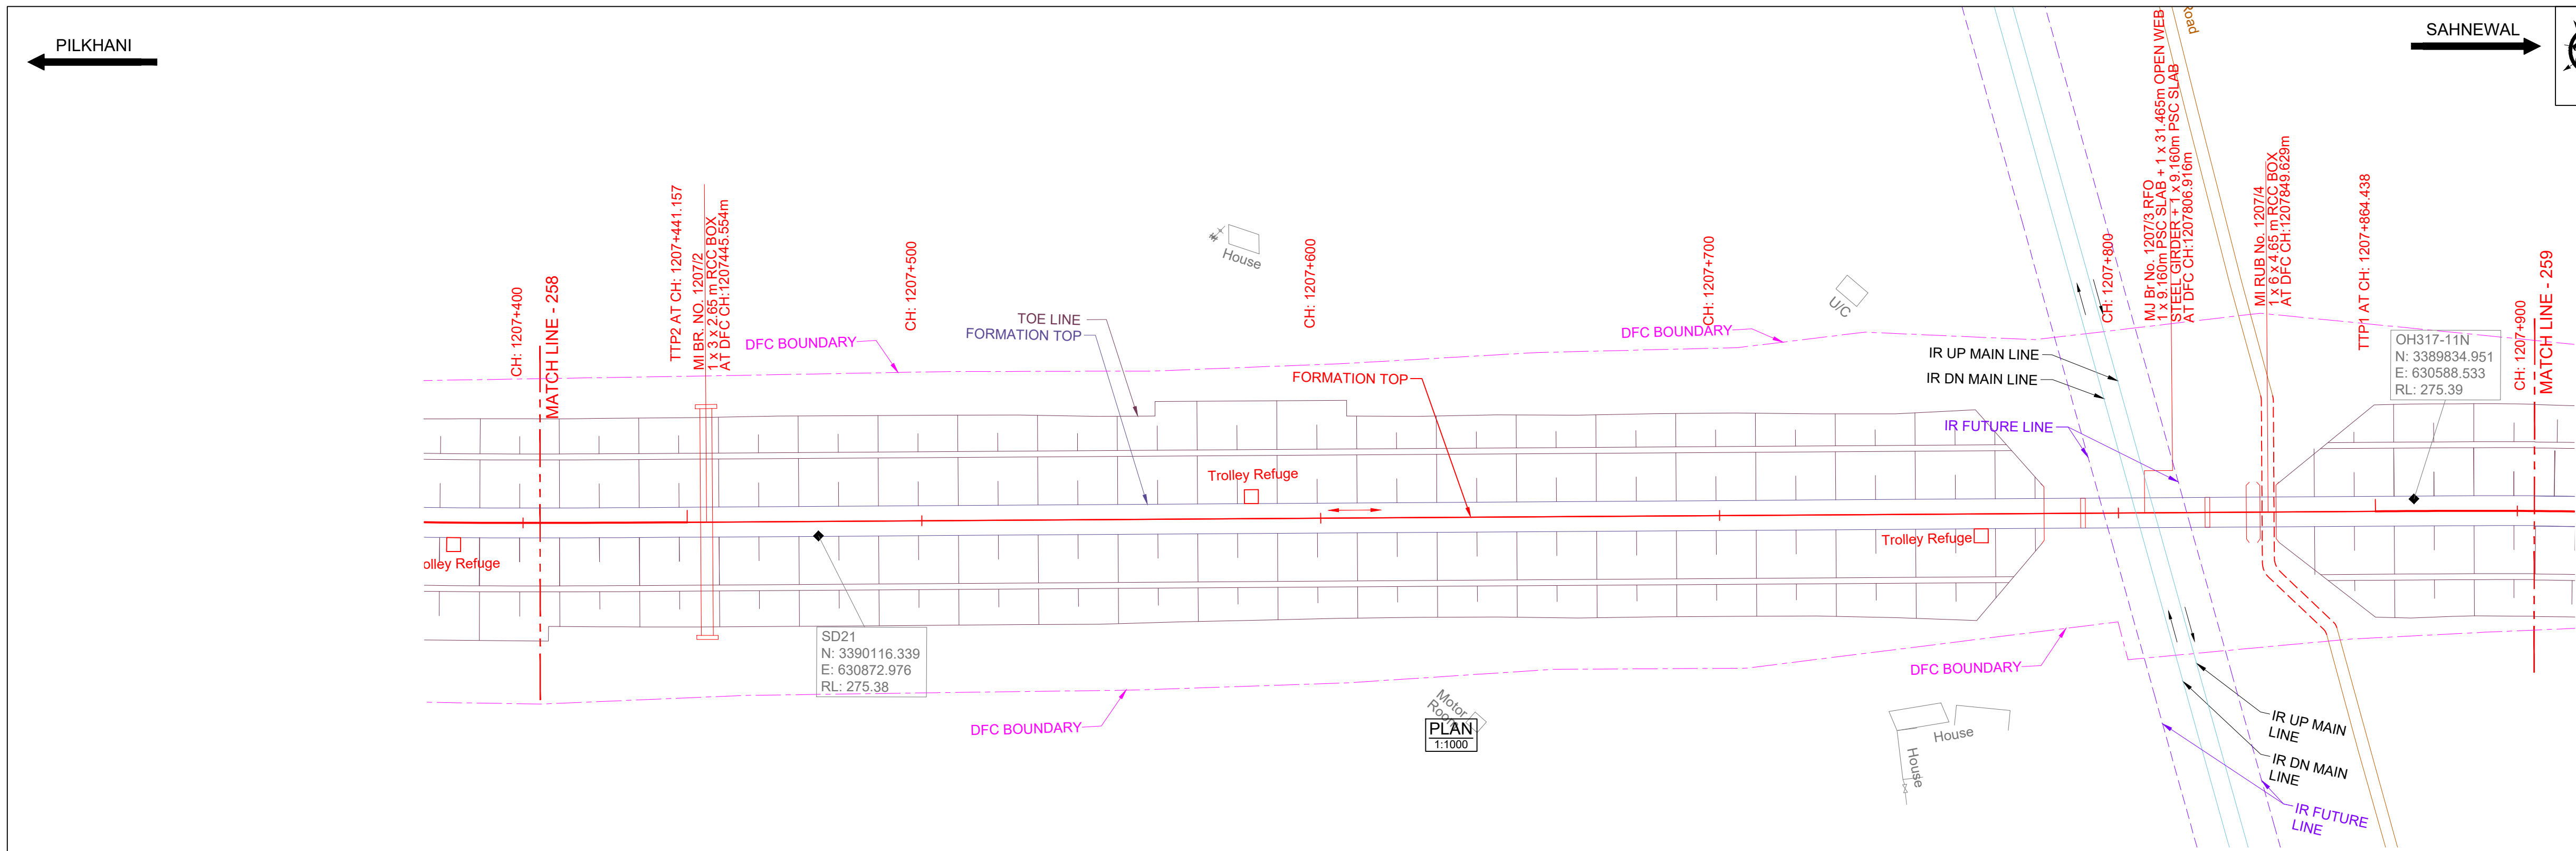

HORIZONTAL ALIGNMENT	TL = 160m L = 423.281m TL = 80m																			
VERTICAL ALIGNMENT	L=1559.618 m LEVEL																			
HEIGHT OF BANKING(+) / DEPTH OF CUTTING(-) (PFL-GL)	+10.515	+10.584	+10.595	+10.694	+10.796	+10.686	+10.643	+10.574	+10.553	+10.242	+10.193	+10.024	+10.191	+10.335	+10.206	+10.102	+10.107	+10.293	+10.574	+9.497
EXG GROUND LEVEL AT CENTER LINE OF DFC TRACK (GL)	264.765	264.696	264.685	264.586	264.464	264.592	264.637	264.706	264.727	265.038	265.087	265.256	265.089	264.945	265.072	265.178	265.173	264.987	264.706	265.783
DFC FORMATION LEVEL (PFL)	275.280	275.280	275.280	275.280	275.280	275.280	275.280	275.280	275.280	275.280	275.280	275.280	275.280	275.280	275.280	275.280	275.280	275.280	275.280	275.280
DFC RAIL LEVEL (PRL)	275.993	275.993	275.993	275.993	275.993	275.993	275.993	275.993	275.993	275.993	275.993	275.993	275.993	275.993	275.993	275.993	275.993	275.993	275.993	275.993
DFC TRACK CHAINAGE	1207404.6	1207424.6	1207444.6	1207464.6	1207484.6	1207504.6	1207524.6	1207544.6	1207564.6	1207584.6	1207604.6	1207624.6	1207644.6	1207664.6	1207684.6	1207704.6	1207724.6	1207744.6	1207764.6	1207784.6

L - SECTION

- NOTE:-
- DFCC WORKS ARE SHOWN IN RED.
 - IR NEW WORKS ARE SHOWN IN VIOLET.
 - ALL DIMENSIONS ARE SHOWN IN METRES.
 - THIS DRAWING IS PREPARED BASED ON LATEST SURVEY DATA HELD ON APRIL-2022. GTS BENCH MARK OF 261.850M CONSIDERED ON TOP OF CANAL BRIDGE ABUTMENT AT DORANA VILLAGE ALONG THE NH1.
 - DFC NEW CHAINAGE OF 1075.950M IS WITH REFERENCE TO THE IR KM OF 187.500KM END OF KM OF CP-303(SECTION P-3 PILKHANI END) AGAINST THE EXISTING DFC CHAINAGE. 116277.742M ISSUED VIDE LETTER NO. COM/DFCC/UMS/SURVEY/2021-301-230116-011173.DT. 17.01.2023.
 - BALLAST PROFILE HAS BEEN PROVIDED ACCORDING TO THE CLAUSE 1.11.3 OF STANDARD SCHEDULE OF DIMENSION(EASTERN CORRIDOR) & THE BALLAST CUSHION DIMENSION SHOWN IN 35CM ON GE-14 PARA 17. SPECIFICATIONS & RECOMMENDATIONS 2. TWO LAYER SYSTEM FIG.10.

- REFERENCE DRAWINGS :-
- FOR KEY PLAN REFER DRAWING NO. 301-2/AL/0001
 - FOR LEGEND AND ABBREVIATIONS REFER DRAWING NO. 301-2/AL/1000
 - FOR TYPICAL SECTION OF BALLAST PROFILE (FL-RL) REFER DRG. NO. 301-2/TK/TFD/-004 (TR.1952)

0	18.09.2024	SUBMISSION OF AS-BUILT DRAWING	FOR APPROVAL
REV.	DATE	REVISION DETAILS	PURPOSE OF ISSUE

LEGEND:


SCALE

HOR - 1:1000

VER - 1:100

SHEET SIZE : A1

IR TRACK
DFCC TRACK
DFCC FUTURE PROPOSALS
STRUCTURE / BUILDING
DFCC TOE LINE
DFCC FORMATION
RETAINING WALL
ROAD
STREAM, DRAIN, NALA, CANAL.
FENCE
POWER LINES
TBM
ELECTRIC POLE/OHE MAST
IR RAILWAY BOUNDARY
DFCC BOUNDARY

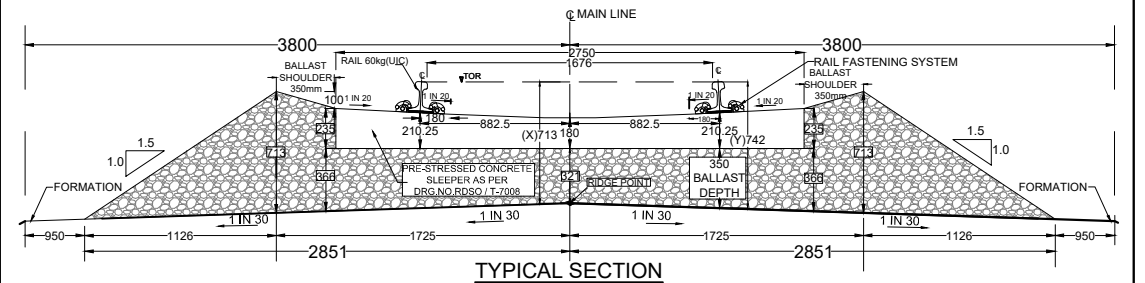

TRACK STRUCTURE		
RAIL SECTION: 60Kg/m (UIC 60Kg/m) DFC LINE: 60Kg/m (UIC 60Kg/m) IR MAIN LINE: 52Kg/m	Difference between FL- RL (Below Rail Seat)	
	IR Line	DFC
RUBBER PAD	172mm	172mm
SLEEPER DEPTH	6mm	10mm
BALLAST CUSHION	210mm	210mm
	300mm	350mm
Total Depth (FL TO RL)	688mm	742mm

OWNER

DEDICATED FREIGHT CORRIDOR CORPORATION OF INDIA LTD.

(A GOVERNMENT OF INDIA ENTERPRISE)

PROJECT OFFICE/AMBALA UNIT: OLD RAILWAY COLONY (NEAR ANAND MARKET),AMBALA CANTT-133001.

CORPORATE IDENTITY NO. : U60232DL20060G0155068

ENGINEER:

DB Engineering & Consulting GmbH

Deutsche Bahn Engineering & Consulting GmbH

CONTRACTOR:

GIL - TPL JV

GAR TATA



SUBMITTED BY	GIL - TPL JV		
	DATED	NAME	SIGNATURE
PREPARED BY			
CHECKED BY	18.09.2024	VIJAY PRATAP	
APPROVED BY	18.09.2024	PARASURAM KOTYADA	

APPROVED BY	DEUTSCHE BAHN ENGINEERING & CONSULTING GMBH		
	DATED	NAME	SIGNATURE
Sr. DE./CHIEF ENGINEER		SURESH K.YALANGI	
CHIEF TRACK ENGINEER		RAJ PAL SINGH	
T.L.		H.D. VIDJAK	

STAMP	A AS-BUILT DRAWING TR. Ref..... ENGINEER Sign.:		
EMPLOYER (DFCCIL):	DEDICATED FREIGHT CORRIDOR CORPORATION OF INDIA LTD.		

AS BUILT DRAWING			
TITLE	AS-BUILT PLAN AND PROFILE	DFCC APPR. NO. -	
	DFC KM:1207.405 TO 1207.905 (DETOUR)	ENGG. APPR. NO. -	
		DRG. NO. - 301-2/AL/A/1259	
		SHEET NO. : 1 OF 1	STATUS
		DATE : 18.09.2024	A

TR.

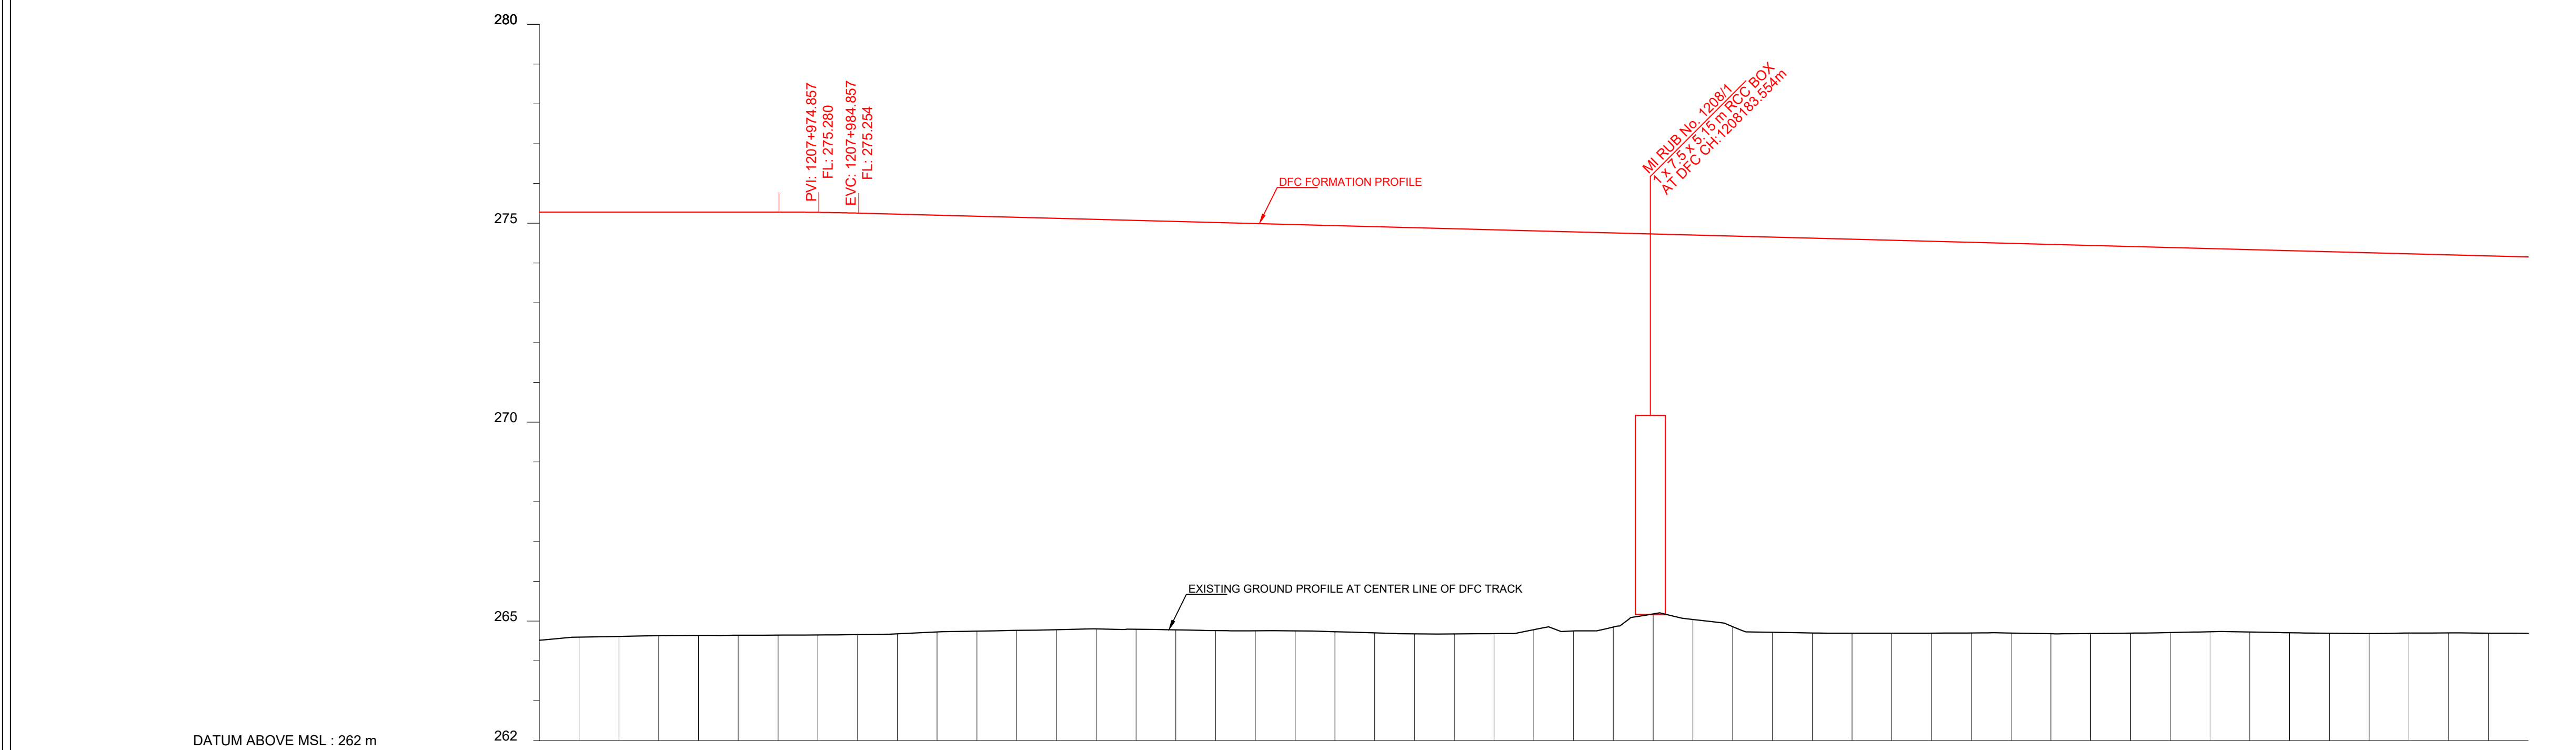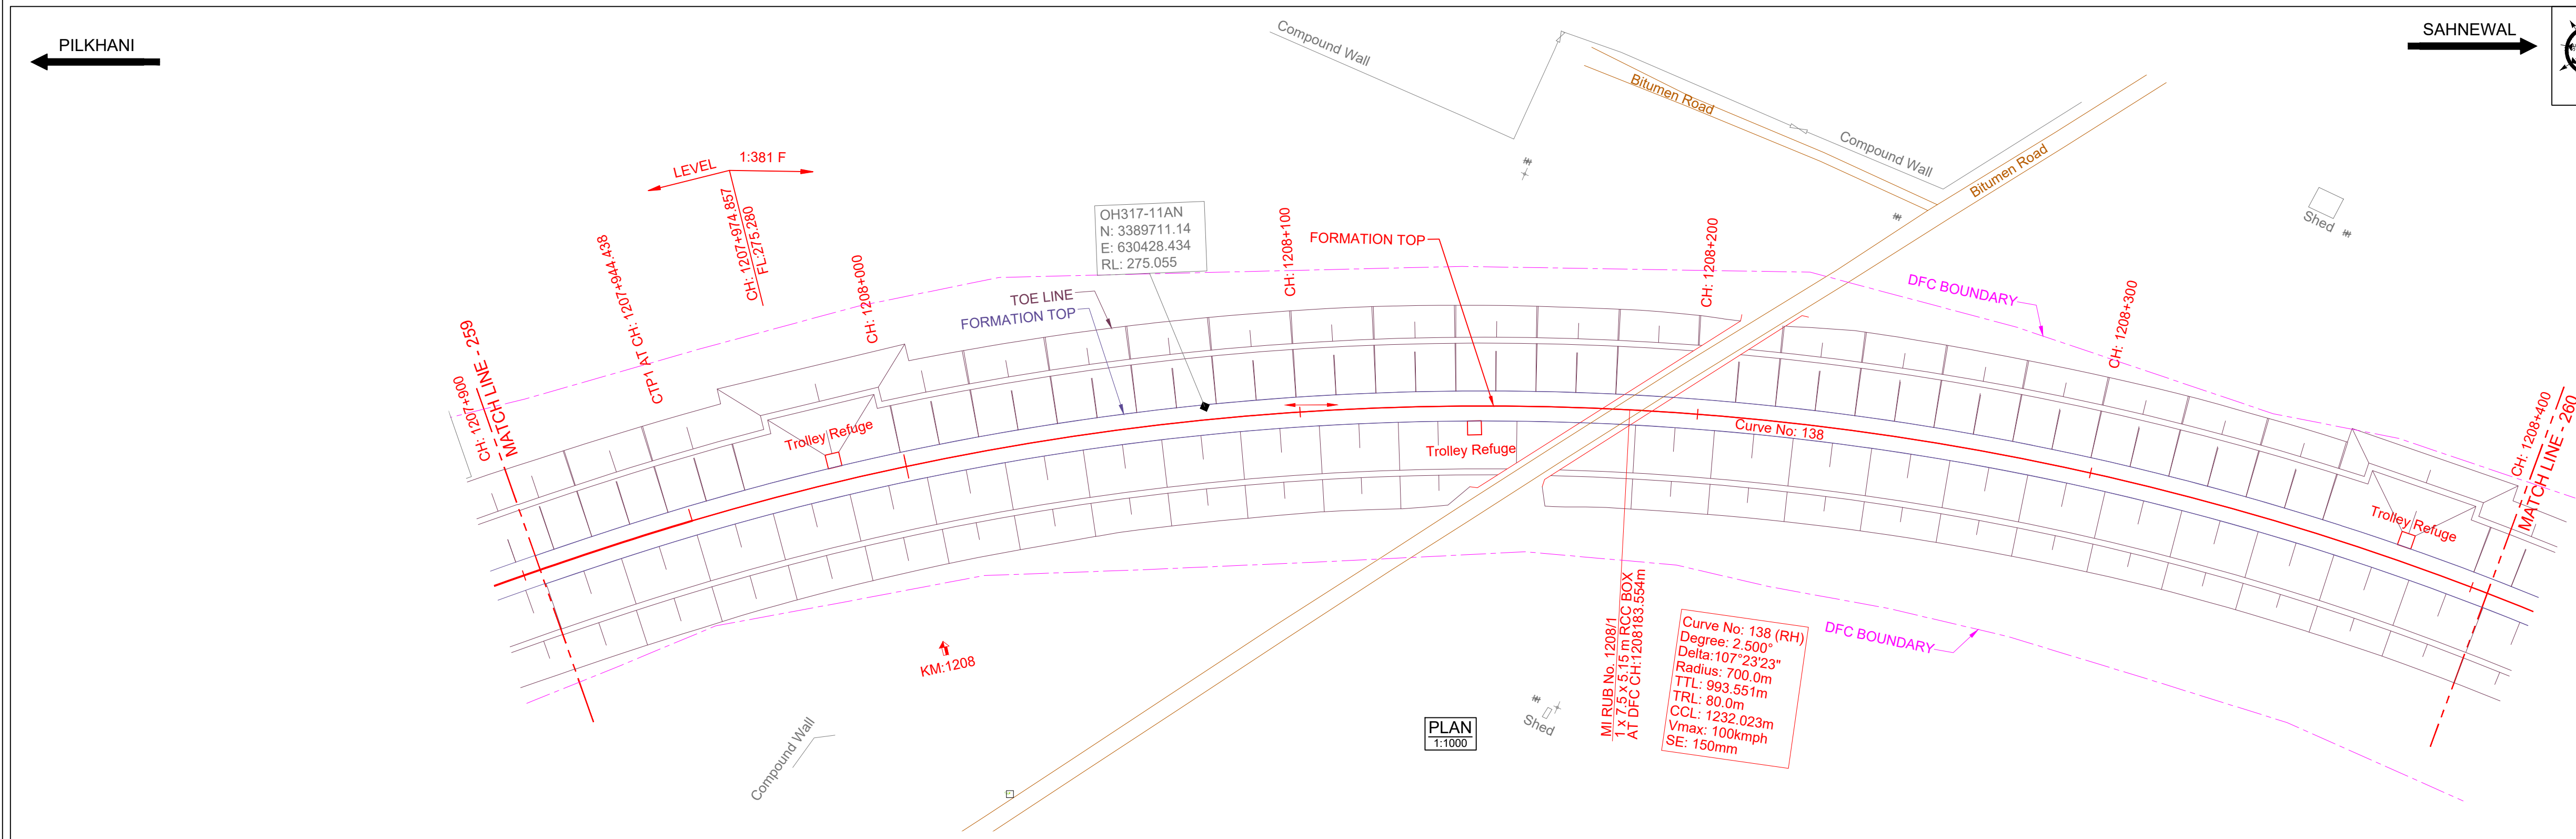

DATUM ABOVE MSL : 262 m

HORIZONTAL ALIGNMENT	TL = 80m R = 700m																			
VERTICAL ALIGNMENT	L=1559.618 m LEVEL L=20.0 m R=7623 m L=1692.889 m 1 IN 381.150 F																			
HEIGHT OF BANKING(+) / DEPTH OF CUTTING(-) (PFL-GL)	+10.764	+10.667	+10.642	+10.634	+10.594	+10.475	+10.383	+10.295	+10.266	+10.235	+10.208	+10.208	+10.151	+10.031	+9.551	+9.616	+9.924	+9.877	+9.818	+9.785
EXG GROUND LEVEL AT CENTER LINE OF DFC TRACK (GL)	264.516	264.613	264.638	264.646	264.660	264.727	264.766	264.802	264.779	264.757	264.732	264.679	264.684	264.751	265.179	264.861	264.701	264.695	264.702	264.682
DFC FORMATION LEVEL (PFL)	275.280	275.280	275.280	275.280	275.255	275.203	275.150	275.098	275.045	274.992	274.940	274.887	274.835	274.782	274.730	274.677	274.625	274.572	274.520	274.467
DFC RAIL LEVEL (PRL)	275.993	275.993	275.993	275.993	275.968	275.915	275.863	275.810	275.758	275.705	275.653	275.600	275.548	275.495	275.443	275.390	275.338	275.285	275.233	275.180
DFC TRACK CHAINAGE	1207904.6	1207924.6	1207944.6	1207964.6	1207984.6	1208004.6	1208024.6	1208044.6	1208064.6	1208084.6	1208104.6	1208124.6	1208144.6	1208164.6	1208184.6	1208204.6	1208224.6	1208244.6	1208264.6	1208284.6

L - SECTION

NOTE:-
1. DFC WORKS ARE SHOWN IN RED.
2. IR NEW WORKS ARE SHOWN IN VIOLET.
3. ALL DIMENSIONS ARE SHOWN IN METRES.
4. THIS DRAWING IS PREPARED BASED ON LATEST SURVEY DATA HELD ON APRIL-2022. GTS BENCH MARK OF 261.850M CONSIDERED ON TOP OF CANAL BRIDGE ABUTMENT AT DORANA VILLAGE ALONG THE NH1.
5. DFC NEW CHAINAGE OF 1075.950M IS WITH REFERENCE TO THE IR KM OF 187.500KM END OF KM OF CP-303(SECTION P-3 PILKHANI END) AGAINST THE EXISTING DFC CHAINAGE. 116277.742M ISSUED VIDE LETTER NO. COM/DFCC/MB/SURVEY/2021-301-230116-011173 DT. 17.01.2023.
6. BALLAST PROFILE HAS BEEN PROVIDED ACCORDING TO THE CLAUSE 1.11.3 OF STANDARD SCHEDULE OF DIMENSION(EASTERN CORRIDOR) & THE BALLAST CUSHION DIMENSION SHOWN IN 35CM ON GE-14 PARA 17. SPECIFICATIONS & RECOMMENDATIONS 2. TWO LAYER SYSTEM FIG.10.


REFERENCE DRAWINGS :-
1. FOR KEY PLAN REFER DRAWING NO. 301-2/AL/0001
2. FOR LEGEND AND ABBREVIATIONS REFER DRAWING NO. 301-2/AL/1000
3. FOR TYPICAL SECTION OF BALLAST PROFILE (FL-RL) REFER DRG. NO. 301-2/TK/TFD-004 (TR.1952)

REV.	DATE	REVISION DETAILS	PURPOSE OF ISSUE
0	18.09.2024	SUBMISSION OF AS-BUILT DRAWING	FOR APPROVAL

LEGEND:

SCALE
HOR - 1:1000
VER - 1:100
SHEET SIZE : A1

IR TRACK
DFCC TRACK
DFCC FUTURE PROPOSALS
STRUCTURE / BUILDING
DFCC TOE LINE
DFCC FORMATION
RETAINING WALL
ROAD
STREAM, DRAIN, NALA, CANAL.
FENCE
POWER LINES
TBM
ELECTRIC POLE/OHE MAST
IR RAILWAY BOUNDARY
DFCC BOUNDARY

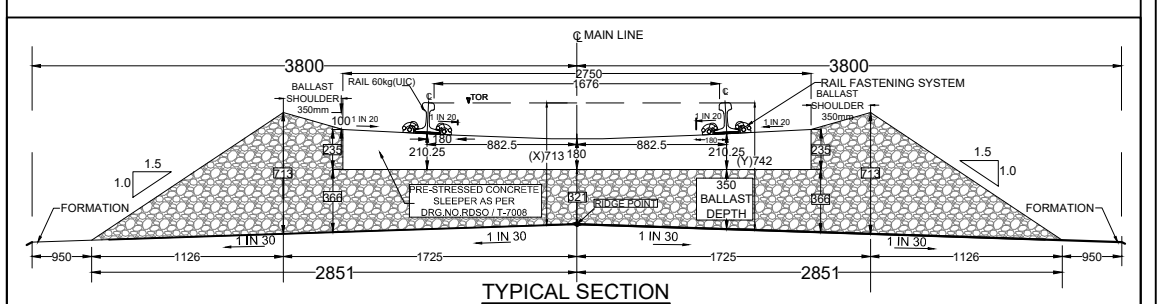

TRACK STRUCTURE		
RAIL SECTION: 60Kg/m (UIC 60Kg/m) DFC LINE: 60Kg/m (UIC 60Kg/m) IR MAIN LINE: 52Kg/m	Difference between FL- RL (Below Rail Seat)	
	IR Line	DFC
RUBBER PAD	172mm	172mm
SLEEPER DEPTH	6mm	10mm
BALLAST CUSHION	210mm	210mm
Total Depth (FL TO RL)	300mm	350mm

OWNER
DEDICATED FREIGHT CORRIDOR CORPORATION OF INDIA LTD.
(A GOVERNMENT OF INDIA ENTERPRISE)
PROJECT OFFICE/AMBALA UNIT: OLD RAILWAY COLONY (NEAR ANAND MARKET), AMBALA CANTT-133001.
CORPORATE IDENTITY NO. : U60232DL2006GGI155068

ENGINEER:
DB Engineering & Consulting GmbH
Deutsche Bahn Engineering & Consulting GmbH

CONTRACTOR:
GIL - TPL JV
GAR TATA

SUBMITTED BY	GIL - TPL JV		
	DATED	NAME	SIGNATURE
PREPARED BY			
CHECKED BY	18.09.2024	VIJAY PRATAP	
APPROVED BY	18.09.2024	PARASURAM KOTYADA	

APPROVED BY	DEUTSCHE BAHN ENGINEERING & CONSULTING GMBH		
	DATED	NAME	SIGNATURE
Sr. DE./CHIEF ENGINEER		SURESH K.YALANGI	
CHIEF TRACK ENGINEER		RAJ PAL SINGH	
T.L.		H.D. VIDJAK	



STAMP

AS-BUILT DRAWING
TR. Ref.....
ENGINEER Sign.:

EMPLOYER (DFCCIL): DEDICATED FREIGHT CORRIDOR CORPORATION OF INDIA LTD.

AS BUILT DRAWING		
TITLE	AS-BUILT PLAN AND PROFILE	DFCC APPR. NO. -
	DFC KM:1207.905 TO 1208.405 (DETOUR)	ENGG. APPR. NO. -
		DRG. NO. - 301-2/AL/A/1260
		SHEET NO. : 1 OF 1
		DATE : 18.09.2024
		STATUS
		A

TR.

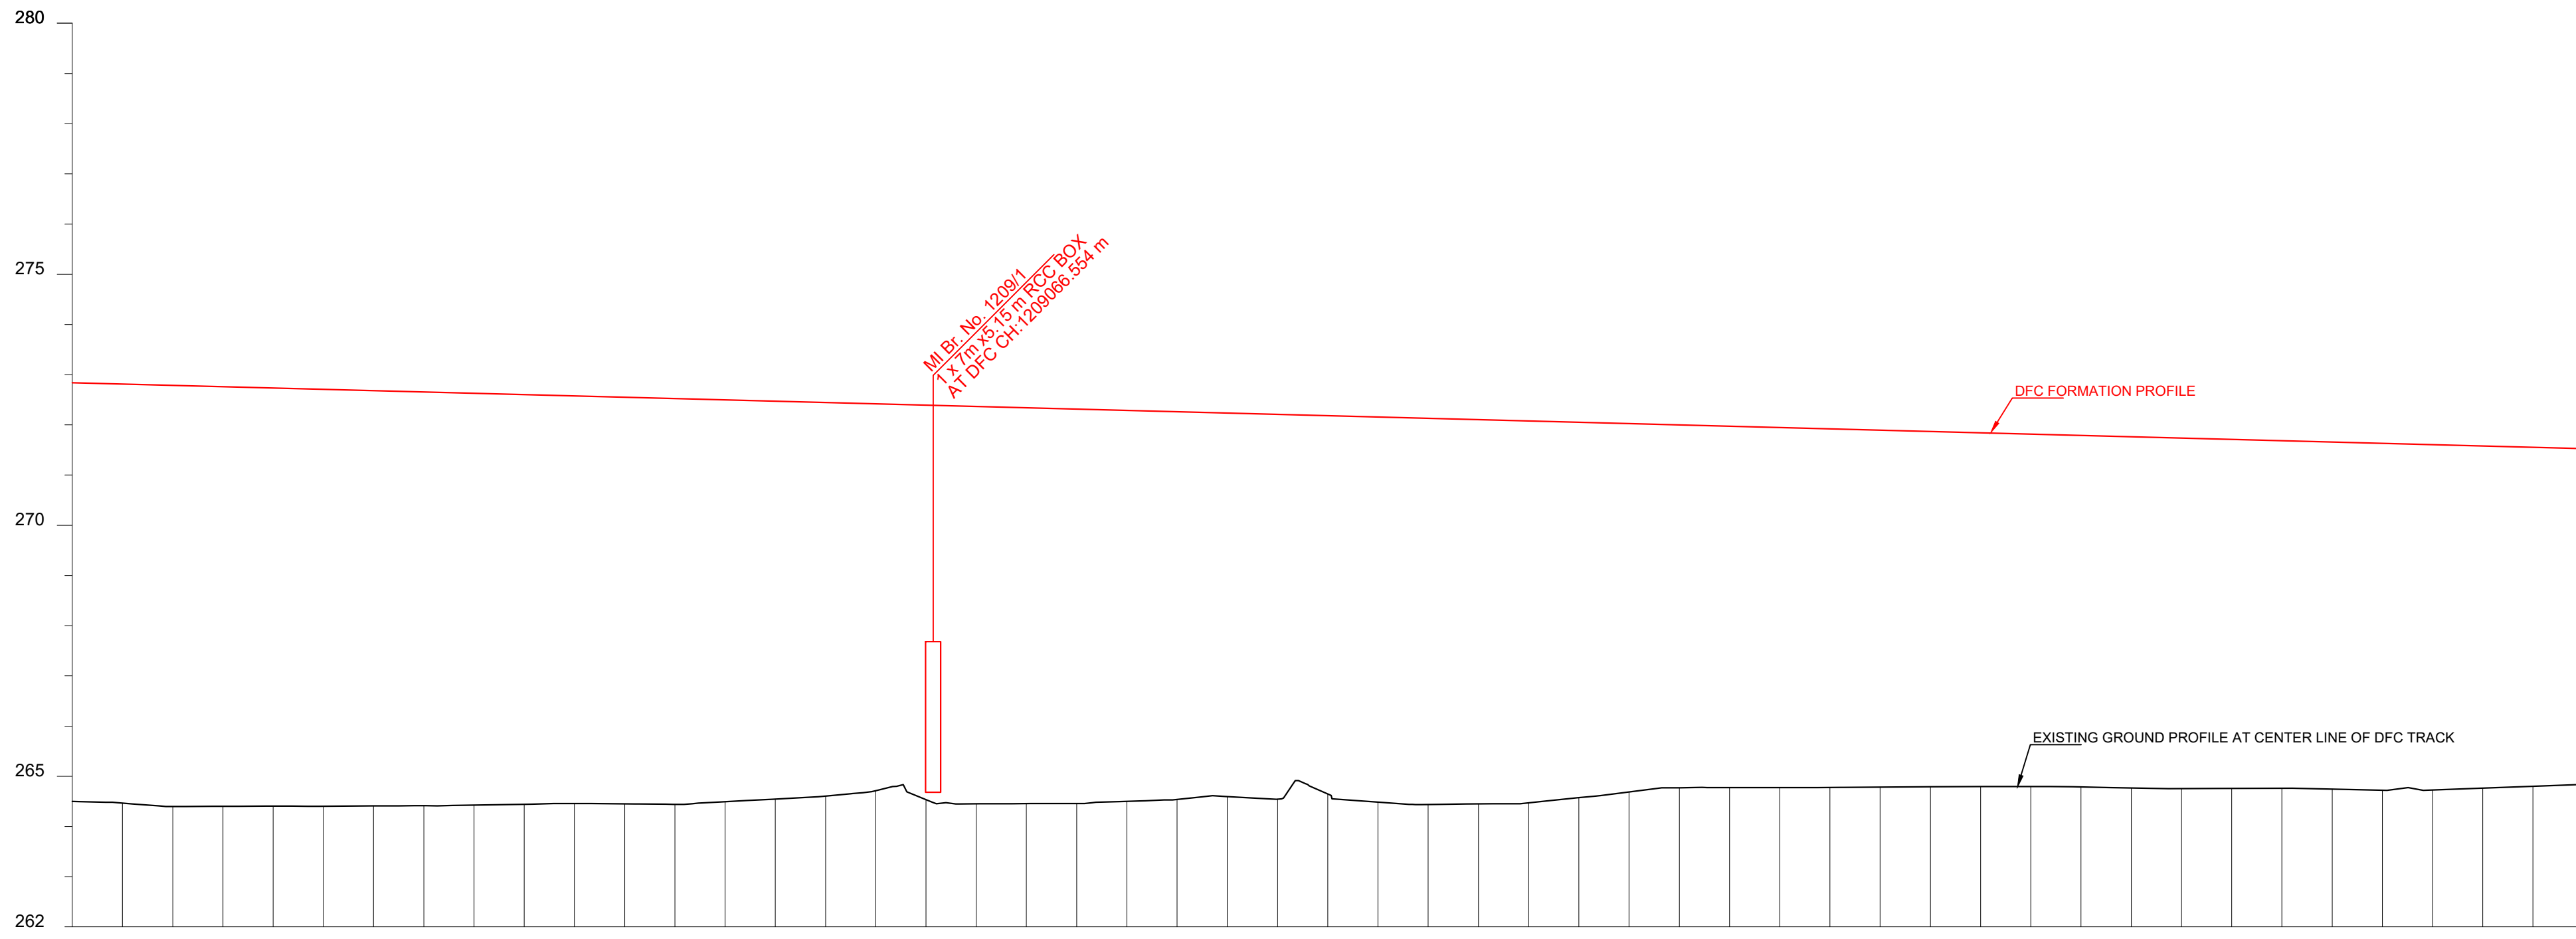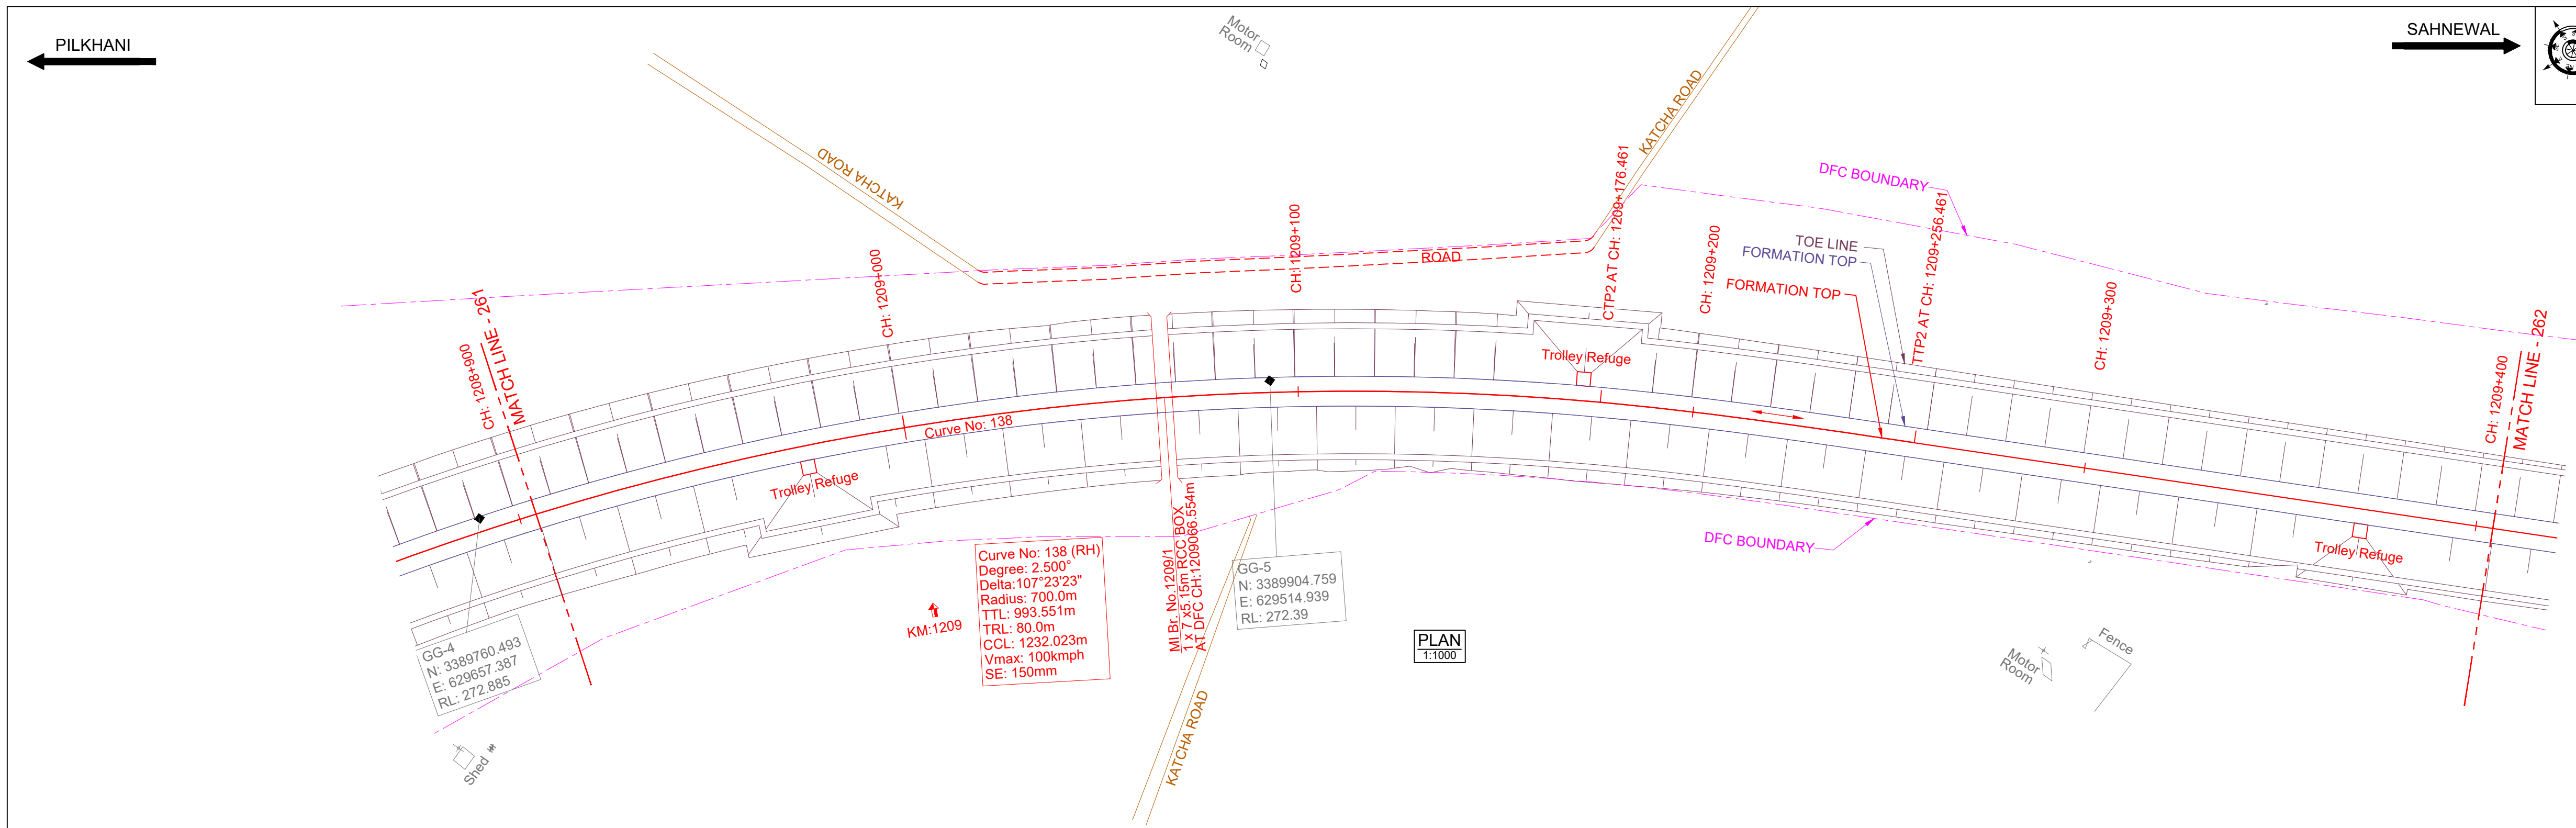


DATUM ABOVE MSL : 262 m

HORIZONTAL ALIGNMENT	R = 700m																			
VERTICAL ALIGNMENT	L = 1692.889 m 1 IN 381.150 F																			
HEIGHT OF BANKING(+) / DEPTH OF CUTTING(-) (PFL-GL)	+8.341	+8.391	+8.329	+8.274	+8.207	+8.120	+8.084	+7.926	+7.709	+7.917	+7.857	+7.724	+7.665	+7.675	+7.656	+7.478	+7.229	+7.173	+7.111	+7.047
EXG GROUND LEVEL AT CENTER LINE OF DFC TRACK (GL)	264.500	264.397	264.407	264.409	264.424	264.458	264.442	264.547	264.712	264.451	264.459	264.539	264.546	264.484	264.450	264.576	264.772	264.776	264.785	264.797
DFC FORMATION LEVEL (PFL)	272.841	272.788	272.736	272.683	272.631	272.578	272.526	272.473	272.421	272.366	272.316	272.263	272.211	272.159	272.106	272.054	272.001	271.949	271.896	271.844
DFC RAIL LEVEL (PRL)	273.554	273.501	273.449	273.396	273.344	273.291	273.239	273.187	273.134	273.082	273.029	272.977	272.924	272.872	272.819	272.767	272.714	272.662	272.609	272.557
DFC TRACK CHAINAGE	1208904.6	1208924.6	1208944.6	1208964.6	1208984.6	1209004.6	1209024.6	1209044.6	1209064.6	1209084.6	1209104.6	1209124.6	1209144.6	1209164.6	1209184.6	1209204.6	1209224.6	1209244.6	1209264.6	1209284.6

L - SECTION

SAHNEWAL

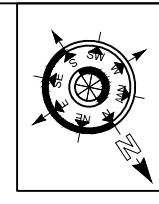

- NOTE:-
1. DFC WORKS ARE SHOWN IN RED.
 2. IR NEW WORKS ARE SHOWN IN VIOLET.
 3. ALL DIMENSIONS ARE SHOWN IN METRES.
 4. THIS DRAWING IS PREPARED BASED ON LATEST SURVEY DATA HELD ON APRIL-2022. GTS BENCH MARK OF 261.850M CONSIDERED ON TOP OF CANAL BRIDGE ABUTMENT AT DORANA VILLAGE ALONG THE NH1.
 5. DFC NEW CHAINAGE OF 1075.950M IS WITH REFERENCE TO THE IR KM OF 187.500KM END OF KM OF CP-303(SECTION P-3 PILKHANI END) AGAINST THE EXISTING DFC CHAINAGE. 116277.742M ISSUED VIDE LETTER NO. COM/DFCC/MB/SURVEY/2021-301-230116-011173 DT. 17.01.2023.
 6. BALLAST PROFILE HAS BEEN PROVIDED ACCORDING TO THE CLAUSE 1.11.3 OF STANDARD SCHEDULE OF DIMENSION(EASTERN CORRIDOR) & THE BALLAST CUSHION DIMENSION SHOWN IN 35CM ON GE-14 PARA 17. SPECIFICATIONS & RECOMMENDATIONS 2. TWO LAYER SYSTEM FIG.10.

- REFERENCE DRAWINGS :-
1. FOR KEY PLAN REFER DRAWING NO. 301-2/AL/0001
 2. FOR LEGEND AND ABBREVIATIONS REFER DRAWING NO. 301-2/AL/1000
 3. FOR TYPICAL SECTION OF BALLAST PROFILE (FL-RL) REFER DRG. NO. 301-2/TK/TFD/-004 (TR.1952)

0	18.09.2024	SUBMISSION OF AS-BUILT DRAWING	FOR APPROVAL
REV.	DATE	REVISION DETAILS	PURPOSE OF ISSUE

LEGEND:


SCALE

HOR - 1:1000

VER - 1:100

SHEET SIZE : A1

IR TRACK
DFCC TRACK
DFCC FUTURE PROPOSALS
STRUCTURE / BUILDING
DFCC TOE LINE
DFCC FORMATION
RETAINING WALL
ROAD
STREAM, DRAIN, NALA, CANAL.
FENCE
POWER LINES
TBM
ELECTRIC POLE/OHE MAST
IR RAILWAY BOUNDARY
DFCC BOUNDARY

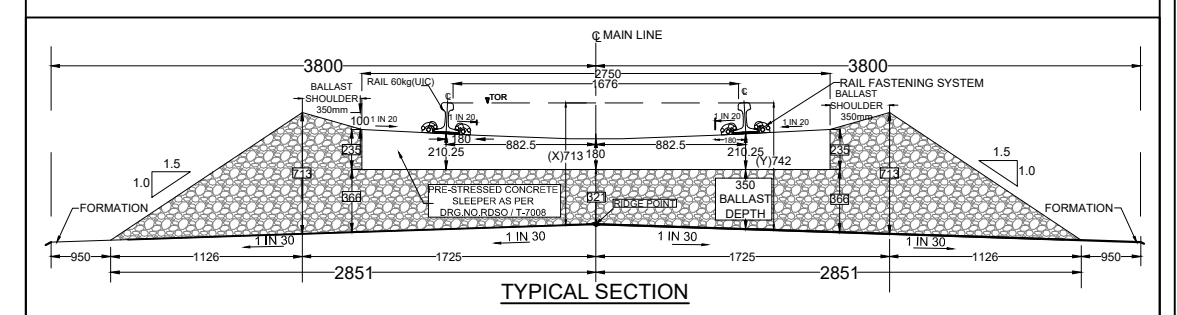

TRACK STRUCTURE		
RAIL SECTION: 60Kg/m (UIC 60Kg/m) DFC LINE: 60Kg/m (UIC 60Kg/m) IR MAIN LINE: 52Kg/m	Difference between FL- RL (Below Rail Seat)	
	IR Line	DFC
RUBBER PAD	172mm	172mm
SLEEPER DEPTH	6mm	10mm
BALLAST CUSHION	210mm	210mm
	300mm	350mm
Total Depth (FL TO RL)	688mm	742mm

OWNER: DEDICATED FREIGHT CORRIDOR CORPORATION OF INDIA LTD.
(A GOVERNMENT OF INDIA ENTERPRISE)
PROJECT OFFICE/AMBALA UNIT: OLD RAILWAY COLONY (NEAR ANAND MARKET),AMBALA CANTT.-133001.
CORPORATE IDENTITY NO. : U60232DL2006GGI155068

ENGINEER: DB Engineering & Consulting GmbH
Deutsche Bahn Engineering & Consulting GmbH

CONTRACTOR: GIL - TPL JV
GAR TATA

SUBMITTED BY	GIL - TPL JV		
	DATED	NAME	SIGNATURE
PREPARED BY			
CHECKED BY	18.09.2024	VIJAY PRATAP	
APPROVED BY	18.09.2024	PARASURAM KOTYADA	

APPROVED BY	DEUTSCHE BAHN ENGINEERING & CONSULTING GMBH		
	DATED	NAME	SIGNATURE
Sr. DE./CHIEF ENGINEER		SURESH K.YALANGI	
CHIEF TRACK ENGINEER		RAJ PAL SINGH	
T.L.		H.D. VIDJAK	

STAMP

AS-BUILT DRAWING
TR. Ref.....
ENGINEER Sign.:

EMPLOYER (DFCCIL): DEDICATED FREIGHT CORRIDOR CORPORATION OF INDIA LTD.

AS BUILT DRAWING

TITLE: AS-BUILT PLAN AND PROFILE

DFCC APPR. NO. -

ENGG. APPR. NO. -

DRG. NO. - 301-2/AL/A/1262

SHEET NO. : 1 OF 1

DATE : 18.09.2024

STATUS: A