
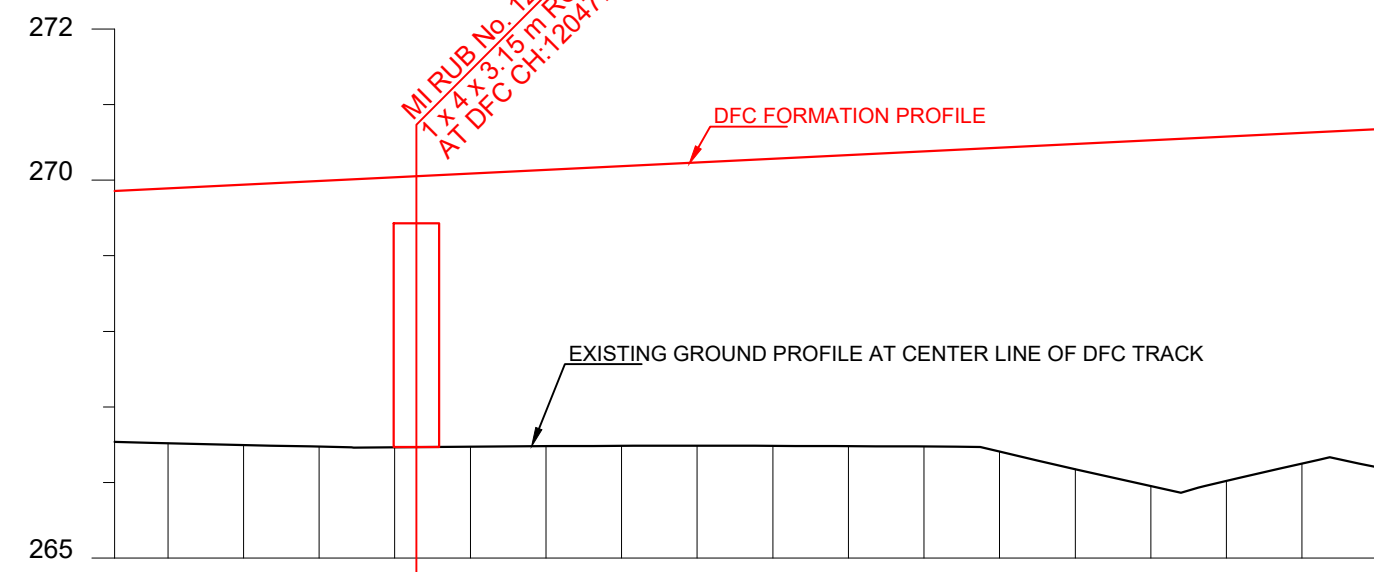
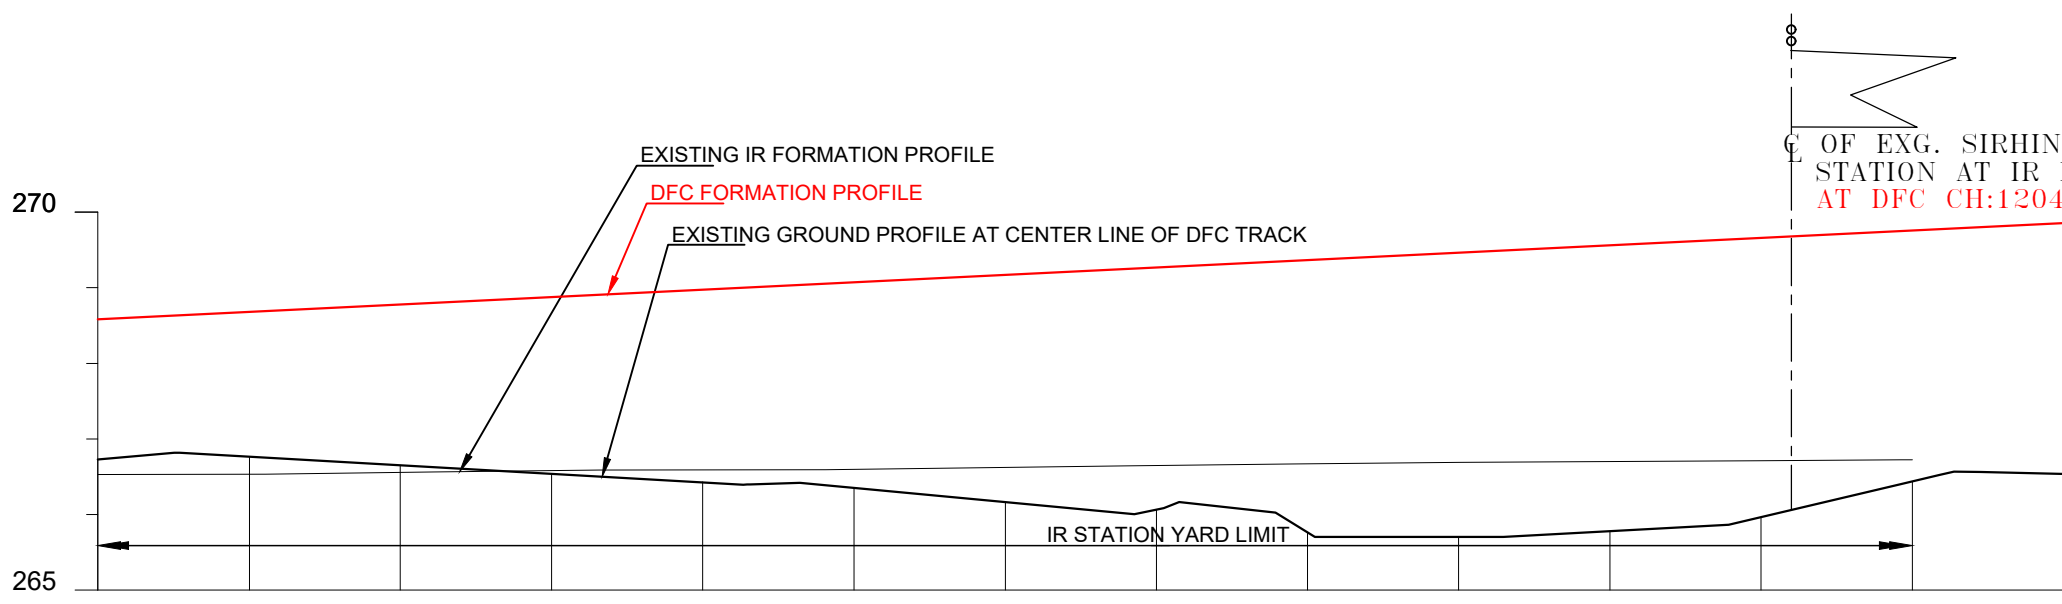
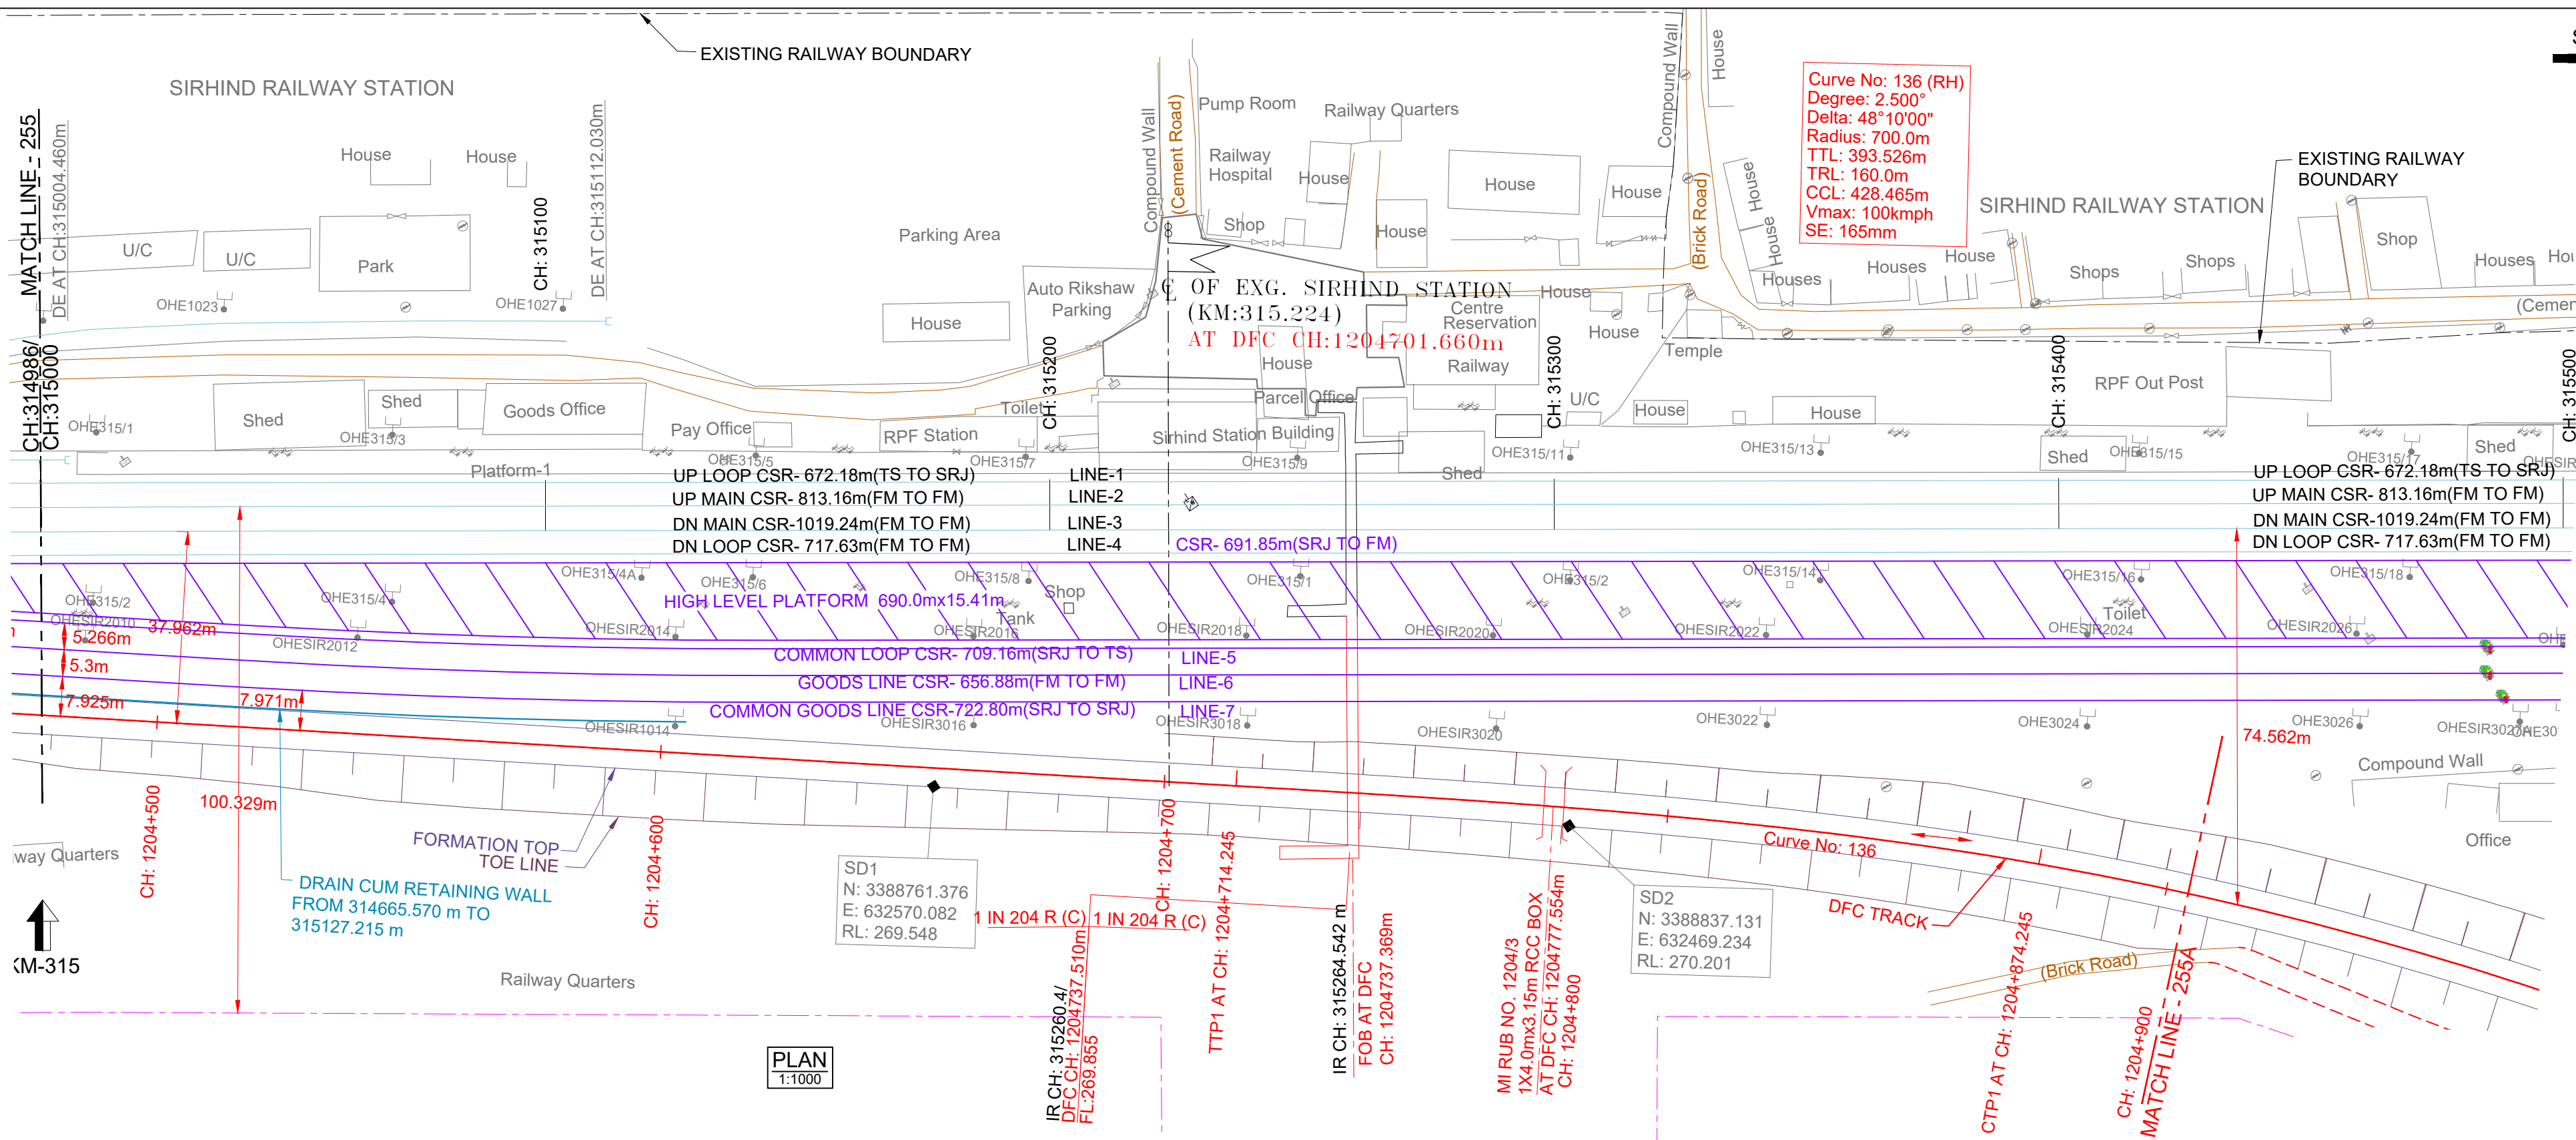


PILKHANI

EXISTING RAILWAY BOUNDARY

SAHNEWAL

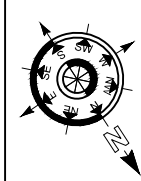

DATUM ABOVE MSL : 265 m

DATUM ABOVE MSL : 265 m

HORIZONTAL ALIGNMENT	L = 654.990m TL= 160m															
VERTICAL ALIGNMENT	L=188.755 m 1 IN 204.286 R															
TRACK DISTANCE FROM EXISTING NEAREST IR DN MAIN LINE TO DFC MAIN LINE	36.342	37.618	38.837	40.057	41.288	42.478	43.692	44.902	46.106	47.310	48.516	49.721	50.920	52.140	53.349	54.548
HEIGHT OF BANKING(+)/ DEPTH OF CUTTING(-) (PFL-GL)	+1.851	+1.913	+2.125	+2.337	+2.549	+2.718	+3.006	+3.201	+3.610	+3.758	+3.780	+3.689	+3.312	+3.319	+3.319	+3.319
EXG GROUND LEVEL AT CENTER LINE OF DFC TRACK (GL)	266.730	266.766	266.652	266.538	266.424	266.353	266.163	266.066	265.755	265.340	265.705	265.970	266.445	266.536	266.536	266.536
EXG GROUND LEVEL AT TOE LOCATION OF DFC TRACK	265.628	265.276	265.047	264.495	264.180	264.210	264.314	264.506	264.884	265.340	265.796	266.251	266.512	266.464	266.464	266.464
DIFFERENCE BETWEEN DFC FORMATION LEVEL AND EXG FORMATION LEVEL (PFL-EFL)	2.051	2.145	2.221	2.295	2.384	2.474	2.546	2.620	2.696	2.771	2.858	2.946	3.031	3.120	3.120	3.120
DFC FORMATION LEVEL (PFL)	268.581	268.679	268.777	268.875	268.973	269.071	269.169	269.267	269.365	269.463	269.561	269.659	269.757	269.855	269.855	269.855
EXG FORMATION LEVEL OF EXG IR DN MAIN LINE (EFL)	266.530	266.534	266.556	266.580	266.589	266.597	266.623	266.647	266.669	266.692	266.703	266.713	266.726	266.737	266.737	266.737
DIFFERENCE BETWEEN DFC RAIL LEVEL AND EXG. RAIL LEVEL (PRL - ERL)	2.092	2.187	2.261	2.336	2.425	2.515	2.588	2.661	2.737	2.812	2.900	2.987	3.073	3.161	3.161	3.161
DFC RAIL LEVEL (PRL)	269.204	269.302	269.49	269.588	269.686	269.784	269.882	269.98	270.078	270.176	270.274	270.372	270.471	270.570	270.570	270.570
EXG RAIL LEVEL OF NEAREST IR DN MAIN LINE (ERL)	267.202	267.206	267.228	267.252	267.261	267.269	267.295	267.319	267.341	267.364	267.375	267.385	267.398	267.409	267.409	267.409
EQUIVALENT CHAINAGE ON DFC TRACK	1204477.3	1204497.3	1204517.2	1204537.3	1204557.3	1204577.3	1204597.4	1204617.4	1204637.4	1204657.5	1204677.5	1204697.5	1204717.6	1204737.9	1204757.9	1204777.9
EXISTING IR CHAINAGE	314985.7	315000.0	315020.0	315040.0	315060.0	315080.0	315100.0	315120.0	315140.0	315160.0	315180.0	315200.0	315220.0	315240.0	315260.0	315280.0

L - SECTION

HORIZONTAL ALIGNMENT	TL = 160m R = 700m															
VERTICAL ALIGNMENT	L=188.755 m 1 IN 204.286 R															
HEIGHT OF BANKING(+)/ DEPTH OF CUTTING(-) (PFL-GL)	+3.321	+3.370	+3.513	+3.610	+3.699	+3.796	+3.903	+4.297	+4.555	+4.471	+4.471	+4.471	+4.471	+4.471	+4.471	+4.471
EXG GROUND LEVEL AT CENTER LINE OF DFC TRACK (GL)	266.536	266.520	266.474	266.475	266.484	266.485	266.476	266.180	266.020	266.202	266.202	266.202	266.202	266.202	266.202	266.202
DFC FORMATION LEVEL (PFL)	269.857	269.890	269.988	270.085	270.183	270.281	270.379	270.477	270.575	270.673	270.673	270.673	270.673	270.673	270.673	270.673
DFC RAIL LEVEL (PRL)	270.570	270.603	270.701	270.798	270.896	270.994	271.092	271.190	271.288	271.386	271.386	271.386	271.386	271.386	271.386	271.386
DFC TRACK CHAINAGE	1204737.9	1204744.6	1204764.6	1204784.6	1204804.6	1204824.6	1204844.6	1204864.6	1204884.6	1204904.6	1204924.6	1204944.6	1204964.6	1204984.6	1205004.6	1205024.6

L - SECTION FOR DETOUR

- NOTE:-
- DFCC WORKS ARE SHOWN IN RED.
 - IR NEW WORKS ARE SHOWN IN VIOLET.
 - ALL DIMENSIONS ARE SHOWN IN METRES.
 - THIS DRAWING IS PREPARED BASED ON LATEST SURVEY DATA HELD ON APRIL-2022. GTS BENCH MARK OF 261.850M CONSIDERED ON TOP OF CANAL BRIDGE ABUTMENT AT DORANA VILLAGE ALONG THE NH1.
 - DFC NEW CHAINAGE OF 1075.950M IS WITH REFERENCE TO THE IR KM OF 187.500KM END OF KM OF CP-303 (SECTION P-3 PILKHANI END) AGAINST THE EXISTING DFC CHAINAGE. 116277.742M ISSUED VIDE LETTER NO. COM/DFCC/MB/SURVEY/2021-301-2301/16-01/173.DT. 17.01.2023.
 - BALLAST PROFILE HAS BEEN PROVIDED ACCORDING TO THE CLAUSE 1.11.3 OF STANDARD SCHEDULE OF DIMENSION (EASTERN CORRIDOR) & THE BALLAST CUSHION DIMENSION SHOWN IN 35CM ON GE-14 PARA 17. SPECIFICATIONS & RECOMMENDATIONS 2. TWO LAYER SYSTEM FIG.10.

REFERENCE DRAWINGS:-

- FOR KEY PLAN REFER DRAWING NO. 301-2/AL/0001
- FOR LEGEND AND ABBREVIATIONS REFER DRAWING NO. 301-2/AL/1000
- FOR TYPICAL SECTION OF BALLAST PROFILE (FL-RL) REFER DRG. NO. 301-2/TK/TFD/004 (TR.1952)

REV.	DATE	REVISION DETAILS	PURPOSE OF ISSUE
0	18.09.2024	SUBMISSION OF AS-BUILT DRAWING	FOR APPROVAL

LEGEND:

SCALE

HOR - 1:1000

VER - 1:100

SHEET SIZE : A1

IR TRACK

DFCC TRACK

DFCC FUTURE PROPOSALS

STRUCTURE / BUILDING

DFCC TOE LINE

DFCC FORMATION

RETAINING WALL

ROAD

STREAM, DRAIN, NALA, CANAL

FENCE


POWER LINES

TBM

ELECTRIC POLE/OHE MAST

IR RAILWAY BOUNDARY

DFCC BOUNDARY

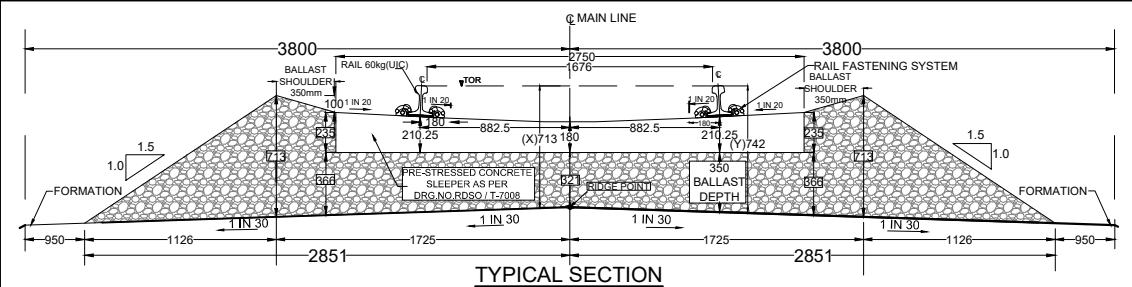

TRACK STRUCTURE		
RAIL SECTION: 60Kg/m (UIC 60Kg/m) DFC LINE: 60Kg/m (UIC 60Kg/m) IR MAIN LINE: 52Kg/m	Difference between FL - RL (Below Rail Seat)	
	IR Line	DFC
RUBBER PAD	172mm	172mm
SLEEPER DEPTH	210mm	210mm
BALLAST CUSHION	300mm	350mm
Total Depth (FL TO RL)	688mm	742mm

OWNER

DEDICATED FREIGHT CORRIDOR CORPORATION OF INDIA LTD.

(A GOVERNMENT OF INDIA ENTERPRISE)

PROJECT OFFICE (AMBALA UNIT): OLD RAILWAY COLONY (NEAR ANAND MARKET), AMBALA CANTT-133001.

CORPORATE IDENTITY NO. : U60232DL2006GGI155068

ENGINEER:

DB Engineering & Consulting GmbH

Deutsche Bahn Engineering & Consulting GmbH

CONTRACTOR:

GIL - TPL JV

GAR TATA

SUBMITTED BY	GIL - TPL JV		
DATED	NAME	SIGNATURE	
18.09.2024	VIJAY PRATAP		
18.09.2024	PARASURAM KOTYADA		

APPROVED BY	DEUTSCHE BAHN ENGINEERING & CONSULTING GMBH		
DATED	NAME	SIGNATURE	
	SURESH K.YALANGI		
	RAJ PAL SINGH		
T.L.	H.D. VIDJAK		

STAMP

AS-BUILT DRAWING

TR. Ref.

ENGINEER Sign.:

EMPLOYER (DFCCIL): DEDICATED FREIGHT CORRIDOR CORPORATION OF INDIA LTD.

AS BUILT DRAWING		
TITLE		
AS-BUILT PLAN AND PROFILE		
FROM IR KM: 315.000 TO 315.260		
DFC KM: 1204.477 TO 1204.905		
(DETOUR START FROM KM: 1204.738)		
DFCC APPR. NO. -	ENGG. APPR. NO. -	STATUS
DRG. NO. - 301-2/AL/A/1255A	SHEET NO. : 1 OF 1	
DATE : 18.09.2024		A

TR.