
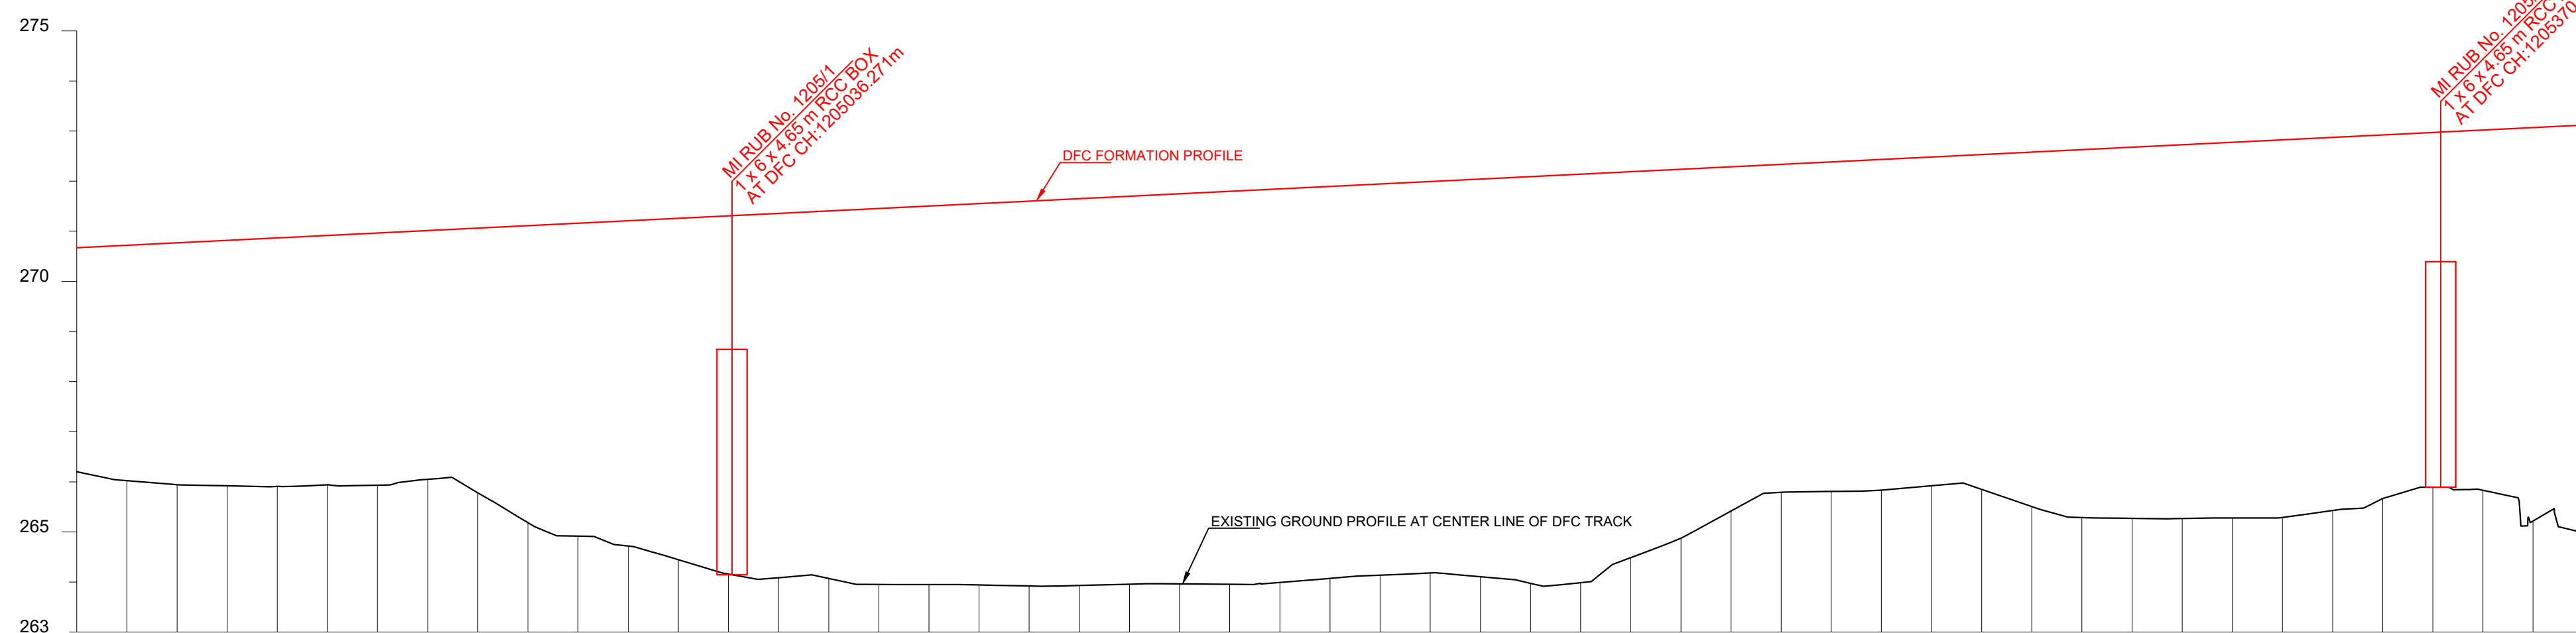
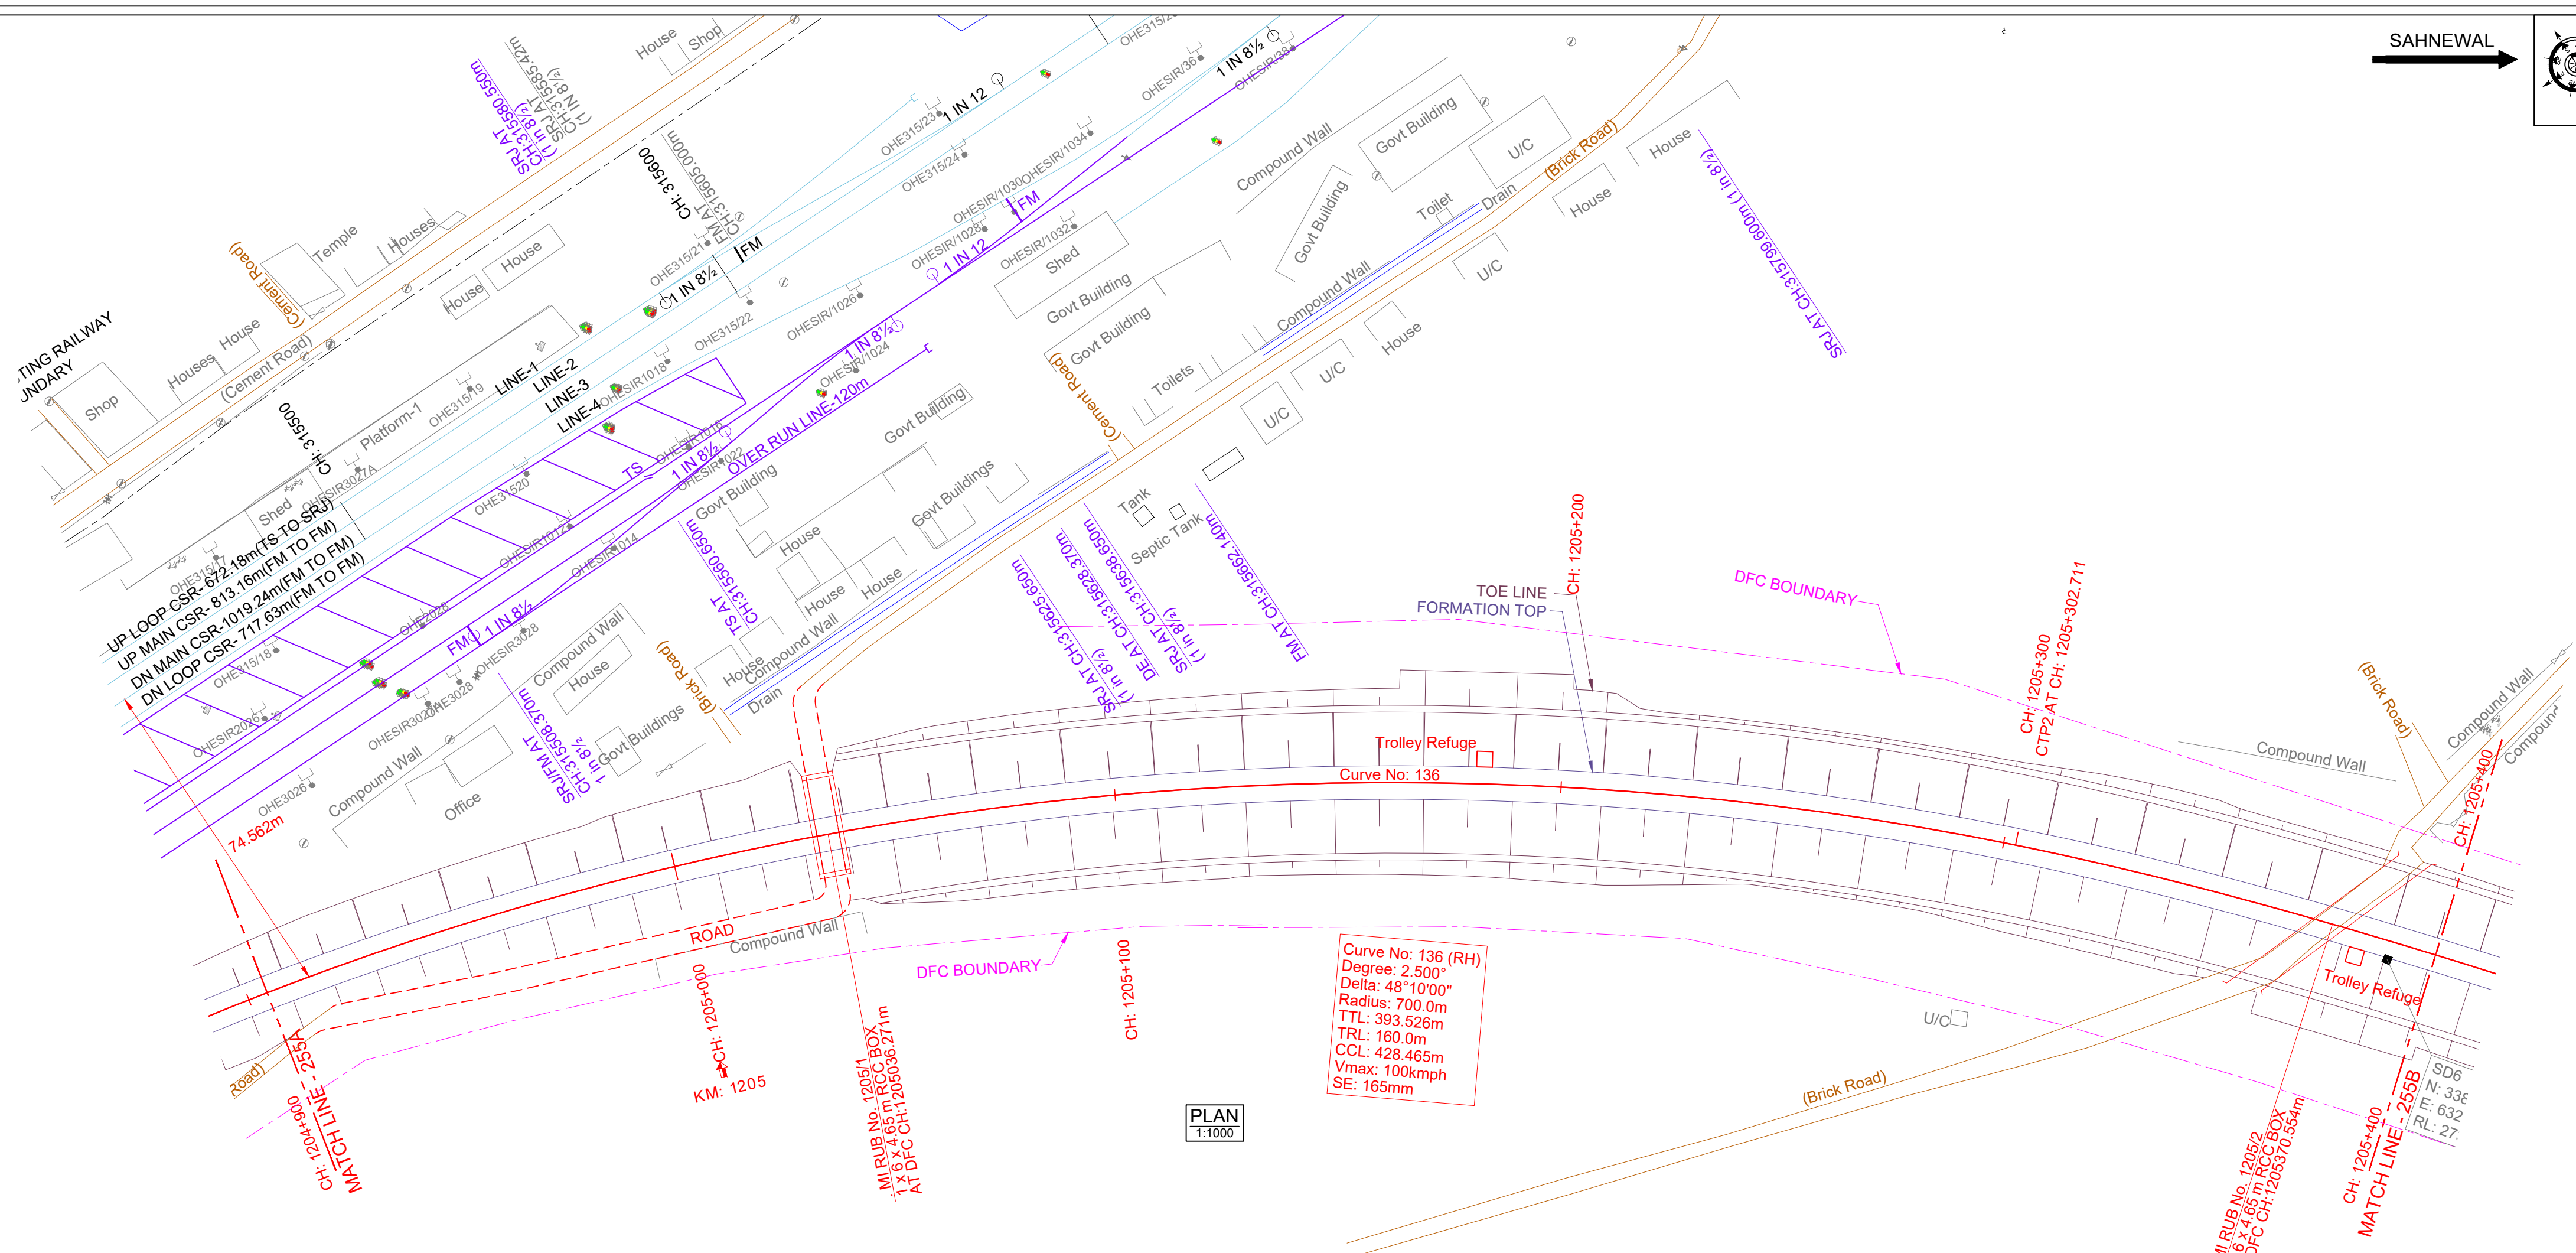


[illegible]

L - SECTION

SAHNEWAL

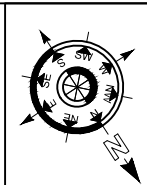


- NOTE:-**
- DRG NO.-301-2/AL/12/555
-
1. DFFC WORKS ARE SHOWN IN **RED**.
 2. IR NEW WORKS ARE SHOWN IN **VIOLET**.
 3. ALL DIMENSIONS ARE SHOWN IN METRES.
 4. THE DRAWING IS PREPARED BASED ON LATEST SURVEY DATA HELD ON APRIL-2022. GTS BENCH MARK OF 261.850M CONSIDERED ON TOP OF CANAL BRIDGE ABUTMENT AT DORAHA VILLAGE ALONG THE NH1.
 5. DFC NEW DIMENSION OF 1075.950M IS WITH REFERENCE TO THE IR KM OF 187.500KME END OF KM OF CP-303(SECTION P-3 PLUKHANI) END AGAINST THE EXISTING DFC CHAINAGE. 116277.742M ISSUED VIVID LETTER NO. CM/GMDFCO/CHM/SURVEY/2021-301-23011611173 DT. 17.01.2023
 6. BALLAST PAVEMENT HAS BEEN PROVIDED ACCORDING TO THE CLAUSE 11.1.3 OF STANDARD SCHEDULE OF MATERIALS(EASTERN CORRIDOR) & THE BALLAST CUSHION DIMENSION SHOWN IN 35CM ON GE-1. PARALL 177. SPECIFICATIONS & RECOMMENDATIONS 2. TWO LAYER SYSTEM OF 10.00 CM

REFERENCE DRAWINGS :-


1. FOR KEY PLAN REFER DRAWING NO. 301-2/AL/0001
2. FOR LEGEND AND ABBREVIATIONS REFER DRAWING NO. 301-2/AL/1000
3. FOR TYPICAL SECTION OF BALLAST PROFILE (FL-RL) REFFER DRG. NO. 301-2/TK/TFD/-004 (TR.1952)

0	18.09.2024	SUBMISSION OF AS-BUILT DRAWING	FOR APPROVAL
REV.	DATE	REVISION DETAILS	PURPOSE OF ISSUE

LEGEND

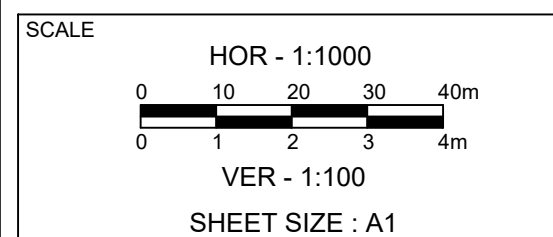

-
- IR TRACK
 DFCC TRACK
 DFCC FUTURE PROPOSALS
 STRUCTURE / BUILDING
 DFCC TOE LINE
 DFCC FORMATION
 RETAINING WALL
 ROAD
 STREAM, DRAIN, NALA, CANAL,
 FENCE
 POWER LINES
 TBM
 ELECTRIC POLE/OHE MAST
 IR RAILWAY BOUNDARY
 DFCC BOUNDARY
- The legend defines the following symbols:
 - IR TRACK: Solid black line.
 - DFCC TRACK: Dashed blue line.
 - DFCC FUTURE PROPOSALS: Dashed red line.
 - STRUCTURE / BUILDING: Red hatched area.
 - DFCC TOE LINE: Solid purple line.
 - DFCC FORMATION: Solid blue line.
 - RETAINING WALL: Solid orange line.
 - ROAD: Solid black line with cross-ticks.
 - STREAM, DRAIN, NALA, CANAL, FENCE: Wavy blue line.
 - POWER LINES: Line with cross-ticks.
 - TBM: Circle with 'TBM' text and a downward arrow.
 - ELECTRIC POLE/OHE MAST: Circle with a cross.
 - IR RAILWAY BOUNDARY: Dashed black line.
 - DFCC BOUNDARY: Dashed purple line.

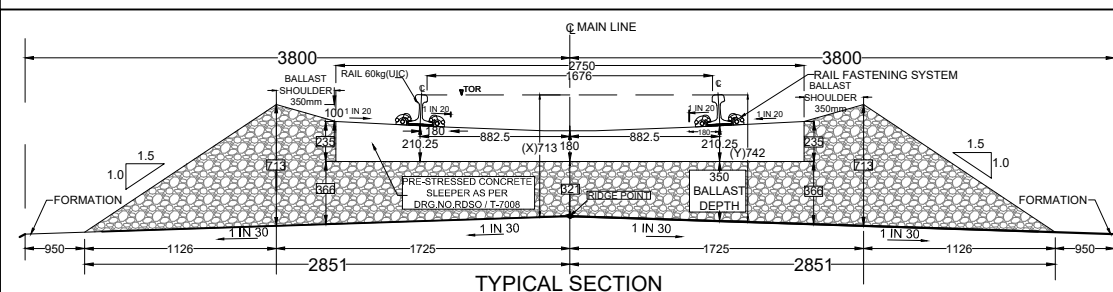

TRACK STRUCTURE		
RAIL SECTION: 60Kg/m (UIC 60Kg/m) DFC LINE: 60Kg/m (UIC 60Kg/m) IR MAIN LINE: 52Kg/m	Difference between FL- RL (Below Rail Seat)	
	IR Line	DFC
	172mm	172mm
RUBBER PAD	6mm	10mm
SLEEPER DEPTH	210mm	210mm
BALLAST CUSHION	300mm	350mm
Total Depth (FL TO RL)	688mm	742mm

OWNER	DEDICATED FREIGHT CORRIDOR CORPORATION OF INDIA LTD.
-------	--



DEDICATED FREIGHT CORRIDOR CORPORATION OF INDIA LTD.
(A GOVERNMENT OF INDIA ENTERPRISE)
PROJECT OFFICE (AMBALA UNIT): OLD RAILWAY COLONY (NEAR
ANAND MARKET), AMBALA CANTT-133001.
CORPORATE IDENTITY NO. : U60232DL2006GOI155068

ENGINEER



DB Engineering & Consulting GmbH
Deutsche Bahn Engineering & Consulting GmbH

CONTRACTOR

GIL - TPL JV



SUBMITTED BY	GIL - TPL JV		
	DATED	NAME	SIGNATURE
PREPARED BY			
CHECKED BY	18.09.2024	VIJAY PRATAP	
APPROVED BY	18.09.2024	PARASURAM KOTYADA	

APPROVED BY	DEUTSCHE BAHN ENGINEERING & CONSULTING GMBH
-------------	---

	DATED	NAME	SIGNATURE
Sr. DE./CHIEF ENGINEER		SURESH K YALANGI	
CHIEF TRACK ENGINEER		RAJ PAL SINGH	
T.L.		H.D. VIDJAK	

STAMP

AS-BUILT DRAWING
TR. Ref.....
ENGINEER Sign.:

EMPLOYER (DFCCIL):

DEDICATED FREIGHT CORRIDOR CORPORATION OF INDIA LTD

AS BUILT DRAWING

TITLE

AS-BUILT PLAN AND PROFILE

DFC KM:1204.905 TO 1205.405
(DETOUR)

DFCC APPR. NO. -

ENGG. APPR. NO. -
DRG. NO. - 301-2/AL/A/1255B

SHEET NO. : 1 OF 1
DATE : 18.09.2024

STATUS

TR
