
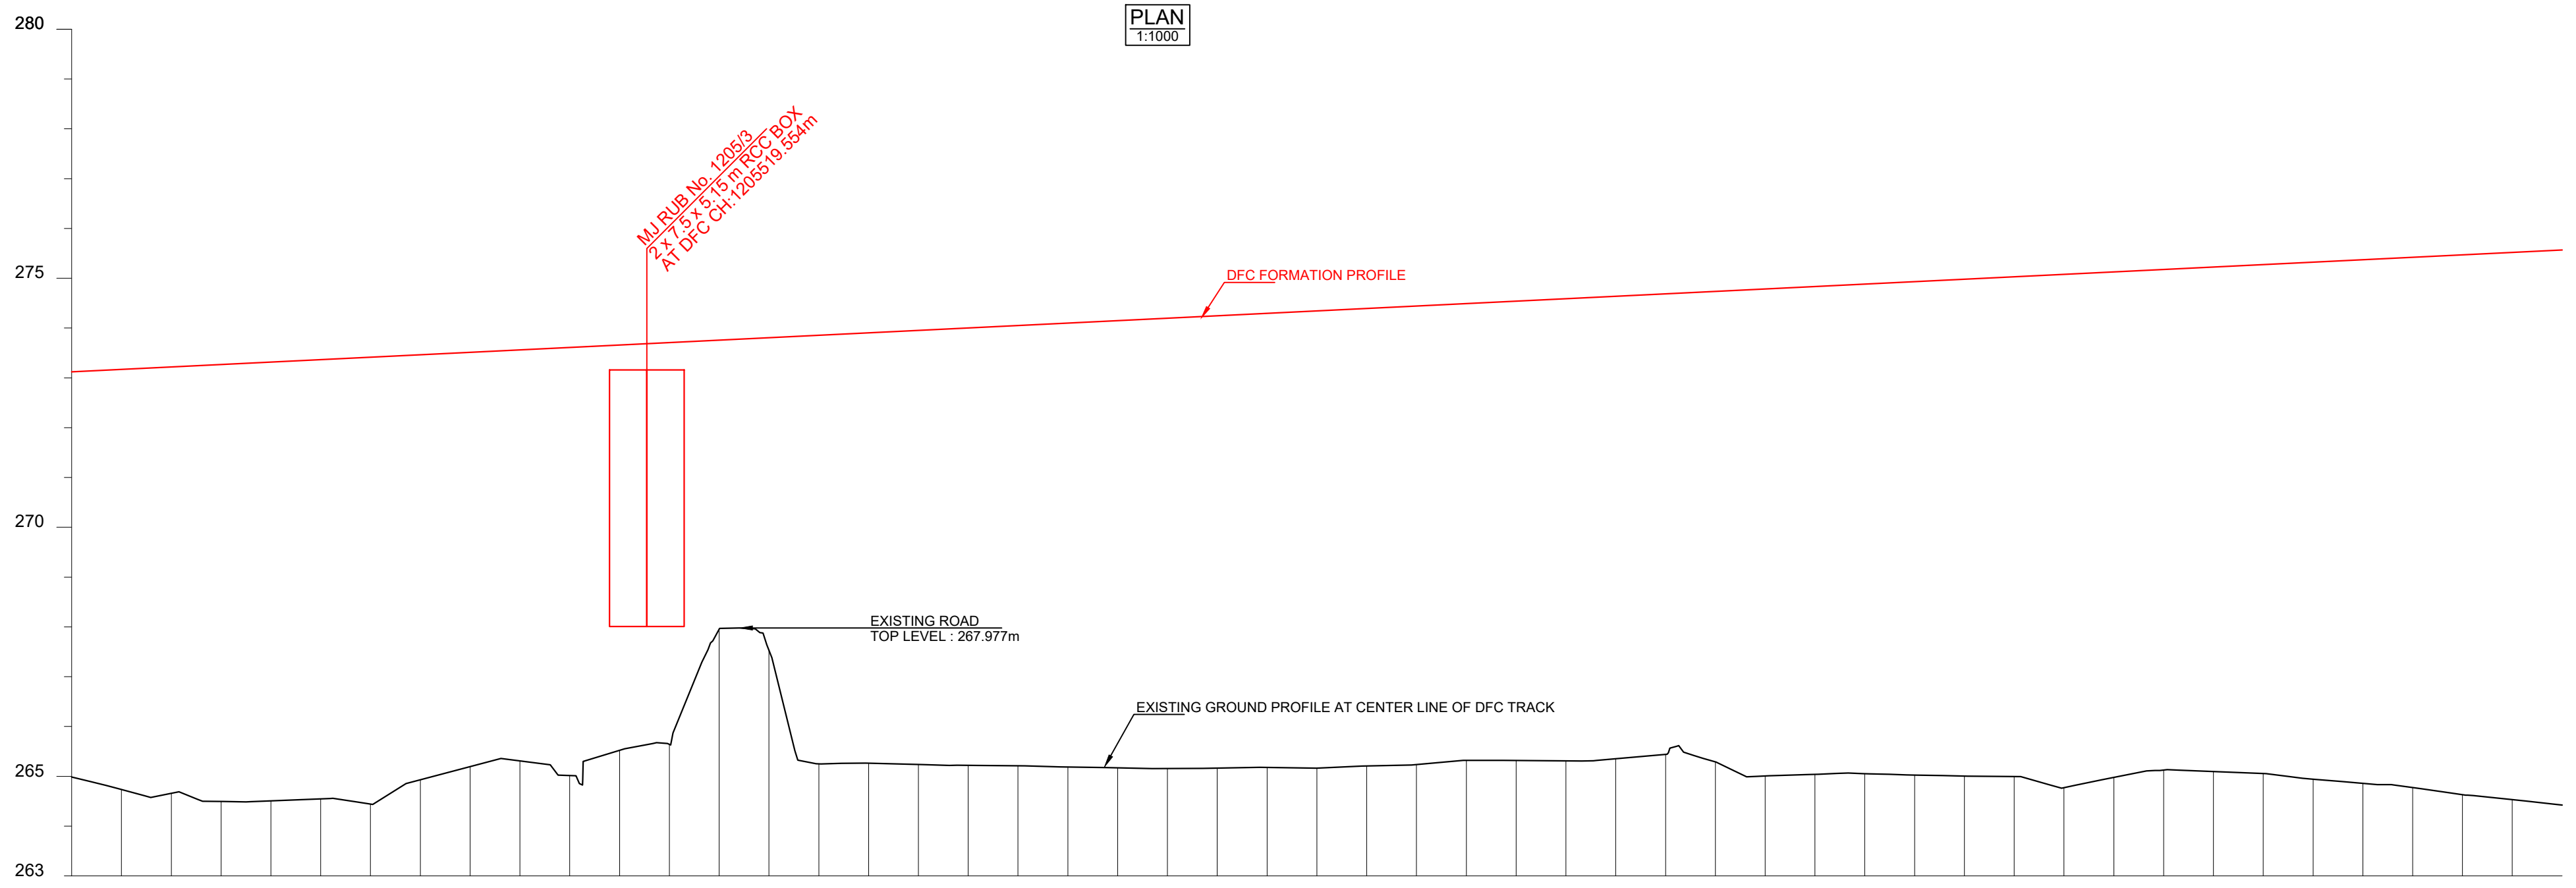


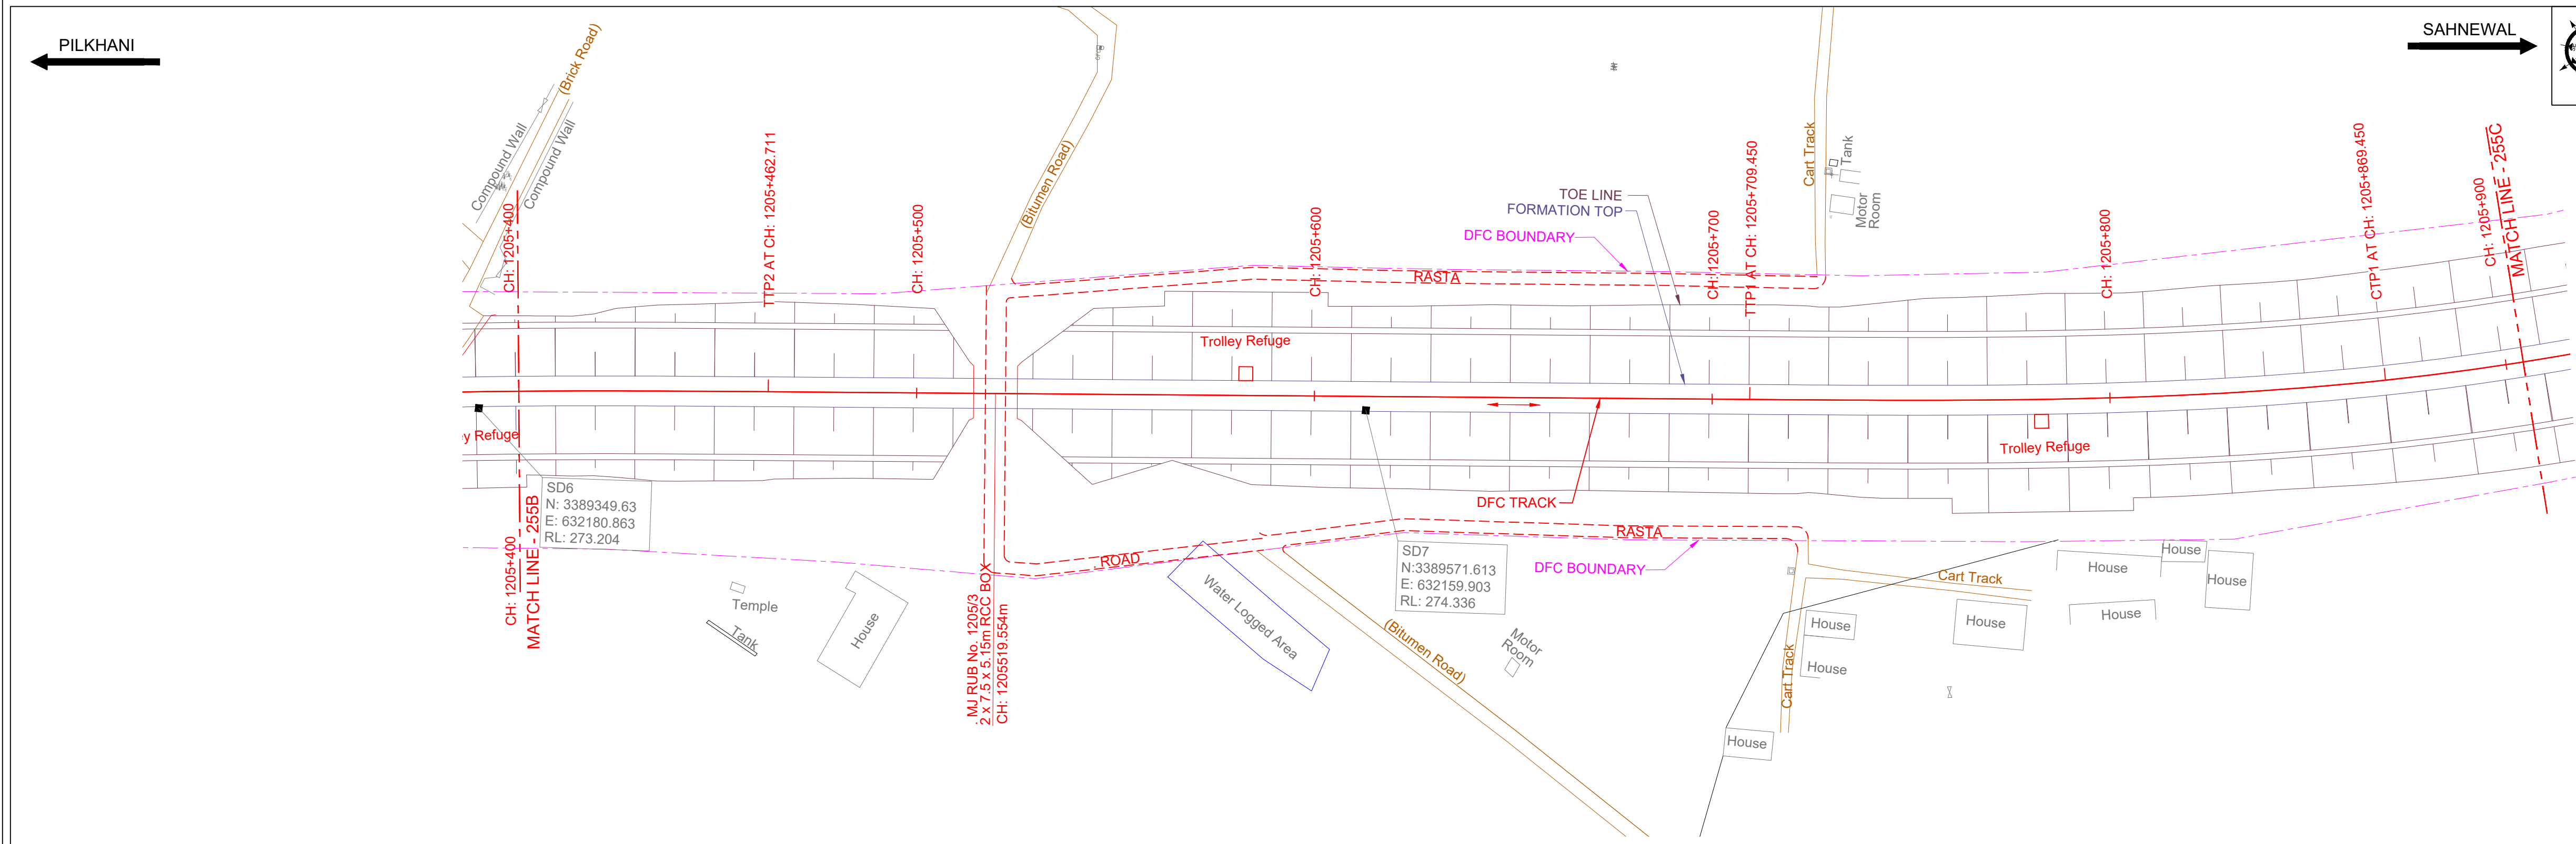

HORIZONTAL ALIGNMENT	TL = 160m L = 246.740m TL = 160m R = 700m																			
VERTICAL ALIGNMENT	L=1887.555 m 1 IN 204.286 R																			
HEIGHT OF BANKING(+) / DEPTH OF CUTTING(-) (PFL-GL)	+8.136	+8.559	+8.808	+8.972	+8.316	+8.595	+8.067	+6.276	+8.640	+8.782	+8.912	+9.041	+9.118	+9.187	+9.170	+9.281	+9.246	+9.779	+9.828	+9.975
EXG GROUND LEVEL AT CENTER LINE OF DFC TRACK (GL)	264.984	264.659	264.508	264.442	265.196	265.015	265.641	267.530	265.263	265.219	265.187	265.156	265.177	265.206	265.321	265.308	265.441	265.006	265.054	265.005
DFC FORMATION LEVEL (PFL)	273.120	273.218	273.316	273.414	273.512	273.610	273.708	273.806	273.903	274.001	274.099	274.197	274.295	274.393	274.491	274.589	274.687	274.785	274.882	274.980
DFC RAIL LEVEL (PRL)	273.933	273.931	274.029	274.127	274.225	274.323	274.421	274.519	274.617	274.715	274.812	274.910	275.008	275.106	275.204	275.302	275.400	275.498	275.596	275.694
DFC TRACK CHAINAGE	1205404.6	1205424.6	1205444.6	1205464.6	1205484.6	1205504.6	1205524.6	1205544.6	1205564.6	1205584.6	1205604.6	1205624.6	1205644.6	1205664.6	1205684.6	1205704.6	1205724.6	1205744.6	1205764.6	1205784.6

L - SECTION

DRG NO.-301-2/AL/A/1255C

NOTE:-

- DFCC WORKS ARE SHOWN IN RED.
- IR NEW WORKS ARE SHOWN IN VIOLET.
- ALL DIMENSIONS ARE SHOWN IN METRES.
- THIS DRAWING IS PREPARED BASED ON LATEST SURVEY DATA HELD ON APRIL-2022. GTS BENCH MARK OF 261.850M CONSIDERED ON TOP OF CANAL BRIDGE ABUTMENT AT DORAHA VILLAGE ALONG THE NH1.
- DFC NEW CHAINAGE OF 1075.950M IS WITH REFERENCE TO THE IR KM OF 187.500KM END OF KM OF CP-303(SECTION P-3 PILKHANI END) AGAINST THE EXISTING DFC CHAINAGE. 116277.742M ISSUED VIDE LETTER NO. COM/DFCC/UMS/SURVEY/2021-301-230116-011173 DT. 17.01.2023.
- BALLAST PROFILE HAS BEEN PROVIDED ACCORDING TO THE CLAUSE 1.11.3 OF STANDARD SCHEDULE OF DIMENSION(EASTERN CORRIDOR) & THE BALLAST CUSHION DIMENSION SHOWN IN 35CM ON GE-14 PARA 17. SPECIFICATIONS & RECOMMENDATIONS 2. TWO LAYER SYSTEM FIG.10.

REFERENCE DRAWINGS :-

- FOR KEY PLAN REFER DRAWING NO. 301-2/AL/0001
- FOR LEGEND AND ABBREVIATIONS REFER DRAWING NO. 301-2/AL/1000
- FOR TYPICAL SECTION OF BALLAST PROFILE (FL-RL) REFER DRG. NO. 301-2/TK/TFDI-004 (TR.1952)

018.09.2024SUBMISSION OF AS-BUILT DRAWINGFOR APPROVAL

REV. DATE REVISION DETAILS PURPOSE OF ISSUE

SCALE
HOR - 1:1000
VER - 1:100
SHEET SIZE - A1

LEGEND:

- IR TRACK
- DFCC TRACK
- DFCC FUTURE PROPOSALS
- STRUCTURE / BUILDING
- DFCC TOE LINE
- DFCC FORMATION
- RETAINING WALL
- ROAD
- STREAM, DRAIN, NALA, CANAL.
- FENCE
- POWER LINES
- TBM
- ELECTRIC POLE/OHE MAST
- IR RAILWAY BOUNDARY
- DFCC BOUNDARY

TYPICAL SECTION

TRACK STRUCTURE

RAIL SECTION: 60Kg/m (UIC 60Kg/m)	Difference between FL- RL (Below Rail Seat)	
DFC LINE: 60Kg/m (UIC 60Kg/m)	IR Line	DFC
IR MAIN LINE: 52Kg/m	172mm	172mm
RUBBER PAD	6mm	10mm
SLEEPER DEPTH	210mm	210mm
BALLAST CUSHION	300mm	350mm
Total Depth (FL TO RL)	688mm	742mm

OWNER

DEDICATED FREIGHT CORRIDOR CORPORATION OF INDIA LTD.
(A GOVERNMENT OF INDIA ENTERPRISE)
PROJECT OFFICE (AMBALA UNIT): OLD RAILWAY COLONY (NEAR ANAND MARKET), AMBALA CANTT-133001.
CORPORATE IDENTITY NO. : U60232DL2006GGI155068

ENGINEER:

DB Engineering & Consulting GmbH
Deutsche Bahn Engineering & Consulting GmbH

CONTRACTOR:

GIL - TPL JV
GAR TATA

SUBMITTED BY	GIL - TPL JV		
	DATED	NAME	SIGNATURE
PREPARED BY			
CHECKED BY	18.09.2024	VIJAY PRATAP	
APPROVED BY	18.09.2024	PARASURAM KOTYADA	
APPROVED BY	DEUTSCHE BAHN ENGINEERING & CONSULTING GMBH		
	DATED	NAME	SIGNATURE
Sr. DE./CHIEF ENGINEER		SURESH K.YALANGI	
CHIEF TRACK ENGINEER		RAJ PAL SINGH	
T.L.		H.D. VIDJAK	

STAMP

A AS-BUILT DRAWING
TR. Ref.....
ENGINEER Sign.:

EMPLOYER (DFCCIL):

DEDICATED FREIGHT CORRIDOR CORPORATION OF INDIA LTD.

AS BUILT DRAWING

TITLE
AS-BUILT PLAN AND PROFILE
DFC KM:1205.405 TO 1205.905
(DETOUR)

DFCC APPR. NO. -
ENGG. APPR. NO. -
DRG. NO. -301-2/AL/A/1255C
SHEET NO. : 1 OF 1
DATE : 18.09.2024

STATUS
A

TR.