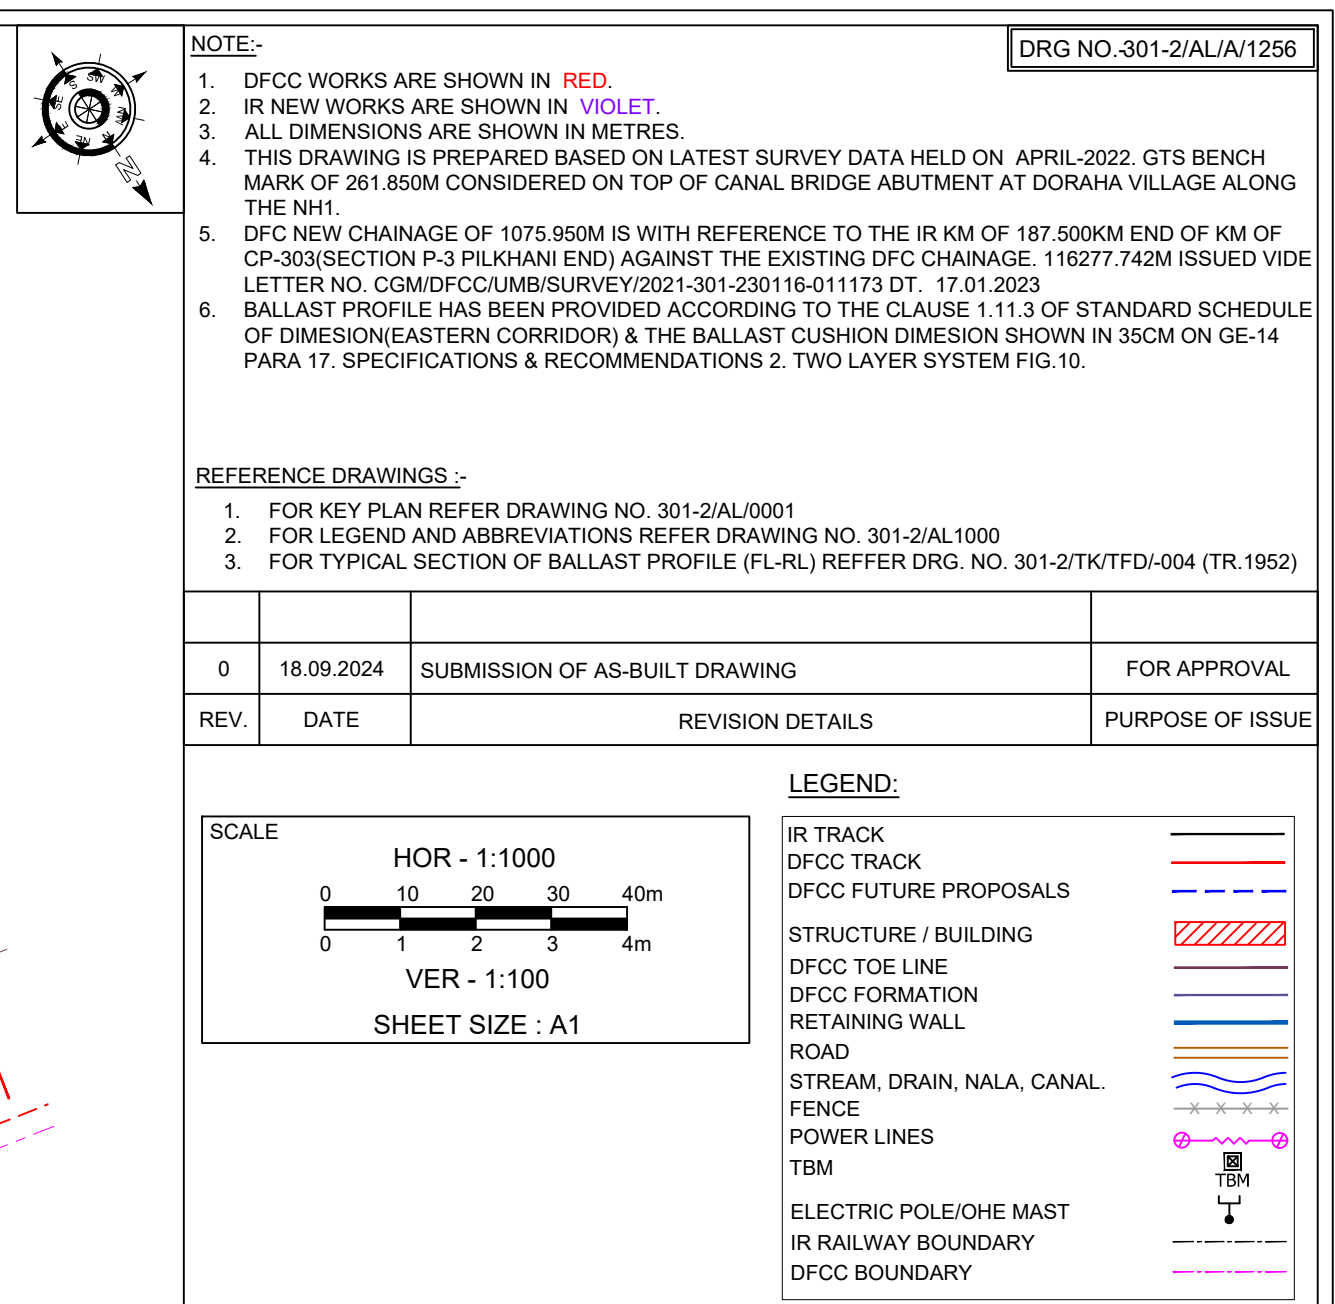


OWNER

**DEDICATED FREIGHT CORRIDOR CORPORATION OF INDIA LTD**
(A GOVERNMENT OF INDIA ENTERPRISE)
PROJECT OFFICE/AMBALA UNIT: OLD RAILWAY COLONY (NEAR
ANAND MARKET),AMBALA CANTT-133001
CORPORATE IDENTITY NO. : U60232DL2006GO1155068

CONTRACTOR: GIL - TPL JV

APPROVED BY	DEUTSCHE BAHN ENGINEERING & CONSULTING GMBH		
	DATED	NAME	SIGNATURE
Sr. DE./CHIEF ENGINEER		SURESH K.YALANGI	
CHIEF TRACK ENGINEER		RAJ PAL SINGH	
T.L.		H.D. VIDJAK	

STAMP	A AS-BUILT DRAWING TR. Ref..... ENGINEER Sign..:		
EMPLOYER (DFCCIL):	DEDICATED FREIGHT CORRIDOR CORPORATION OF INDIA L		

TITLE AS-BUILT PLAN AND PROFILE DFC KM:1205.905 TO 1206.405 (DETOUR)	DFCC APPR. NO. -		STATUS A
	ENGG. APPR. NO. -		
	DRG. NO. - 301-2/AL/A/1256		
	SHEET NO. : 1 OF 1		
	DATE : 18.09.2024		

L - SECTION