


PILKHANI

SAHNEWAL

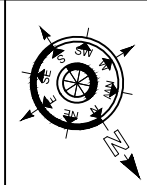

DRG NO.-301-2/AL/A/1257

NOTE:-

1. DFCC WORKS ARE SHOWN IN **RED**.
2. IR NEW WORKS ARE SHOWN IN **VIOLET**.
3. ALL DIMENSIONS ARE SHOWN IN METRES.
4. THIS DRAWING IS PREPARED BASED ON LATEST SURVEY DATA HELD ON APRIL-2022. GTS BENCH MARK OF 261.850M CONSIDERED ON TOP OF CANAL BRIDGE ABUTMENT AT DORANA VILLAGE ALONG THE NH1.
5. DFC NEW CHAINAGE OF 1075.950M IS WITH REFERENCE TO THE IR KM OF 187.500KM END OF KM OF CP-303(SECTION P-3 PILKHANI END) AGAINST THE EXISTING DFC CHAINAGE. 116277.742M ISSUED VIDE LETTER NO. COM/DFCC/MB/SURVEY/2021-301-230116-011173.DT. 17.01.2023.
6. BALLAST PROFILE HAS BEEN PROVIDED ACCORDING TO THE CLAUSE 1.11.3 OF STANDARD SCHEDULE OF DIMENSION(EASTERN CORRIDOR) & THE BALLAST CUSHION DIMENSION SHOWN IN 35CM ON GE-14 PARA 17. SPECIFICATIONS & RECOMMENDATIONS 2. TWO LAYER SYSTEM FIG.10.

REFERENCE DRAWINGS :-

1. FOR KEY PLAN REFER DRAWING NO. 301-2/AL/0001
2. FOR LEGEND AND ABBREVIATIONS REFER DRAWING NO. 301-2/AL/1000
3. FOR TYPICAL SECTION OF BALLAST PROFILE (FL-RL) REFER DRG. NO. 301-2/TK/TFD/004 (TR.1952)


REV.	DATE	REVISION DETAILS	PURPOSE OF ISSUE
0	18.09.2024	SUBMISSION OF AS-BUILT DRAWING	FOR APPROVAL

LEGEND:

IR TRACK
DFCC TRACK
DFCC FUTURE PROPOSALS
STRUCTURE / BUILDING
DFCC TOE LINE
DFCC FORMATION
RETAINING WALL
ROAD
STREAM, DRAIN, NALA, CANAL.
FENCE
POWER LINES
TBM
ELECTRIC POLE/OHE MAST
IR RAILWAY BOUNDARY
DFCC BOUNDARY

SCALE

HOR - 1:1000
VER - 1:100
SHEET SIZE - A1

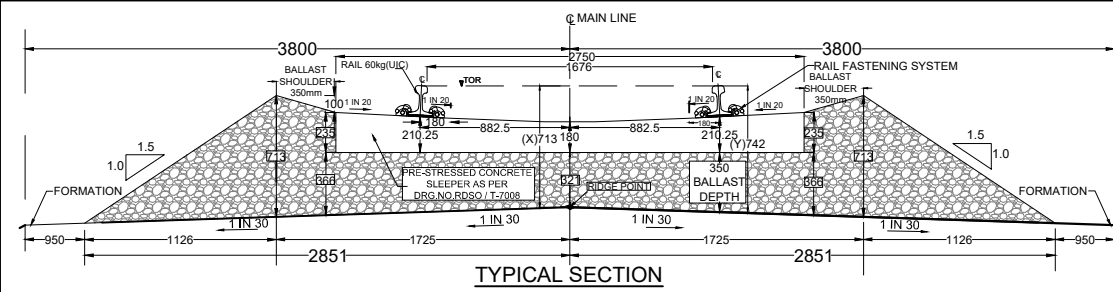

TRACK STRUCTURE		
RAIL SECTION: 60Kg/m (UIC 60Kg/m) DFC LINE: 60Kg/m (UIC 60Kg/m) IR MAIN LINE: 52Kg/m	Difference between FL- RL (Below Rail Seat)	
	IR Line	DFC
	172mm	172mm
RUBBER PAD	6mm	10mm
SLEEPER DEPTH	210mm	210mm
BALLAST CUSHION	300mm	350mm
Total Depth (FL TO RL)	688mm	742mm

OWNER: DEDICATED FREIGHT CORRIDOR CORPORATION OF INDIA LTD.
(A GOVERNMENT OF INDIA ENTERPRISE)
PROJECT OFFICE/AMBALA UNIT: OLD RAILWAY COLONY (NEAR ANAND MARKET),AMBALA CANTT-133001.
CORPORATE IDENTITY NO. : U60232DL20060G01155068

ENGINEER: DB Engineering & Consulting GmbH
Deutsche Bahn Engineering & Consulting GmbH

CONTRACTOR: GIL - TPL JV
GAR TATA

SUBMITTED BY	GIL - TPL JV		
	DATED	NAME	SIGNATURE
PREPARED BY			
CHECKED BY	18.09.2024	VIJAY PRATAP	
APPROVED BY	18.09.2024	PARASURAM KOTYADA	

APPROVED BY	DEUTSCHE BAHN ENGINEERING & CONSULTING GMBH		
	DATED	NAME	SIGNATURE
Sr. DE./CHIEF ENGINEER		SURESH K.YALANGI	
CHIEF TRACK ENGINEER		RAJ PAL SINGH	
T.L.		H.D. VIDJAK	



STAMP

AS-BUILT DRAWING
TR. Ref.:.....
ENGINEER Sign.:.....

EMPLOYER (DFCCIL): DEDICATED FREIGHT CORRIDOR CORPORATION OF INDIA LTD.

AS BUILT DRAWING		
TITLE	DFCC APPR. NO. -	STATUS A
AS-BUILT PLAN AND PROFILE	ENGG. APPR. NO. -	
DFC KM:1206.405 TO 1206.905 (DETOUR)	DRG. NO. -301-2/AL/A/1257	
	SHEET NO. : 1 OF 1	
	DATE : 18.09.2024	

TR.

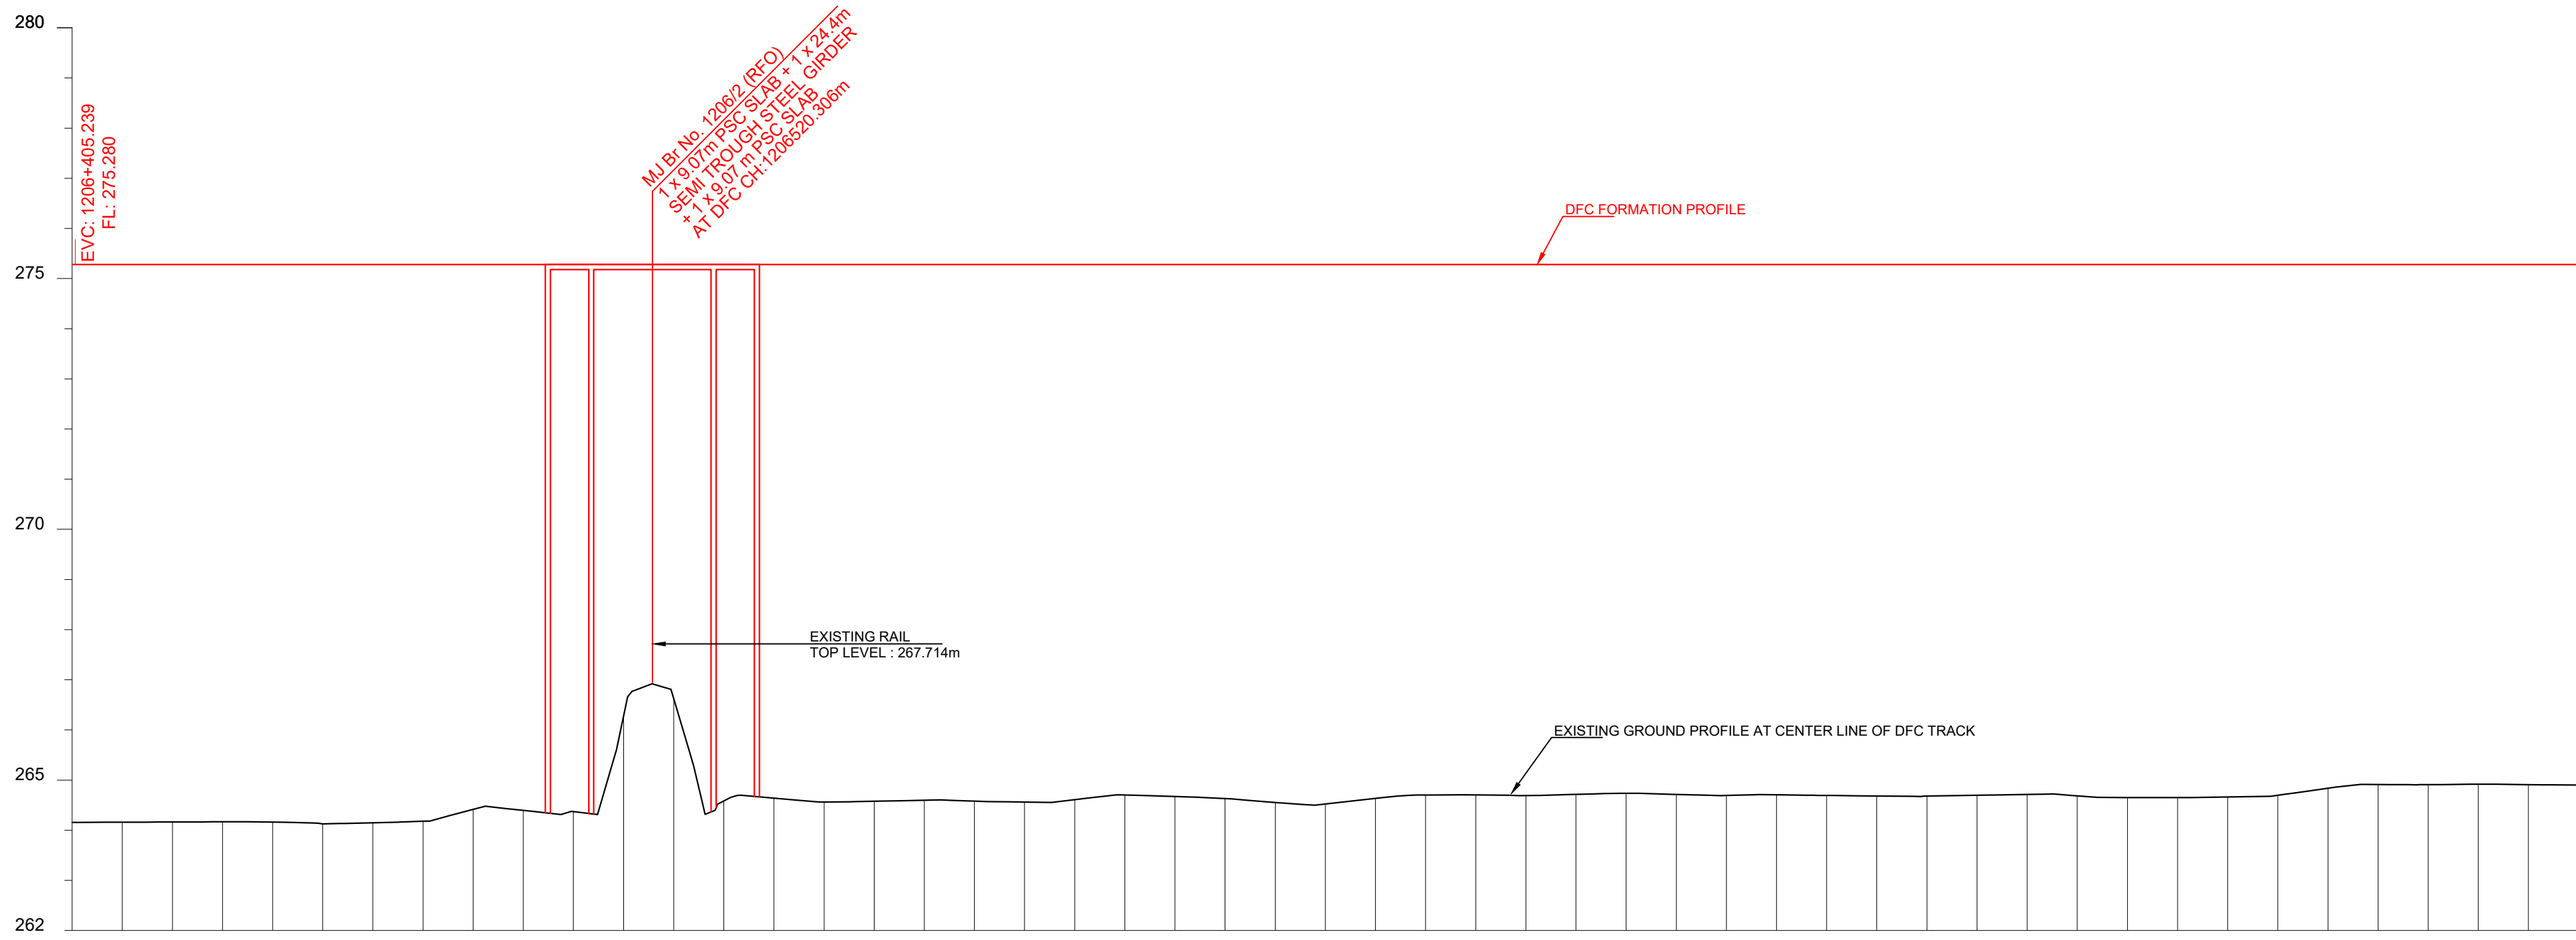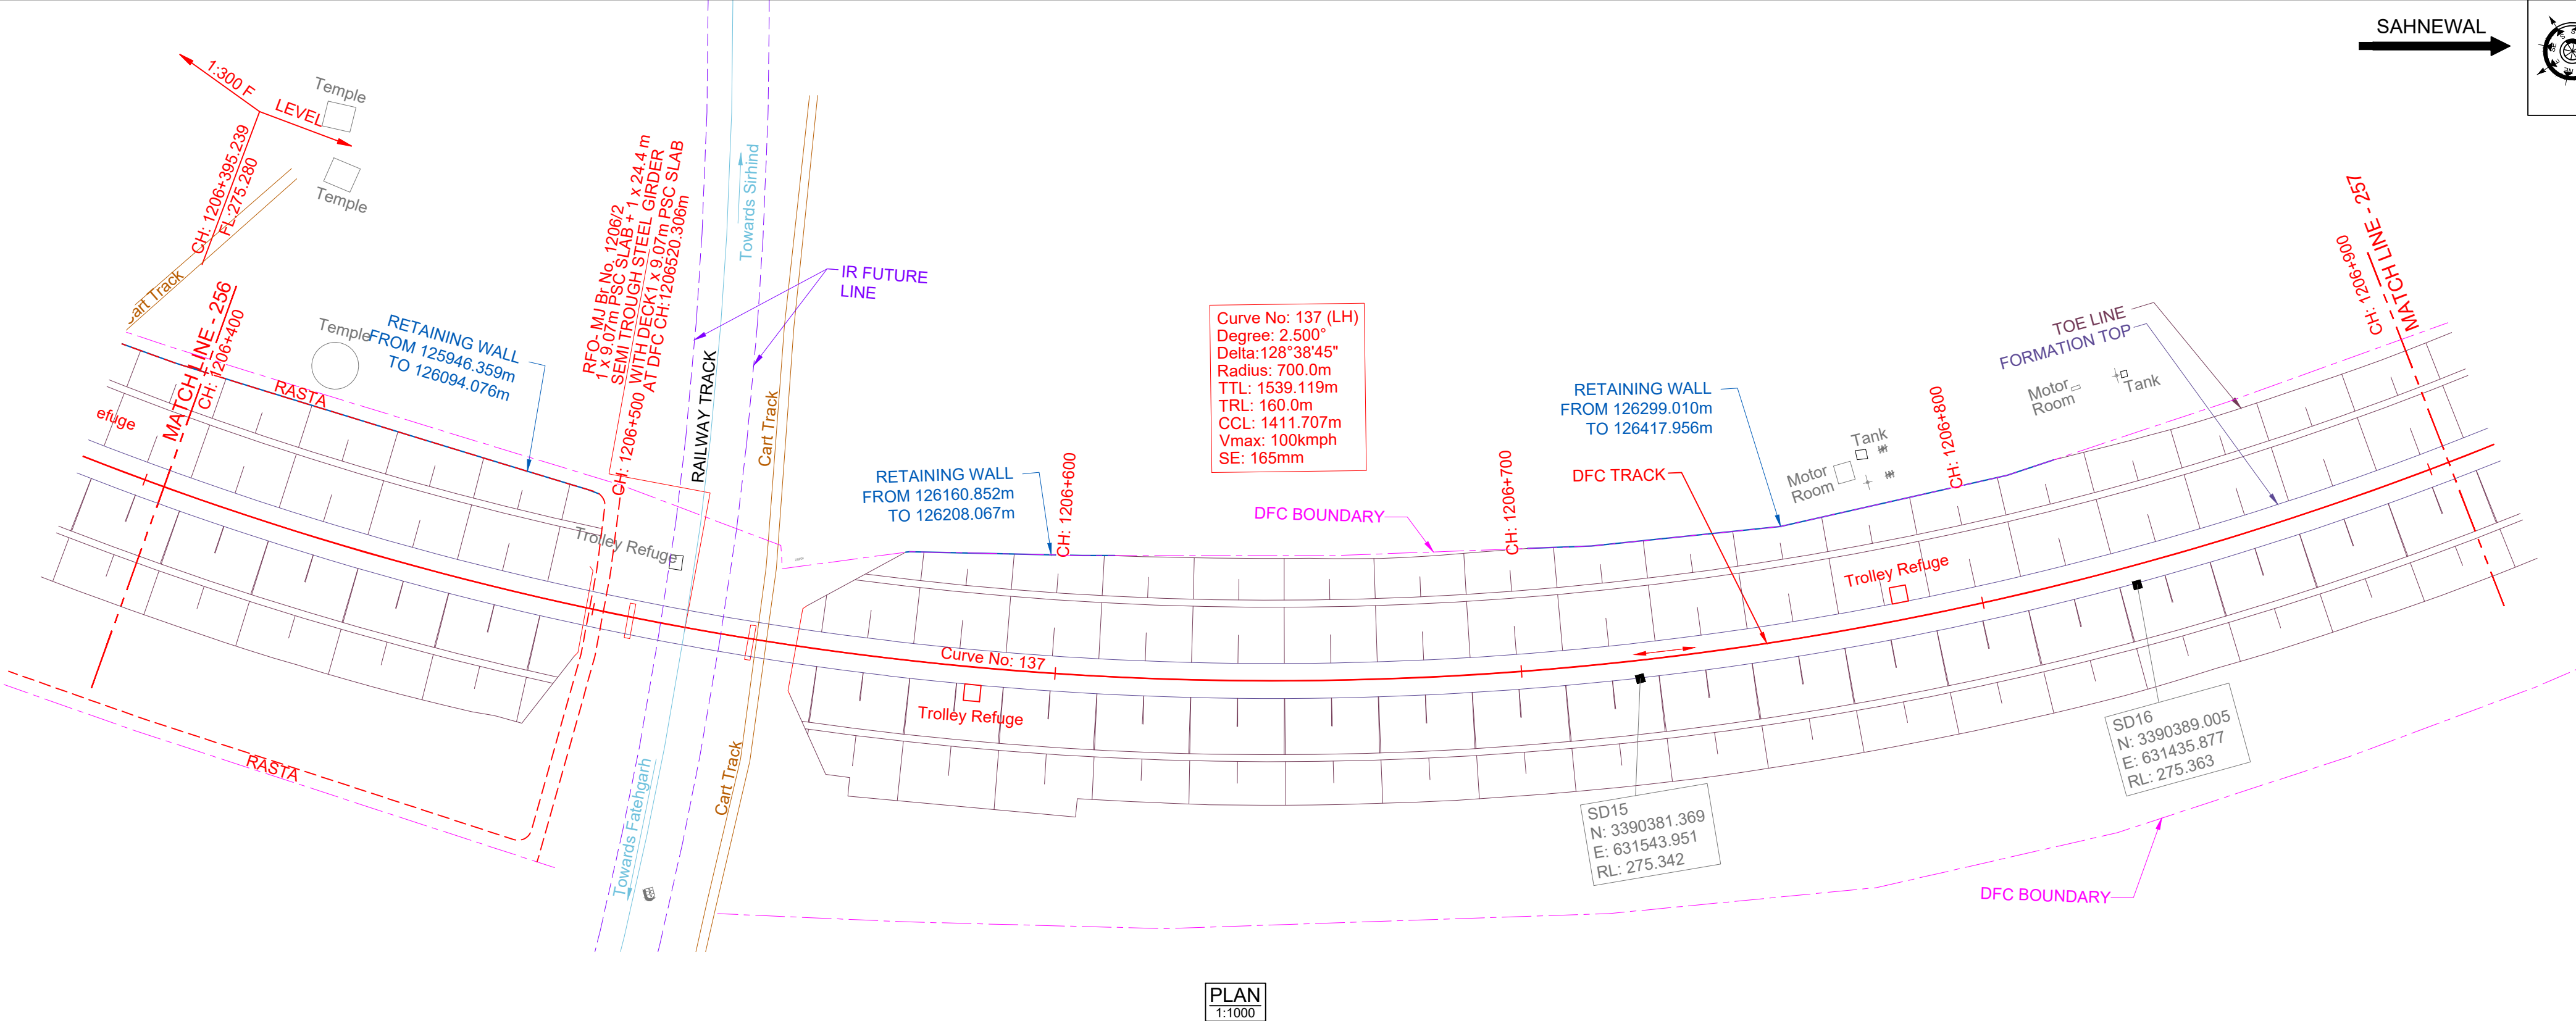

DATUM ABOVE MSL : 262 m

HORIZONTAL ALIGNMENT	R = -700m																									
VERTICAL ALIGNMENT	L=20.0 m R=6001 m												L=1559.618 m LEVEL													
HEIGHT OF BANKING(+) / DEPTH OF CUTTING(-) (PFL-GL)	+11.124	+11.116	+11.119	+11.130	+10.864	+10.909	+8.652	+10.641	+10.703	+10.700	+10.670	+10.609	+10.728	+10.646	+10.576	+10.565	+10.566	+10.574	+10.598	+10.583	+10.594	+10.628	+10.583	+10.368	+10.362	+10.377
EXG GROUND LEVEL AT CENTER LINE OF DFC TRACK (GL)	264.156	264.164	264.161	264.150	264.416	264.371	266.628	264.639	264.577	264.580	264.610	264.671	264.552	264.634	264.704	264.715	264.714	264.706	264.682	264.697	264.686	264.652	264.697	264.912	264.918	264.903
DFC FORMATION LEVEL (PFL)	275.280	275.280	DFC RAIL LEVEL (PRL)	275.993	275.993	DFC TRACK CHAINAGE	1206404.6	1206424.6	1206444.6	1206464.6	1206484.6	1206504.6	1206524.6	1206544.6	1206564.6	1206584.6	1206604.6	1206624.6	1206644.6	1206664.6	1206684.6	1206704.6	1206724.6	1206744.6	1206764.6	1206784.6	1206804.6	1206824.6	1206844.6	1206864.6	1206884.6	1206904.6

L - SECTION