


PILKHANI

SAHNEWAL

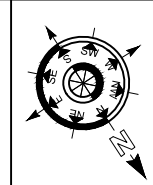

DRG NO.-301-2/AL/A/1260

NOTE:-

1. DFCC WORKS ARE SHOWN IN RED.
2. IR NEW WORKS ARE SHOWN IN VIOLET.
3. ALL DIMENSIONS ARE SHOWN IN METRES.
4. THIS DRAWING IS PREPARED BASED ON LATEST SURVEY DATA HELD ON APRIL-2022. GTS BENCH MARK OF 261.850M CONSIDERED ON TOP OF CANAL BRIDGE ABUTMENT AT DORANA VILLAGE ALONG THE NH1.
5. DFC NEW CHAINAGE OF 1075.950M IS WITH REFERENCE TO THE IR KM OF 187.500KM END OF KM OF CP-303(SECTION P-3 PILKHANI END) AGAINST THE EXISTING DFC CHAINAGE. 116277.742M ISSUED VIDE LETTER NO. COM/DFCC/UM/SURVEY/2021-301-230116-11173.DT. 17.01.2023.
6. BALLAST PROFILE HAS BEEN PROVIDED ACCORDING TO THE CLAUSE 1.11.3 OF STANDARD SCHEDULE OF DIMENSION(EASTERN CORRIDOR) & THE BALLAST CUSHION DIMENSION SHOWN IN 35CM ON GE-14 PARA 17. SPECIFICATIONS & RECOMMENDATIONS 2. TWO LAYER SYSTEM FIG.10.

REFERENCE DRAWINGS :-

1. FOR KEY PLAN REFER DRAWING NO. 301-2/AL/0001
2. FOR LEGEND AND ABBREVIATIONS REFER DRAWING NO. 301-2/AL/1000
3. FOR TYPICAL SECTION OF BALLAST PROFILE (FL-RL) REFER DRG. NO. 301-2/TK/TFD-004 (TR.1952)

REV.	DATE	REVISION DETAILS	PURPOSE OF ISSUE
0	18.09.2024	SUBMISSION OF AS-BUILT DRAWING	FOR APPROVAL

SCALE

HOR - 1:1000

VER - 1:100

SHEET SIZE : A1

LEGEND:

IR TRACK

DFCC TRACK

DFCC FUTURE PROPOSALS

STRUCTURE / BUILDING

DFCC TOE LINE

DFCC FORMATION

RETAINING WALL

ROAD

STREAM, DRAIN, NALA, CANAL.

FENCE


POWER LINES

TBM

ELECTRIC POLE/OHE MAST

IR RAILWAY BOUNDARY

DFCC BOUNDARY

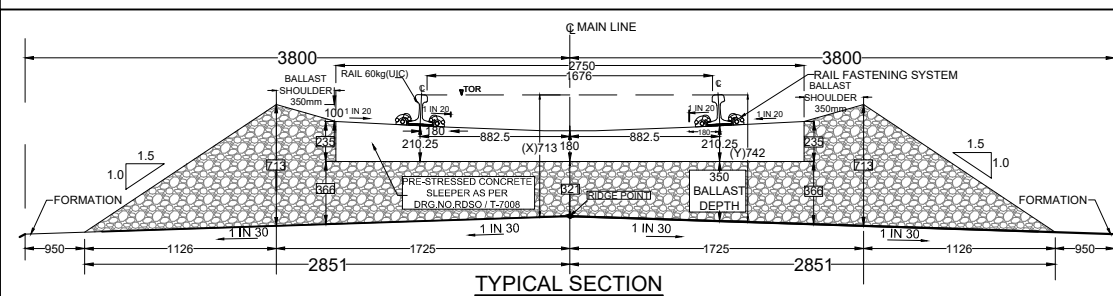

TRACK STRUCTURE		
RAIL SECTION: 60Kg/m (UIC 60Kg/m) DFC LINE: 60Kg/m (UIC 60Kg/m) IR MAIN LINE: 52Kg/m	Difference between FL- RL (Below Rail Seat)	
	IR Line	DFC
RUBBER PAD	172mm	172mm
SLEEPER DEPTH	6mm	10mm
BALLAST CUSHION	210mm	210mm
	300mm	350mm
Total Depth (FL TO RL)	688mm	742mm

OWNER
DEDICATED FREIGHT CORRIDOR CORPORATION OF INDIA LTD.
(A GOVERNMENT OF INDIA ENTERPRISE)
PROJECT OFFICE/AMBALA UNIT: OLD RAILWAY COLONY (NEAR ANAND MARKET),AMBALA CANTT-133001.
CORPORATE IDENTITY NO. : U60232DL2006GGI155068

ENGINEER:
DB Engineering & Consulting GmbH
Deutsche Bahn Engineering & Consulting GmbH

CONTRACTOR:
GIL - TPL JV
GAR TATA

SUBMITTED BY	GIL - TPL JV		
	DATED	NAME	SIGNATURE
PREPARED BY			
CHECKED BY	18.09.2024	VIJAY PRATAP	
APPROVED BY	18.09.2024	PARASURAM KOTYADA	

APPROVED BY	DEUTSCHE BAHN ENGINEERING & CONSULTING GMBH		
	DATED	NAME	SIGNATURE
Sr. DE./CHIEF ENGINEER		SURESH K.YALANGI	
CHIEF TRACK ENGINEER		RAJ PAL SINGH	
T.L.		H.D. VIDJAK	



STAMP

AS-BUILT DRAWING
TR. Ref.....
ENGINEER Sign.:

EMPLOYER (DFCCIL): DEDICATED FREIGHT CORRIDOR CORPORATION OF INDIA LTD.

AS BUILT DRAWING		
TITLE	DFCC APPR. NO. -	STATUS A
AS-BUILT PLAN AND PROFILE	ENGG. APPR. NO. -	
DFC KM:1207.905 TO 1208.405 (DETOUR)	DRG. NO. - 301-2/AL/A/1260	
	SHEET NO. : 1 OF 1	
	DATE : 18.09.2024	

TR.

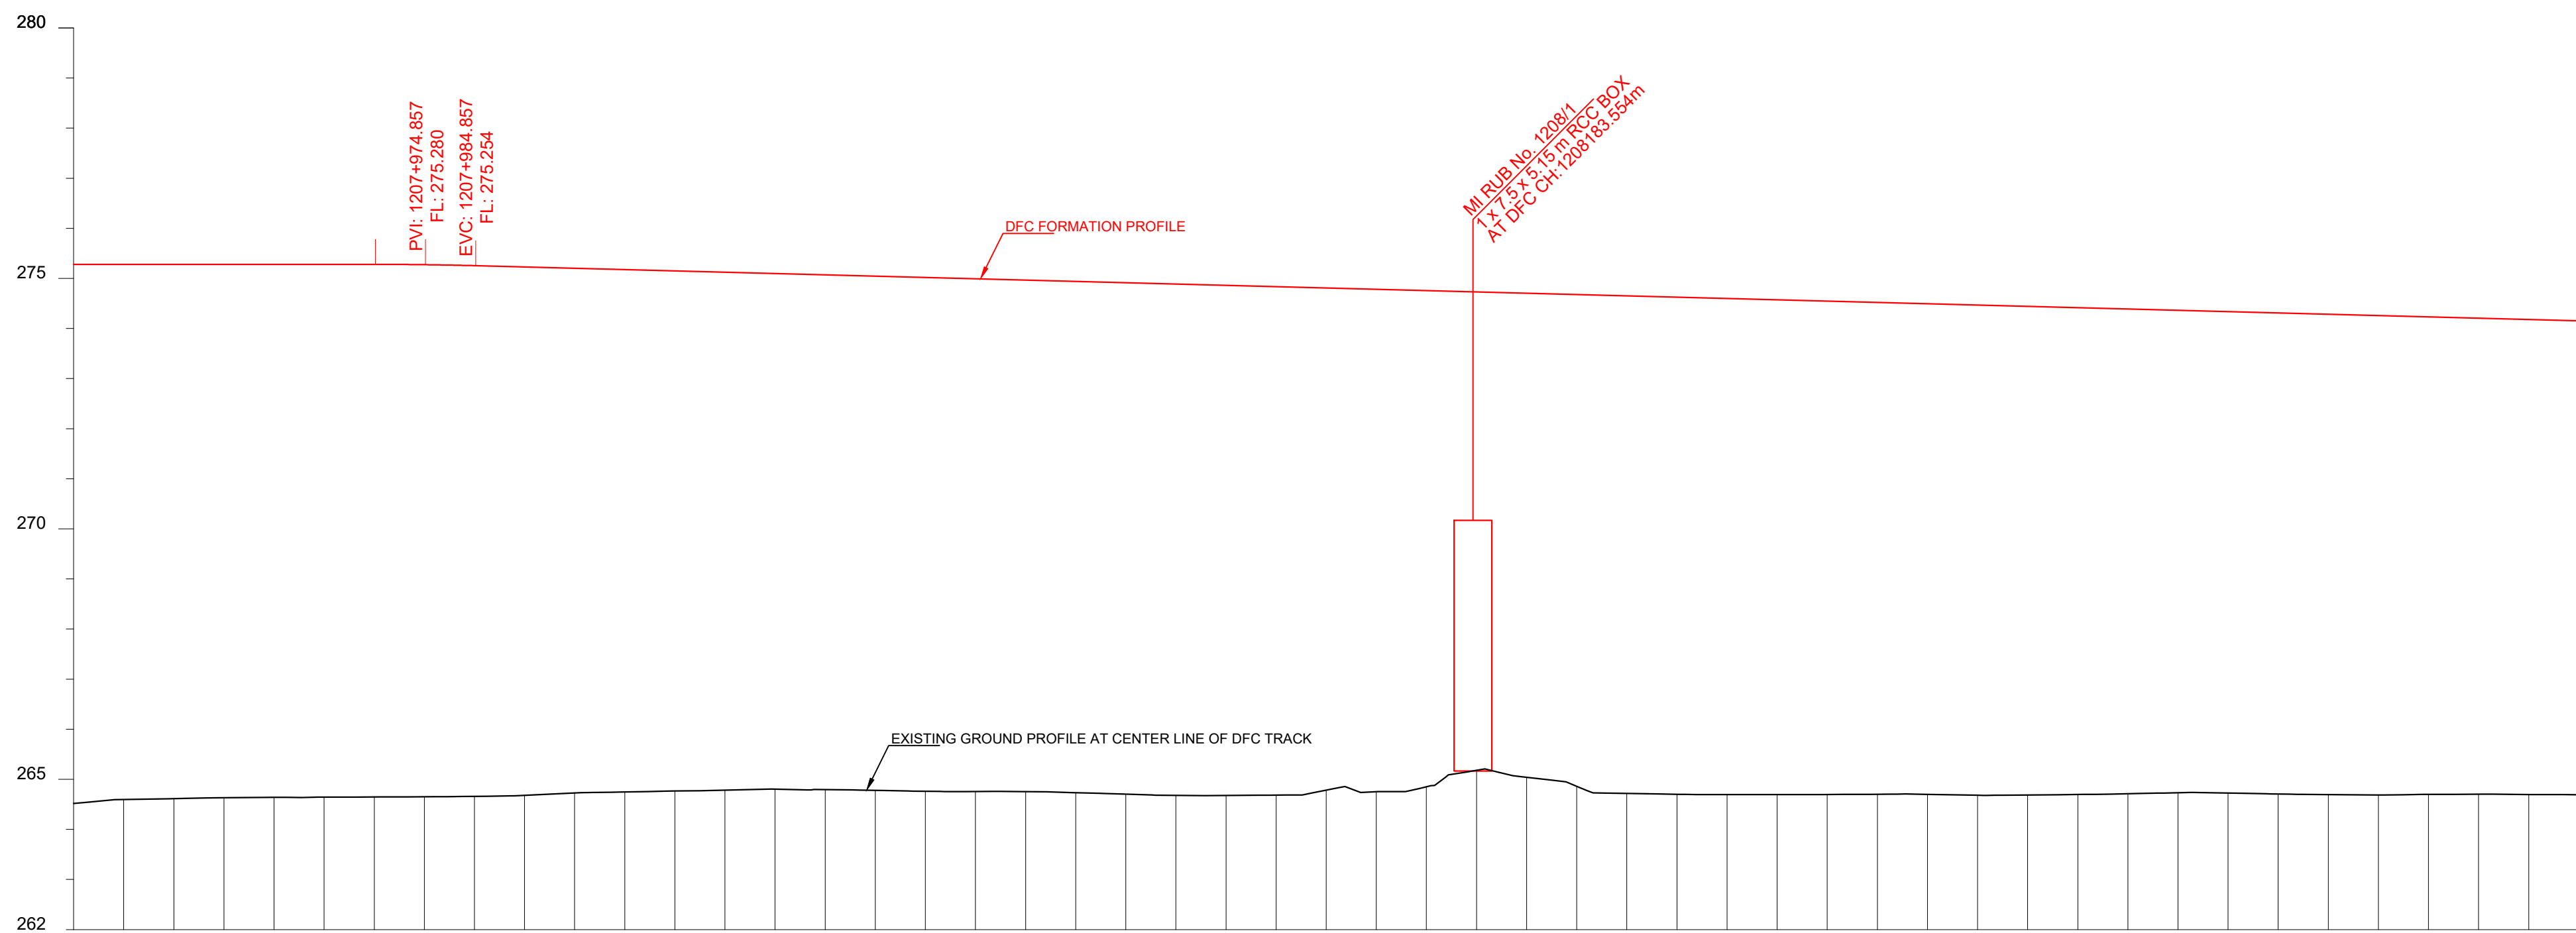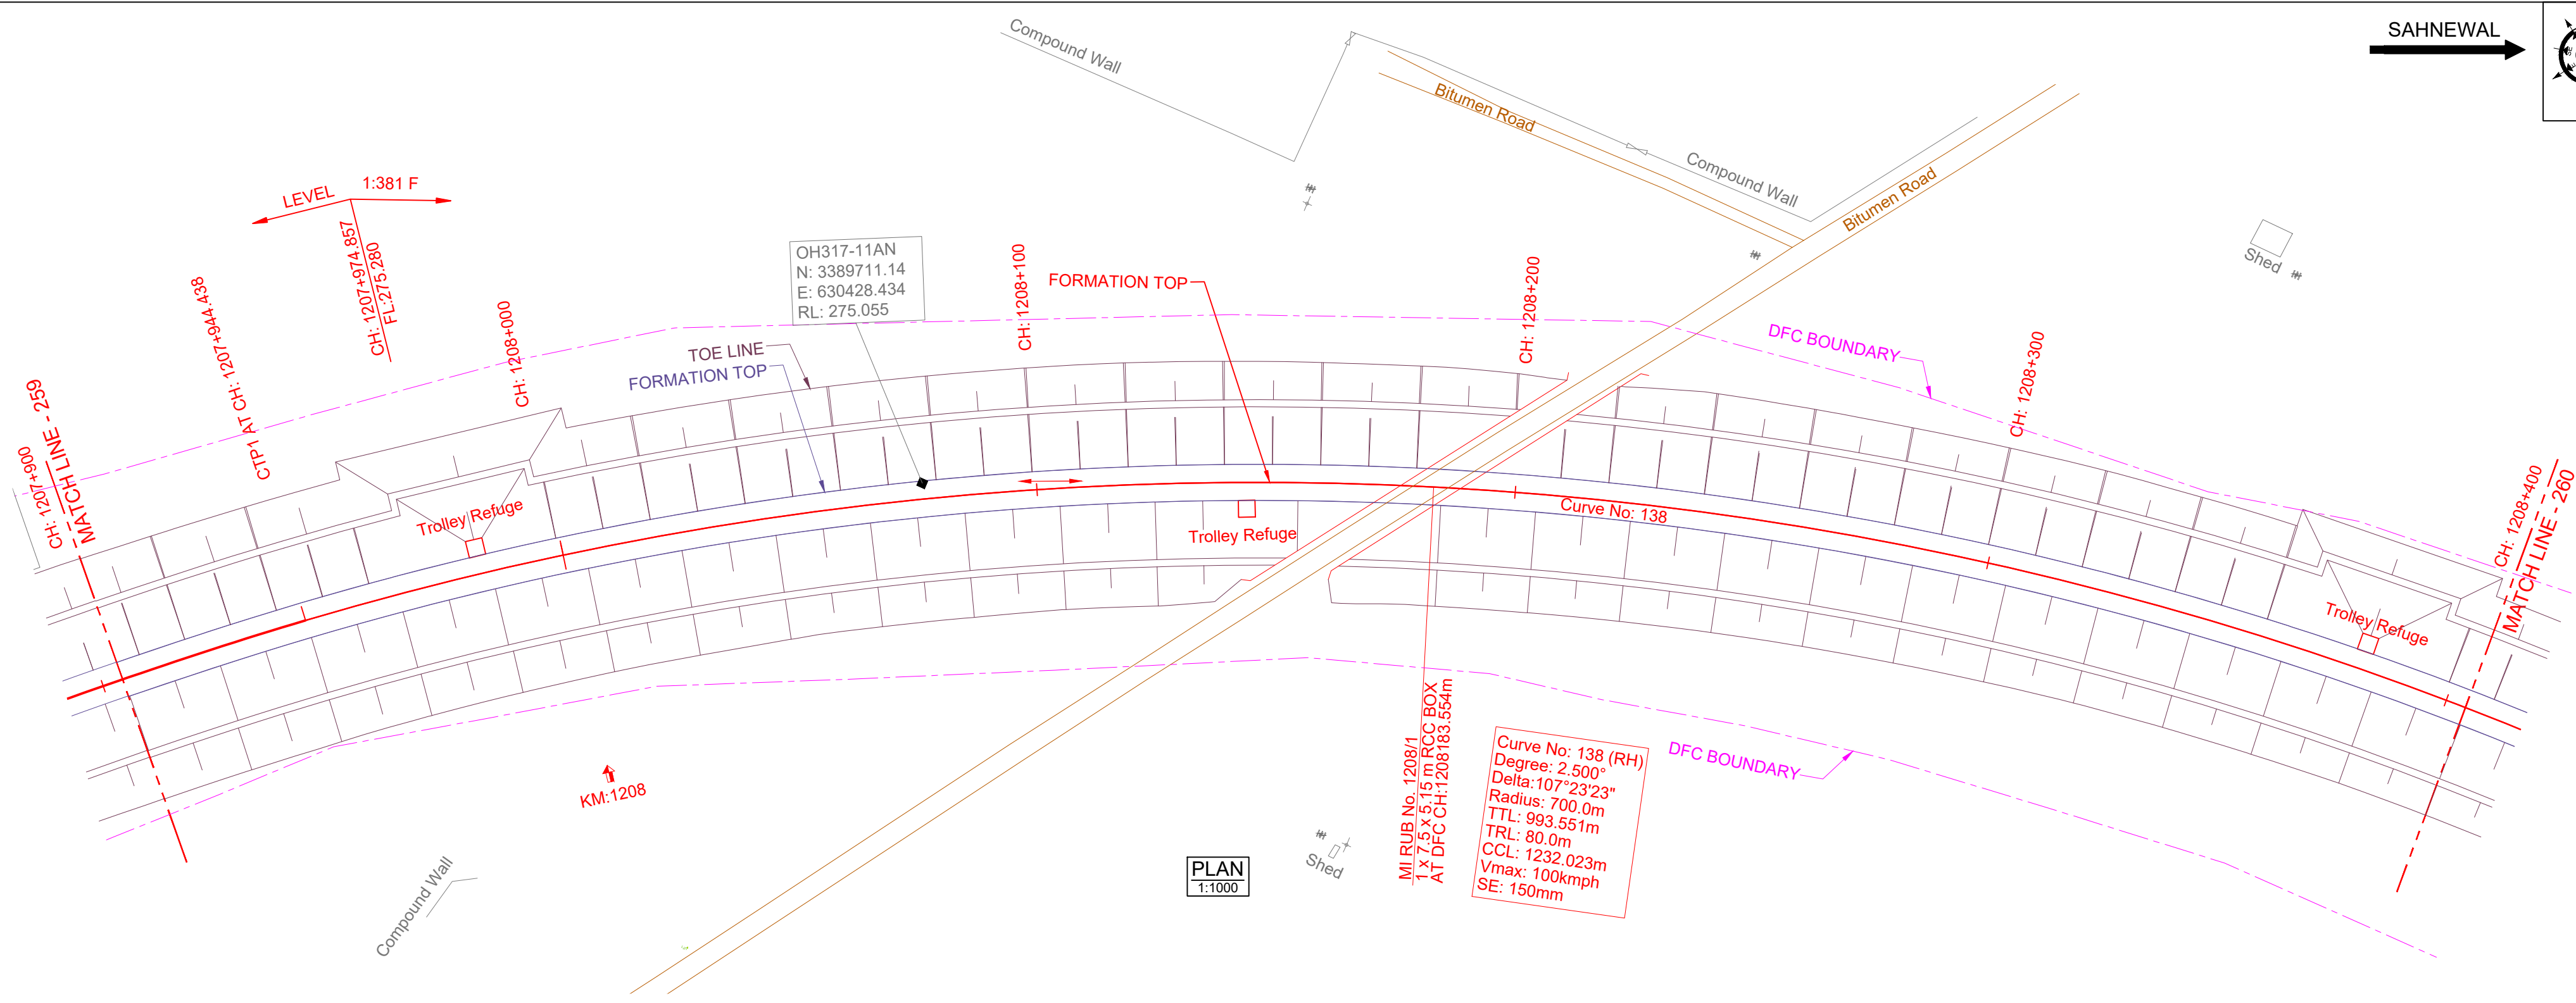

DATUM ABOVE MSL : 262 m

HORIZONTAL ALIGNMENT	TL = 80m R = 700m																		
VERTICAL ALIGNMENT	L=1559.618 m LEVEL L=20.0 m R=7623 m L=1692.889 m 1 IN 381.150 F																		
HEIGHT OF BANKING(+) / DEPTH OF CUTTING(-) (PFL-GL)	+10.764	+10.667	+10.642	+10.634	+10.594	+10.475	+10.383	+10.295	+10.266	+10.235	+10.208	+10.208	+10.151	+10.031	+9.551	+9.616	+9.924	+9.877	+9.818
EXG GROUND LEVEL AT CENTER LINE OF DFC TRACK (GL)	264.516	264.613	264.638	264.646	264.660	264.727	264.766	264.802	264.779	264.757	264.732	264.679	264.684	264.751	265.179	264.861	264.701	264.695	264.702
DFC FORMATION LEVEL (PFL)	275.280	275.280	275.280	275.280	275.255	275.203	275.150	275.098	275.045	274.992	274.940	274.887	274.835	274.782	274.730	274.677	274.625	274.572	274.520
DFC RAIL LEVEL (PRL)	275.993	275.993	275.993	275.993	275.968	275.915	275.863	275.810	275.758	275.705	275.653	275.600	275.548	275.495	275.443	275.390	275.338	275.285	275.233
DFC TRACK CHAINAGE	1207904.6	1207924.6	1207944.6	1207964.6	1207984.6	1208004.6	1208024.6	1208044.6	1208064.6	1208084.6	1208104.6	1208124.6	1208144.6	1208164.6	1208184.6	1208204.6	1208224.6	1208244.6	1208264.6

L - SECTION