
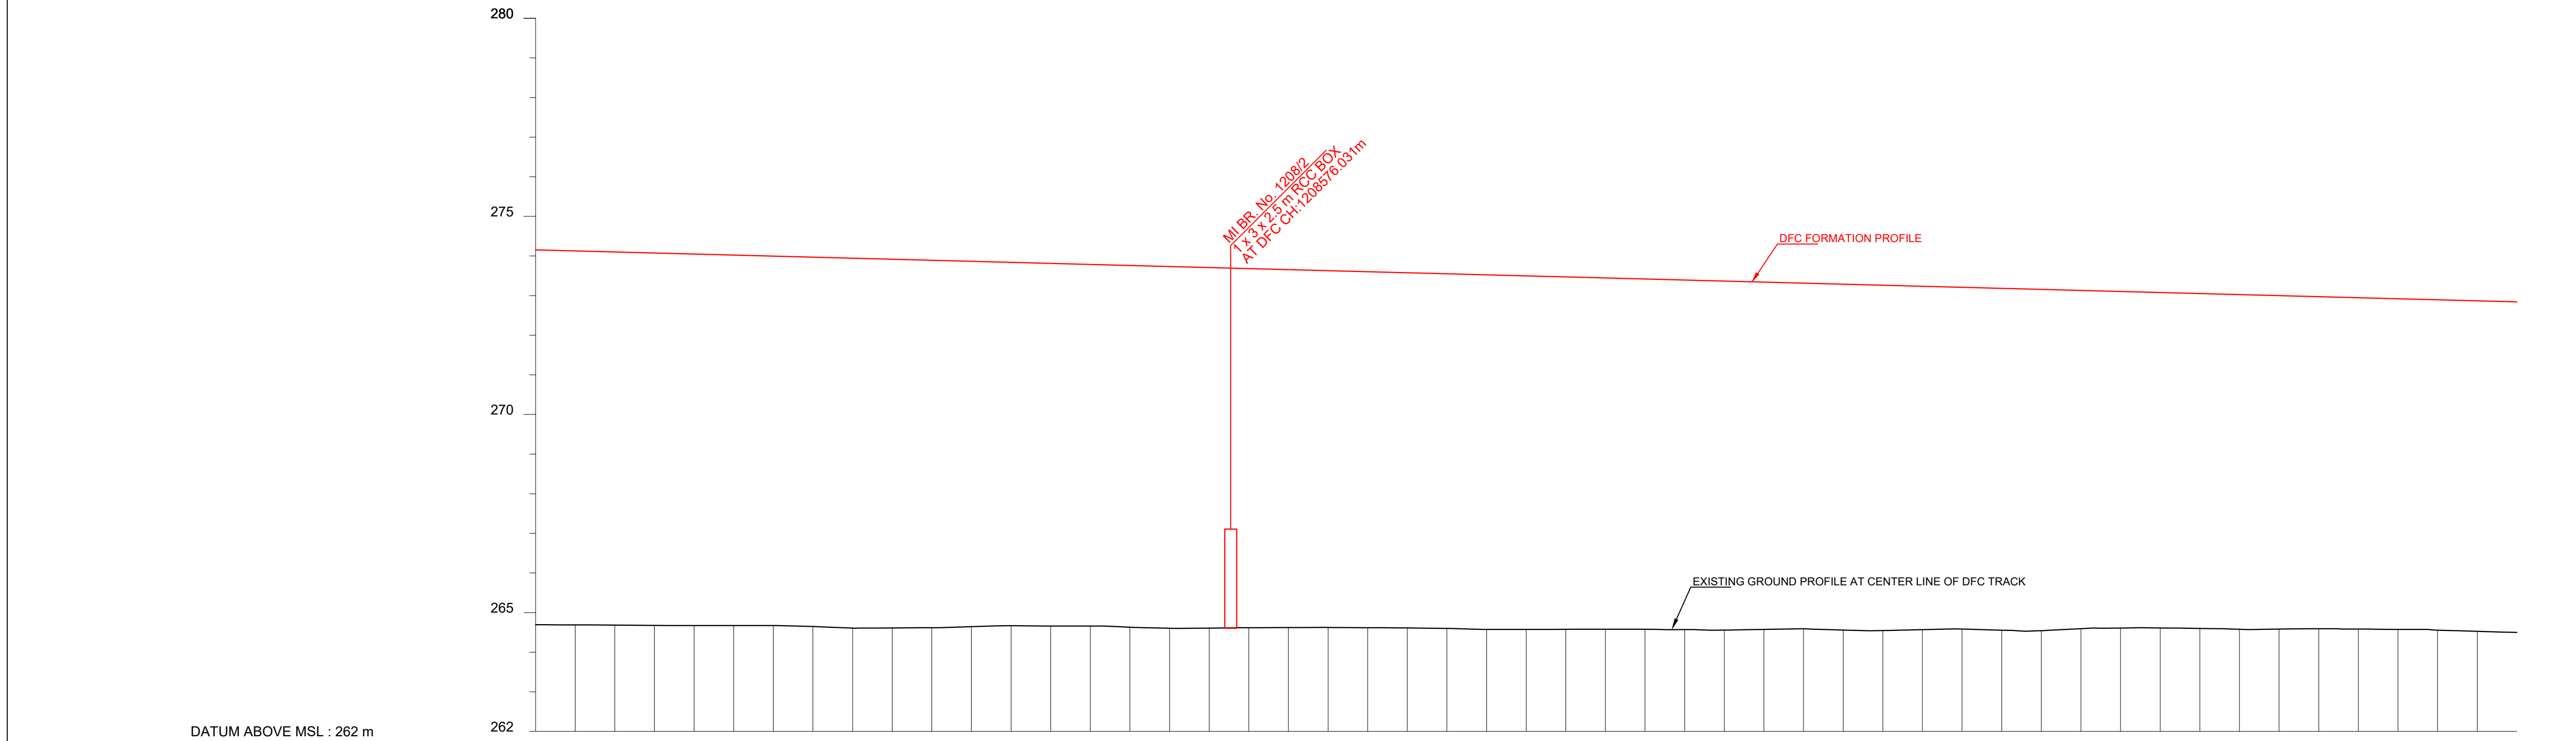


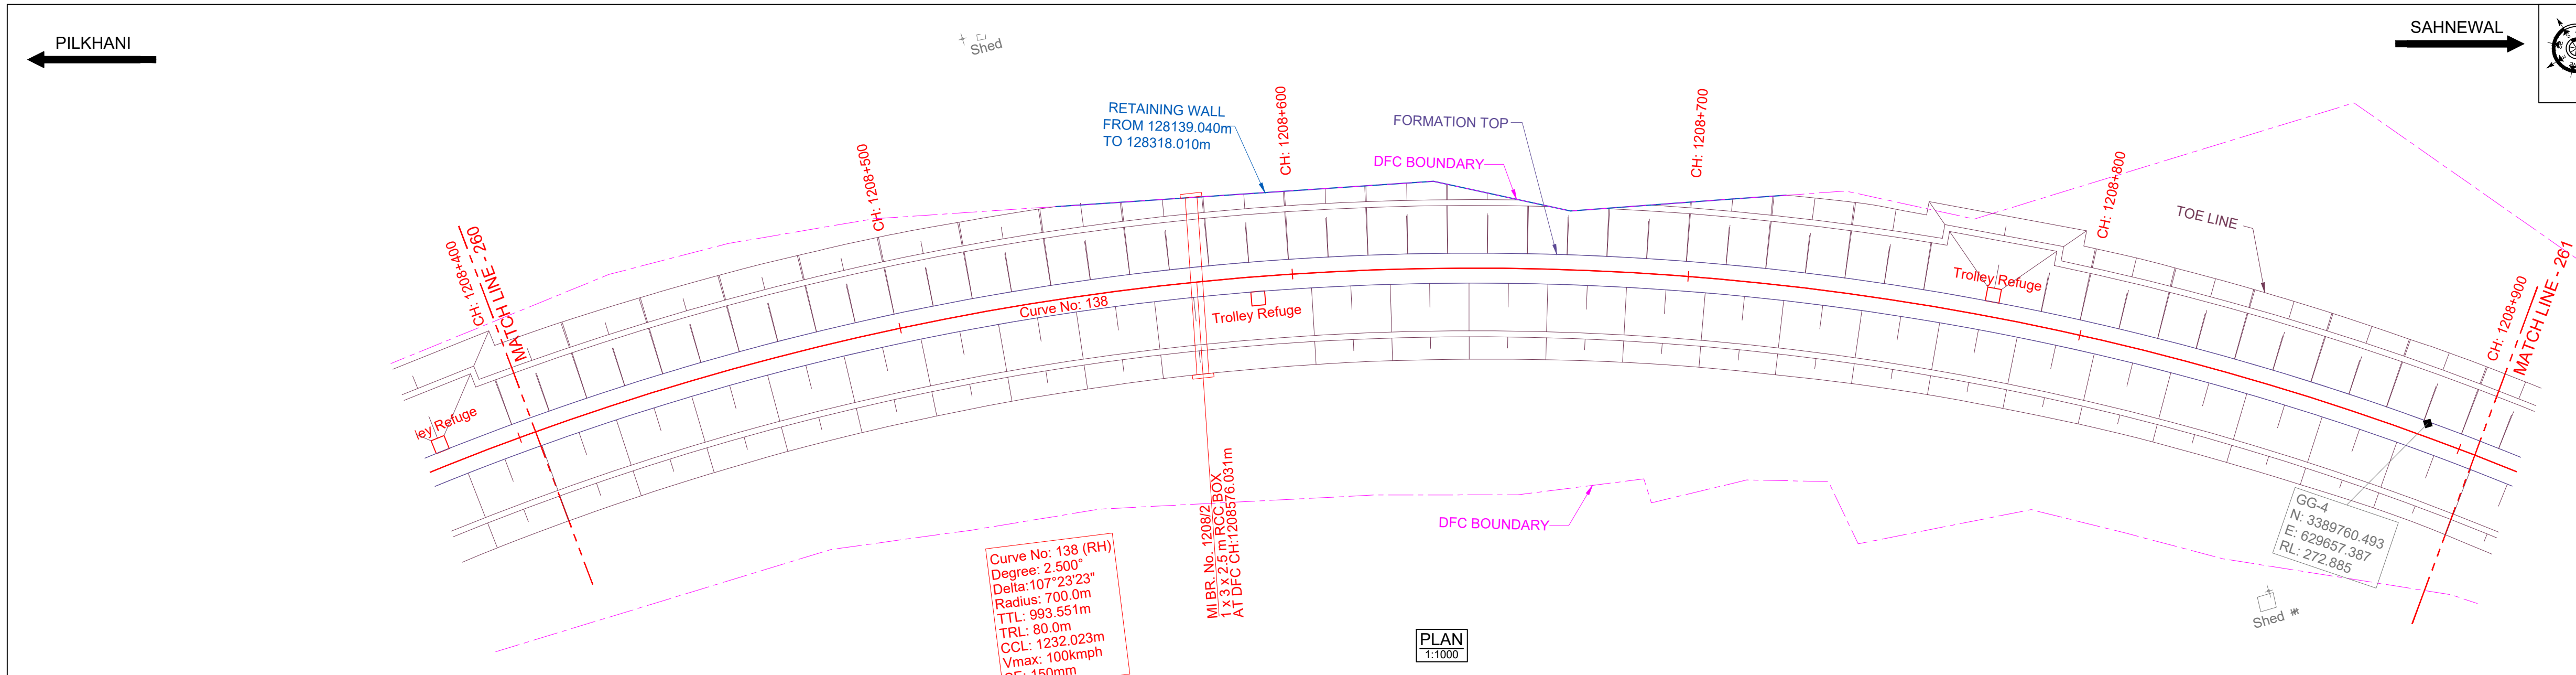

DATUM ABOVE MSL : 262 m

HORIZONTAL ALIGNMENT	R = 700m																			
VERTICAL ALIGNMENT	L=1692.889 m 1 IN 381.150 F																			
HEIGHT OF BANKING(+) / DEPTH OF CUTTING(-) (PFL-GL)	+9.459	+9.417	+9.376	+9.325	+9.334	+9.272	+9.170	+9.126	+9.128	+9.062	+9.004	+8.963	+8.946	+8.893	+8.840	+8.808	+8.723	+8.713	+8.623	+8.613
EXG GROUND LEVEL AT CENTER LINE OF DFC TRACK (GL)	264.693	264.693	264.672	264.670	264.609	264.618	264.668	264.659	264.605	264.618	264.624	264.612	264.577	264.577	264.578	264.557	264.590	264.547	264.585	264.542
DFC FORMATION LEVEL (PFL)	274.152	274.100	274.048	273.995	273.943	273.890	273.838	273.785	273.733	273.680	273.628	273.575	273.523	273.470	273.418	273.365	273.313	273.260	273.208	273.155
DFC RAIL LEVEL (PRL)	274.666	274.613	274.561	274.508	274.456	274.403	274.351	274.298	274.246	274.193	274.141	274.088	274.036	273.983	273.931	273.878	273.826	273.774	273.721	273.668
DFC TRACK CHAINAGE	1208404.6	1208424.6	1208444.6	1208464.6	1208484.6	1208504.6	1208524.6	1208544.6	1208564.6	1208584.6	1208604.6	1208624.6	1208644.6	1208664.6	1208684.6	1208704.6	1208724.6	1208744.6	1208764.6	1208784.6

L - SECTION

DRG NO. 301-2/AL/A/1261

NOTE:-

1. DFC WORKS ARE SHOWN IN RED.

2. IR NEW WORKS ARE SHOWN IN VIOLET.

3. ALL DIMENSIONS ARE SHOWN IN METRES.

4. THIS DRAWING IS PREPARED BASED ON LATEST SURVEY DATA HELD ON APRIL-2022. GTS BENCH MARK OF 261.850M CONSIDERED ON TOP OF CANAL BRIDGE ABUTMENT AT DORANA VILLAGE ALONG THE NH1.

5. DFC NEW CHAINAGE OF 1075.950M IS WITH REFERENCE TO THE IR KM OF 187.500KM END OF KM OF CP-303(SECTION P-3 PILKHANI END) AGAINST THE EXISTING DFC CHAINAGE. 116277.742M ISSUED VIDE LETTER NO. COM/DFCC/UM/SURVEY/2021-301-230116-011173 DT. 17.01.2023.

6. BALLAST PROFILE HAS BEEN PROVIDED ACCORDING TO THE CLAUSE 1.11.3 OF STANDARD SCHEDULE OF DIMENSION(EASTERN CORRIDOR) & THE BALLAST CUSHION DIMENSION SHOWN IN 35CM ON GE-14 PARA 17. SPECIFICATIONS & RECOMMENDATIONS 2. TWO LAYER SYSTEM FIG.10.

REFERENCE DRAWINGS :-

1. FOR KEY PLAN REFER DRAWING NO. 301-2/AL/0001

2. FOR LEGEND AND ABBREVIATIONS REFER DRAWING NO. 301-2/AL/1000

3. FOR TYPICAL SECTION OF BALLAST PROFILE (FL-RL) REFER DRG. NO. 301-2/TK/TFD/-004 (TR.1952)

0

18.09.2024

SUBMISSION OF AS-BUILT DRAWING

FOR APPROVAL

REV.

DATE

REVISION DETAILS

PURPOSE OF ISSUE

SCALE

HOR - 1:1000

VER - 1:100

SHEET SIZE : A1

LEGEND:-

IR TRACK

DFCC TRACK

DFCC FUTURE PROPOSALS

STRUCTURE / BUILDING

DFCC TOE LINE

DFCC FORMATION

RETAINING WALL

ROAD

STREAM, DRAIN, NALA, CANAL.

FENCE

POWER LINES

TBM

ELECTRIC POLE/OHE MAST

IR RAILWAY BOUNDARY

DFCC BOUNDARY

TYPICAL SECTION

3900

3900

1.5

1.5

TRACK STRUCTURE

RAIL SECTION: 60Kg/m (UIC 60Kg/m)

DFC LINE: 60Kg/m (UIC 60Kg/m)

IR MAIN LINE: 52Kg/m

Difference between FL- RL (Below Rail Seat)

IR Line

DFC

172mm

172mm

RUBBER PAD

6mm

10mm

SLEEPER DEPTH

210mm

210mm

BALLAST CUSHION

300mm

350mm

Total Depth (FL TO RL)

688mm

742mm

OWNER

DEDICATED FREIGHT CORRIDOR CORPORATION OF INDIA LTD.

(A GOVERNMENT OF INDIA ENTERPRISE)

PROJECT OFFICE/AMBALA UNIT: OLD RAILWAY COLONY (NEAR ANAND MARKET),AMBALA CANTT-133001.

CORPORATE IDENTITY NO. : U60232DL20060G01155068

ENGINEER:

DB Engineering & Consulting GmbH

Deutsche Bahn Engineering & Consulting GmbH

CONTRACTOR:

GIL - TPL JV

GAR

TATA

SUBMITTED BY

GIL - TPL JV

DATED

NAME

SIGNATURE

PREPARED BY

18.09.2024

VIJAY PRATAP

CHECKED BY

18.09.2024

PARASURAM KOTYADA

APPROVED BY

DEUTSCHE BAHN ENGINEERING & CONSULTING GMBH

DATED

NAME

SIGNATURE

Sr. DE./CHIEF ENGINEER

SURESH K.YALANGI

CHIEF TRACK ENGINEER

RAJ PAL SINGH

T.L.

H.D. VIDJAK

STAMP

A

AS-BUILT DRAWING

TR. Ref.....

ENGINEER Sign.:

EMPLOYER (DFCCIL):

DEDICATED FREIGHT CORRIDOR CORPORATION OF INDIA LTD.

AS BUILT DRAWING

TITLE

AS-BUILT PLAN AND PROFILE

DFCC APPR. NO. -

ENGG. APPR. NO. -

DRG. NO. - 301-2/AL/A/1261

SHEET NO. : 1 OF 1

DATE : 18.09.2024

STATUS

A

DFC KM:1208.405 TO 1208.905 (DETOUR)

TR.