
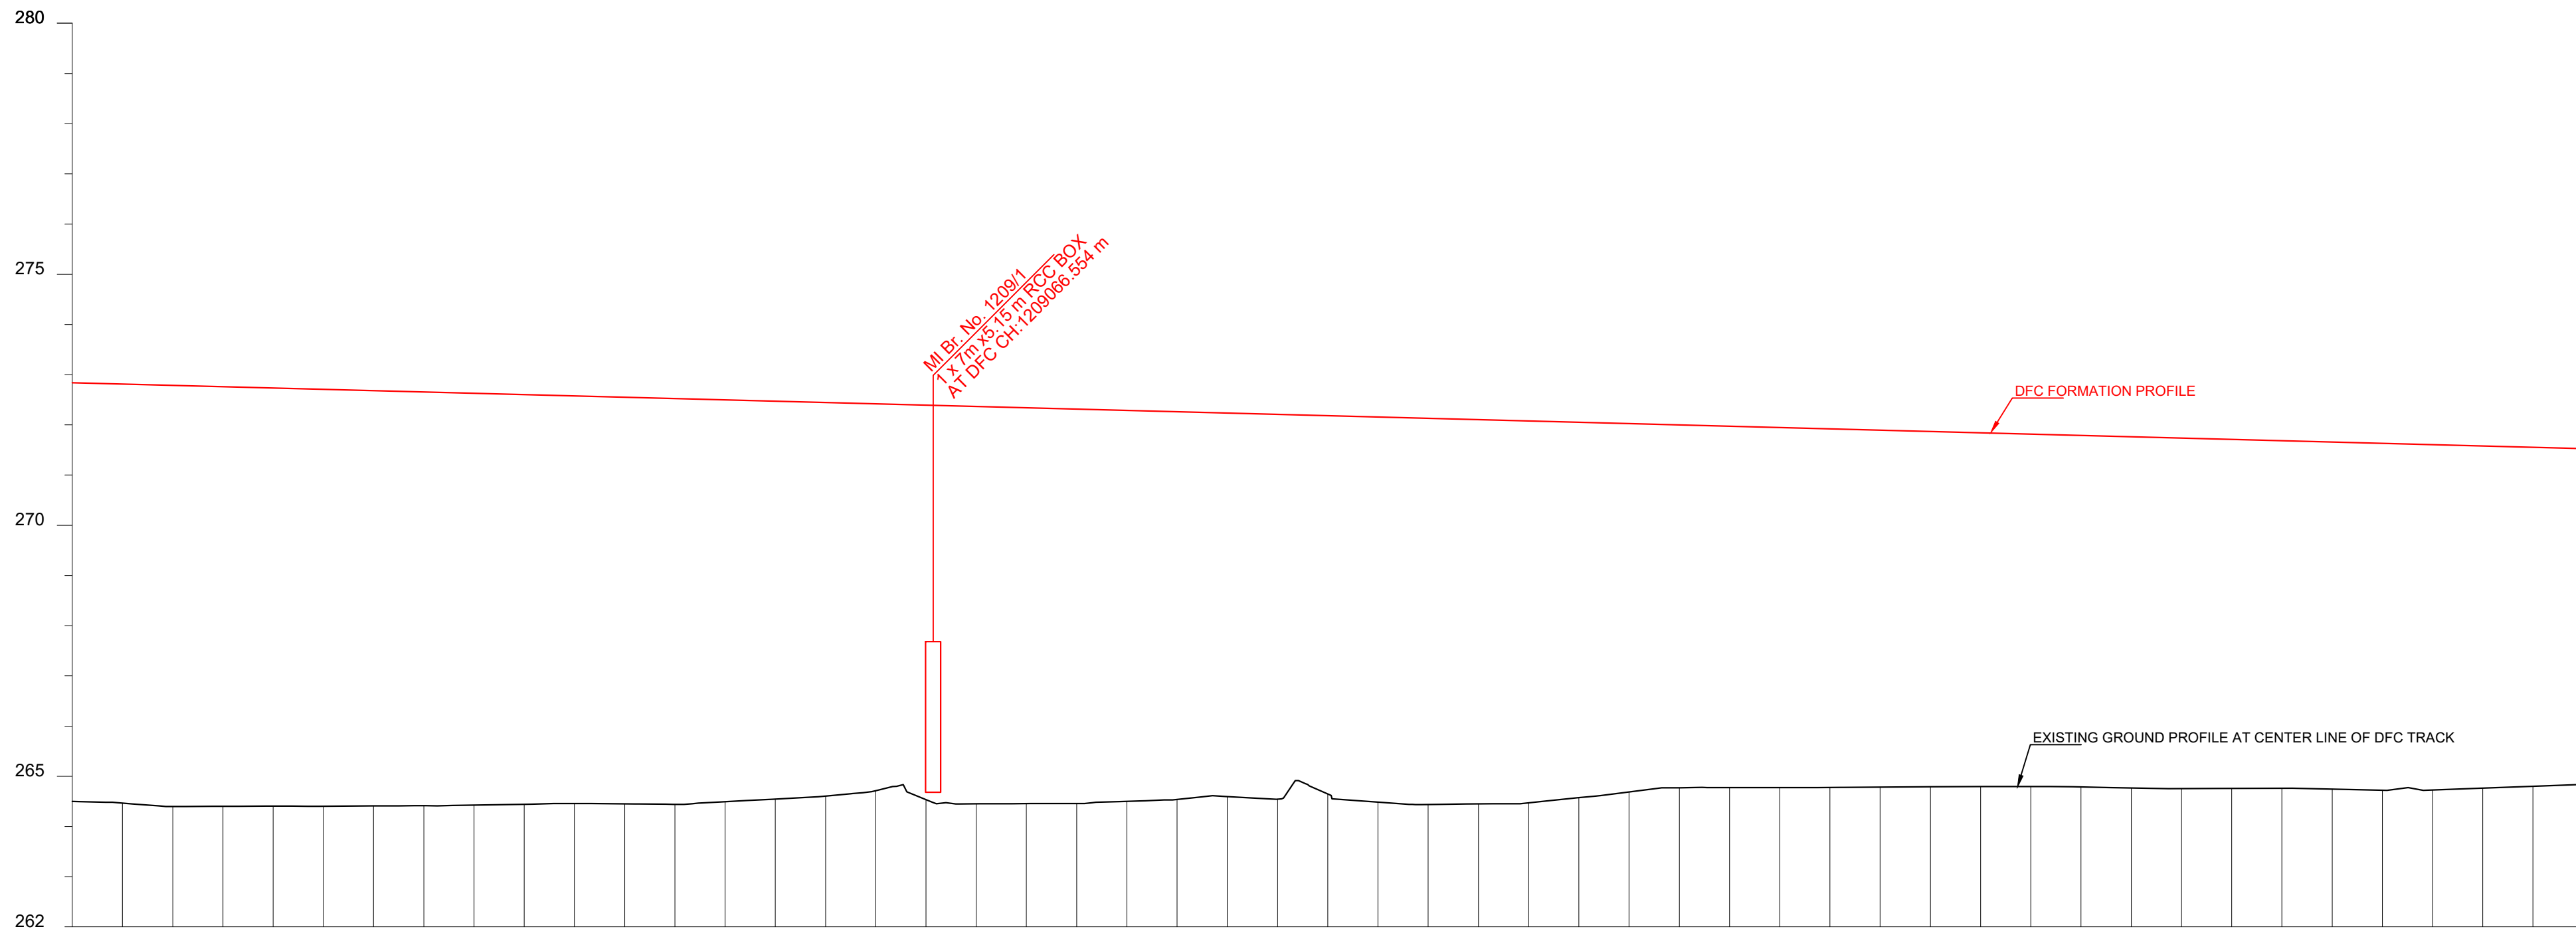


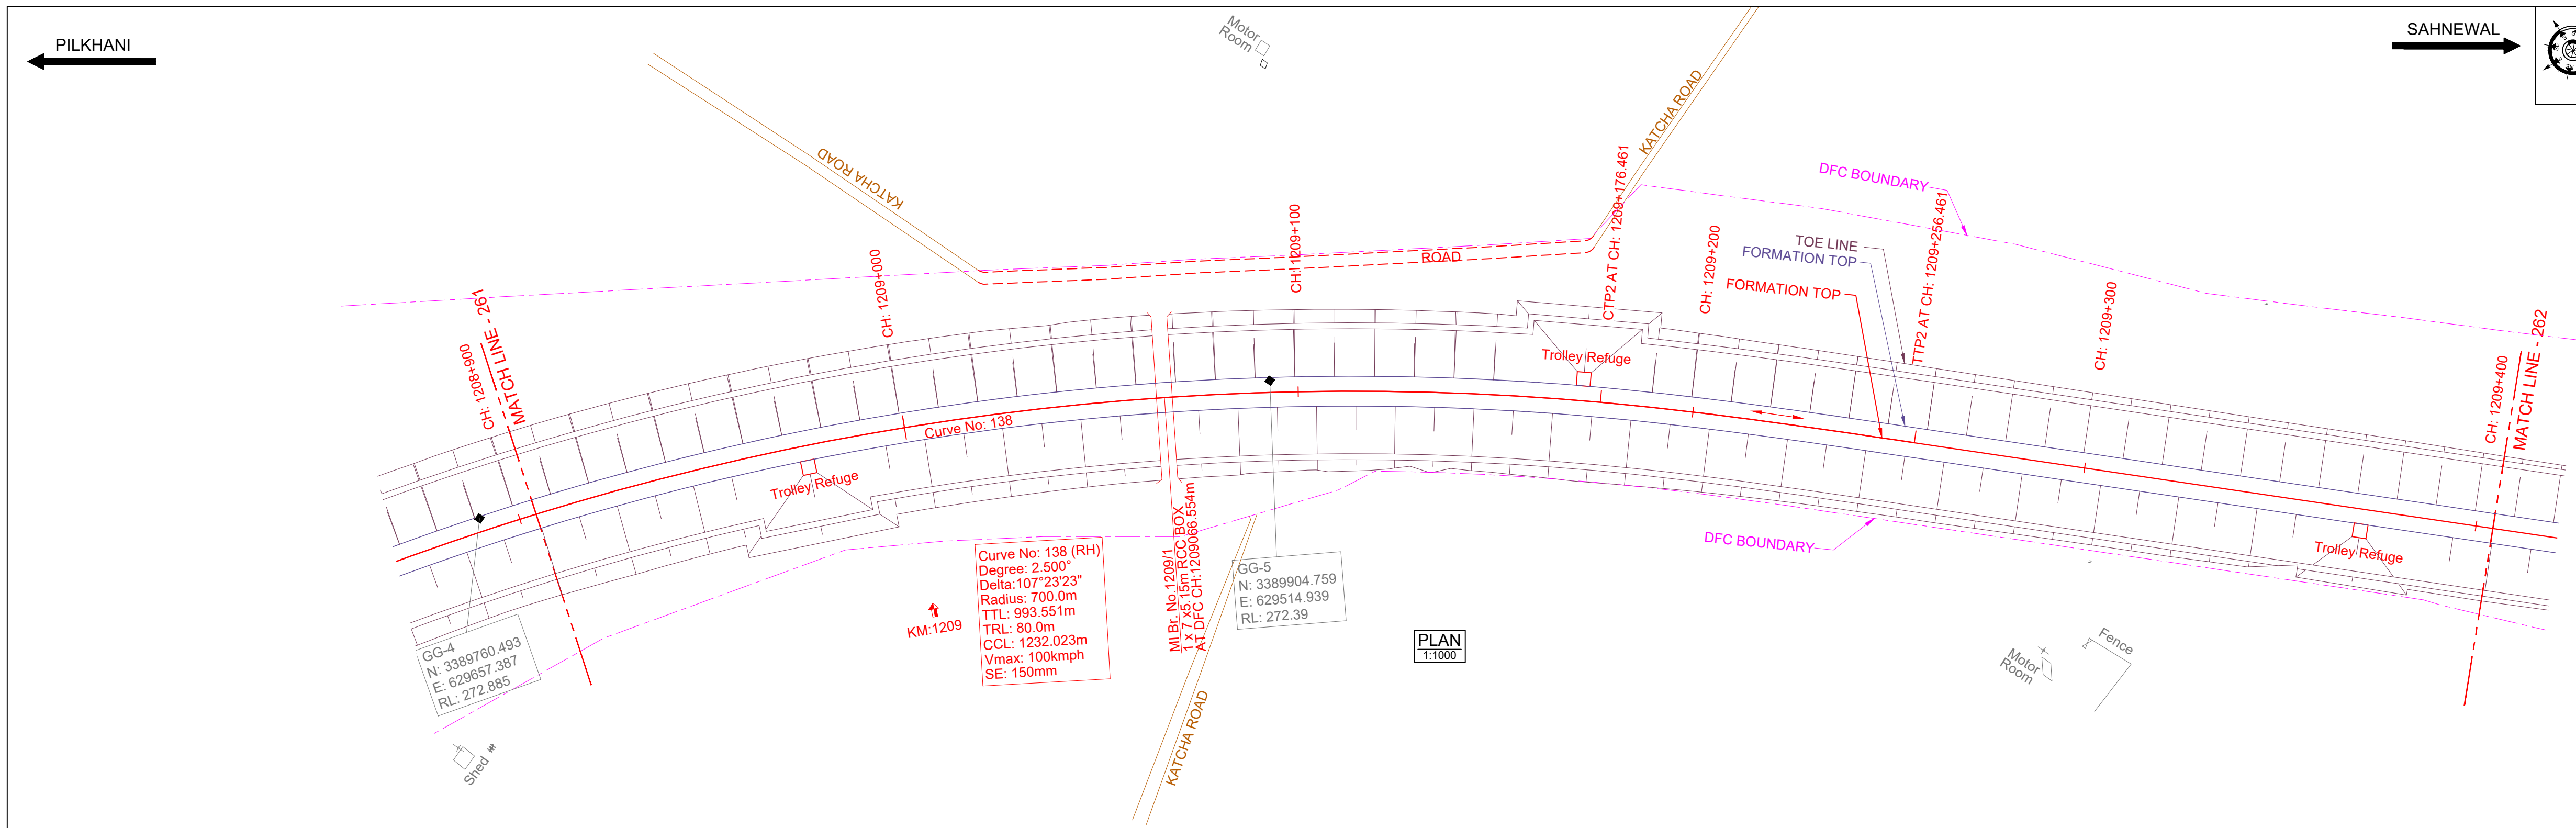


DATUM ABOVE MSL : 262 m

HORIZONTAL ALIGNMENT	R = 700m																			
VERTICAL ALIGNMENT	L = 1692.889 m 1 IN 381.150 F																			
HEIGHT OF BANKING(+) / DEPTH OF CUTTING(-) (PFL-GL)	+8.341	+8.391	+8.329	+8.274	+8.207	+8.120	+8.084	+7.926	+7.709	+7.917	+7.857	+7.724	+7.665	+7.675	+7.656	+7.478	+7.229	+7.173	+7.111	+7.047
EXG GROUND LEVEL AT CENTER LINE OF DFC TRACK (GL)	264.500	264.397	264.407	264.409	264.424	264.458	264.442	264.547	264.712	264.451	264.459	264.539	264.546	264.484	264.450	264.576	264.772	264.776	264.787	264.755
DFC FORMATION LEVEL (PFL)	272.841	272.788	272.736	272.683	272.631	272.578	272.526	272.473	272.421	272.366	272.316	272.263	272.211	272.159	272.106	272.054	272.001	271.949	271.896	271.844
DFC RAIL LEVEL (PRL)	273.554	273.501	273.449	273.396	273.344	273.291	273.239	273.187	273.134	273.082	273.029	272.977	272.924	272.872	272.819	272.767	272.714	272.662	272.609	272.557
DFC TRACK CHAINAGE	1208904.6	1208924.6	1208944.6	1208964.6	1208984.6	1209004.6	1209024.6	1209044.6	1209064.6	1209084.6	1209104.6	1209124.6	1209144.6	1209164.6	1209184.6	1209204.6	1209224.6	1209244.6	1209264.6	1209284.6

L - SECTION

SAHNEWAL

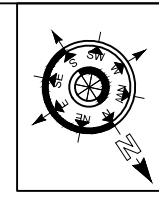

- NOTE:-
1. DFC WORKS ARE SHOWN IN RED.
 2. IR NEW WORKS ARE SHOWN IN VIOLET.
 3. ALL DIMENSIONS ARE SHOWN IN METRES.
 4. THIS DRAWING IS PREPARED BASED ON LATEST SURVEY DATA HELD ON APRIL-2022. GTS BENCH MARK OF 261.850M CONSIDERED ON TOP OF CANAL BRIDGE ABUTMENT AT DORANA VILLAGE ALONG THE NH1.
 5. DFC NEW CHAINAGE OF 1075.950M IS WITH REFERENCE TO THE IR KM OF 187.500KM END OF KM OF CP-303(SECTION P-3 PILKHANI END) AGAINST THE EXISTING DFC CHAINAGE. 116277.742M ISSUED VIDE LETTER NO. COM/DFCC/MB/SURVEY/2021-301-230116-011173 DT. 17.01.2023.
 6. BALLAST PROFILE HAS BEEN PROVIDED ACCORDING TO THE CLAUSE 1.11.3 OF STANDARD SCHEDULE OF DIMENSION(EASTERN CORRIDOR) & THE BALLAST CUSHION DIMENSION SHOWN IN 35CM ON GE-14 PARA 17. SPECIFICATIONS & RECOMMENDATIONS 2. TWO LAYER SYSTEM FIG.10.

- REFERENCE DRAWINGS :-
1. FOR KEY PLAN REFER DRAWING NO. 301-2/AL/0001
 2. FOR LEGEND AND ABBREVIATIONS REFER DRAWING NO. 301-2/AL/1000
 3. FOR TYPICAL SECTION OF BALLAST PROFILE (FL-RL) REFER DRG. NO. 301-2/TK/TFD/-004 (TR.1952)

0	18.09.2024	SUBMISSION OF AS-BUILT DRAWING	FOR APPROVAL
REV.	DATE	REVISION DETAILS	PURPOSE OF ISSUE

LEGEND:


SCALE

HOR - 1:1000

VER - 1:100

SHEET SIZE : A1

IR TRACK
DFCC TRACK
DFCC FUTURE PROPOSALS
STRUCTURE / BUILDING
DFCC TOE LINE
DFCC FORMATION
RETAINING WALL
ROAD
STREAM, DRAIN, NALA, CANAL.
FENCE
POWER LINES
TBM
ELECTRIC POLE/OHE MAST
IR RAILWAY BOUNDARY
DFCC BOUNDARY

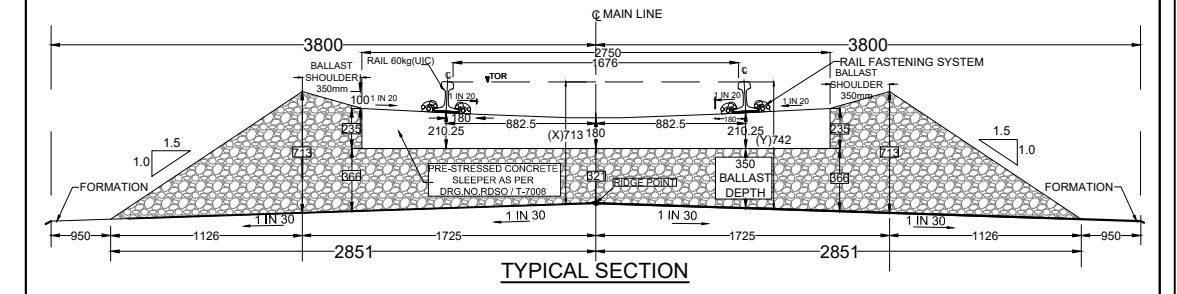

TRACK STRUCTURE		
RAIL SECTION: 60Kg/m (UIC 60Kg/m) DFC LINE: 60Kg/m (UIC 60Kg/m) IR MAIN LINE: 52Kg/m	Difference between FL- RL (Below Rail Seat)	
	IR Line	DFC
RUBBER PAD	172mm	172mm
SLEEPER DEPTH	6mm	10mm
BALLAST CUSHION	210mm	210mm
	300mm	350mm
Total Depth (FL TO RL)	688mm	742mm

OWNER

DEDICATED FREIGHT CORRIDOR CORPORATION OF INDIA LTD.

(A GOVERNMENT OF INDIA ENTERPRISE)

PROJECT OFFICE/AMBALA UNIT: OLD RAILWAY COLONY (NEAR ANAND MARKET),AMBALA CANTT.-133001.

CORPORATE IDENTITY NO. : U60232DL2006GGI155068

ENGINEER:

DB Engineering & Consulting GmbH

Deutsche Bahn Engineering & Consulting GmbH

CONTRACTOR:

GIL - TPL JV

GAR TATA

SUBMITTED BY	GIL - TPL JV		
	DATED	NAME	SIGNATURE
PREPARED BY			
CHECKED BY	18.09.2024	VIJAY PRATAP	
APPROVED BY	18.09.2024	PARASURAM KOTYADA	

APPROVED BY	DEUTSCHE BAHN ENGINEERING & CONSULTING GMBH		
	DATED	NAME	SIGNATURE
Sr. DE./CHIEF ENGINEER		SURESH K.YALANGI	
CHIEF TRACK ENGINEER		RAJ PAL SINGH	
T.L.		H.D. VIDJAK	

STAMP

A AS-BUILT DRAWING
TR. Ref.....
ENGINEER Sign.:

EMPLOYER (DFCCIL): DEDICATED FREIGHT CORRIDOR CORPORATION OF INDIA LTD.

--	--	--	--

AS BUILT DRAWING

TITLE

AS-BUILT PLAN AND PROFILE

DFCC APPR. NO. -

ENGG. APPR. NO. -

DRG. NO. - 301-2/AL/A/1262

SHEET NO. : 1 OF 1

DATE : 18.09.2024

STATUS

A