




DEDICATED FREIGHT CORRIDOR CORPORATION OF INDIA LTD.
(A GOVERNMENT OF INDIA ENTERPRISE)

EASTERN DEDICATED FREIGHT CORRIDOR
SAHNEWAL TO PILKHANI SECTION
CONTRACT PACKAGE - 301

PLAN & PROFILE OF AS BUILT DRAWINGS FOR DFC MAIN LINE

IR CHAINAGE FROM 319.500 KM TO 331.000 KM
DFCC CHAINAGE FROM KM 1210.395 TO KM 1221.876
(DETOUR FROM KM 1209.405 TO 1210.395)

DESIGN CONSULTANT


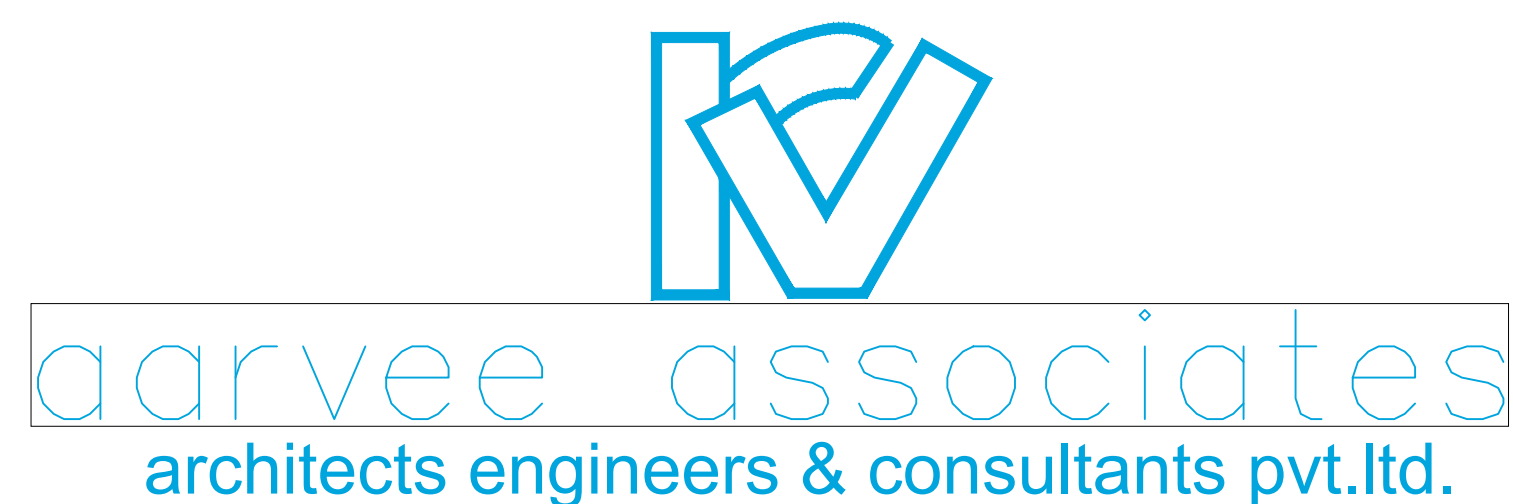


ENGINEER



CONTRACTOR CLIENT
GIL - TPL JV



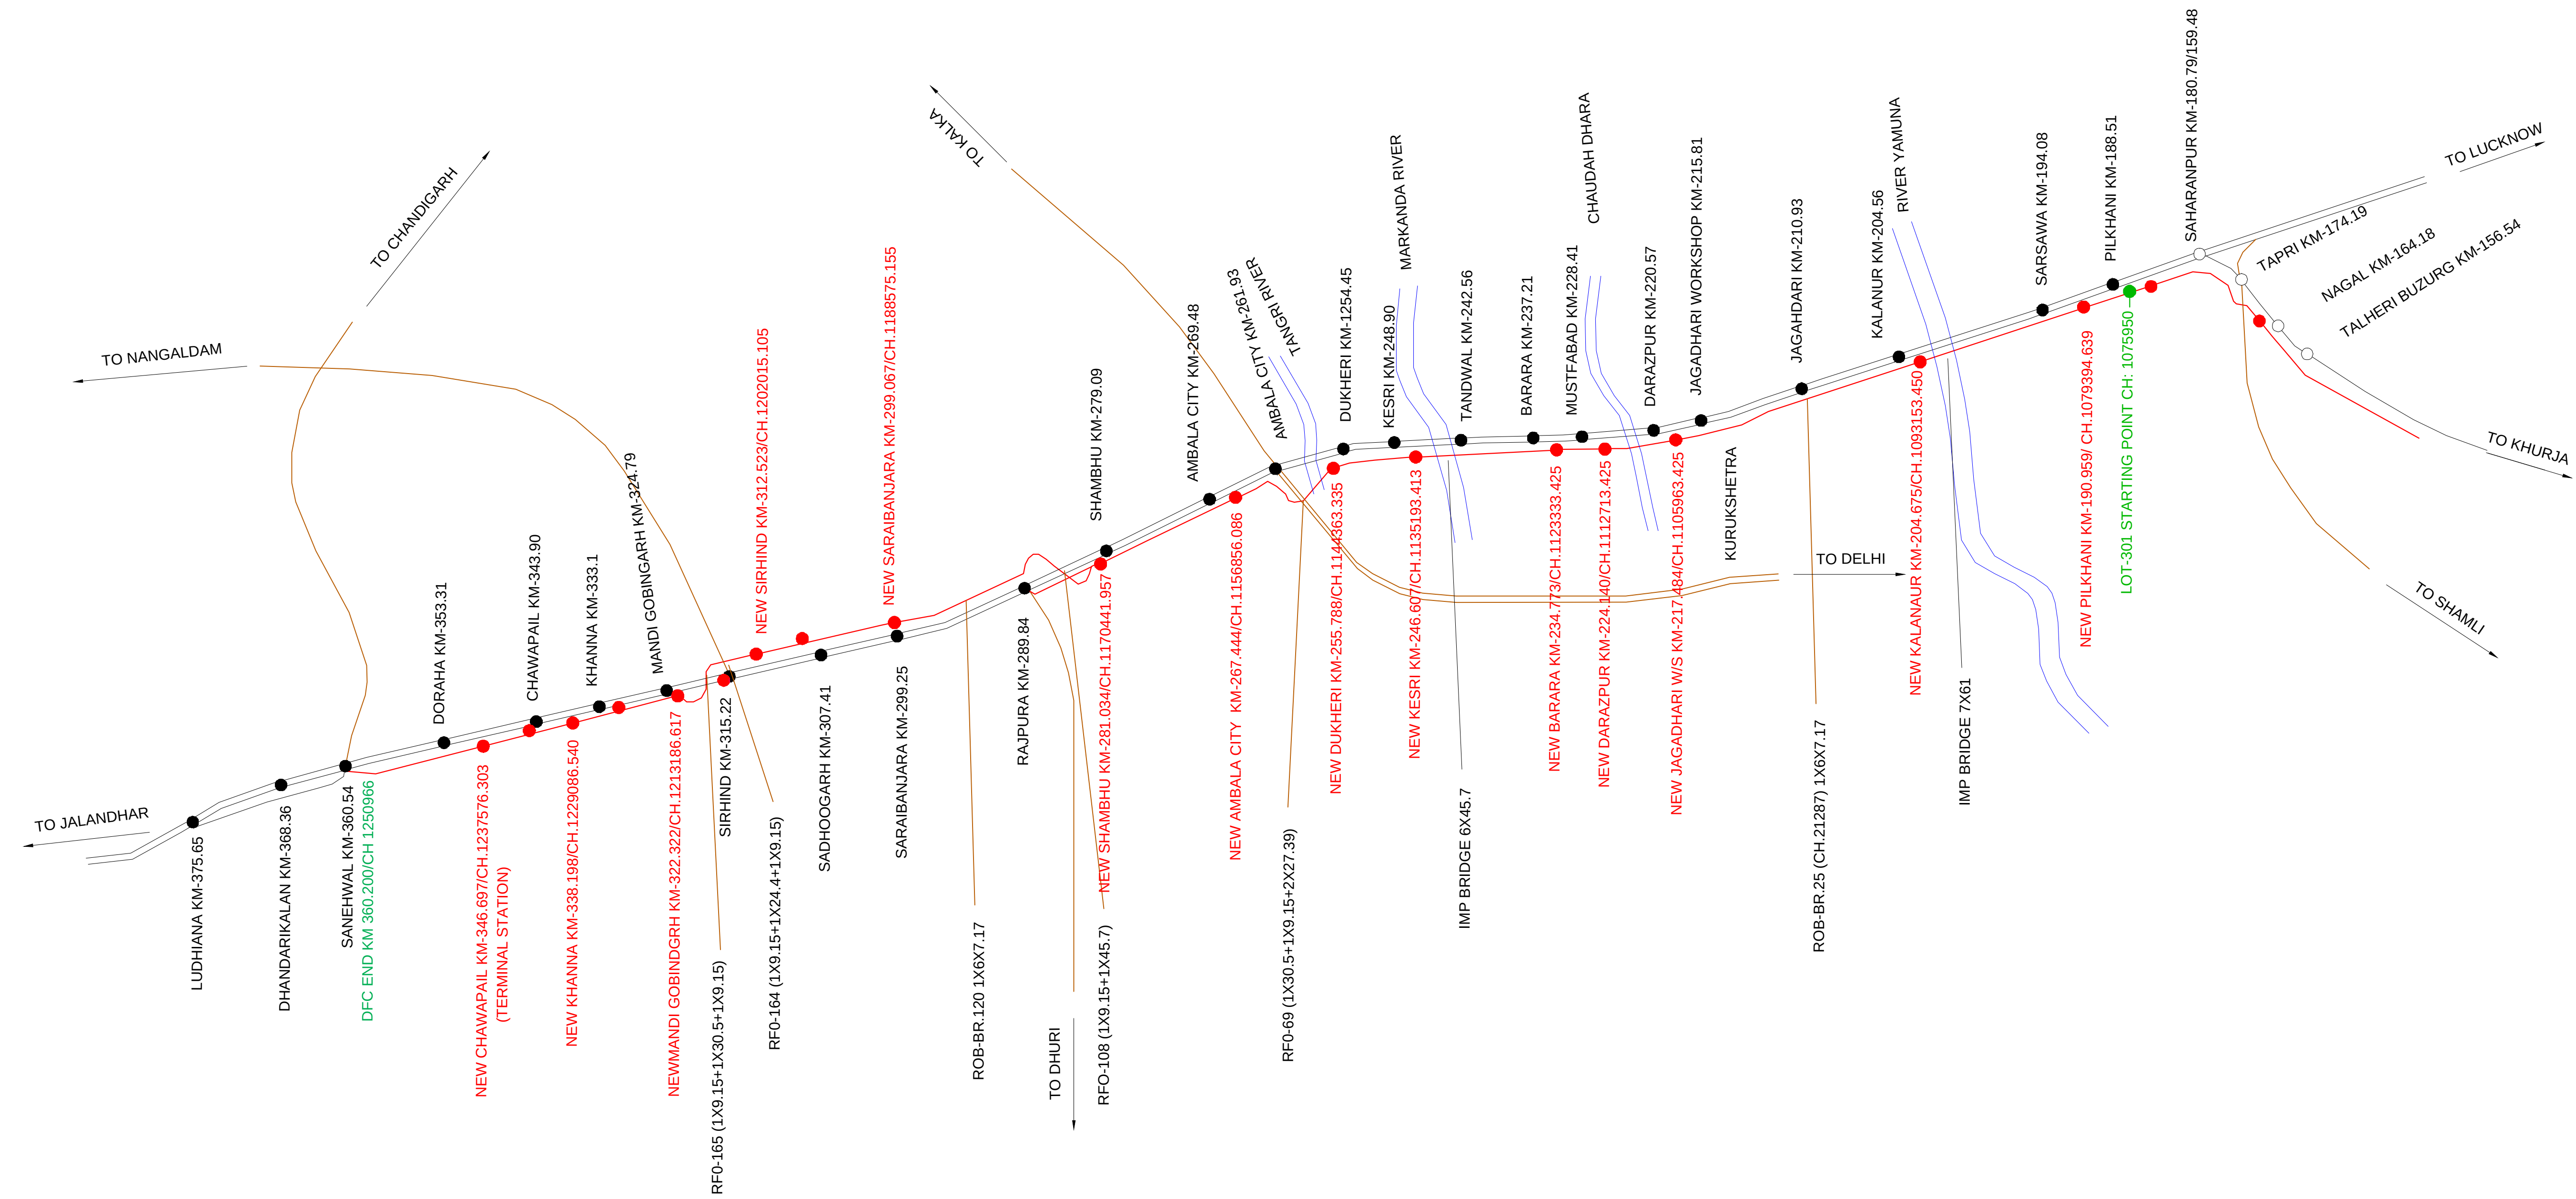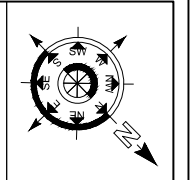

				SCALE	DESIGN CONSULTANT	CONTRACTOR	ENGINEER	OWNER	PROJECT	TITLE	DFCC APPR. NO. -			
				NOT TO SCALE	 aarvee associates architects engineers & consultants pvt.ltd.	  GIL - TPL JV	 DB Engineering & Consulting GmbH	 मेडीकेटल फ्रेट कॉर्पोरेश	DEDICATED FREIGHT CORRIDOR CORPORATION OF INDIA LTD. (A GOVERNMENT OF INDIA ENTERPRISE) PROJECT OFFICE(AMBALA UNIT): OLD RAILWAY COLONY (NEAR ANAND MARKET),AMBALA CANTT-133001. CORPORATE IDENTITY NO. : U60232DL2006GOI155068	EASTERN DEDICATED FREIGHT CORRIDOR SAHNEWAL TO PILKHANI CONTRACT PACKAGE - 301.	ALIGNMENT DRAWINGS KEY PLAN	ENGG. APPR. NO. -		
DRG. NO. : 301-2/AL/0001														
SHEET NO. : 1 OF 1	REV. NO.	STATUS												
REV.	DATE	REVISION DETAILS		PURPOSE OF ISSUE								DATE: 15-06-2024	0	A



LEGEND	
EXISTING IR TRACK	
DFC TRACK	
DFC FUTURE PROPOSALS	
IR PROPOSALS	
TOE LINE	
FORMATION CESS	
RETAINING WALL	
DRAIN CUM RETAINING WALL	
ROAD	
STREAM, DRAIN, NALA, CANAL.	
FENCE	
POWER LINES	
GPS POINTS	
ELECTRIC POLE/OHE MAST	
EXISTING RAILWAY BOUNDARY	
DFC BOUNDARY	
DISMANTLED WORKS	
IOCL PIPE LINE	
IOCL ROW	
SIGNALLING CABLE PIPE	

ABBREVIATIONS		
1.	BL	- BED LEVEL
2.	BVC	- BEGIN OF VERTICAL CURVE
3.	Ca	- APPLIED CANT
4.	CCL	- CIRCULAR CURVE LENGTH
5.	CTP1	- COMMON TANGENT POINT
6.	CTP2	- COMMON TANGENT POINT
7.	DEGREE	- DEGREE OF CURVE
8.	DE	- DEAD END
9.	ECL	- EXISTING CLEARANCE
10.	EFB	- EXISTING FREE BOARD
11.	EFL	- EXISTING FORMATION LEVEL
12.	ERL	- EXISTING RAIL LEVEL
13.	ESL	- EXISTING SOFFIT LEVEL
14.	EVC	- END OF VERTICAL CURVE
15.	EVCL	- EXISTING VERTICAL CLEARANCE
16.	F/CSB	- FROM CENTER LINE OF STN BLDG
17.	FM	- FOULING MARK
18.	FSL	- FULL SUPPLY LEVEL
19.	HFL	- HIGH FLOOD LEVEL
20.	L	- STRAIGHT LENGTH
21.	LH	- LEFT HANDED
22.	LHS	- LIMITED HEIGHT SUBWAY
23.	PCL	- PROPOSED CLEARANCE
24.	PFB	- PROPOSED FREE BOARD
25.	PFL	- PROPOSED FORMATION LEVEL
26.	PRL	- PROPOSED RAIL LEVEL
27.	PSL	- PROPOSED SOFFIT LEVEL
28.	PVCL	- PROPOSED VERTICAL CLEARANCE
29.	PVI	- POINT OF VERTICAL INTERSECTION
30.	R	- RADIUS
31.	REV.BL	- REVISED BED LEVEL
32.	RH	- RIGHT HANDED
33.	Rr	- RESULTANT RADIUS
34.	SE	- SUPER ELEVATION
35.	SRJ	- STOCK RAIL JOINT
36.	TS	- TRAP SWITCH
37.	TTL	- TOTAL TANGENT LENGTH
38.	TTP1	- TRANSITION TANGENT POINT
39.	TTP2	- TRANSITION TANGENT POINT
40.	TL	- TRANSITION LENGTH
41.	DELTA	- DEFLECTION ANGLE


--	--	
PILKHANI

SAHNEWAL

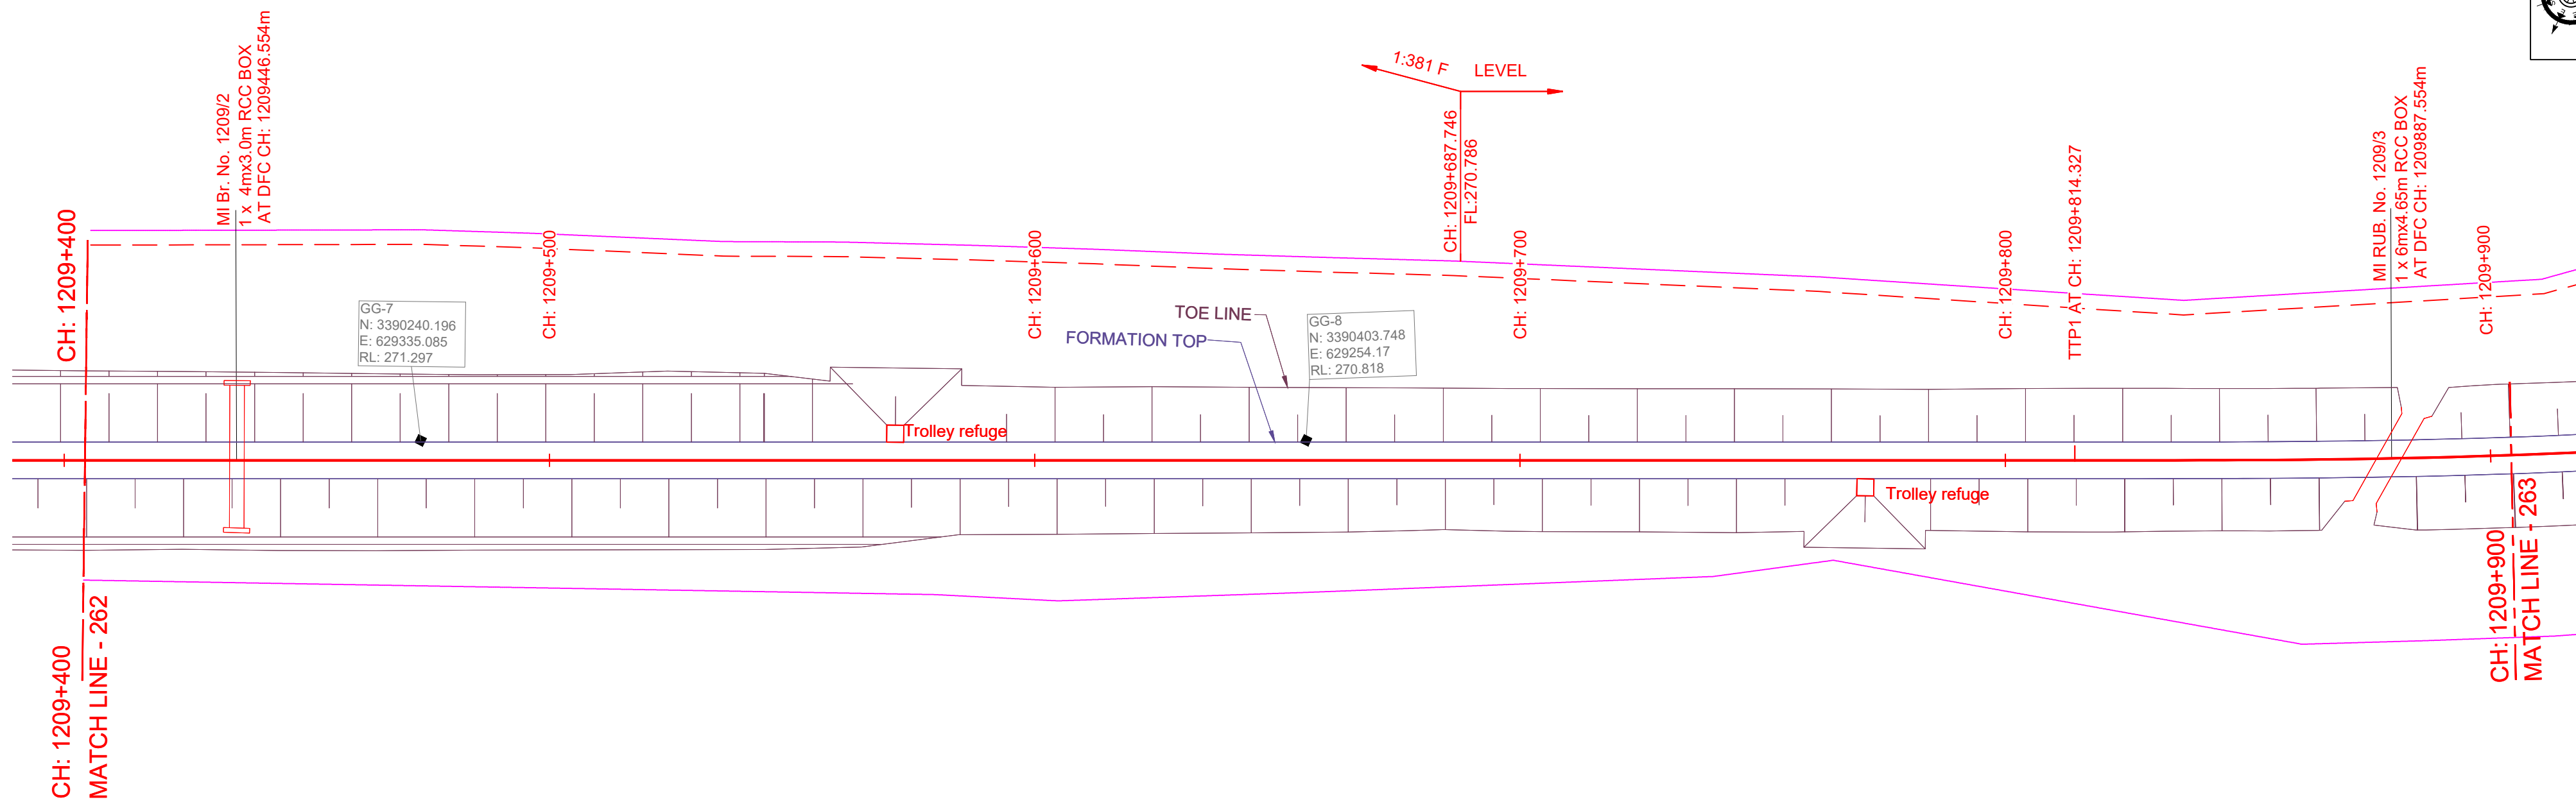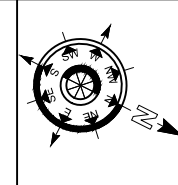

PLAN
1:1000

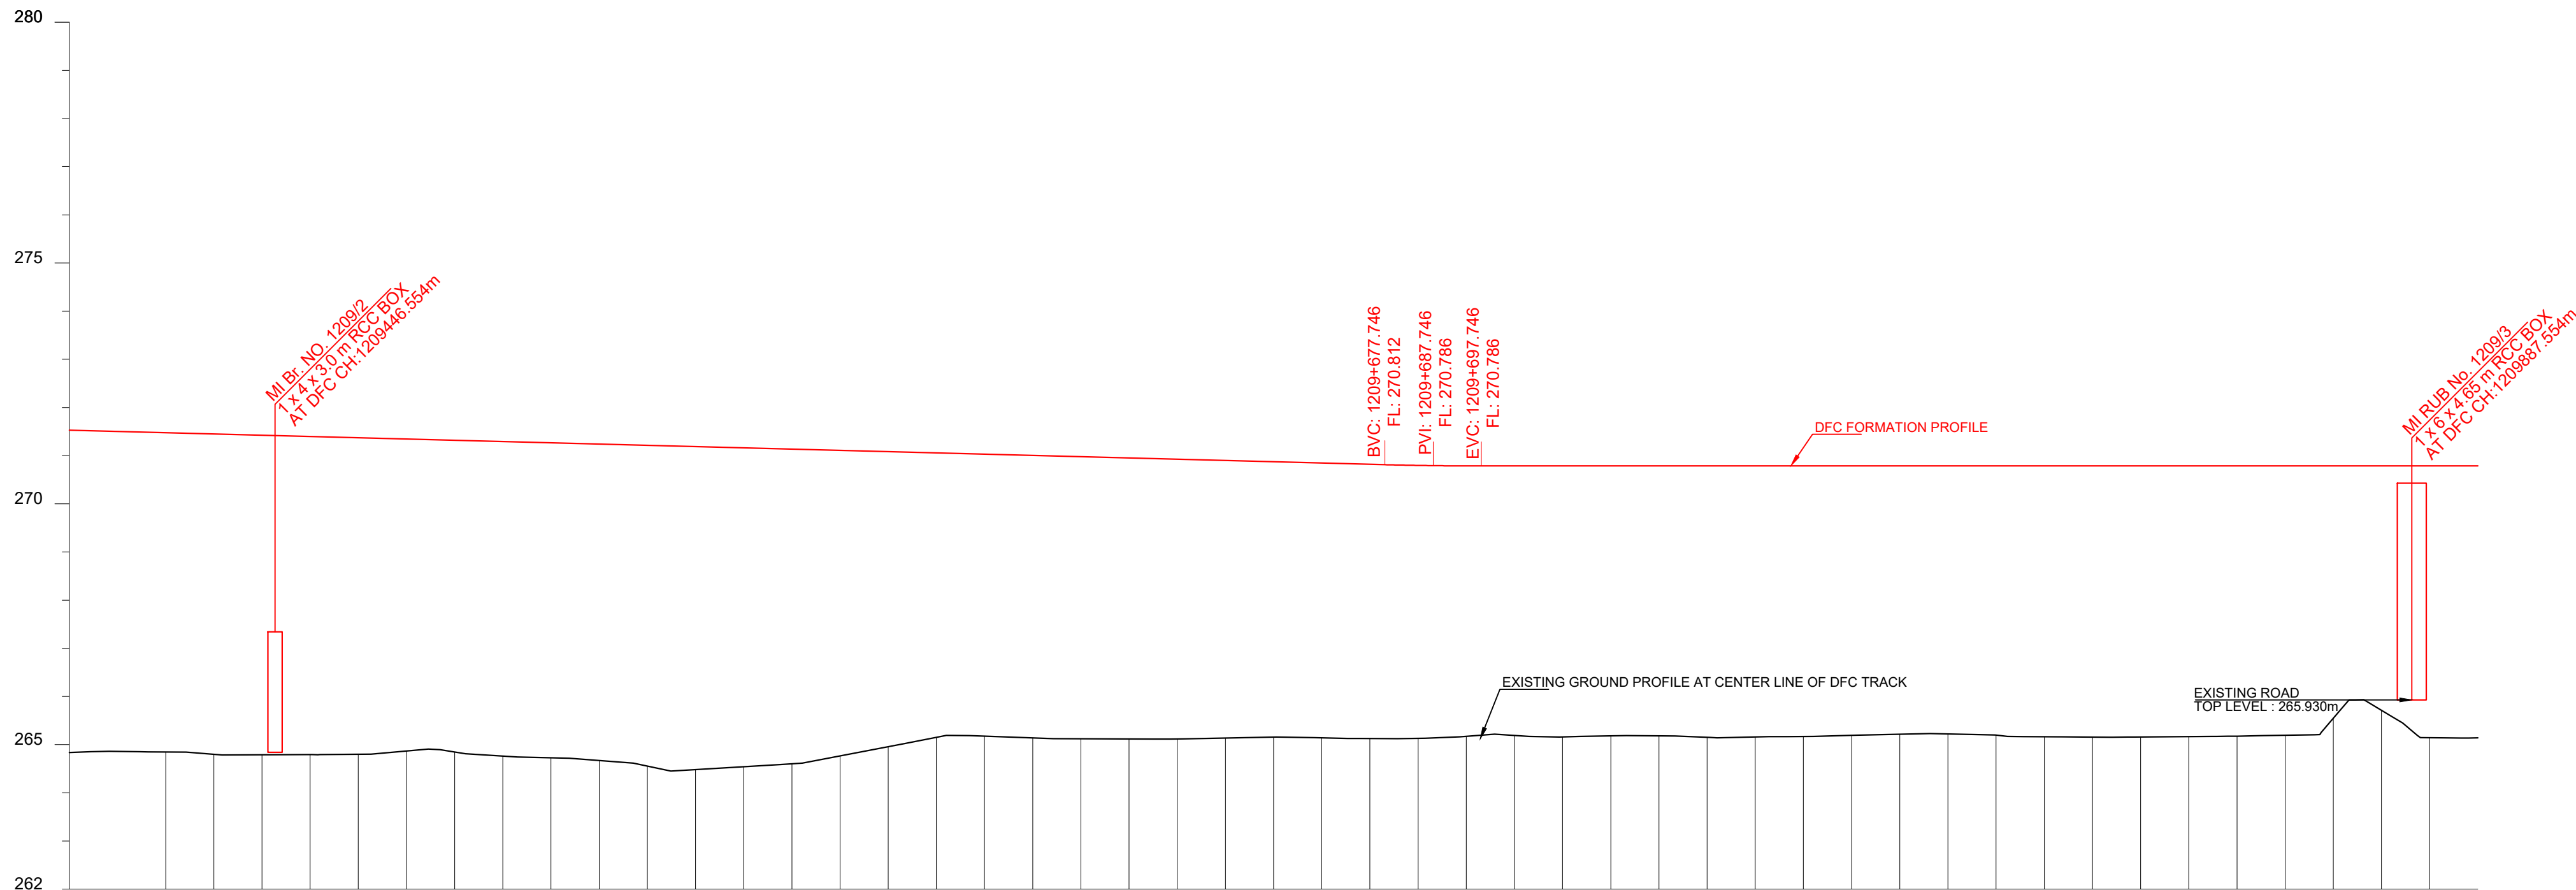

DATUM ABOVE MSL : 262 m

HORIZONTAL ALIGNMENT	L = 557.867m TL = 160m																			
VERTICAL ALIGNMENT	L=1692.889 m 1 IN 381.150 F L=20.0 m R=7623.3 m L=1254.449 m LEVEL																			
HEIGHT OF BANKING(+) / DEPTH OF CUTTING(-) (PFL-GL)	+6.692	+6.630	+6.636	+6.569	+6.473	+6.541	+6.656	+6.620	+6.343	+5.906	+5.863	+5.834	+5.763	+5.706	+5.667	+5.635	+5.618	+5.569	+5.587	+5.629
EXG GROUND LEVEL AT CENTER LINE OF DFC TRACK (GL)	264.837	264.846	264.788	264.802	264.846	264.725	264.556	264.542	264.766	265.151	265.141	265.118	265.136	265.141	265.130	265.191	265.181	265.151	265.168	265.217
DFC FORMATION LEVEL (PFL)	271.529	271.476	271.424	271.371	271.319	271.266	271.214	271.162	271.109	271.057	271.004	270.952	270.899	270.847	270.797	270.786	270.786	270.786	270.786	270.786
DFC RAIL LEVEL (PRL)	272.242	272.190	272.137	272.085	272.032	271.980	271.927	271.875	271.822	271.770	271.717	271.665	271.612	271.560	271.507	271.499	271.499	271.499	271.499	271.499
DFC TRACK CHAINAGE	1209404.6	1209424.6	1209444.6	1209464.6	1209484.6	1209504.6	1209524.6	1209544.6	1209564.6	1209584.6	1209604.6	1209624.6	1209644.6	1209664.6	1209684.6	1209704.6	1209724.6	1209744.6	1209764.6	1209784.6

L - SECTION

- NOTE:-
- DFCC WORKS ARE SHOWN IN RED.
 - IR NEW WORKS ARE SHOWN IN VIOLET.
 - ALL DIMENSIONS ARE SHOWN IN METRES.
 - THIS DRAWING IS PREPARED BASED ON LATEST SURVEY DATA HELD ON APRIL-2022. GTS BENCH MARK OF 261.850M CONSIDERED ON TOP OF CANAL BRIDGE ABUTMENT AT DORANA VILLAGE ALONG THE NH1.
 - DFC NEW CHAINAGE OF 1075.950M IS WITH REFERENCE TO THE IR KM OF 187.500KM END OF KM OF CP-303(SECTION P-3 PILKHANI END) AGAINST THE EXISTING DFC CHAINAGE. 116277.742M ISSUED VIDE LETTER NO. COM/DFCC/UM/SURVEY/2021-301-230116-011173 DT. 17.01.2023.
 - BALLAST PROFILE HAS BEEN PROVIDED ACCORDING TO THE CLAUSE 1.11.3 OF STANDARD SCHEDULE OF DIMENSION(EASTERN CORRIDOR) & THE BALLAST CUSHION DIMENSION SHOWN IN 35CM ON GE-14 PARA 17. SPECIFICATIONS & RECOMMENDATIONS 2. TWO LAYER SYSTEM FIG.10.

- REFERENCE DRAWINGS :-
- FOR KEY PLAN REFER DRAWING NO. 301-2/AL/0001
 - FOR LEGEND AND ABBREVIATIONS REFER DRAWING NO. 301-2/AL/1000
 - FOR TYPICAL SECTION OF BALLAST PROFILE (FL-RL) REFER DRG. NO. 301-2/TK/TFD/004 (TR.1952)

REV.	DATE	REVISION DETAILS	PURPOSE OF ISSUE
0	26.09.2024	SUBMISSION OF AS-BUILT DRAWING	FOR APPROVAL

LEGEND:


SCALE

HOR - 1:1000

VER - 1:100

SHEET SIZE : A1

IR TRACK
DFCC TRACK
DFCC FUTURE PROPOSALS
STRUCTURE / BUILDING
DFCC TOE LINE
DFCC FORMATION
RETAINING WALL
ROAD
STREAM, DRAIN, NALA, CANAL.
FENCE
POWER LINES
TBM
ELECTRIC POLE/OHE MAST
IR RAILWAY BOUNDARY
DFCC BOUNDARY

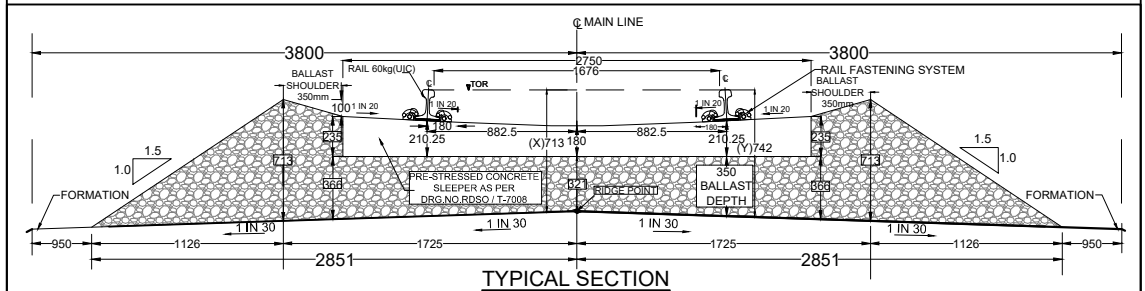

TRACK STRUCTURE		
RAIL SECTION: 60Kg/m (UIC 60Kg/m) DFC LINE: 60Kg/m (UIC 60Kg/m) IR MAIN LINE: 52Kg/m	Difference between FL- RL (Below Rail Seat)	
	IR Line	DFC
RUBBER PAD	172mm	172mm
SLEEPER DEPTH	6mm	10mm
BALLAST CUSHION	210mm	210mm
	300mm	350mm
Total Depth (FL TO RL)	688mm	742mm

OWNER

DEDICATED FREIGHT CORRIDOR CORPORATION OF INDIA LTD.
(A GOVERNMENT OF INDIA ENTERPRISE)
PROJECT OFFICE/AMBALA UNIT: OLD RAILWAY COLONY (NEAR ANAND MARKET), AMBALA CANTT-133001.
CORPORATE IDENTITY NO. : U60232DL2006GGI155068

ENGINEER:

DB Engineering & Consulting GmbH
Deutsche Bahn Engineering & Consulting GmbH

CONTRACTOR:

GIL - TPL JV
GAR TATA


SUBMITTED BY	GIL - TPL JV		
	DATED	NAME	SIGNATURE
PREPARED BY			
CHECKED BY	26.09.2024	VIJAY PRATAP	
APPROVED BY	26.09.2024	PARASURAM KOTYADA	

APPROVED BY	DEUTSCHE BAHN ENGINEERING & CONSULTING GMBH		
	DATED	NAME	SIGNATURE
Sr. DE./CHIEF ENGINEER		SURESH K.YALANGI	
CHIEF TRACK ENGINEER		RAJ PAL SINGH	
T.L.		H.D. VIDJAK	

STAMP	A AS-BUILT DRAWING TR. Ref.:..... ENGINEER Sign.:		
EMPLOYER (DFCCIL):	DEDICATED FREIGHT CORRIDOR CORPORATION OF INDIA LTD.		

AS BUILT DRAWING			
TITLE		DFCC APPR. NO. - ENGG. APPR. NO. -	
AS-BUILT PLAN AND PROFILE		DRG. NO. - 301-2/AL/A/1263	
DFC KM:1209.405 TO 1209.905 (DETOUR)		SHEET NO. : 1 OF 1	STATUS A
		DATE : 26.09.2024	

TR.

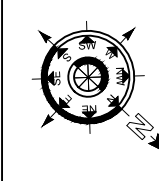

NOTE



1. DFC WORKS ARE SHOWN IN **RED**.
2. NEW WORKS ARE SHOWN IN **VIOLET**.
3. ALL DIMENSIONS ARE SHOWN IN METERS.
4. THIS DRAWING IS PREPARED BASED ON LATEST SURVEY DATA HELD ON APRIL-2022. GTS BENCH MARK OF 261.850M CONSIDERED ON TOP OF CANAL BRIDGE ABUTMENT AT DORAHA VILLAGE ALONG THE DFC.
5. DFC NEW CUMULATIVE OF 1075.95M WITH REFERENCE TO THE IR M OF 187.500M END OF KM OF 1075.95M TO P-3. P-3 POINT MUST BE THE END OF DFC. DFC POINTS: 116227.742M ISSUED BY LETTER NO. CGMID/MSB/SEV/2022/116111-1117. IR M: 17.0121.
6. BALLAST PROFILE HAS BEEN PROVIDED ACCORDING TO THE CLAUSE 11.1.3 OF STANDARD SCHEDULE FOR BALLAST CORRIDOR. THE BALLAST CUSHION DIMENSION IS 20CM IN 35CM ON GE-1.
7. BALL. 17. SPECIFICATIONS & RECOMMENDATIONS 2. TWO LAYER SYSTEM F10.

REFERENCE DRAWINGS :-

1. FOR KEY PLAN REFER DRAWING NO. 301-2/AL/0001
2. FOR LEGEND AND ABBREVIATIONS REFER DRAWING NO. 301-2/AL/1000
3. FOR TYPICAL SECTION OF BALLAST PROFILE (FL-RL) REFFER DRG. NO. 301-2/TK/TFD/-004 (TR.1952)

0	26.09.2024	SUBMISSION OF AS-BUILT DRAWING	FOR APPROVAL
REV.	DATE	REVISION DETAILS	PURPOSE OF ISSUE

LEGEND:

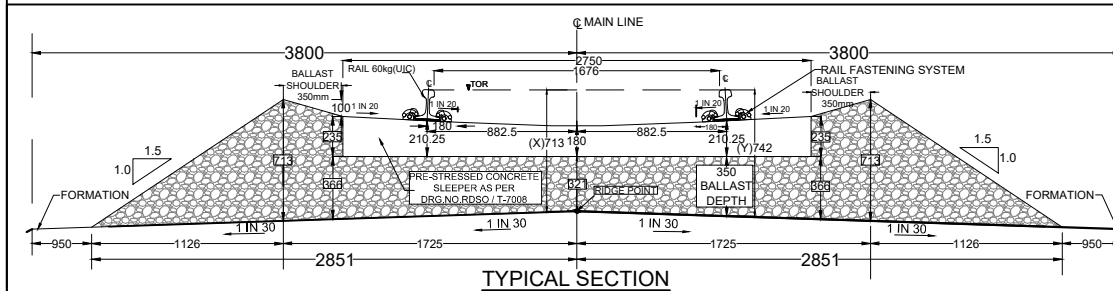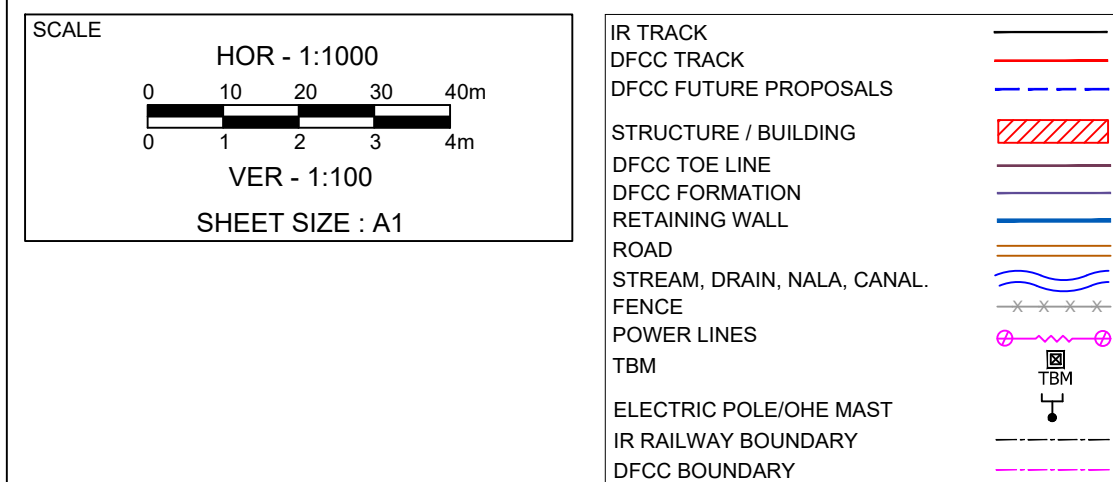

TRACK STRUCTURE		
RAIL SECTION: 60Kg/m (UIC 60Kg/m) DFC LINE: 60Kg/m (UIC 60Kg/m) IR MAIN LINE: 52Kg/m	Difference between FL- RL (Below Rail Seat)	
	IR Line	DFC
	172mm	172mm
RUBBER PAD	6mm	10mm
SLEEPER DEPTH	210mm	210mm
BALLAST CUSHION	300mm	350mm
Total Depth (FL TO RL)	688mm	742mm

OWNER	DEDICATED FREIGHT CORRIDOR CORPORATION OF INDIA LTD.
-------	--



DEDICATED FREIGHT CORRIDOR CORPORATION OF INDIA LTD.
(A GOVERNMENT OF INDIA ENTERPRISE)
PROJECT OFFICE(AMBALA UNIT): OLD RAILWAY COLONY (NEAR
ANAND MARKET),AMBALA CANTT-133001.
CORPORATE IDENTITY NO. : U60232DL2006GOI155068

ENGINEER



DB Engineering & Consulting GmbH
Deutsche Bahn Engineering & Consulting GmbH

CONTRACTOR

GIL - TPL JV



SUBMITTED BY	GIL - TPL JV
--------------	--------------

	DATED	NAME	SIGNATURE
PREPARED BY			
CHECKED BY	26.09.2024	VIJAY PRATAP	
APPROVED BY	26.09.2024	PARASURAM KOTYADA	

APPROVED BY	DEUTSCHE BAHN ENGINEERING & CONSULTING GMBH
-------------	---

	DATED	NAME	SIGNATURE
Sr. DE./CHIEF ENGINEER		SURESH K.YALANGI	
CHIEF TRACK ENGINEER		RAJ PAL SINGH	
T.L.		H.D. VIDJAK	

[illegible]

STAMP	AS-BUILT DRAWING
	TR Ref

ENGINEER Sign.: _____

EMPL DATE (YYYYMM)	

EMILY (BY SUE)	DEDICATED FREIGHT CORRIDOR CORPORATION OF INDIA ET		

--	--	--	--

--	--	--	--

--	--	--	--

--	--	--	--

AS BUILT DRAWING



TITLE	DFCC APPR. NO. -
-------	------------------

AS-BUILT PLAN AND PROFILE	ENGG. APPR. NO. -
REQ KM 1200 005 TO 1210 005	DRG NO. - 301.2/A/1/A/1264

SHEET NO. : 1 OF 1	STATUS
--------------------	--------

	DATE : 26.09.2024	A
--	-------------------	---



TR	
----	--

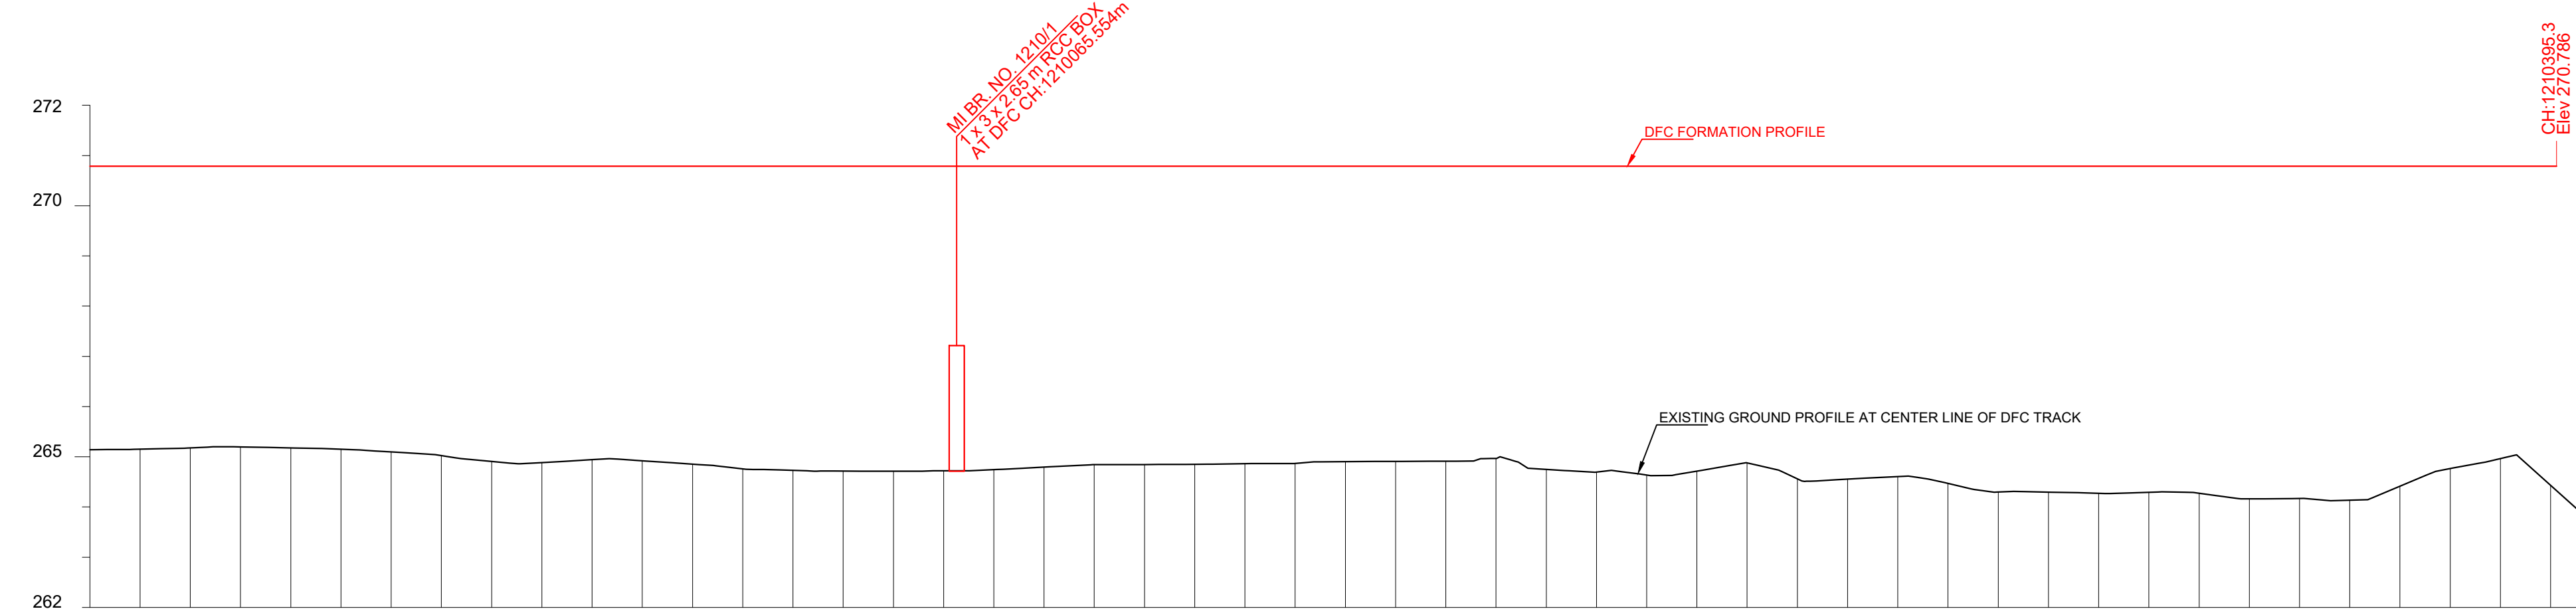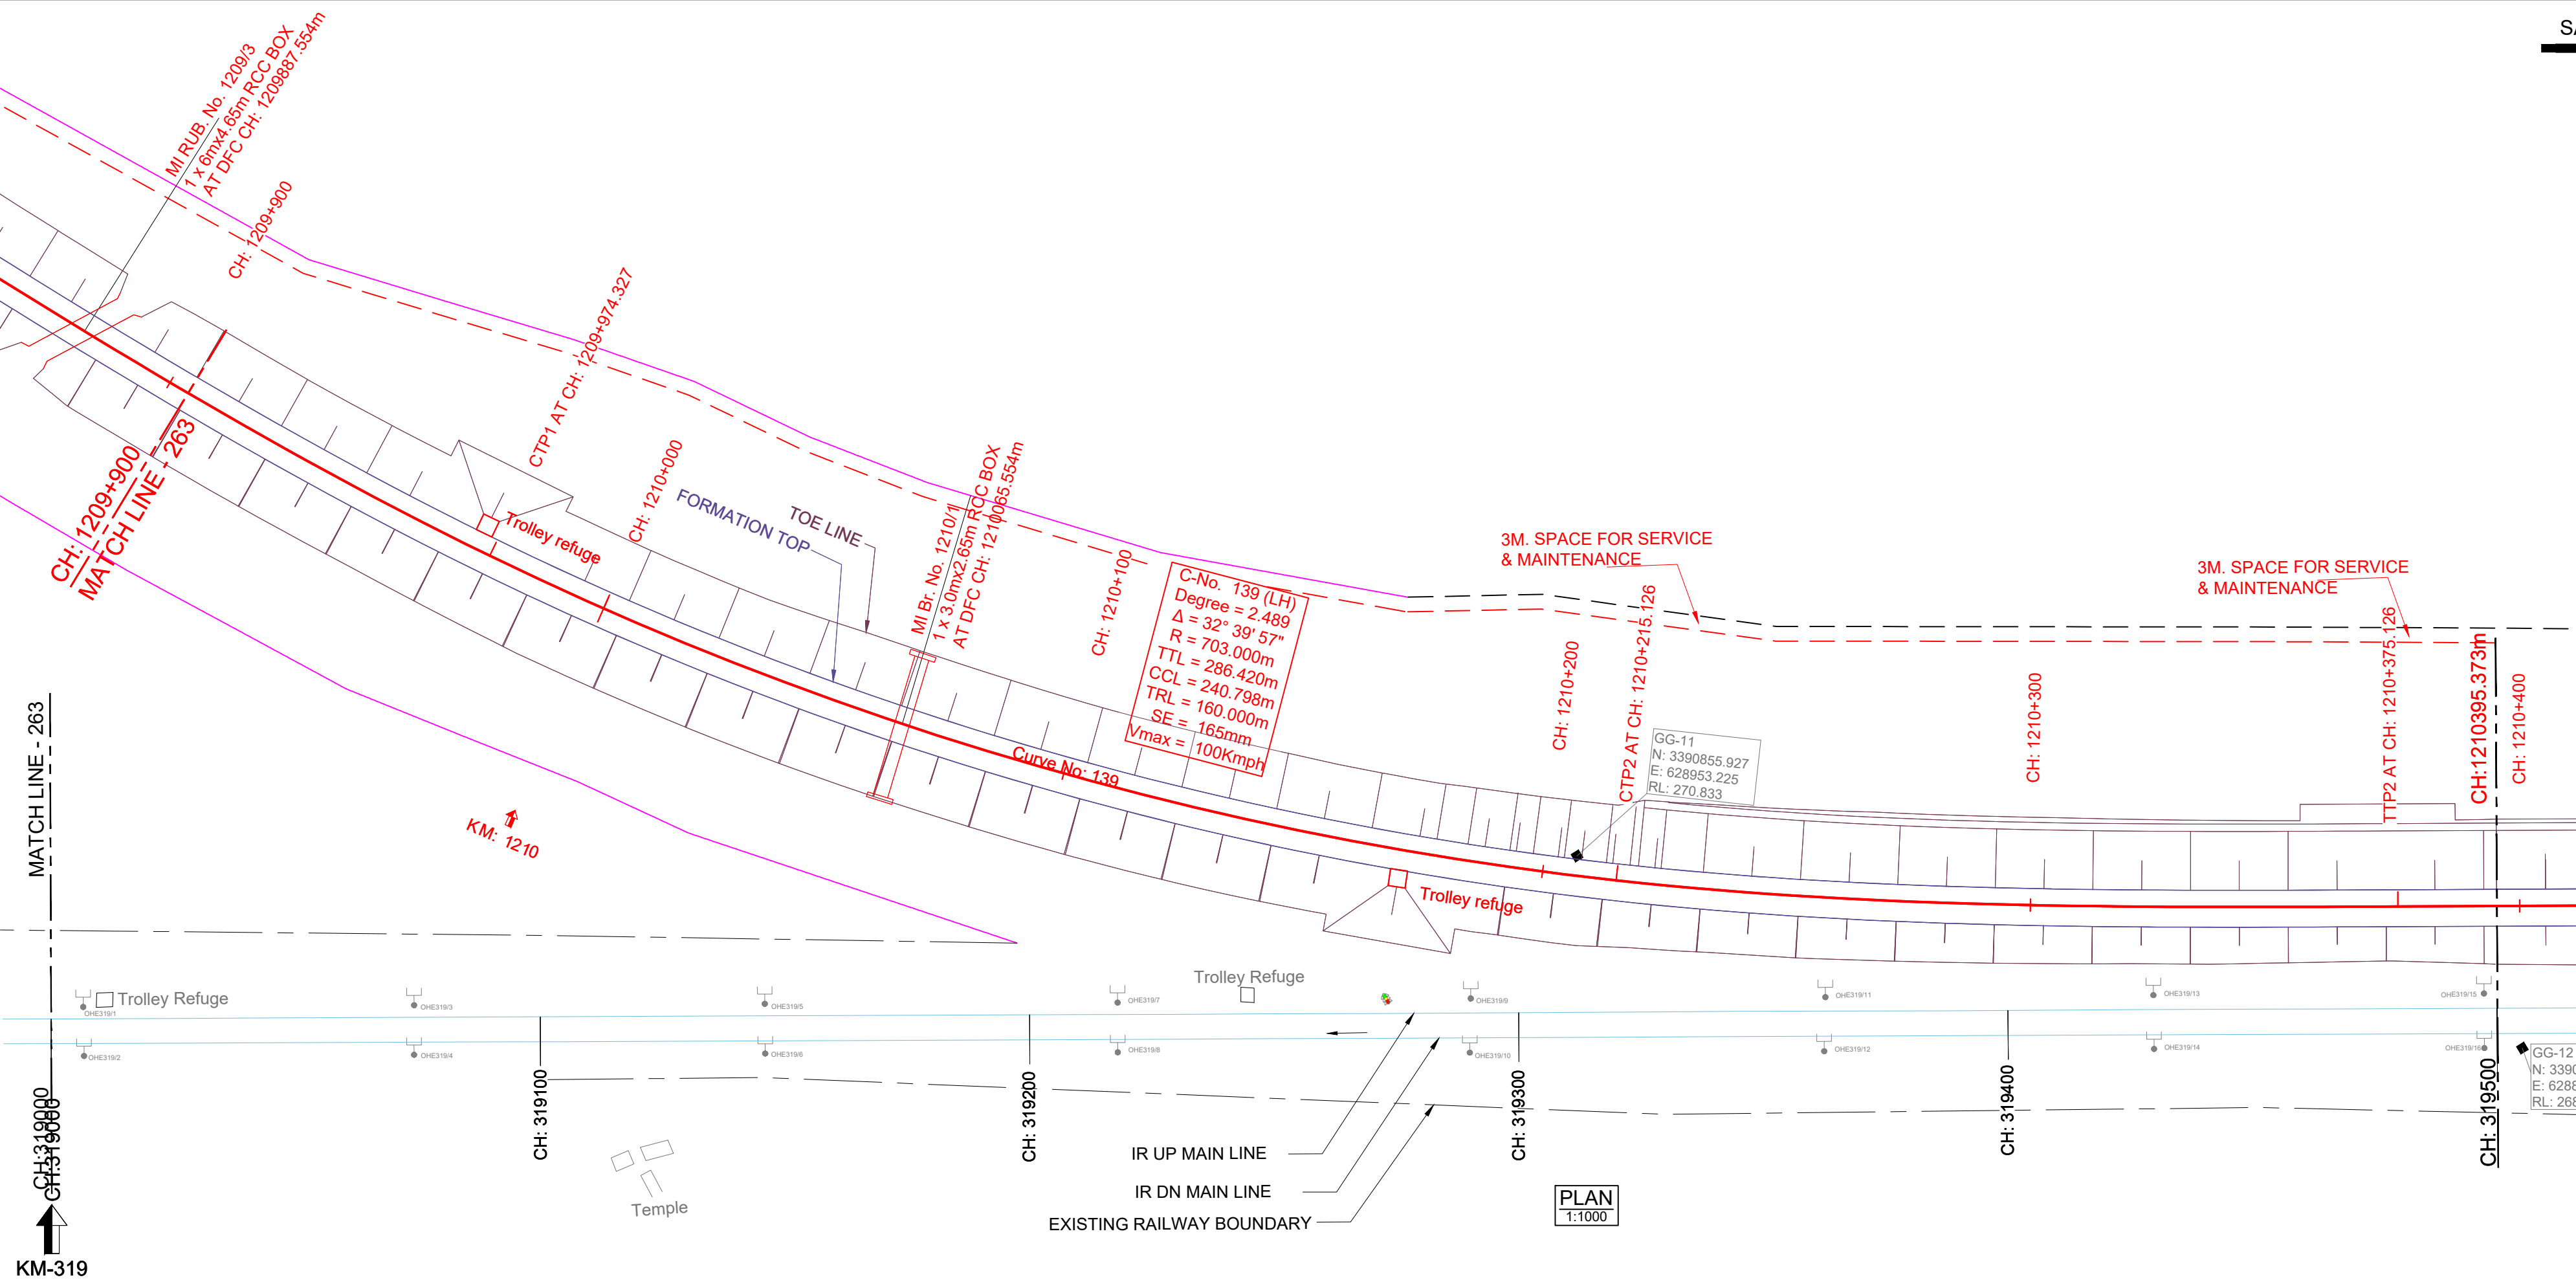

DATUM ABOVE MSL : 262 m

HORIZONTAL ALIGNMENT	TL = 160m R = 703m TL = 160m L = 524.646m																																																																																																																																																
VERTICAL ALIGNMENT	L=1254.449 m LEVEL																																																																																																																																																
TRACK DISTANCE FROM DFC MAIN LINE TO EXISTING NEAREST IR UP MAIN LINE																																																																																																																																																	
HEIGHT OF BANKING(+) / DEPTH OF CUTTING(-) (PFL-GL)	+5.646		+5.609	+5.609	+5.609	+5.689	+5.878	+5.843	+5.932	+6.057	+6.073	+6.042	+5.943	+5.936	47.534	+5.917	42.221	+5.877	37.561	+5.818	33.578	+6.081	30.184	+6.072	27.410	+6.226	25.220	+6.179	23.617	+6.489	22.508	+6.512	21.732	+6.513	21.206	+6.617	20.944	+6.372	20.866	+5.823	20.859	+7.005	20.871																																																																																																						
EXG GROUND LEVEL AT CENTER LINE OF DFC TRACK (GL)	265.140	265.177	265.177	265.177	265.097	264.908	264.943	264.854	264.729	264.713	264.744	264.843	264.850	264.869	264.909	264.968	264.705	264.714	264.560	264.607	264.297	264.274	264.273	264.169	264.414	264.963	263.781																																																																																																																						
DFC FORMATION LEVEL (PFL)	270.786	270.786	DFC RAIL LEVEL (PRL)	271.499	271.499	DFC TRACK CHAINAGE	1209904.6	1209924.6	1209944.6	1209964.6	1209984.6	1210004.6	1210024.6	1210044.6	1210064.6	1210084.6	1210104.6	1210124.6	1210144.6	1210164.6	1210184.6	1210204.6	1210224.6	1210244.6	1210264.6	1210284.6	1210304.6	1210324.6	1210344.6	1210364.6	1210384.6	1210395.3	1210404.6	1210414.6	1210424.6	1211584.6
EQUIVALENT CHAINAGE ON EXISTING IR TRACK	319207.3	319209.3	319250.9	319272.3	319293.5	319314.4	319335.3	319355.9	319376.4	319396.8	319417.0	319437.2	319457.4	319477.4	319500.0																																																																																																																																		

L - SECTION

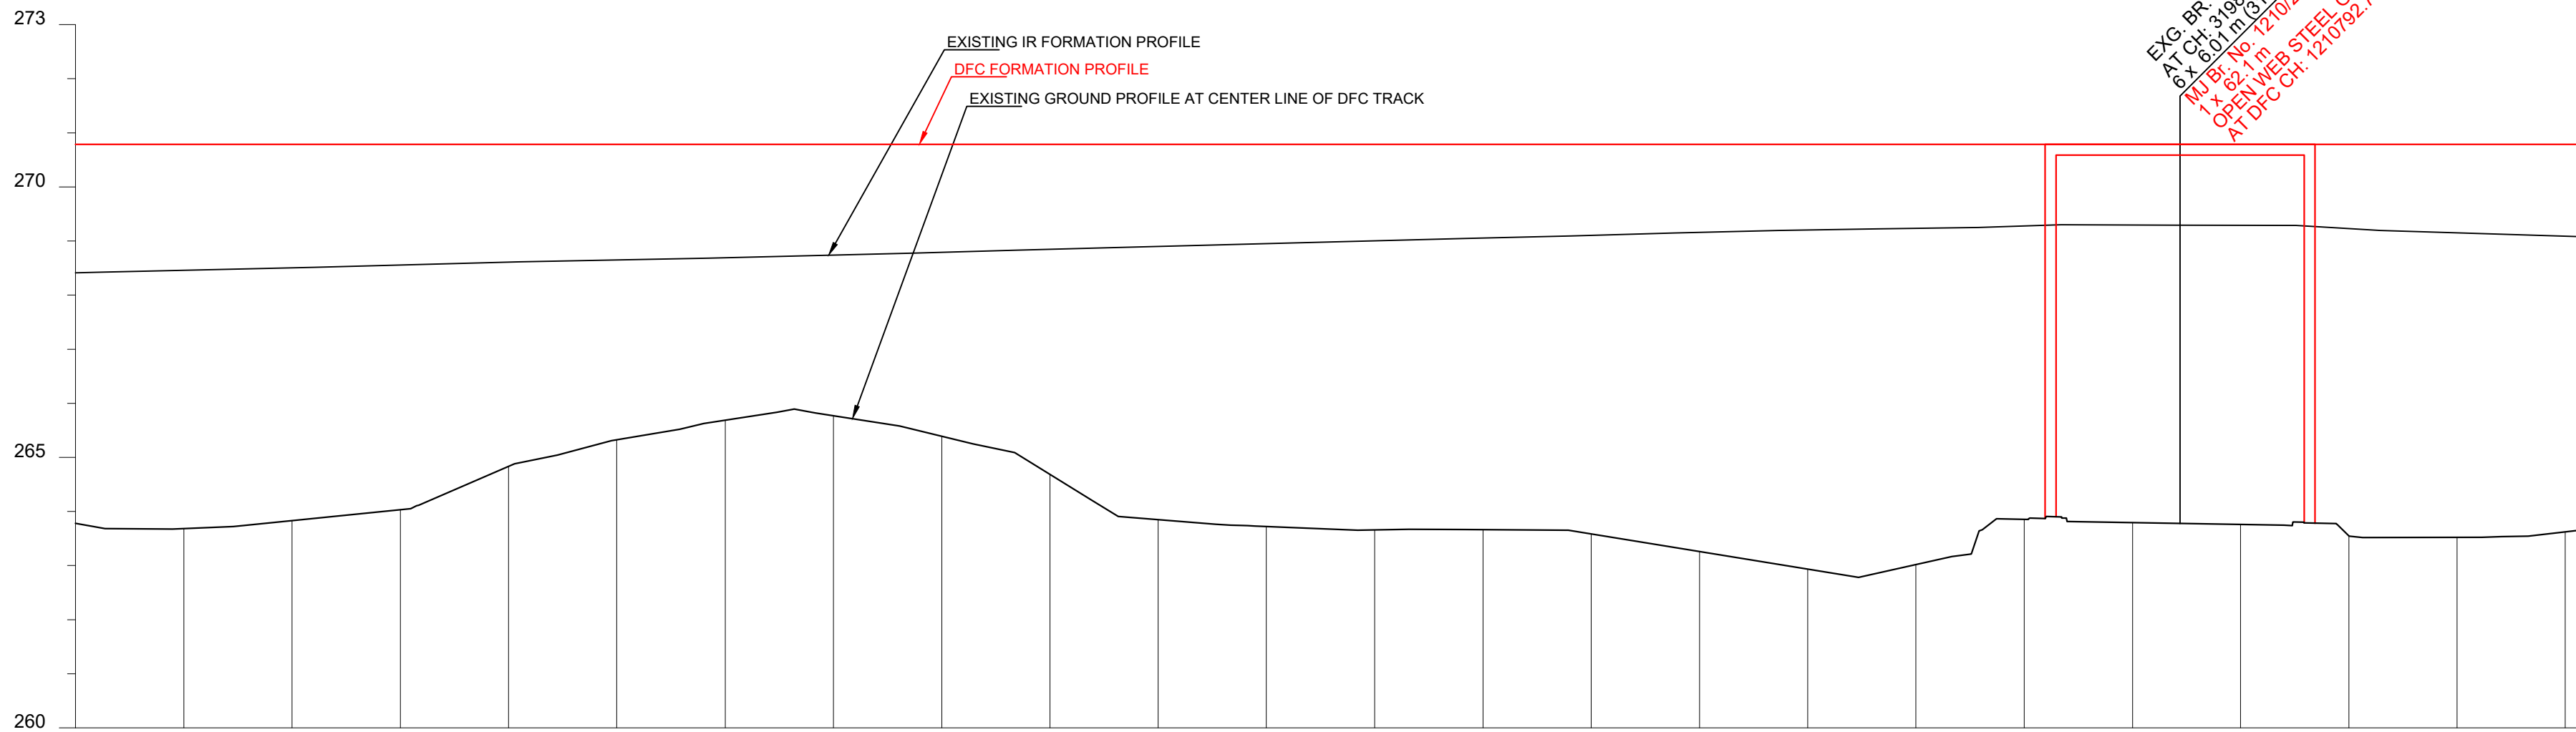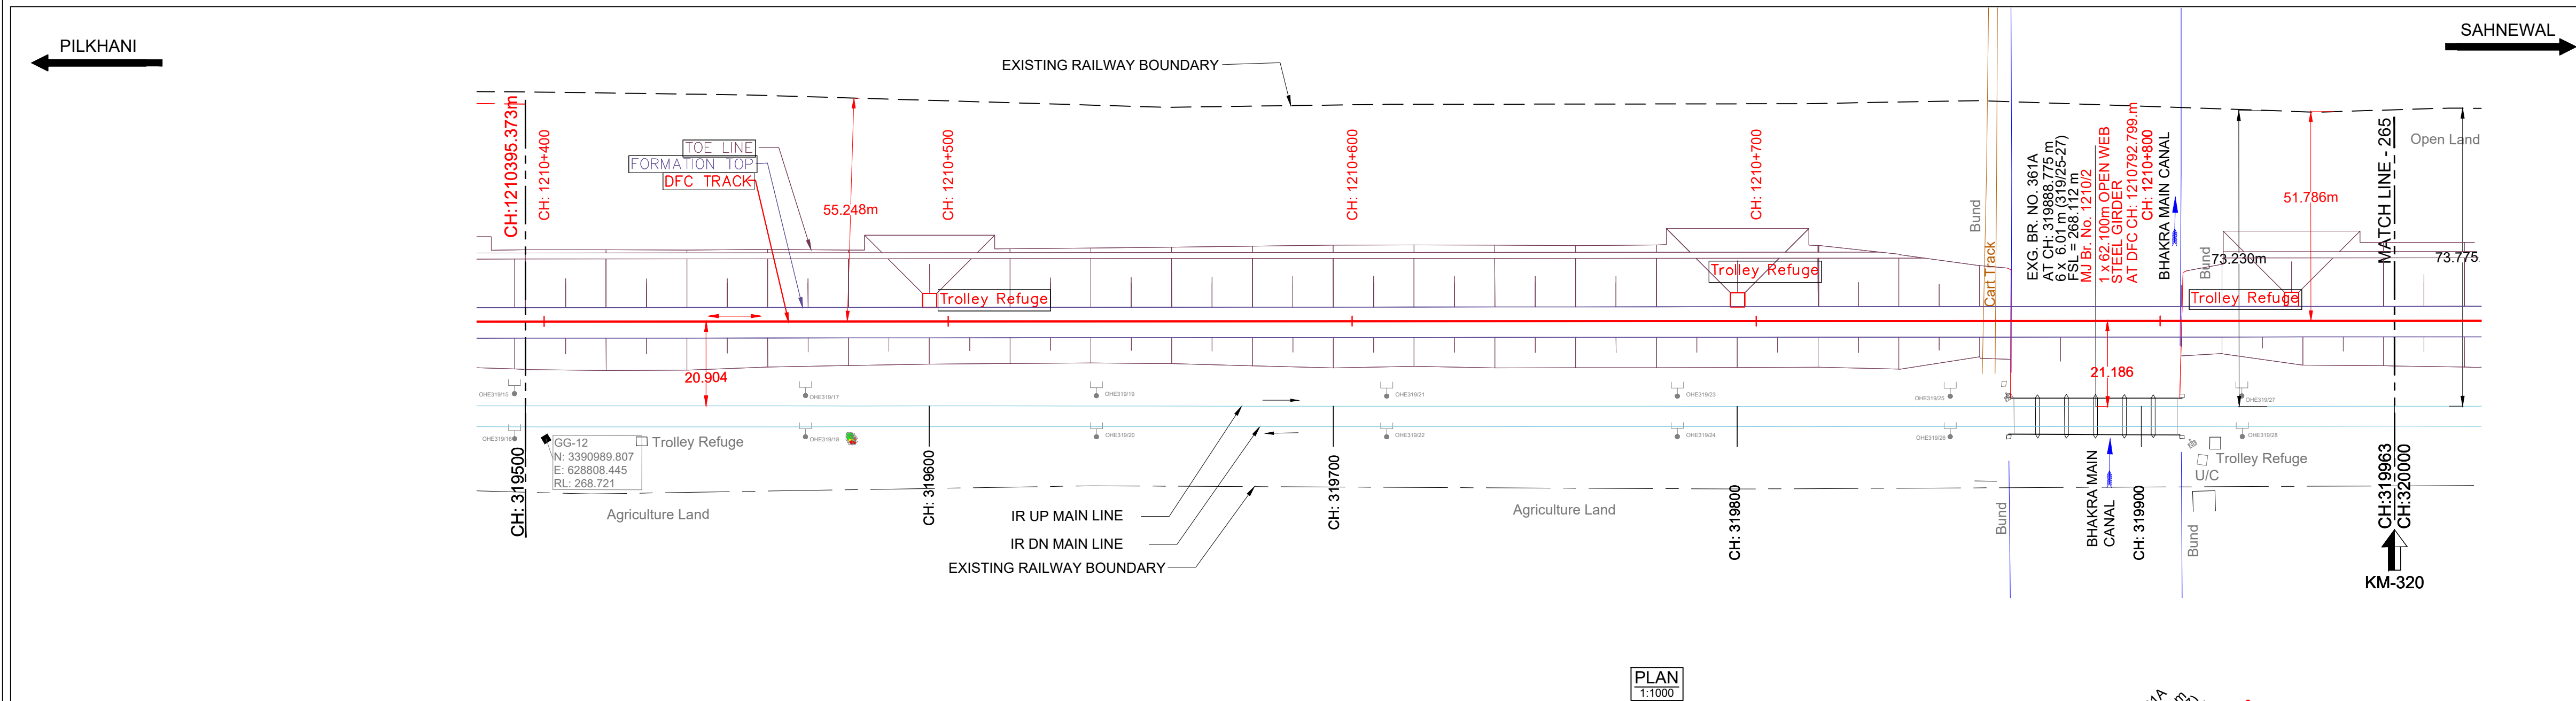


DATUM ABOVE MSL : 260 m

HORIZONTAL ALIGNMENT	L = 524.646m																						
VERTICAL ALIGNMENT	L=1254.449 m LEVEL																						
TRACK DISTANCE FROM EXISTING NEAREST IR UP MAIN LINE TO DFC MAIN LINE	-20.871	-20.871	-20.884	-20.900	-20.917	-20.933	-20.935	-20.960	-20.986	-21.017	-21.038	-21.040	-21.044	-21.060	-21.077	-21.105	-21.129	-21.139	-21.145	-21.166	-21.156	-21.145	-21.133
HEIGHT OF BANKING(+)/ DEPTH OF CUTTING(-) (PFL-GL)	+7.005	+7.005	+7.103	+6.954	+6.753	+5.954	+5.100	+5.017	+5.395	+6.099	+6.938	+7.063	+7.128	+7.123	+7.200	+7.525	+7.850	+7.766	+6.932	+7.239	+7.265	+7.193	+7.183
EXG GROUND LEVEL AT CENTER LINE OF DFC TRACK (GL)	263.781	263.781	263.683	263.832	264.033	264.832	265.686	265.769	265.391	264.687	263.848	263.723	263.658	263.663	263.586	263.261	262.936	263.020	263.854	263.794	263.759	263.547	263.521
EXG GROUND LEVEL AT TOE LOCATION OF DFC TRACK	264.255	264.255	264.270	264.311	264.236	264.338	264.178	264.085	264.001	263.874	263.748	263.738	263.763	263.846	263.756	263.490	263.829	264.659	265.595	265.411	265.372	265.455	263.468
DIFFERENCE BETWEEN DFC FORMATION LEVEL AND EXG.FORMATION LEVEL (PFL-EFL)	2.374	2.374	2.327	2.283	2.232	2.178	2.098	2.047	1.995	1.940	1.886	1.834	1.782	1.733	1.684	1.628	1.584	1.551	1.509	1.491	1.496	1.556	1.635
DFC FORMATION LEVEL (PFL)	270.786	270.786	EXG. FORMATION LEVEL OF EXG IR UP MAIN LINE (EFL)	268.412	268.412	268.459	268.503	268.554	268.608	268.688	268.739	268.791	268.846	268.900	268.952	269.004	269.053	269.102	269.158	269.202	269.235	269.277	269.295	269.290	269.230	269.151
DIFFERENCE BETWEEN DFC RAIL LEVEL AND EXG. RAIL LEVEL (PRL - ERL)	2.415	2.415	2.368	2.324	2.273	2.219	2.139	2.088	2.036	1.981	1.927	1.875	1.823	1.774	1.725	1.669	1.625	1.592	1.550	1.532	1.537	1.597	1.676
DFC RAIL LEVEL (PRL)	271.499	271.499	EXG.RAIL LEVEL OF NEAREST IR UP MAIN LINE(ERL)	269.084	269.084	269.131	269.175	269.226	269.280	269.360	269.411	269.463	269.518	269.572	269.624	269.676	269.725	269.774	269.830	269.874	269.907	269.949	269.967	269.962	269.902	269.823
EQUIVALENT CHAINAGE ON DFC TRACK	1210395.3	1210395.3	1210415.3	1210435.3	1210455.3	1210475.3	1210495.3	1210515.3	1210535.3	1210555.3	1210575.3	1210595.3	1210615.3	1210635.3	1210655.3	1210675.3	1210695.3	1210715.3	1210735.3	1210755.3	1210775.3	1210795.3	1210815.3
EXISTING IR CHAINAGE	319500.0	319500.0	319520.0	319540.0	319560.0	319580.0	319600.0	319620.0	319640.0	319660.0	319680.0	319700.0	319720.0	319740.0	319760.0	319780.0	319800.0	319820.0	319840.0	319860.0	319880.0	319900.0	319940.0

L - SECTION

SAHNEWAL

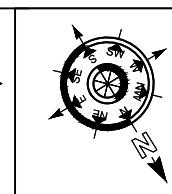

NOTE:-

1. DFC WORKS ARE SHOWN IN RED.
2. IR NEW WORKS ARE SHOWN IN VIOLET.
3. ALL DIMENSIONS ARE SHOWN IN METRES.
4. THIS DRAWING IS PREPARED BASED ON LATEST SURVEY DATA HELD ON APRIL-2022. GTS BENCH MARK OF 261.850M CONSIDERED ON TOP OF CANAL BRIDGE ABUTMENT AT DORANA VILLAGE ALONG THE NH1.
5. DFC NEW CHAINAGE OF 1075.950M IS WITH REFERENCE TO THE IR KM OF 187.500KM END OF KM OF CP-303(SECTION P-3 PILKHANI END) AGAINST THE EXISTING DFC CHAINAGE. 116277.742M ISSUED VIDE LETTER NO. COM/DFCC/UM/SURVEY/2021-301-230116-011173 DT. 17.01.2023.
6. BALLAST PROFILE HAS BEEN PROVIDED ACCORDING TO THE CLAUSE 1.11.3 OF STANDARD SCHEDULE OF DIMENSION(EASTERN CORRIDOR) & THE BALLAST CUSHION DIMENSION SHOWN IN 35CM ON GE-14 PARA 17. SPECIFICATIONS & RECOMMENDATIONS 2. TWO LAYER SYSTEM FIG.10.

REFERENCE DRAWINGS :-

1. FOR KEY PLAN REFER DRAWING NO. 301-2/AL/0001
2. FOR LEGEND AND ABBREVIATIONS REFER DRAWING NO. 301-2/AL/1000
3. FOR TYPICAL SECTION OF BALLAST PROFILE (FL-RL) REFER DRG. NO. 301-2/TK/TFD/004 (TR.1952)

0	26.09.2024	SUBMISSION OF AS-BUILT DRAWING	FOR APPROVAL
REV.	DATE	REVISION DETAILS	PURPOSE OF ISSUE

LEGEND:


SCALE

HOR - 1:1000

VER - 1:100

SHEET SIZE : A1

IR TRACK
DFCC TRACK
DFCC FUTURE PROPOSALS
STRUCTURE / BUILDING
DFCC TOE LINE
DFCC FORMATION
RETAINING WALL
ROAD
STREAM, DRAIN, NALA, CANAL.
FENCE
POWER LINES
TBM
ELECTRIC POLE/OHE MAST
IR RAILWAY BOUNDARY
DFCC BOUNDARY

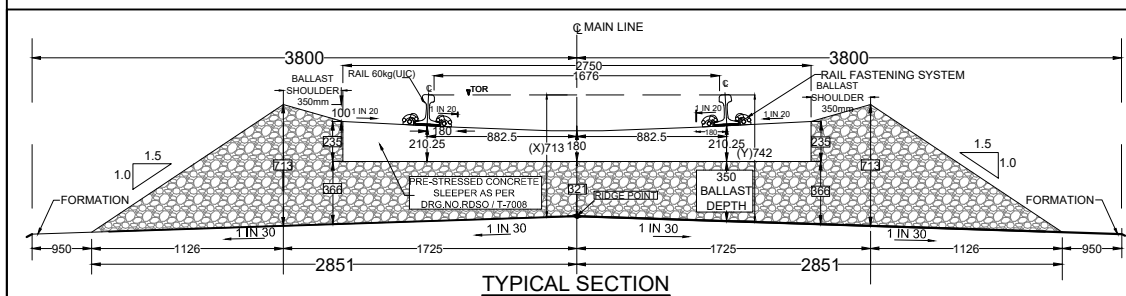

TRACK STRUCTURE		
RAIL SECTION: 60Kg/m (UIC 60Kg/m) DFC LINE: 60Kg/m (UIC 60Kg/m) IR MAIN LINE: 52Kg/m	Difference between FL- RL (Below Rail Seat)	
	IR Line	DFC
RUBBER PAD	172mm	172mm
SLEEPER DEPTH	210mm	210mm
BALLAST CUSHION	300mm	350mm
Total Depth (FL TO RL)	688mm	742mm

OWNER

DEDICATED FREIGHT CORRIDOR CORPORATION OF INDIA LTD.

(A GOVERNMENT OF INDIA ENTERPRISE)

PROJECT OFFICE/AMBALA UNIT: OLD RAILWAY COLONY (NEAR ANAND MARKET),AMBALA CANTT-133001.

CORPORATE IDENTITY NO. : U60232DL2006GGI155068

ENGINEER:

DB Engineering & Consulting GmbH

Deutsche Bahn Engineering & Consulting GmbH

CONTRACTOR:

GIL - TPL JV

GAR TATA


SUBMITTED BY	GIL - TPL JV		
	DATED	NAME	SIGNATURE
PREPARED BY			
CHECKED BY	26.09.2024	VIJAY PRATAP	
APPROVED BY	26.09.2024	PARASURAM KOTYADA	

APPROVED BY	DEUTSCHE BAHN ENGINEERING & CONSULTING GMBH		
	DATED	NAME	SIGNATURE
Sr. DE./CHIEF ENGINEER		SURESH K.YALANGI	
CHIEF TRACK ENGINEER		RAJ PAL SINGH	
T.L.		H.D. VIDJAK	

STAMP	A AS-BUILT DRAWING TR. Ref.:..... ENGINEER Sign.:		
EMPLOYER (DFCCIL):	DEDICATED FREIGHT CORRIDOR CORPORATION OF INDIA LTD.		

AS BUILT DRAWING			
TITLE	AS-BUILT PLAN AND PROFILE	DFCC APPR. NO. -	
	FROM IR KM: 319.500 TO 320.000	ENGG. APPR. NO. -	
	DFC KM:1210.395 TO 1210.858	DRG. NO. - 301-2/AL/A/1265	
		SHEET NO. : 1 OF 1	STATUS
		DATE : 26.09.2024	A

TR.

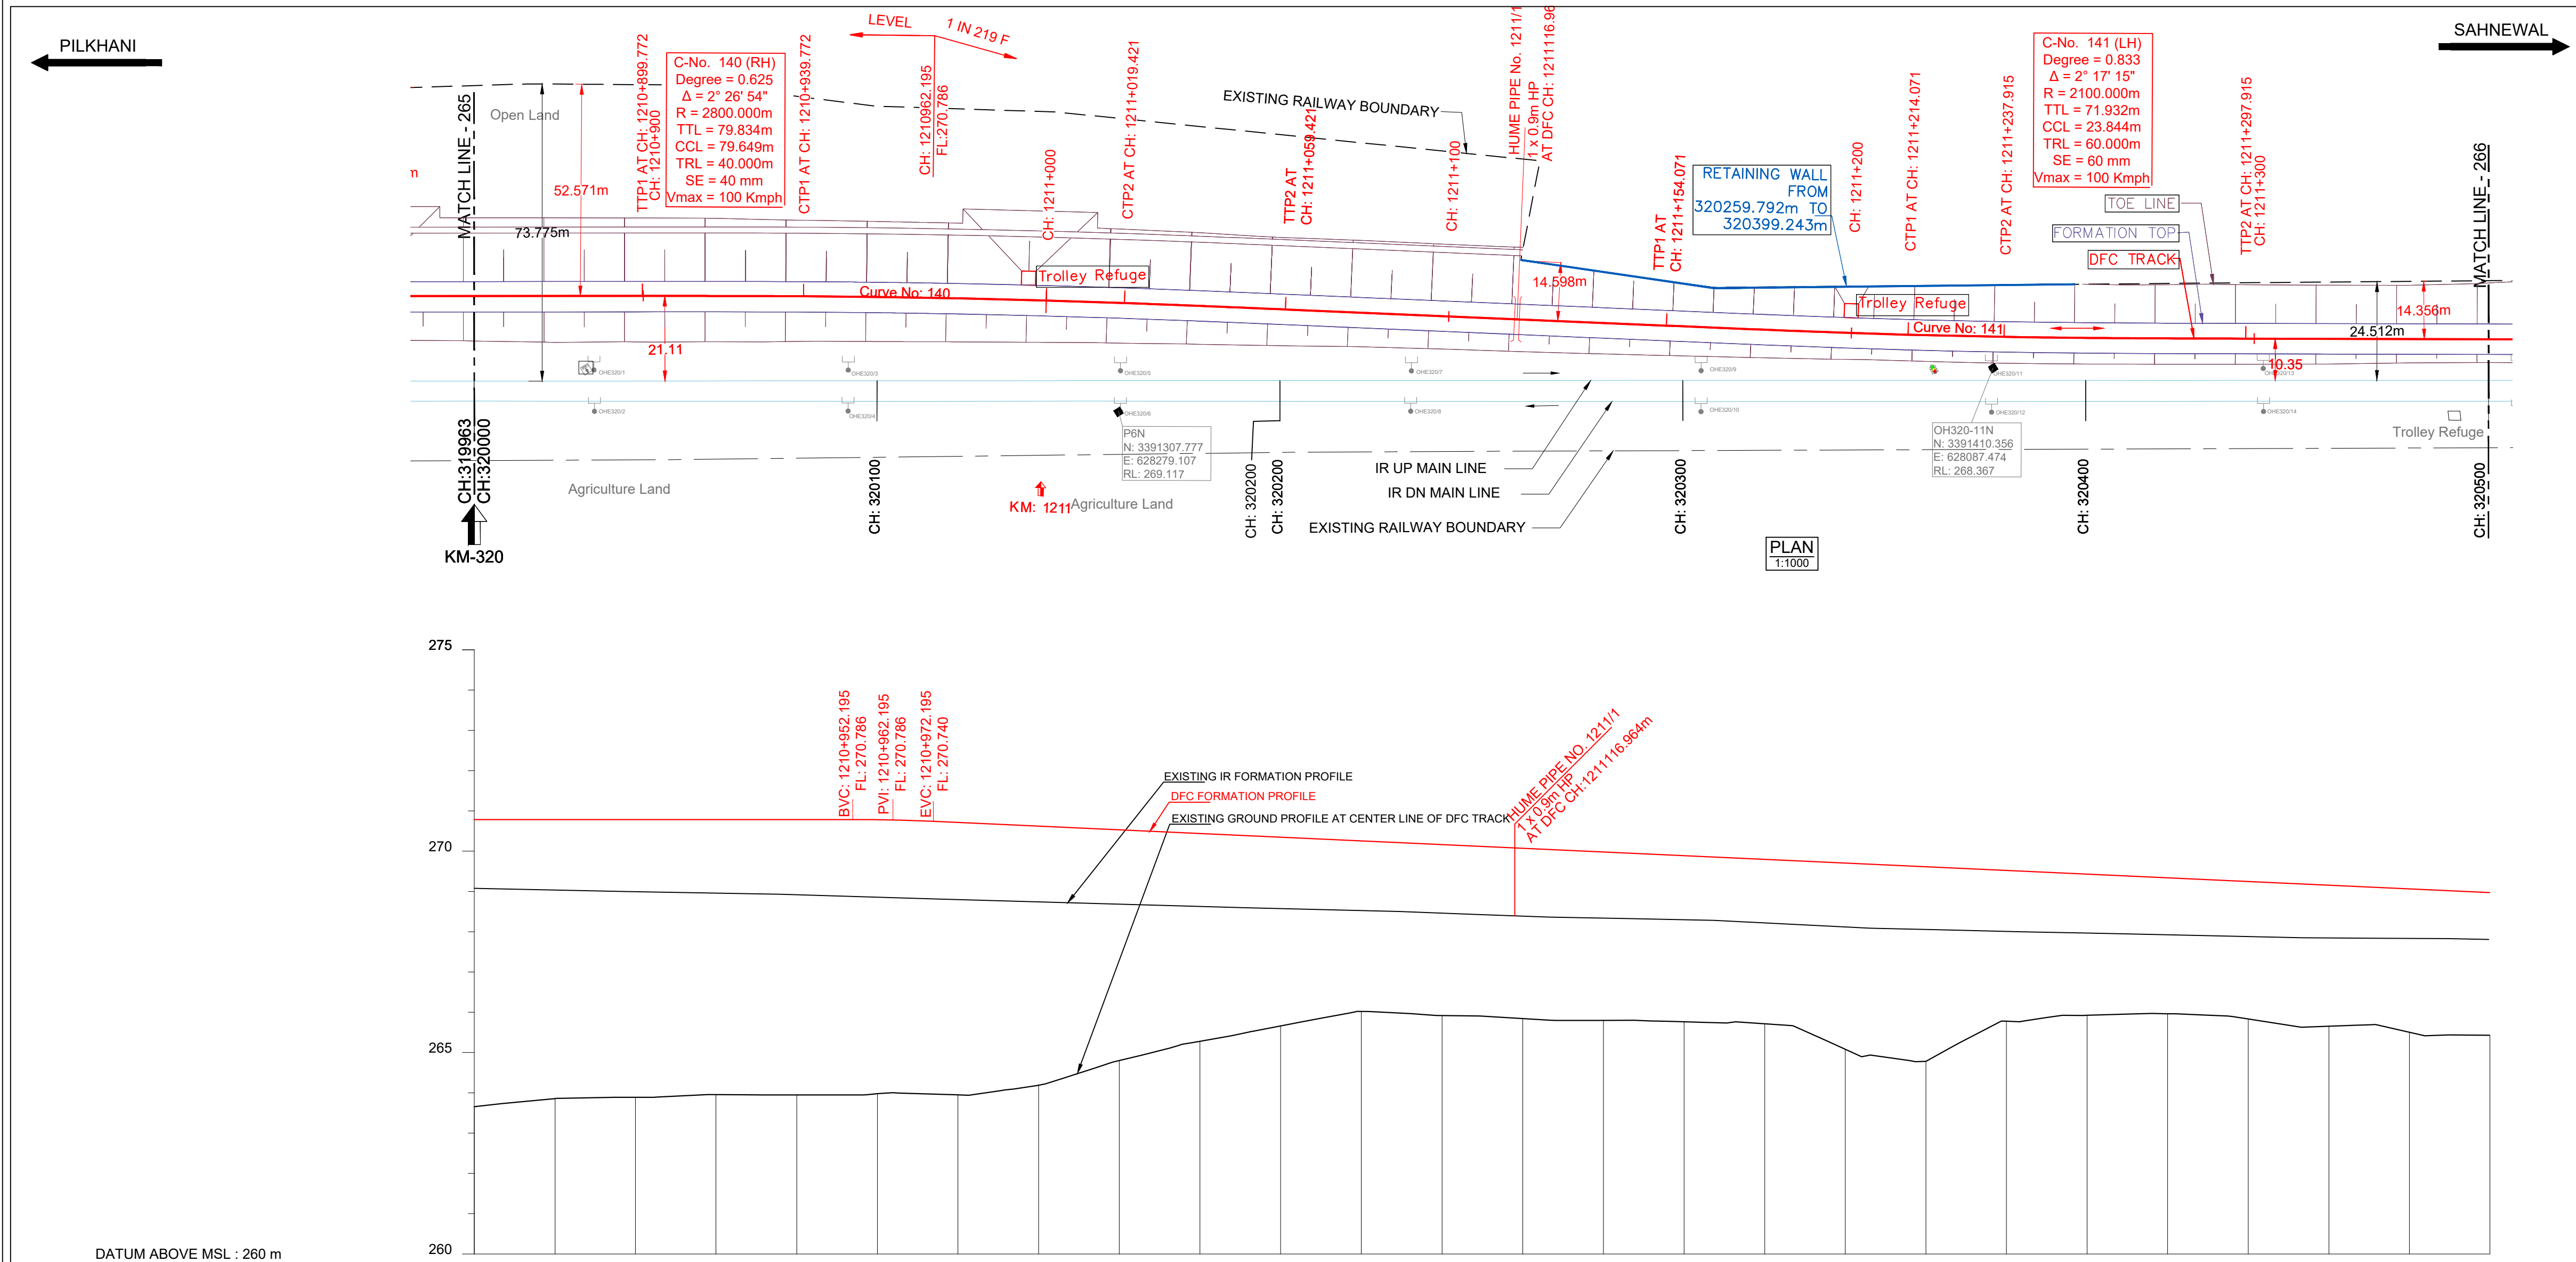

DATUM ABOVE MSL : 260 m

HORIZONTAL ALIGNMENT	L = 524.646m TL= 40m R =2800m TL= 40m L = 94.650m TL= 60m R =2100m TL= 60m L = 170.347m																										
VERTICAL ALIGNMENT	L=1254.449 m LEVEL L=20.0 m R=4372 m L=465.900 m 1 IN 218.578 F																										
TRACK DISTANCE FROM EXISTING NEAREST IR UP MAIN LINE TO DFC MAIN LINE	21.120	21.125	21.127	21.073	20.965	20.782	20.444	19.936	19.297	18.547	17.711	16.846	15.992	15.147	14.287	13.422	12.587	11.841	11.236	10.569	10.463	10.377	10.314	10.280	10.242		
HEIGHT OF BANKING(+) / DEPTH OF CUTTING(-) (PFL-GL)	+7.131	+6.929	+6.897	+6.832	+6.837	+6.804	+6.764	+6.433	+5.730	+5.160	+4.687	+4.234	+4.245	+4.228	+4.181	+4.124	+4.081	+3.744	+3.507	+3.376	+3.413	+3.503	+3.560	+3.545			
EXG GROUND LEVEL AT CENTER LINE OF DFC TRACK (GL)	263.655	263.857	263.889	263.954	263.949	263.978	263.948	264.188	264.799	265.278	265.660	266.021	265.918	265.844	265.800	265.765	265.716	265.686	265.785	265.925	265.964	265.964	265.654	265.506	265.429		
EXG GROUND LEVEL AT TOE LOCATION OF DFC TRACK	263.513	263.517	263.540	263.596	263.796	263.870	263.853	263.948	263.881	263.887	263.970	263.922	263.765	263.638	263.539	263.405	263.230	263.030	262.831	262.559	262.465	262.342	262.181	261.983	261.764		
DIFFERENCE BETWEEN DFC FORMATION LEVEL AND EXG.FORMATION LEVEL.(PFL-EFL)	1.706	1.750	1.792	1.828	1.868	1.928	1.913	1.879	1.844	1.810	1.773	1.731	1.700	1.682	1.643	1.591	1.576	1.587	1.558	1.464	1.416	1.369	1.312	1.232	1.164		
DFC FORMATION LEVEL (PFL)	270.786	270.786	270.786	270.786	270.786	270.786	270.712	270.621	270.529	270.438	270.347	270.255	270.163	270.072	269.981	269.889	269.797	269.706	269.614	269.523	269.432	269.340	269.249	269.157	269.066		
EXG. FORMATION LEVEL OF EXG IR UP MAIN LINE (EFL)	269.080	269.036	268.994	268.958	268.918	268.858	268.799	268.742	268.685	268.628	268.574	268.524	268.463	268.390	268.338	268.286	268.221	268.119	268.056	268.008	267.968	267.924	267.880	267.845	267.810		
DIFFERENCE BETWEEN DFC RAIL LEVEL AND EXG. RAIL LEVEL (PRL - ERL)	1.747	1.791	1.833	1.869	1.909	1.969	1.954	1.918	1.883	1.849	1.811	1.769	1.740	1.721	1.681	1.630	1.616	1.627	1.598	1.558	1.505	1.457	1.412	1.353	1.273		
DFC RAIL LEVEL (PRL)	271.499	271.499	271.499	271.499	271.499	271.499	271.425	271.333	271.241	271.149	271.057	270.966	270.874	270.783	270.692	270.600	270.509	270.418	270.327	270.238	270.145	270.053	269.963	269.870	269.688		
EXG.RAIL LEVEL OF NEAREST IR UP MAIN LINE(ERL)	269.752	269.708	269.666	269.630	269.590	269.530	269.471	269.414	269.357	269.300	269.246	269.196	269.135	269.062	269.010	268.970	268.893	268.791	268.728	268.680	268.640	268.596	268.552	268.517	268.506		
EQUIVALENT CHAINAGE ON DFC TRACK	1210857.7	1210878.0	1210898.0	1210918.0	1210938.1	1210958.2	1210978.4	1210998.5	1211018.7	1211038.7	1211058.8	1211078.7	1211098.7	1211118.7	1211138.7	1211158.6	1211178.6	1211198.5	1211218.4	1211237.8	1211258.2	1211278.2	1211297.8	1211318.2	1211338.2		
EXISTING IR CHAINAGE	319962.7	320000.0	320020.0	320040.0	320060.0	320080.0	320100.0	320120.0	320140.0	320160.0	320180.0	320200.0	320220.0	320240.0	320260.0	320280.0	320300.0	320320.0	320340.0	320360.0	320380.0	320400.0	320420.0	320440.0	320460.0	320480.0	320500.0

L - SECTION

SAHNEWAL

NOTE:-

- DFCC WORKS ARE SHOWN IN RED.
- IR NEW WORKS ARE SHOWN IN VIOLET.
- ALL DIMENSIONS ARE SHOWN IN METRES.
- THIS DRAWING IS PREPARED BASED ON LATEST SURVEY DATA HELD ON APRIL-2022. GTS BENCH MARK OF 261.850M CONSIDERED ON TOP OF CANAL BRIDGE ABUTMENT AT DORANA VILLAGE ALONG THE NH1.
- DFC NEW CHAINAGE OF 1075.950M IS WITH REFERENCE TO THE IR KM OF 187.500KM END OF KM OF CP-303(SECTION P-3 PILKHANI END) AGAINST THE EXISTING DFC CHAINAGE. 116277.742M ISSUED VIDE LETTER NO. COM/DFCC/UMBSURVEY/2021-301-2301/16-011173.DT. 17.01.2023
- BALLAST PROFILE HAS BEEN PROVIDED ACCORDING TO THE CLAUSE 1.11.3 OF STANDARD SCHEDULE OF DIMENSION(EASTERN CORRIDOR) & THE BALLAST CUSHION DIMENSION SHOWN IN 35CM ON GE-14 PARA 17. SPECIFICATIONS & RECOMMENDATIONS 2. TWO LAYER SYSTEM FIG.10.

REFERENCE DRAWINGS :-

- FOR KEY PLAN REFER DRAWING NO. 301-2/AL/0001
- FOR LEGEND AND ABBREVIATIONS REFER DRAWING NO. 301-2/AL/1000
- FOR TYPICAL SECTION OF BALLAST PROFILE (FL-RL) REFER DRG. NO. 301-2/TK/TFD/-004 (TR.1952)

026.09.2024SUBMISSION OF AS-BUILT DRAWINGFOR APPROVAL

REV. DATE REVISION DETAILS PURPOSE OF ISSUE

SCALE
HOR - 1:1000
VER - 1:100
SHEET SIZE : A1

LEGEND:

- IR TRACK
- DFCC TRACK
- DFCC FUTURE PROPOSALS
- STRUCTURE / BUILDING
- DFCC TOE LINE
- DFCC FORMATION
- RETAINING WALL
- ROAD
- STREAM, DRAIN, NALA, CANAL.
- FENCE
- POWER LINES
- TBM
- ELECTRIC POLE/OHE MAST
- IR RAILWAY BOUNDARY
- DFCC BOUNDARY

TYPICAL SECTION

TRACK STRUCTURE	
RAIL SECTION: 60Kg/m (UIC 60Kg/m)	Difference between FL- RL (Below Rail Seat)
DFC LINE: 60Kg/m (UIC 60Kg/m)	
IR MAIN LINE: 52Kg/m	
RUBBER PAD	IR Line 172mm DFC 172mm
SLEEPER DEPTH	6mm 10mm
BALLAST CUSHION	210mm 210mm
Total Depth (FL TO RL)	300mm 350mm
	688mm 742mm

OWNER
DEDICATED FREIGHT CORRIDOR CORPORATION OF INDIA LTD.
(A GOVERNMENT OF INDIA ENTERPRISE)
PROJECT OFFICE(AMBALA UNIT): OLD RAILWAY COLONY (NEAR ANAND MARKET),AMBALA CANTT-133001.
CORPORATE IDENTITY NO. : U60232DL2006GGI155068

ENGINEER:
DB Engineering & Consulting GmbH
Deutsche Bahn Engineering & Consulting GmbH

CONTRACTOR:
GIL - TPL JV
GAR TATA

SUBMITTED BY	GIL - TPL JV		
	DATED	NAME	SIGNATURE
PREPARED BY			
CHECKED BY	26.09.2024	VIJAY PRATAP	
APPROVED BY	26.09.2024	PARASURAM KOTYADA	
APPROVED BY	DEUTSCHE BAHN ENGINEERING & CONSULTING GMBH		
	DATED	NAME	SIGNATURE
Sr. DE./CHIEF ENGINEER		SURESH K.YALANGI	
CHIEF TRACK ENGINEER		RAJ PAL SINGH	
T.L.		H.D. VIDJAK	

STAMP
A AS-BUILT DRAWING
TR. Ref.:.....
ENGINEER Sign.:.....

EMPLOYER (DFCCIL): DEDICATED FREIGHT CORRIDOR CORPORATION OF INDIA LTD.


AS BUILT DRAWING

TITLE
AS-BUILT PLAN AND PROFILE
FROM IR KM: 320.000 TO 320.500
DFC KM:1210.858 TO 1211.358

DFCC APPR. NO. -
ENGG. APPR. NO. -
DRG. NO. -301-2/AL/A/1266
SHEET NO. : 1 OF 1
DATE : 26.09.2024

STATUS
A

TR.

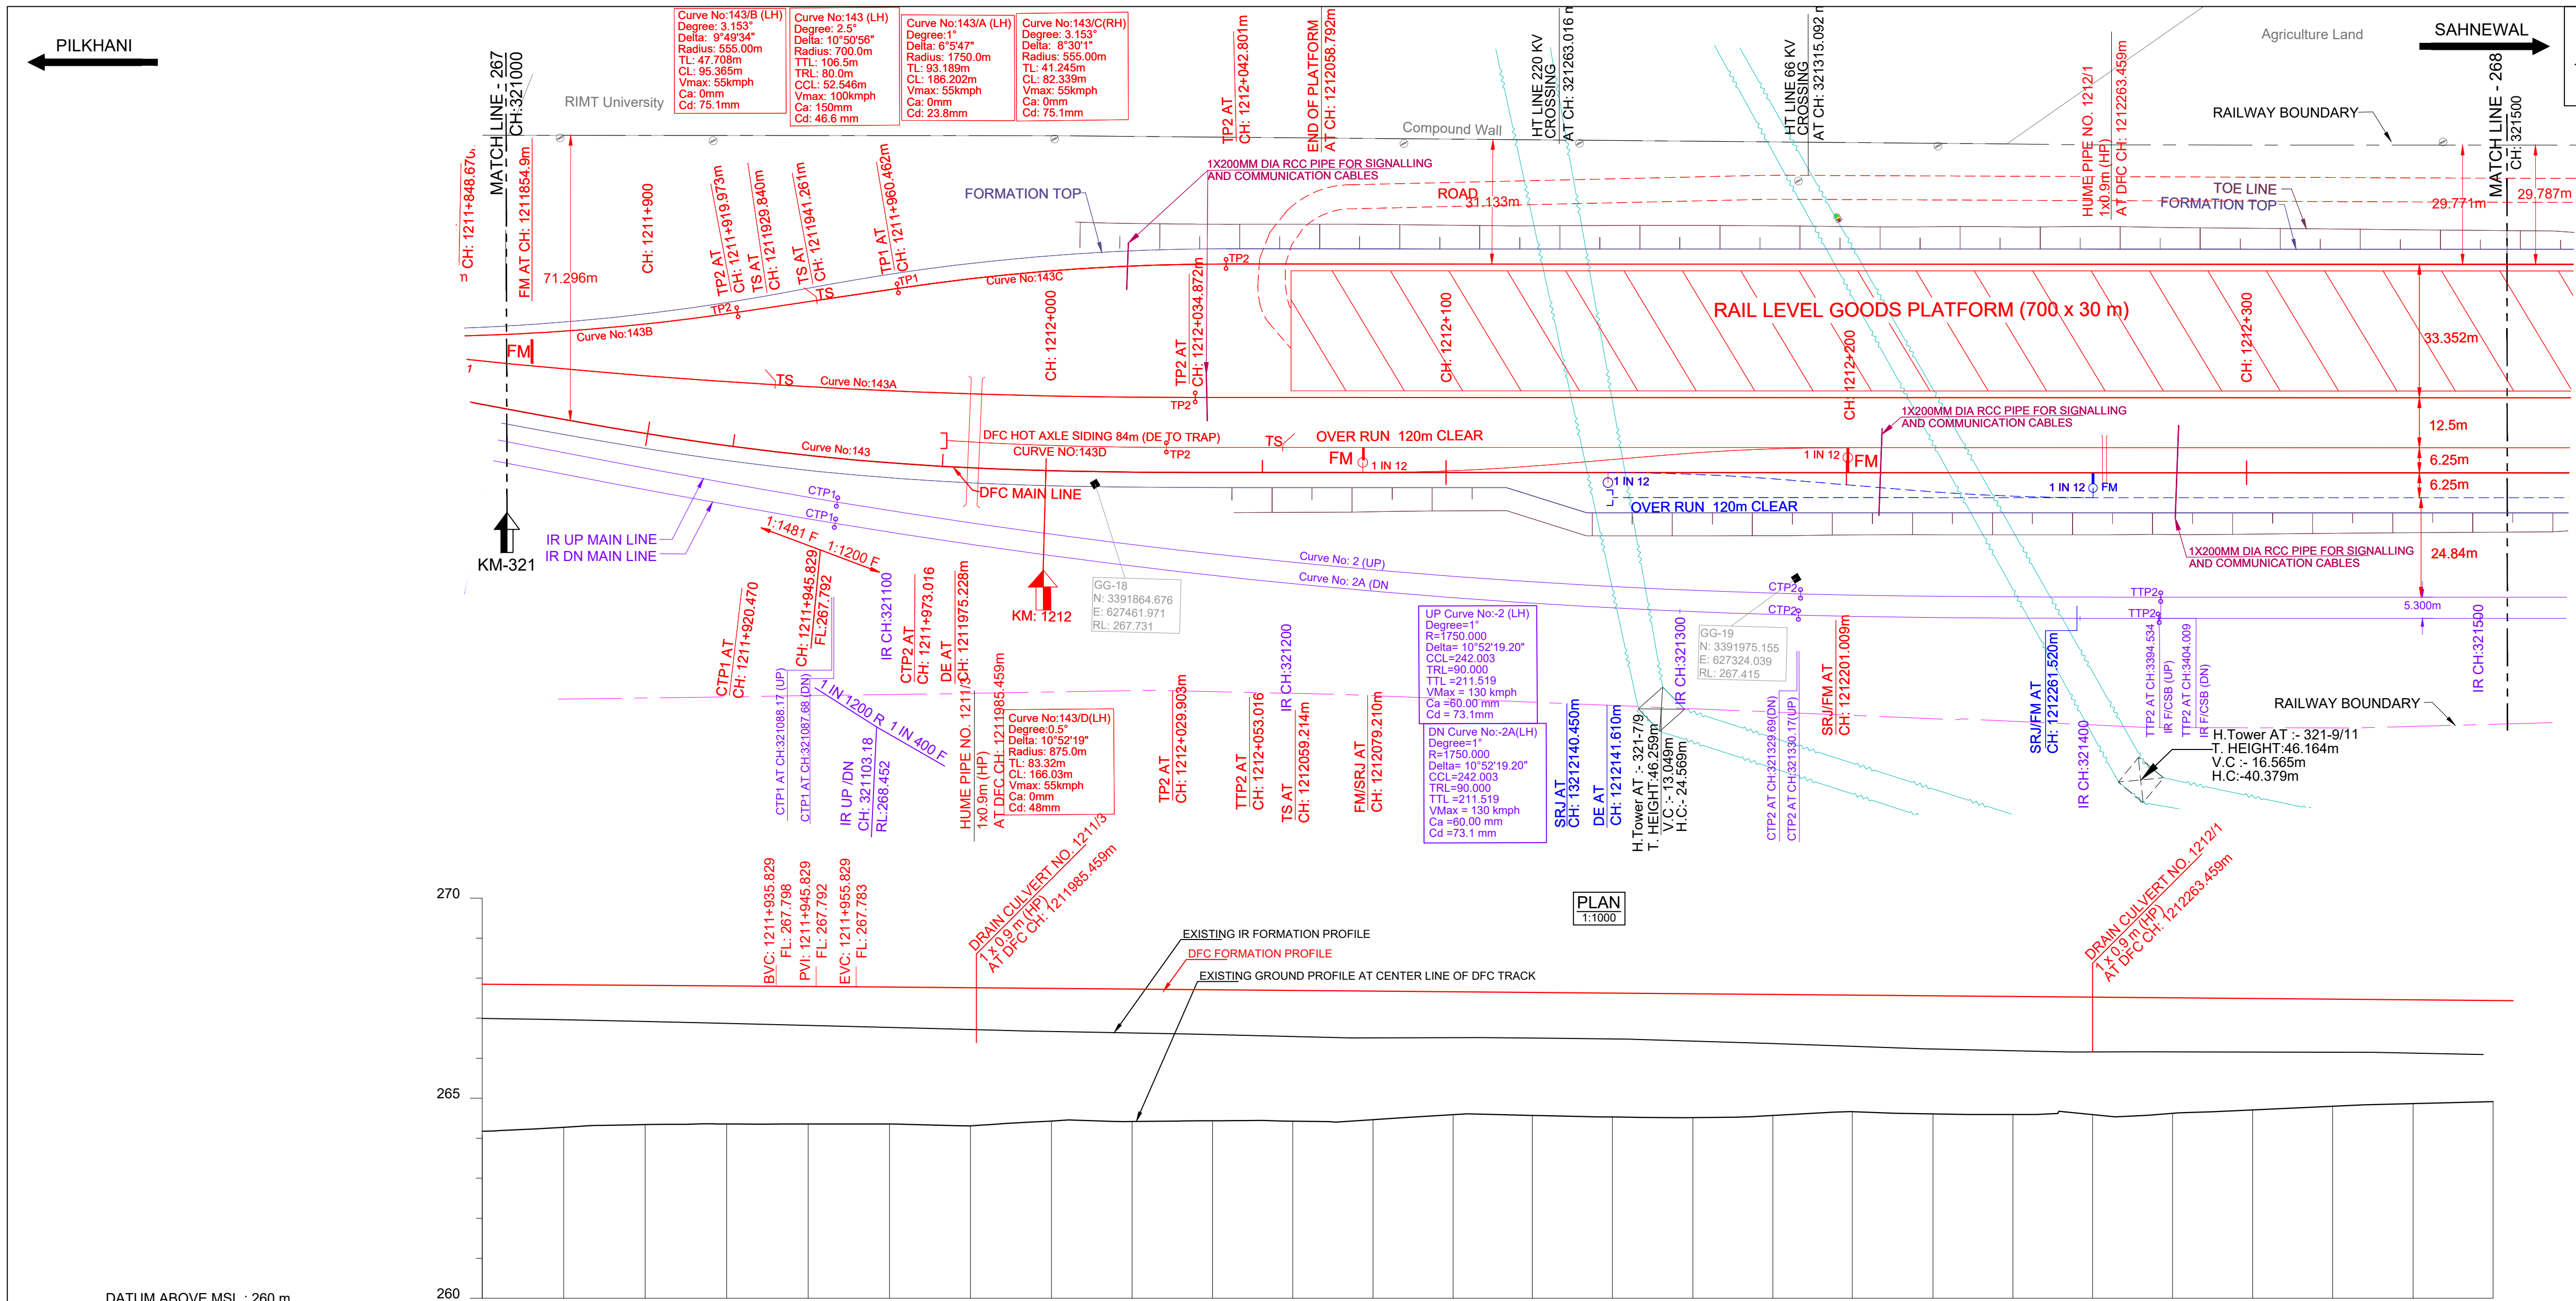

DATUM ABOVE MSL : 260 m

HORIZONTAL ALIGNMENT	TL= 80m R =-700m TL= 80m L = 2464.208m																						
VERTICAL ALIGNMENT	L=346.294 m 1 IN 1481.173 F L=20.0 m R=126428 m L=1915.351 m 1 IN 1200 F																						
TRACK DISTANCE FROM EXISTING NEAREST IR UP MAIN LINE TO DFC MAIN LINE	44.628	48.263	51.582	54.430	56.705	58.402	59.528	60.168	60.474	60.575	60.627	60.681	60.753	60.787	60.789	60.815	60.851	60.837	60.816	60.846	60.836	60.835	60.853
HEIGHT OF BANKING(+) / DEPTH OF CUTTING(-) (PFL-GL)	+3.674	+3.561	+3.460	+3.451	+3.438	+3.420	+3.451	+3.321	+3.310	+3.275	+3.268	+3.222	+3.081	+3.073	+3.095	+3.096	+3.032	+2.916	+2.951	+2.951	+2.897	+2.598	+2.532
EXG GROUND LEVEL AT CENTER LINE OF DFC TRACK (GL)	264.158	264.273	264.340	264.356	264.355	264.357	264.309	264.423	264.417	264.435	264.425	264.455	264.579	264.571	264.532	264.514	264.530	264.562	264.661	264.609	264.593	264.613	264.612
EXG GROUND LEVEL AT TOE LOCATION OF DFC TRACK	264.158	264.273	264.340	264.356	264.355	264.357	264.309	264.423	264.417	264.435	264.425	264.455	264.579	264.571	264.532	264.514	264.530	264.562	264.661	264.609	264.593	264.613	264.612
DIFFERENCE BETWEEN DFC FORMATION LEVEL AND EXG.FORMATION LEVEL(PFL-EFL)	0.855	0.872	0.902	0.934	0.971	1.005	1.038	1.072	1.092	1.114	1.147	1.172	1.148	1.114	1.144	1.175	1.220	1.273	1.327	1.354	1.372	1.354	1.351
DFC FORMATION LEVEL (PFL)	267.848	267.834	267.820	267.807	267.793	267.777	267.760	267.744	267.727	267.710	267.693	267.677	267.660	267.644	267.627	267.610	267.594	267.577	267.560	267.544	267.527	267.477	267.444
EXG. FORMATION LEVEL OF EXG IR UP MAIN LINE (EFL)	-266.993	-266.962	-266.918	-266.873	-266.822	-266.772	-266.722	-266.672	-266.635	-266.596	-266.546	-266.505	-266.512	-266.504	-266.483	-266.435	-266.374	-266.304	-266.233	-266.156	-266.152	-266.130	-266.093
DIFFERENCE BETWEEN DFC RAIL LEVEL AND EXG. RAIL LEVEL (PRL - ERL)	0.896	0.913	0.943	0.975	1.012	1.046	1.080	1.112	1.133	1.156	1.188	1.212	1.189	1.180	1.185	1.217	1.260	1.314	1.368	1.394	1.413	1.371	1.391
DFC RAIL LEVEL (PRL)	268.561	268.547	268.533	268.520	268.506	268.490	268.473	268.457	268.440	268.423	268.406	268.390	268.373	268.357	268.340	268.323	268.307	268.290	268.273	268.257	268.240	268.223	268.157
EXG.RAIL LEVEL OF NEAREST IR UP MAIN LINE(ERL)	267.665	267.634	267.590	267.545	267.494	267.444	267.394	267.344	267.307	267.268	267.218	267.177	267.184	267.176	267.155	267.107	267.046	266.976	266.905	266.828	266.824	266.819	266.802
EQUIVALENT CHAINAGE ON DFC TRACK	-1211863.1	-1211863.2	-1211903.5	-1211923.7	-1211943.8	-1211963.9	-1211983.9	-1212004.0	-1212024.0	-1212044.1	-1212064.1	-1212084.1	-1212104.1	-1212123.9	-1212143.9	-1212164.0	-1212184.0	-1212203.8	-1212224.0	-1212244.0	-1212263.9	-1212283.9	-1212303.9
EXISTING IR CHAINAGE	321000.0	321020.0	321040.0	321060.0	321080.0	321100.0	321120.0	321140.0	321160.0	321180.0	321200.0	321220.0	321240.0	321260.0	321280.0	321300.0	321320.0	321340.0	321360.0	321380.0	321400.0	321420.0	321480.0

L - SECTION

- NOTE:-
- DFCC WORKS ARE SHOWN IN RED.
 - IR NEW WORKS ARE SHOWN IN VIOLET.
 - ALL DIMENSIONS ARE SHOWN IN METRES.
 - THIS DRAWING IS PREPARED BASED ON LATEST SURVEY DATA HELD ON APRIL-2022. GTS BENCH MARK OF 261.850M CONSIDERED ON TOP OF CANAL BRIDGE ABUTMENT AT DORAH VILLAGE ALONG THE NH1.
 - DFC NEW CHAINAGE OF 1075.950M IS WITH REFERENCE TO THE IR KM OF 187.500KM END OF KM OF CP-303(SECTION P-3 PILKHANI END) AGAINST THE EXISTING DFC CHAINAGE. 116277.742M ISSUED VIDE LETTER NO. COM/DFCC/MS/SURVEY/2021-301-230116-011173.DT. 17.01.2023.
 - BALLAST PROFILE HAS BEEN PROVIDED ACCORDING TO THE CLAUSE 1.11.3 OF STANDARD SCHEDULE OF DIMENSION(EASTERN CORRIDOR) & THE BALLAST CUSHION DIMENSION SHOWN IN 35CM ON GE-14 PARA 17. SPECIFICATIONS & RECOMMENDATIONS 2. TWO LAYER SYSTEM FIG.10.


- REFERENCE DRAWINGS :-
- FOR KEY PLAN REFER DRAWING NO. 301-2/AL/0001
 - FOR LEGEND AND ABBREVIATIONS REFER DRAWING NO. 301-2/AL/1000
 - FOR TYPICAL SECTION OF BALLAST PROFILE (FL-RL) REFER DRG. NO. 301-2/TK/TFD/004 (TR.1952)

REV.	DATE	SUBMISSION OF AS-BUILT DRAWING	FOR APPROVAL
0	26.09.2024	SUBMISSION OF AS-BUILT DRAWING	FOR APPROVAL
REVISION DETAILS			
REV.	DATE	REVISION DETAILS	PURPOSE OF ISSUE

LEGEND:

IR TRACK
DFCC TRACK
DFCC FUTURE PROPOSALS
STRUCTURE / BUILDING
DFCC TOE LINE
DFCC FORMATION
RETAINING WALL
ROAD
STREAM, DRAIN, NALA, CANAL.
FENCE
POWER LINES
TBM
ELECTRIC POLE/OHE MAST
IR RAILWAY BOUNDARY
DFCC BOUNDARY

SCALE
HOR - 1:1000
VER - 1:100
SHEET SIZE : A1

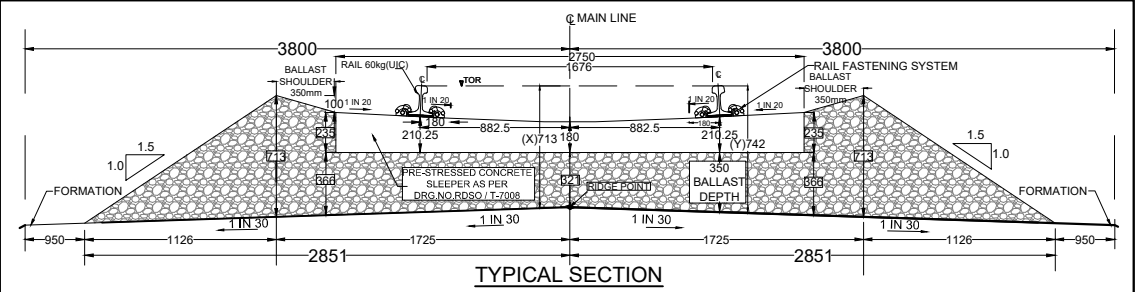

TRACK STRUCTURE		
RAIL SECTION: 60Kg/m (UIC 60Kg/m) DFC LINE: 60Kg/m (UIC 60Kg/m) IR MAIN LINE: 52Kg/m	Difference between FL- RL (Below Rail Seat)	
	IR Line	DFC
RUBBER PAD	172mm	172mm
SLEEPER DEPTH	6mm	10mm
BALLAST CUSHION	210mm	210mm
Total Depth (FL TO RL)	300mm	350mm
	688mm	742mm

OWNER
DEDICATED FREIGHT CORRIDOR CORPORATION OF INDIA LTD.
(A GOVERNMENT OF INDIA ENTERPRISE)
PROJECT OFFICE(AMBALA UNIT): OLD RAILWAY COLONY (NEAR ANAND MARKET),AMBALA CANTT-133001.
CORPORATE IDENTITY NO. : U60232DL2006GGI155068

ENGINEER:
DB Engineering & Consulting GmbH
Deutsche Bahn Engineering & Consulting GmbH

CONTRACTOR:
GIL - TPL JV
GAR TATA

SUBMITTED BY	GIL - TPL JV		
	DATED	NAME	SIGNATURE
PREPARED BY			
CHECKED BY	26.09.2024	VIJAY PRATAP	
APPROVED BY	26.09.2024	PARASURAM KOTYADA	


APPROVED BY	DEUTSCHE BAHN ENGINEERING & CONSULTING GMBH		
	DATED	NAME	SIGNATURE
Sr. DE./CHIEF ENGINEER		SURESH K.YALANGI	
CHIEF TRACK ENGINEER		RAJ PAL SINGH	
T.L.		H.D. VIDJAK	


STAMP
A AS-BUILT DRAWING
TR. Ref:.....
ENGINEER Sign.:.....

EMPLOYER (DFCCIL): DEDICATED FREIGHT CORRIDOR CORPORATION OF INDIA LTD.

AS BUILT DRAWING		
TITLE	DFCC APPR. NO. -	
AS-BUILT PLAN AND PROFILE	ENGG. APPR. NO. -	
FROM IR KM: 321.000 TO 321.500	DRG. NO. - 301-2/AL/A/1268	
DFC KM:1211.863 TO 1212.364	SHEET NO. : 1 OF 1	STATUS
	DATE : 26.09.2024	A

TR.

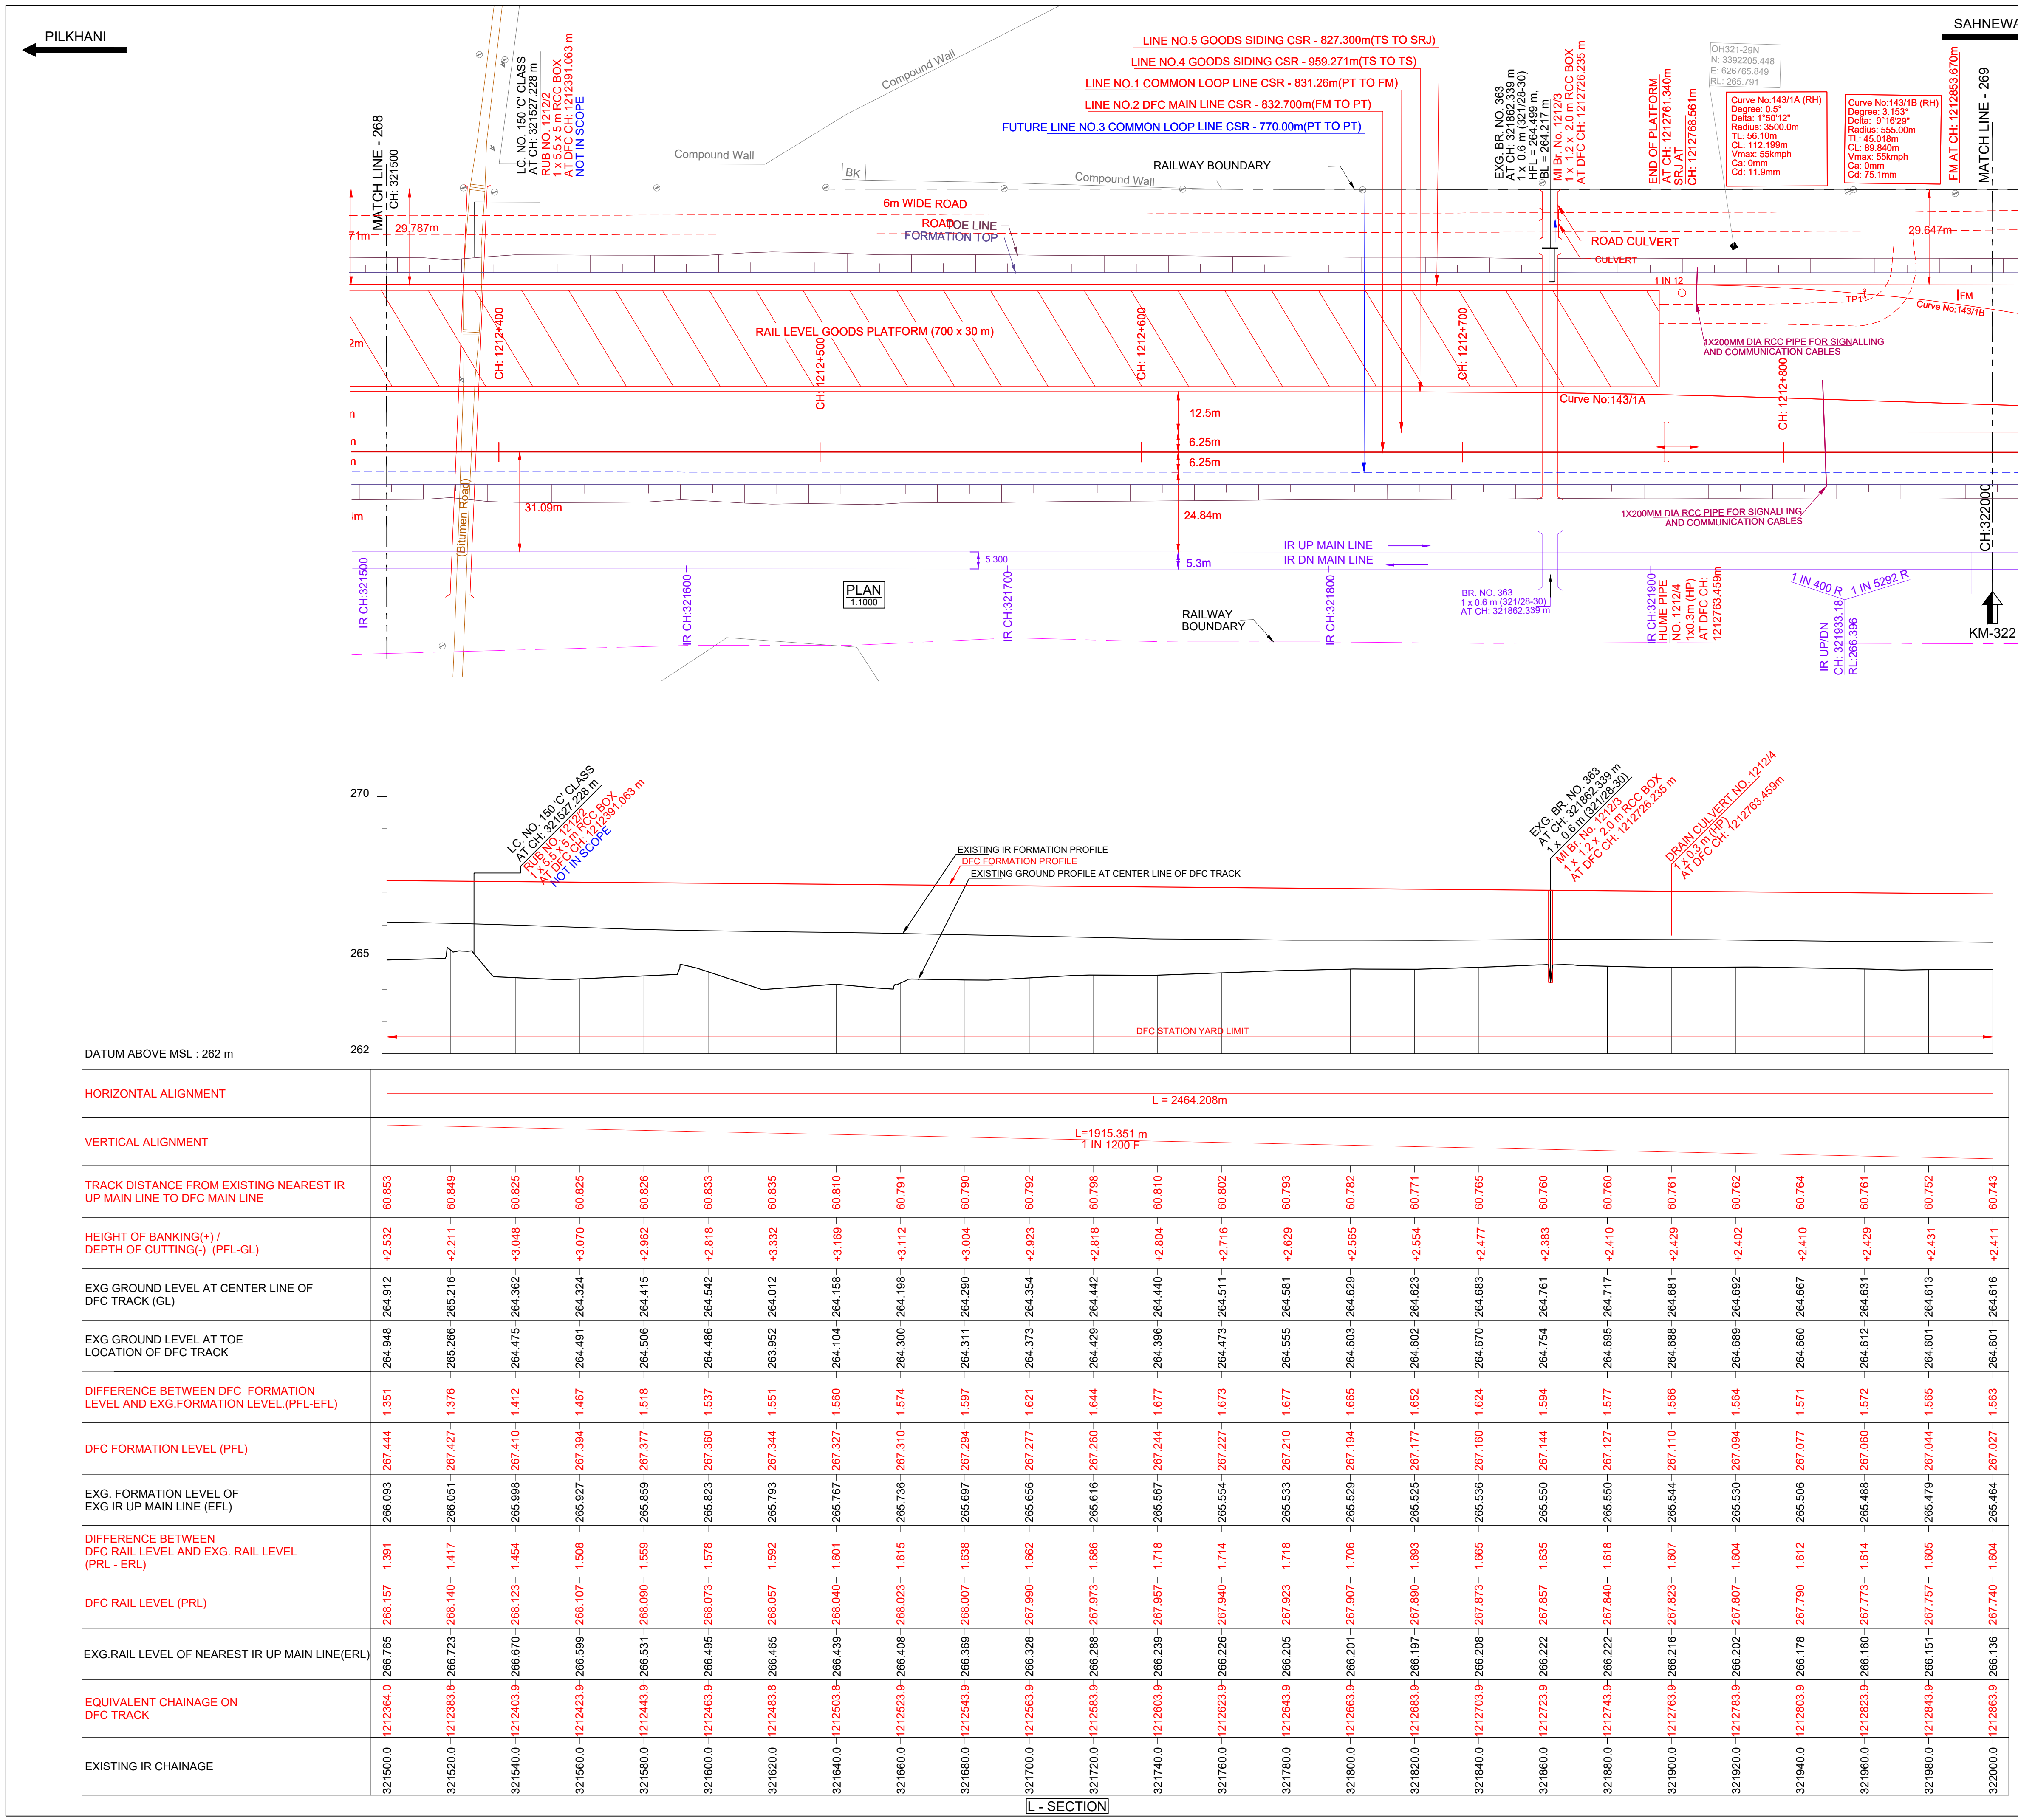

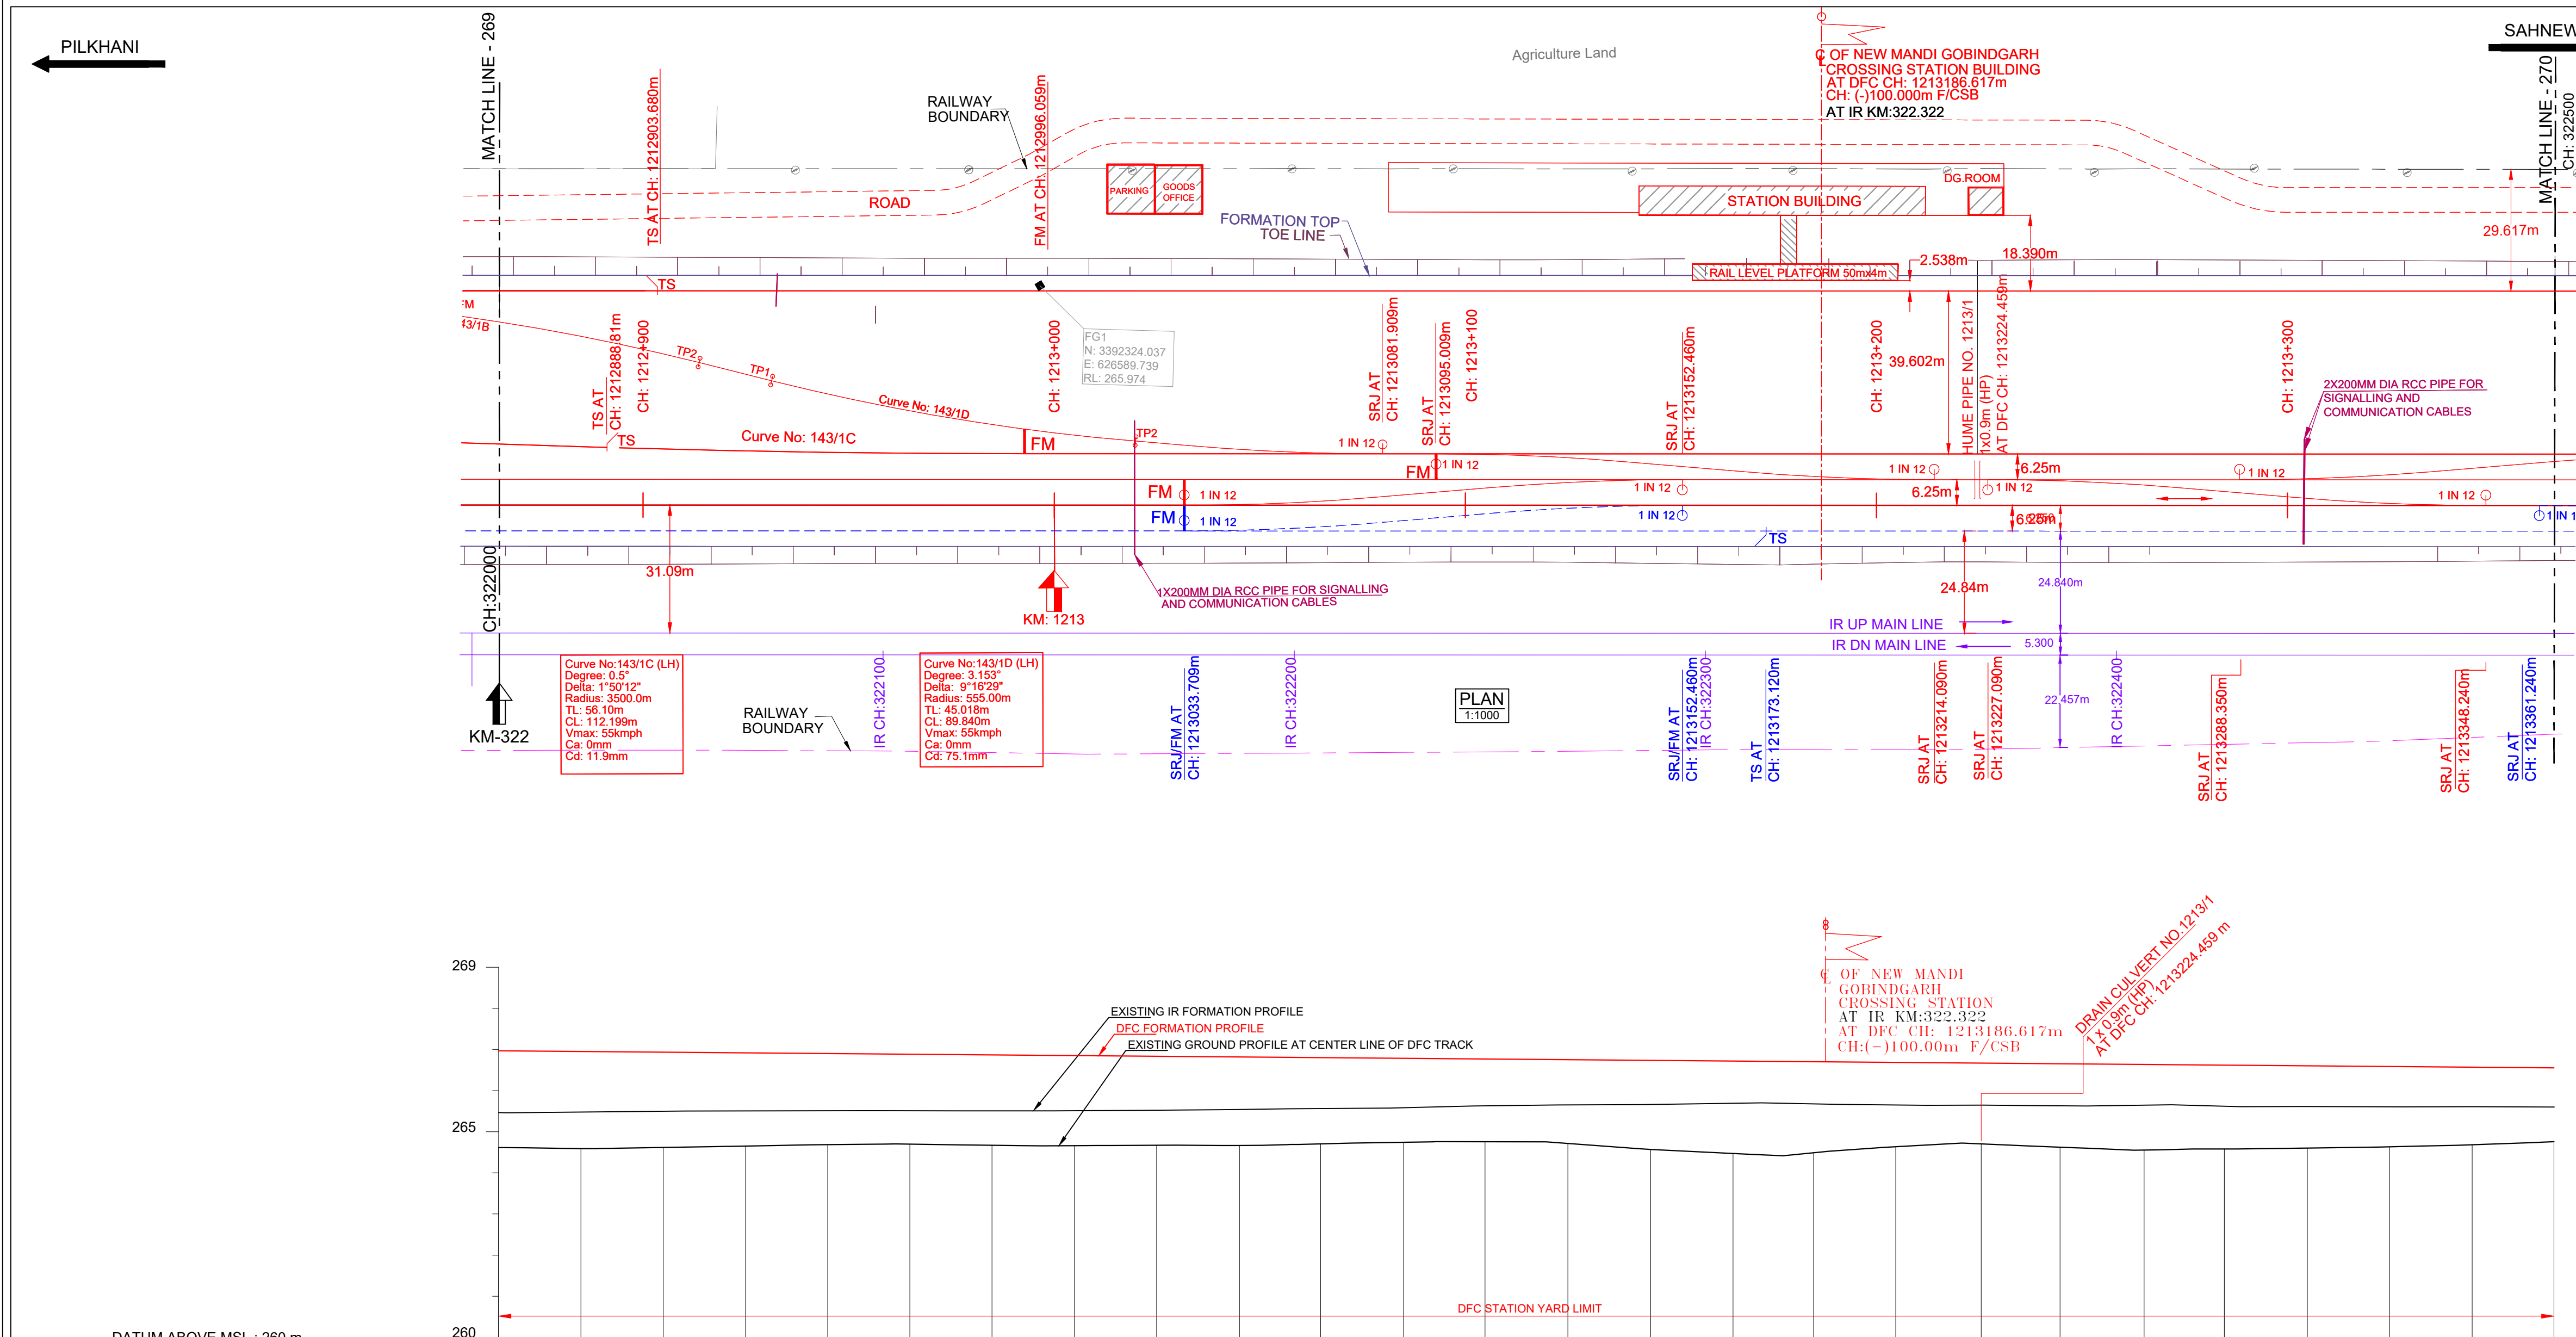

HORIZONTAL ALIGNMENT	L = 2464.208m																			
VERTICAL ALIGNMENT	L=1915.351 m 1 IN 1200 F																			
TRACK DISTANCE FROM EXISTING NEAREST IR UP MAIN LINE TO DFC MAIN LINE	60.743	60.742	60.742	60.742	60.749	60.758	60.759	60.751	60.746	60.753	60.765	60.779	60.749	60.770	60.741	60.763	60.828	60.813	60.744	60.842
HEIGHT OF BANKING(+) / DEPTH OF CUTTING(-) (PFL-GL)	+2.411	+2.421	+2.377	+2.326	+2.273	+2.247	+2.256	+2.250	+2.223	+2.213	+2.164	+2.099	+2.071	+2.094	+2.222	+2.306	+2.272	+2.110	+2.021	+2.087
EXG GROUND LEVEL AT CENTER LINE OF DFC TRACK (GL)	264.616	264.589	264.617	264.651	264.687	264.697	264.671	264.660	264.671	264.684	264.706	264.745	264.756	264.716	264.612	264.571	264.521	264.502	264.624	264.705
EXG GROUND LEVEL AT TOE LOCATION OF DFC TRACK	264.601	264.586	264.615	264.636	264.679	264.692	264.676	264.664	264.672	264.674	264.706	264.739	264.745	264.718	264.612	264.571	264.521	264.502	264.624	264.705
DIFFERENCE BETWEEN DFC FORMATION LEVEL AND EXG.FORMATION LEVEL (PFL-EFL)	1.563	1.530	1.494	1.470	1.451	1.434	1.419	1.400	1.369	1.335	1.296	1.259	1.197	1.156	1.132	1.087	1.087	1.094	1.078	1.078
DFC FORMATION LEVEL (PFL)	267.027	267.010	266.994	266.977	266.960	266.944	266.927	266.910	266.894	266.877	266.860	266.844	266.827	266.810	266.793	266.776	266.760	266.744	266.726	266.708
EXG. FORMATION LEVEL OF EXG IR UP MAIN LINE (EFL)	265.464	265.480	265.500	265.507	265.509	265.510	265.508	265.510	265.525	265.542	265.564	265.585	265.630	265.654	265.661	265.680	265.675	265.650	265.648	265.631
DIFFERENCE BETWEEN DFC RAIL LEVEL AND EXG. RAIL LEVEL (PRL - ERL)	1.604	1.571	1.534	1.511	1.492	1.475	1.460	1.441	1.409	1.376	1.338	1.299	1.238	1.197	1.174	1.127	1.126	1.135	1.120	1.121
DFC RAIL LEVEL (PRL)	267.740	267.723	267.707	267.690	267.673	267.657	267.640	267.623	267.607	267.590	267.573	267.557	267.540	267.523	267.506	267.489	267.473	267.457	267.439	267.423
EXG.RAIL LEVEL OF NEAREST IR UP MAIN LINE(ERL)	266.136	266.152	266.172	266.179	266.181	266.182	266.180	266.182	266.197	266.214	266.236	266.257	266.302	266.326	266.333	266.362	266.347	266.322	266.293	266.303
EQUIVALENT CHAINAGE ON DFC TRACK	1212863.9	1212883.9	1212903.9	1212923.9	1212943.9	1212963.9	1212983.9	1213003.9	1213023.9	1213043.9	1213063.9	1213083.9	1213103.9	1213124.0	1213144.0	1213164.1	1213183.7	1213203.7	1213224.0	1213240.0
EXISTING IR CHAINAGE	322000.0	322020.0	322040.0	322060.0	322080.0	322100.0	322120.0	322140.0	322160.0	322180.0	322200.0	322220.0	322240.0	322260.0	322280.0	322300.0	322320.0	322340.0	322360.0	322380.0

L - SECTION

NOTE:-

- DFCC WORKS ARE SHOWN IN RED.
- IR NEW WORKS ARE SHOWN IN VIOLET.
- ALL DIMENSIONS ARE SHOWN IN METRES.
- THIS DRAWING IS PREPARED BASED ON LATEST SURVEY DATA HELD ON APRIL-2022. GTS BENCH MARK OF 261.850M CONSIDERED ON TOP OF CANAL BRIDGE ABUTMENT AT DORANA VILLAGE ALONG THE NH1.
- DFC NEW CHAINAGE OF 1075.950M IS WITH REFERENCE TO THE IR KM OF 187.500KM END OF KM OF CP-303(SECTION P-3 PILKHANI END) AGAINST THE EXISTING DFC CHAINAGE. 116277.742M ISSUED VIDE LETTER NO. COM/DFCC/UM/SURVEY/2021-301-230116-011173 DT. 17.01.2023.
- BALLAST PROFILE HAS BEEN PROVIDED ACCORDING TO THE CLAUSE 1.11.3 OF STANDARD SCHEDULE OF DIMENSION(EASTERN CORRIDOR) & THE BALLAST CUSHION DIMENSION SHOWN IN 35CM ON GE-14 PARA 17. SPECIFICATIONS & RECOMMENDATIONS 2. TWO LAYER SYSTEM FIG.10.

REFERENCE DRAWINGS :-

- FOR KEY PLAN REFER DRAWING NO. 301-2/AL/0001
- FOR LEGEND AND ABBREVIATIONS REFER DRAWING NO. 301-2/AL/1000
- FOR TYPICAL SECTION OF BALLAST PROFILE (FL-RL) REFER DRG. NO. 301-2/TK/TFD/004 (TR.1952)

0	26.09.2024	SUBMISSION OF AS-BUILT DRAWING	FOR APPROVAL
REV.	DATE	REVISION DETAILS	PURPOSE OF ISSUE

SCALE
HOR - 1:1000
VER - 1:100
SHEET SIZE : A1

LEGEND:

- IR TRACK
- DFCC TRACK
- DFCC FUTURE PROPOSALS
- STRUCTURE / BUILDING
- DFCC TOE LINE
- DFCC FORMATION
- RETAINING WALL
- ROAD
- STREAM, DRAIN, NALA, CANAL.
- FENCE
- POWER LINES
- TBM
- ELECTRIC POLE/OHE MAST
- IR RAILWAY BOUNDARY
- DFCC BOUNDARY

TYPICAL SECTION

TRACK STRUCTURE													
RAIL SECTION: 60Kg/m (UIC 60Kg/m) DFC LINE: 60Kg/m (UIC 60Kg/m) IR MAIN LINE: 52Kg/m	Difference between FL- RL (Below Rail Seat) <table><tr><th>IR Line</th><th>DFC</th></tr><tr><td>172mm</td><td>172mm</td></tr><tr><td>6mm</td><td>10mm</td></tr><tr><td>210mm</td><td>210mm</td></tr><tr><td>300mm</td><td>350mm</td></tr><tr><td>Total Depth (FL TO RL)</td><td>688mm 742mm</td></tr></table>	IR Line	DFC	172mm	172mm	6mm	10mm	210mm	210mm	300mm	350mm	Total Depth (FL TO RL)	688mm 742mm
IR Line	DFC												
172mm	172mm												
6mm	10mm												
210mm	210mm												
300mm	350mm												
Total Depth (FL TO RL)	688mm 742mm												
RUBBER PAD													
SLEEPER DEPTH													
BALLAST CUSHION													

OWNER
DEDICATED FREIGHT CORRIDOR CORPORATION OF INDIA LTD.
(A GOVERNMENT OF INDIA ENTERPRISE)
PROJECT OFFICE(AMBALA UNIT): OLD RAILWAY COLONY (NEAR ANAND MARKET),AMBALA CANTT-133001.
CORPORATE IDENTITY NO. : U60232DL20060G0155068

ENGINEER:
DB Engineering & Consulting GmbH
Deutsche Bahn Engineering & Consulting GmbH

CONTRACTOR:
GIL - TPL JV
GAR TATA


SUBMITTED BY	GIL - TPL JV		
	DATED	NAME	SIGNATURE
PREPARED BY			
CHECKED BY	26.09.2024	VIJAY PRATAP	
APPROVED BY	26.09.2024	PARASURAM KOTYADA	
APPROVED BY	DEUTSCHE BAHN ENGINEERING & CONSULTING GMBH		
	DATED	NAME	SIGNATURE
Sr. DE./CHIEF ENGINEER		SURESH K.YALANGI	
CHIEF TRACK ENGINEER		RAJ PAL SINGH	
T.L.		H.D. VIDJAK	

STAMP
A AS-BUILT DRAWING
TR. Ref.:.....
ENGINEER Sign.:

EMPLOYER (DFCCIL): DEDICATED FREIGHT CORRIDOR CORPORATION OF INDIA LTD.

AS BUILT DRAWING	
TITLE AS-BUILT PLAN AND PROFILE FROM IR KM: 322.000 TO 322.500 DFC KM:1212.864 TO 1213.364	DFCC APPR. NO. - ENGG. APPR. NO. - DRG. NO. -301-2/AL/A/1270 SHEET NO.: 1 OF 1 DATE : 26.09.2024
STATUS A	

TR.

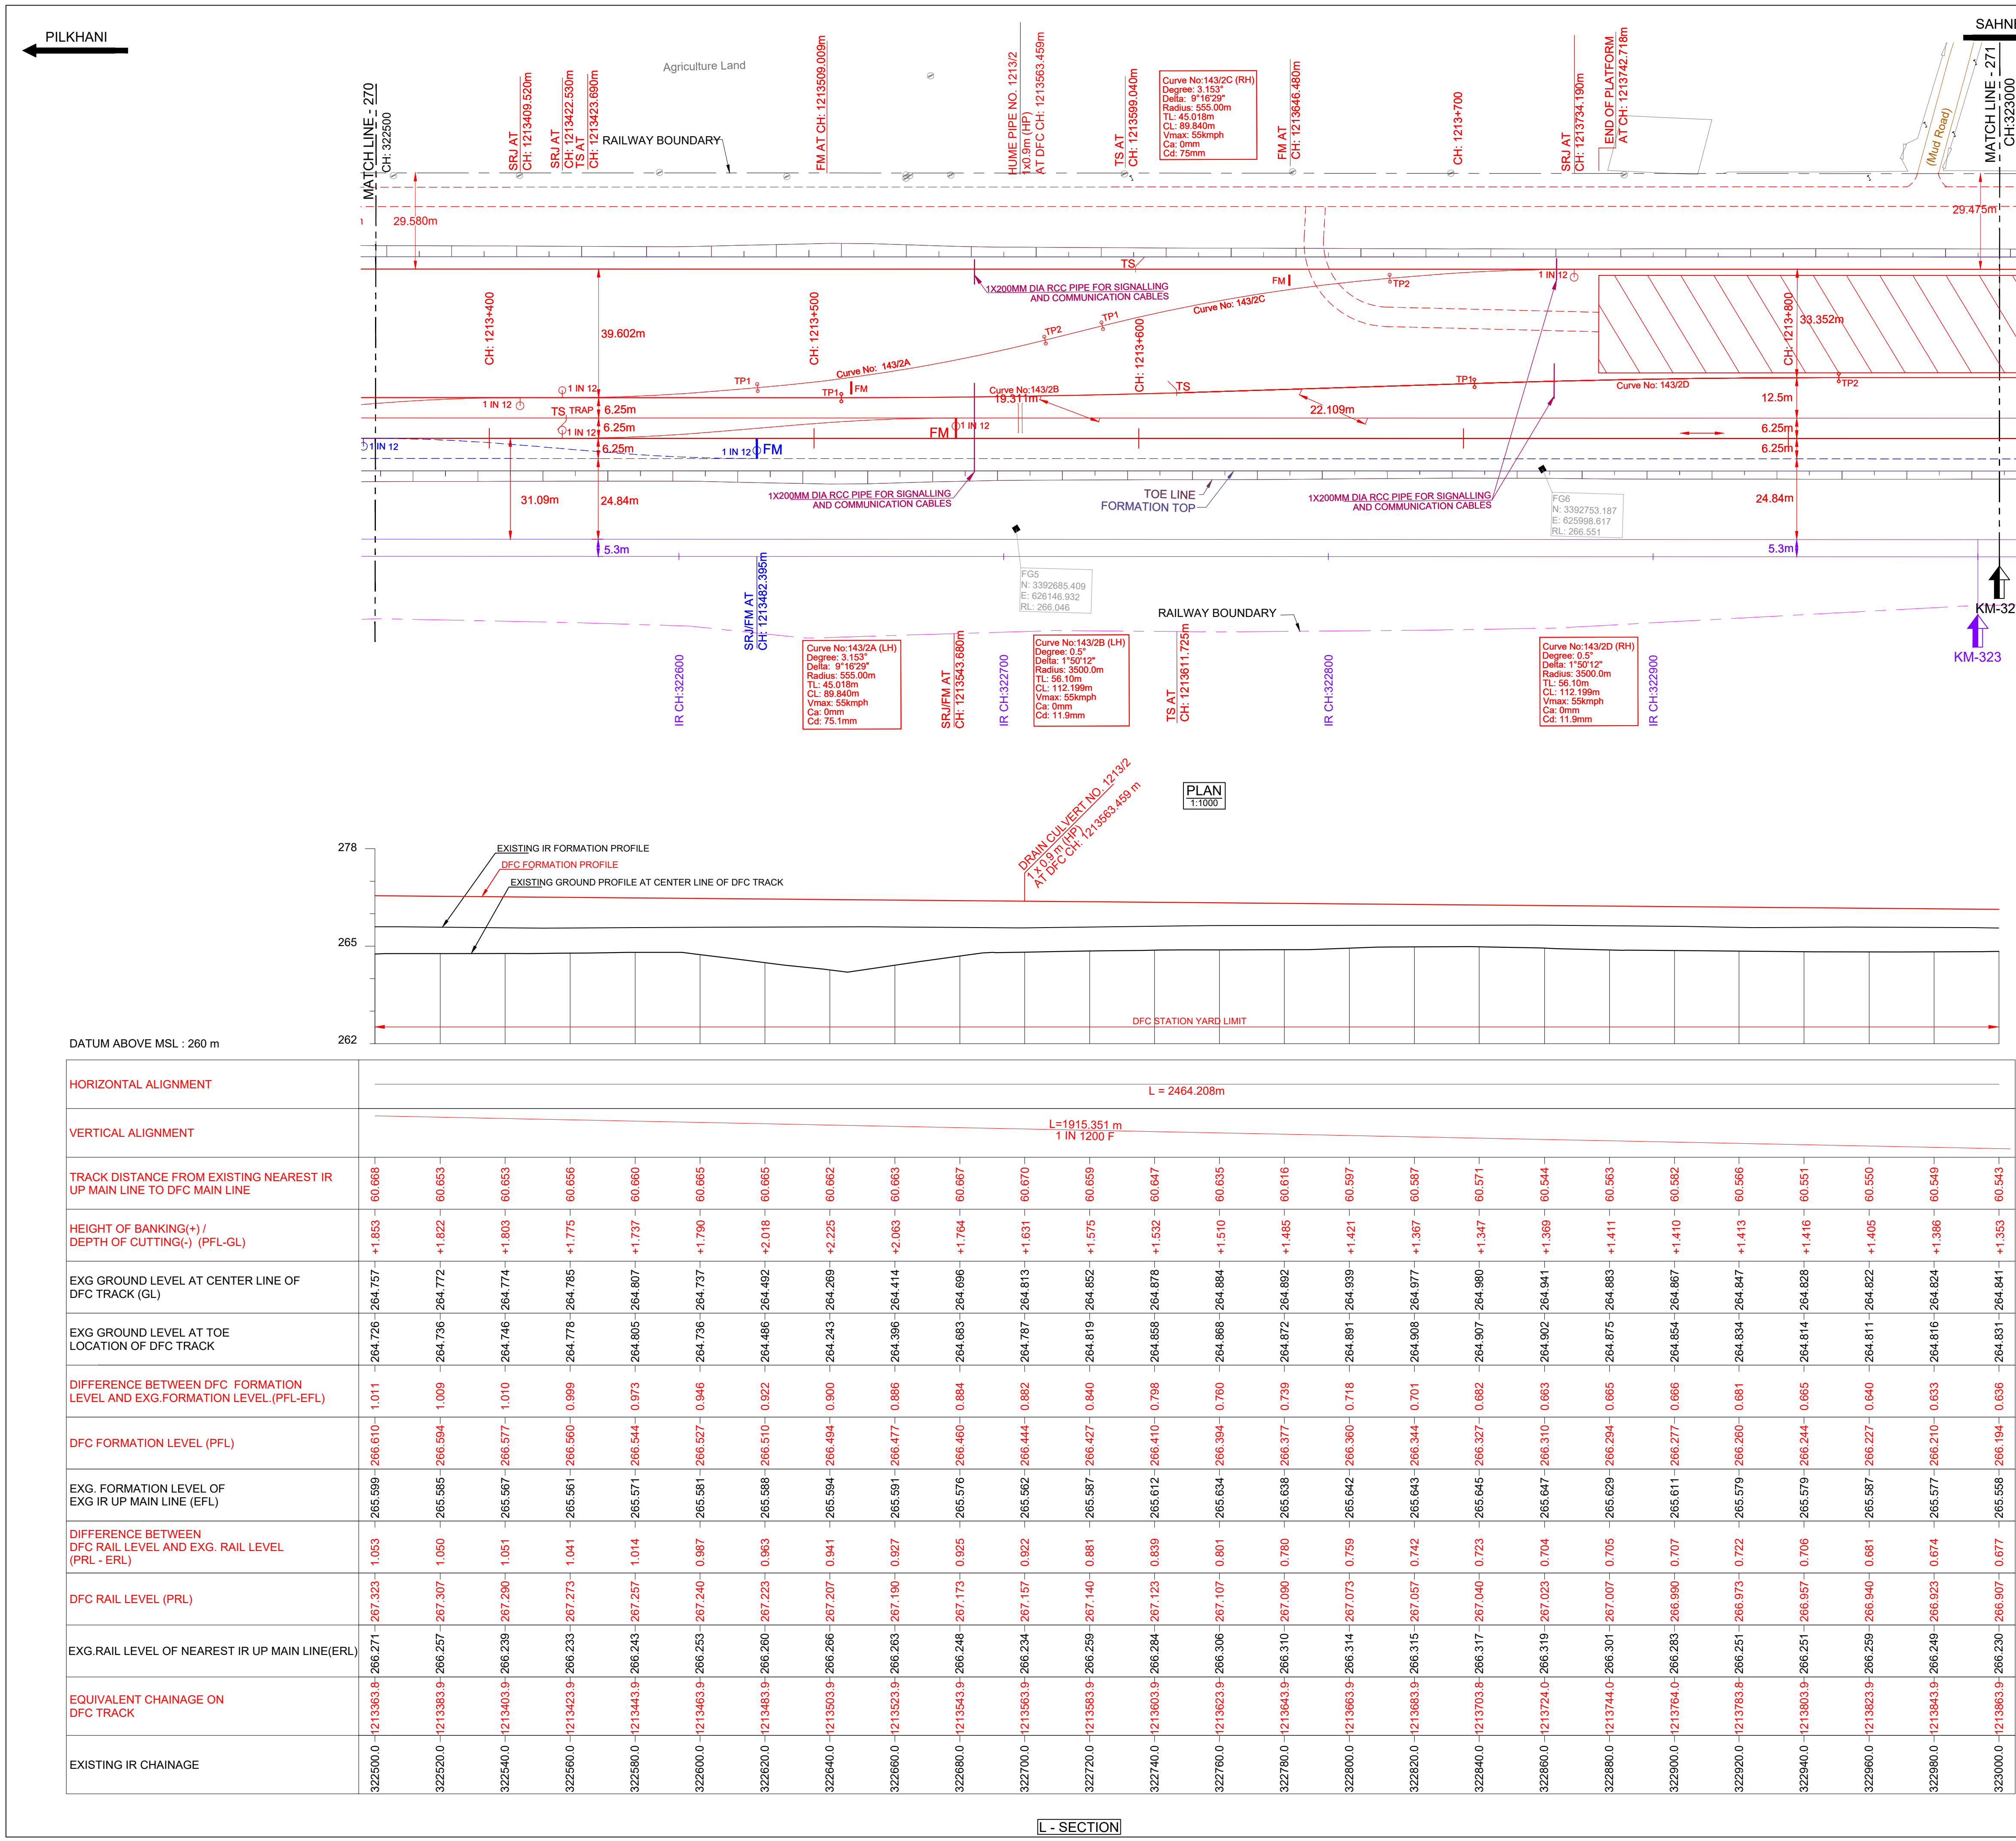

NOTE:-

- DFCC WORKS ARE SHOWN IN RED.
- IR NEW WORKS ARE SHOWN IN VIOLET.
- ALL DIMENSIONS ARE SHOWN IN METRES.
- THIS DRAWING IS PREPARED BASED ON LATEST SURVEY DATA HELD ON APRIL-2022. GTS BENCH MARK OF 261.850M CONSIDERED ON TOP OF CANAL BRIDGE ABUTMENT AT DORANA VILLAGE ALONG THE NH1.
- DFC NEW CHAINAGE OF 1075.950M IS WITH REFERENCE TO THE IR KM OF 187.500KM END OF KM OF CP-303(SECTION P-3 PILKHANI END) AGAINST THE EXISTING DFC CHAINAGE. 116277.742M ISSUED VIDE LETTER NO. COM/DFCC/UM/SURVEY/2021-301-230116-011173 DT. 17.01.2023.
- BALLAST PROFILE HAS BEEN PROVIDED ACCORDING TO THE CLAUSE 1.11.3 OF STANDARD SCHEDULE OF DIMENSION (EASTERN CORRIDOR) & THE BALLAST CUSHION DIMENSION SHOWN IN 35CM ON GE-14 PARA 17. SPECIFICATIONS & RECOMMENDATIONS 2. TWO LAYER SYSTEM FIG.10.

REFERENCE DRAWINGS :-

- FOR KEY PLAN REFER DRAWING NO. 301-2/AL/0001
- FOR LEGEND AND ABBREVIATIONS REFER DRAWING NO. 301-2/AL/1000
- FOR TYPICAL SECTION OF BALLAST PROFILE (FL-RL) REFER DRG. NO. 301-2/TK/TFD/-004 (TR.1952)

REVISION DETAILS

REV.	DATE	REVISION DETAILS	PURPOSE OF ISSUE
0	26.09.2024	SUBMISSION OF AS-BUILT DRAWING	FOR APPROVAL

LEGEND:

- IR TRACK
- DFCC TRACK
- DFCC FUTURE PROPOSALS
- STRUCTURE / BUILDING
- DFCC TOE LINE
- DFCC FORMATION
- RETAINING WALL
- ROAD
- STREAM, DRAIN, NALA, CANAL
- POWER LINES
- TBM
- ELECTRIC POLE/OHE MAST
- IR RAILWAY BOUNDARY
- DFCC BOUNDARY

SCALE

HOR - 1:1000

VER - 1:100

SHEET SIZE : A1

TYPICAL SECTION

TRACK STRUCTURE

RAIL SECTION: 60Kg/m (UIC 60Kg/m) DFC LINE: 60Kg/m (UIC 60Kg/m) IR MAIN LINE: 52Kg/m	Difference between FL- RL (Below Rail Seat)	
	IR Line	DFC
RUBBER PAD	172mm	172mm
SLEEPER DEPTH	210mm	210mm
BALLAST CUSHION	300mm	350mm
Total Depth (FL TO RL)	688mm	742mm

OWNER

DEDICATED FREIGHT CORRIDOR CORPORATION OF INDIA LTD.

(A GOVERNMENT OF INDIA ENTERPRISE)

PROJECT OFFICE (AMBALA UNIT): OLD RAILWAY COLONY (NEAR ANAND MARKET), AMBALA CANTT-133001.

CORPORATE IDENTITY NO. : U60232DL2006GGI155068

ENGINEER:

DB Engineering & Consulting GmbH

Deutsche Bahn Engineering & Consulting GmbH

CONTRACTOR:

GIL - TPL JV

GAR TATA

SUBMITTED BY

GIL - TPL JV

DATED

NAME

SIGNATURE

PREPARED BY

CHECKED BY

26.09.2024

VIJAY PRATAP

APPROVED BY

26.09.2024

PARASURAM KOTYADA

APPROVED BY

DEUTSCHE BAHN ENGINEERING & CONSULTING GMBH

DATED

NAME

SIGNATURE

Sr. DE./CHIEF ENGINEER

SURESH K.YALANGI

CHIEF TRACK ENGINEER

RAJ PAL SINGH

T.L.

H.D. VIDJAK

STAMP

AS-BUILT DRAWING

TR. Ref.:.....

ENGINEER Sign.:.....

EMPLOYER (DFCCIL):

DEDICATED FREIGHT CORRIDOR CORPORATION OF INDIA LTD.

AS BUILT DRAWING

TITLE

AS-BUILT PLAN AND PROFILE

FROM IR KM: 322.500 TO 323.000

DFC KM: 1213.364 TO 1213.864

DFCC APPR. NO. -

ENGG. APPR. NO. -

DRG. NO. - 301-2/AL/A/1271


SHEET NO. : 1 OF 1

DATE : 26.09.2024

STATUS

A

TR.

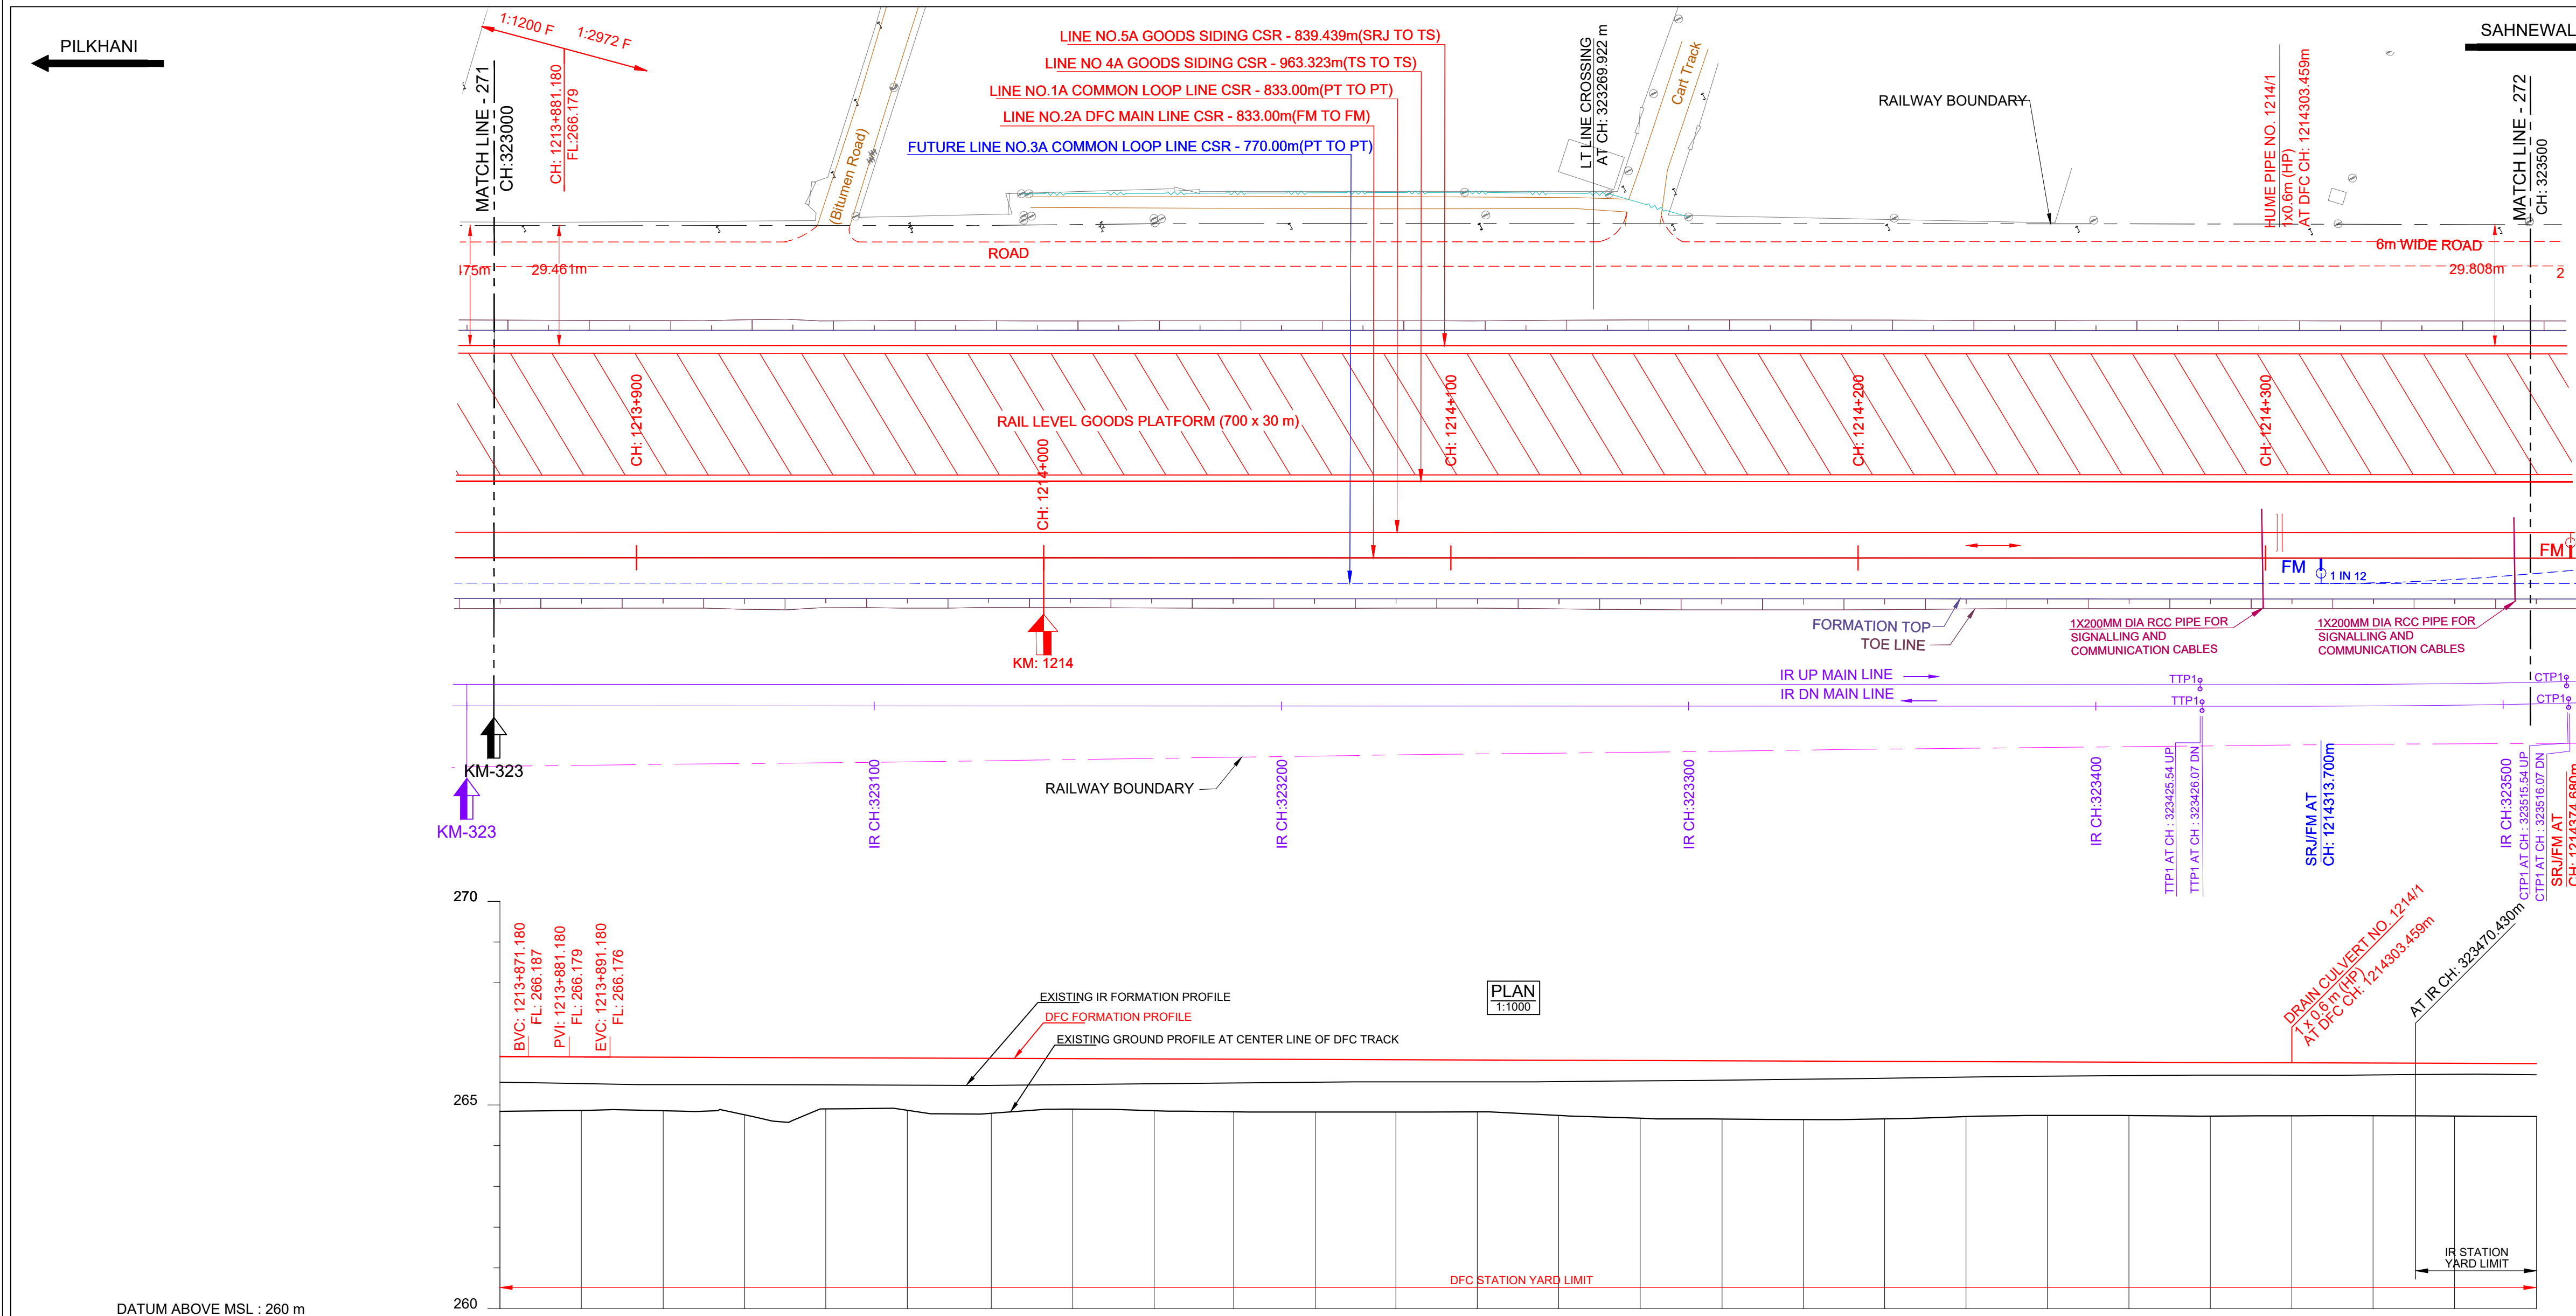

DATUM ABOVE MSL : 260 m

HORIZONTAL ALIGNMENT	L = 2464.208m																							
VERTICAL ALIGNMENT	L=1915.235 m T IN 1200 F L=20.0 m R=40254 m L=1549.010 m T IN 2971.880 F																							
TRACK DISTANCE FROM EXISTING NEAREST IR UP MAIN LINE TO DFC MAIN LINE	60.543	60.530	60.528	60.550	60.566	60.560	60.573	60.774	60.975	61.050	61.094	61.109	61.095	61.045	61.055	61.058	61.042	61.023	60.999	60.976	60.951	60.889	60.882	
HEIGHT OF BANKING(+) / DEPTH OF CUTTING(-) (PFL-GL)	+1.353	+1.312	+1.314	+1.407	+1.254	+1.282	+1.348	+1.238	+1.272	+1.294	+1.291	+1.285	+1.274	+1.431	+1.437	+1.414	+1.348	+1.315	+1.311	+1.316	+1.304	+1.295	+1.298	+1.301
EXG GROUND LEVEL AT CENTER LINE OF DFC TRACK (GL)	264.841	264.866	264.857	264.757	264.904	264.869	264.796	264.899	264.859	264.830	264.826	264.826	264.830	264.741	264.673	264.686	264.640	264.656	264.739	264.727	264.733	264.735	264.715	
EXG GROUND LEVEL AT TOE LOCATION OF DFC TRACK	264.831	264.870	264.892	264.796	264.899	264.850	264.865	264.885	264.857	264.839	264.828	264.824	264.833	264.747	264.695	264.694	264.718	264.715	264.745	264.737	264.737	264.729	264.721	
DIFFERENCE BETWEEN DFC FORMATION LEVEL AND EXG.FORMATION LEVEL.(PFL-EFL)	0.636	0.654	0.672	0.668	0.665	0.666	0.665	0.638	0.611	0.584	0.559	0.543	0.536	0.477	0.447	0.416	0.381	0.350	0.329	0.310	0.306	0.293	0.270	0.276
DFC FORMATION LEVEL (PFL)	266.194	266.178	266.171	266.164	266.158	266.151	266.144	266.137	266.131	266.124	266.117	266.111	266.104	266.084	266.090	266.070	266.063	266.057	266.050	266.043	266.037	266.030	266.016	
EXG. FORMATION LEVEL OF EXG IR UP MAIN LINE (EFL)	265.558	265.524	265.499	265.497	265.493	265.485	265.479	265.469	265.520	265.540	265.559	265.568	265.568	265.607	265.592	265.630	265.654	265.683	265.707	265.721	265.733	265.730	265.740	
DIFFERENCE BETWEEN DFC RAIL LEVEL AND EXG. RAIL LEVEL (PRL - ERL)	0.677	0.695	0.714	0.709	0.706	0.707	0.706	0.679	0.652	0.625	0.600	0.584	0.577	0.518	0.488	0.457	0.422	0.391	0.370	0.352	0.348	0.311	0.317	
DFC RAIL LEVEL (PRL)	266.907	266.891	266.884	266.878	266.871	266.864	266.857	266.850	266.844	266.837	266.830	266.824	266.817	266.797	266.790	266.783	266.777	266.770	266.763	266.757	266.750	266.736	266.730	
EXG.RAIL LEVEL OF NEAREST IR UP MAIN LINE(ERL)	266.230	266.196	266.171	266.169	266.165	266.157	266.151	266.171	266.192	266.212	266.231	266.240	266.240	266.279	266.302	266.326	266.355	266.379	266.393	266.405	266.402	266.425	266.412	
EQUIVALENT CHAINAGE ON DFC TRACK	-1213863.9	-1213883.9	-1213904.0	-1213924.0	-1213943.9	-1213963.9	-1213984.5	-1214004.5	-1214024.5	-1214044.0	-1214064.0	-1214083.9	-1214103.9	-1214123.8	-1214143.8	-1214203.9	-1214223.9	-1214243.8	-1214263.8	-1214283.8	-1214303.8	-1214343.8	-1214363.9	
EXISTING IR CHAINAGE	323000.0	323020.0	323040.0	323060.0	323080.0	323100.0	323120.0	323140.0	323160.0	323180.0	323200.0	323220.0	323240.0	323260.0	323280.0	323300.0	323320.0	323340.0	323360.0	323380.0	323400.0	323420.0	323440.0	

L - SECTION

NOTE:-

- DFCC WORKS ARE SHOWN IN RED.
- IR NEW WORKS ARE SHOWN IN VIOLET.
- ALL DIMENSIONS ARE SHOWN IN METRES.
- THIS DRAWING IS PREPARED BASED ON LATEST SURVEY DATA HELD ON APRIL-2022. GTS BENCH MARK OF 261.850M CONSIDERED ON TOP OF CANAL BRIDGE ABUTMENT AT DORAH VILLAGE ALONG THE NH1.
- DFC NEW CHAINAGE OF 1075.950M IS WITH REFERENCE TO THE IR KM OF 187.500KM END OF KM OF CP-303(SECTION P-3 PILKHANI END) AGAINST THE EXISTING DFC CHAINAGE. 116277.742M ISSUED VIDE LETTER NO. COM/DFCC/UMS/SURVEY/2021-301-230116-011173 DT. 17.01.2023.
- BALLAST PROFILE HAS BEEN PROVIDED ACCORDING TO THE CLAUSE 1.11.3 OF STANDARD SCHEDULE OF DIMENSION(EASTERN CORRIDOR) & THE BALLAST CUSHION DIMENSION SHOWN IN 35CM ON GE-14 PARA 17. SPECIFICATIONS & RECOMMENDATIONS 2. TWO LAYER SYSTEM FIG.10.

REFERENCE DRAWINGS :-

- FOR KEY PLAN REFER DRAWING NO. 301-2/AL/0001
- FOR LEGEND AND ABBREVIATIONS REFER DRAWING NO. 301-2/AL/1000
- FOR TYPICAL SECTION OF BALLAST PROFILE (FL-RL) REFER DRG. NO. 301-2/TK/TFDI-004 (TR.1952)

026.09.2024SUBMISSION OF AS-BUILT DRAWINGFOR APPROVAL

REV. DATE REVISION DETAILS PURPOSE OF ISSUE

SCALE
HOR - 1:1000
VER - 1:100
SHEET SIZE : A1

LEGEND:

- IR TRACK
- DFCC TRACK
- DFCC FUTURE PROPOSALS
- STRUCTURE / BUILDING
- DFCC TOE LINE
- DFCC FORMATION
- RETAINING WALL
- ROAD
- STREAM, DRAIN, NALA, CANAL.
- FENCE
- POWER LINES
- TBM
- ELECTRIC POLE/OHE MAST
- IR RAILWAY BOUNDARY
- DFCC BOUNDARY

TYPICAL SECTION

TRACK STRUCTURE		
RAIL SECTION: 60Kg/m (UIC 60Kg/m)	Difference between FL- RL (Below Rail Seat)	
DFC LINE: 60Kg/m (UIC 60Kg/m)	IR Line	DFC
IR MAIN LINE :52Kg/m	172mm	172mm
RUBBER PAD	6mm	10mm
SLEEPER DEPTH	210mm	210mm
BALLAST CUSHION	300mm	350mm
Total Depth (FL TO RL)	688mm	742mm

OWNER
DEDICATED FREIGHT CORRIDOR CORPORATION OF INDIA LTD.
(A GOVERNMENT OF INDIA ENTERPRISE)
PROJECT OFFICE(AMBALA UNIT): OLD RAILWAY COLONY (NEAR ANAND MARKET),AMBALA CANTT-133001.
CORPORATE IDENTITY NO. : U60232DL2006GGI155068

ENGINEER:
DB Engineering & Consulting GmbH
Deutsche Bahn Engineering & Consulting GmbH

CONTRACTOR:
GIL - TPL JV
GAR TATA

SUBMITTED BY	GIL - TPL JV		
	DATED	NAME	SIGNATURE
PREPARED BY			
CHECKED BY	26.09.2024	VIJAY PRATAP	
APPROVED BY	26.09.2024	PARASURAM KOTYADA	
APPROVED BY	DEUTSCHE BAHN ENGINEERING & CONSULTING GMBH		
	DATED	NAME	SIGNATURE
Sr. DE./CHIEF ENGINEER		SURESH K.YALANGI	
CHIEF TRACK ENGINEER		RAJ PAL SINGH	
T.L.		H.D. VIDJAK	

STAMP
A
AS-BUILT DRAWING
TR. Ref.:.....
ENGINEER Sign.:.....

EMPLOYER (DFCCIL): DEDICATED FREIGHT CORRIDOR CORPORATION OF INDIA LTD.

TITLE
AS-BUILT PLAN AND PROFILE
FROM IR KM: 323.000 TO 323.500
DFC KM:1213.864 TO 1214.364

DFCC APPR. NO. -
ENGG. APPR. NO. -
DRG. NO. -301-2/AL/A/1272
SHEET NO. : 1 OF 1
DATE : 26.09.2024

STATUS
A

TR.



L - SECTION

- NOTE:-**



 1. DFFC WORKS ARE SHOWN IN **RED**.
 2. IR NEW WORKS ARE SHOWN IN **VIOLET**.
 3. ALL DIMENSIONS ARE SHOWN IN METRES.
 4. THIS DRAWING IS PREPARED BASED ON LATEST SURVEY DATA HELD ON APRIL-2022. GT'S BENCH MARK OF 261.850M CONSIDERED ON TOP OF CANAL BRIDGE ABUTMENT AT DORAHA VILLAGE ALONG THE NH1.
 5. DFFC NEW DIMENSION OF 1075.950M IS WITH REFERENCE TO THE IR KM OF 187.500KM END OF KM OF C-303(SECTION P-3 PLK)HANI END AGAINST THE EXISTING DFC CHAINAGE. 116277.742M ISSUED DVIY LETTER NO. GMD/CMDC/PM&M/SURVEY/2021-301-201-216-11173 D-3. 17. 01. 2023
 6. BALLAST PROFILE HAS BEEN PROVIDED ACCORDING TO THE CLAUSE 1.11.3 OF STANDARD SCHEDULE OF WORKS/STANDARD CORRIDOR 3. THE BALLAST CUSHION DIMENSION 1000MM ON 35CM ON GE-11.
 7. BALL. SPECIFICATIONS & RECOMMENDATIONS 2. TWO LAYER SYSTEM FIG. 10.

REFERENCE DRAWINGS :-

1. FOR KEY PLAN REFER DRAWING NO. 301-2/AL/0001
2. FOR LEGEND AND ABBREVIATIONS REFER DRAWING NO. 301-2/AL/1000
3. FOR TYPICAL SECTION OF BALLAST PROFILE (FL-RL) REFFER DRG. NO. 301-2/TK/TFD/-004 (TR.1952)

0	26.09.2024	SUBMISSION OF AS-BUILT DRAWING	FOR APPROVAL
REV.	DATE	REVISION DETAILS	PURPOSE OF ISSUE

LEGEND:

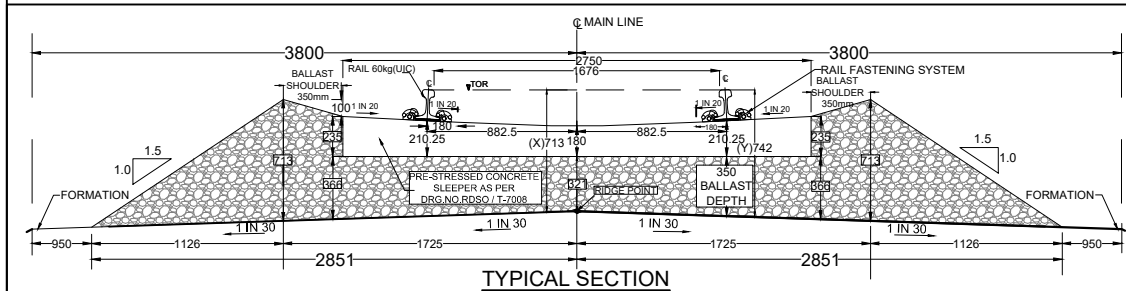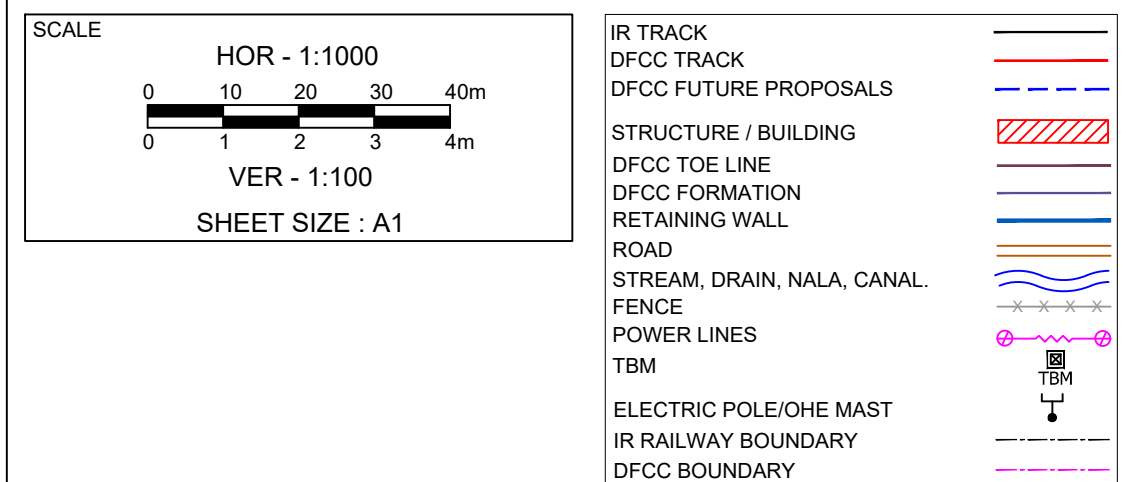

TRACK STRUCTURE		
RAIL SECTION: 60Kg/m (UIC 60Kg/m) DFC LINE: 60Kg/m (UIC 60Kg/m) IR MAIN LINE: 52Kg/m	Difference between FL- RL (Below Rail Seat)	
	IR Line	DFC
	172mm	172mm
RUBBER PAD	6mm	10mm
SLEEPER DEPTH	210mm	210mm
BALLAST CUSHION	300mm	350mm
Total Depth (FL TO RL)	688mm	742mm

OWNER	DEDICATED FREIGHT CORRIDOR CORPORATION OF INDIA LTD
-------	---



DEDICATED FREIGHT CORRIDOR CORPORATION OF INDIA LTD.
(A GOVERNMENT OF INDIA ENTERPRISE)
PROJECT OFFICE(AMBALA UNIT): OLD RAILWAY COLONY (NEAR
ANAND MARKET),AMBALA CANTT-133001.
CORPORATE IDENTITY NO. : U60232DL2006GOI155068

ENGINEER



DB Engineering & Consulting GmbH
Deutsche Bahn Engineering & Consulting GmbH

CONTRACTOR

GIL - TPL JV



SUBMITTED BY	GIL - TPL JV		
	DATED	NAME	SIGNATURE
PREPARED BY			
CHECKED BY	26.09.2024	VIJAY PRATAP	
APPROVED BY	26.09.2024	PARASURAM KOTYADA	

APPROVED BY	DEUTSCHE BAHN ENGINEERING & CONSULTING GMBH		
	DATED	NAME	SIGNATURE
Sr. DE./CHIEF ENGINEER		SURESH K.YALANGI	
CHIEF TRACK ENGINEER		RAJ PAL SINGH	
T.L.		H.D. VIDJAK	

--	--

STAMP



EMPLOYER (DFCCIL):

DEDICATED FREIGHT CORRIDOR CORPORATION OF INDIA LTD

AS BUILT DRAWING

TITLE AS-BUILT PLAN AND PROFILE FROM IR KM: 323.500 TO 324.000 DFC KM:1214.364 TO 1214.880	DFCC APPR. NO. -	STATUS A
	ENGG. APPR. NO. -	
	DRG. NO. - 301-2/AL/A/1273	
	SHEET NO. : 1 OF 1	
	DATE : 26.09.2024	

TR

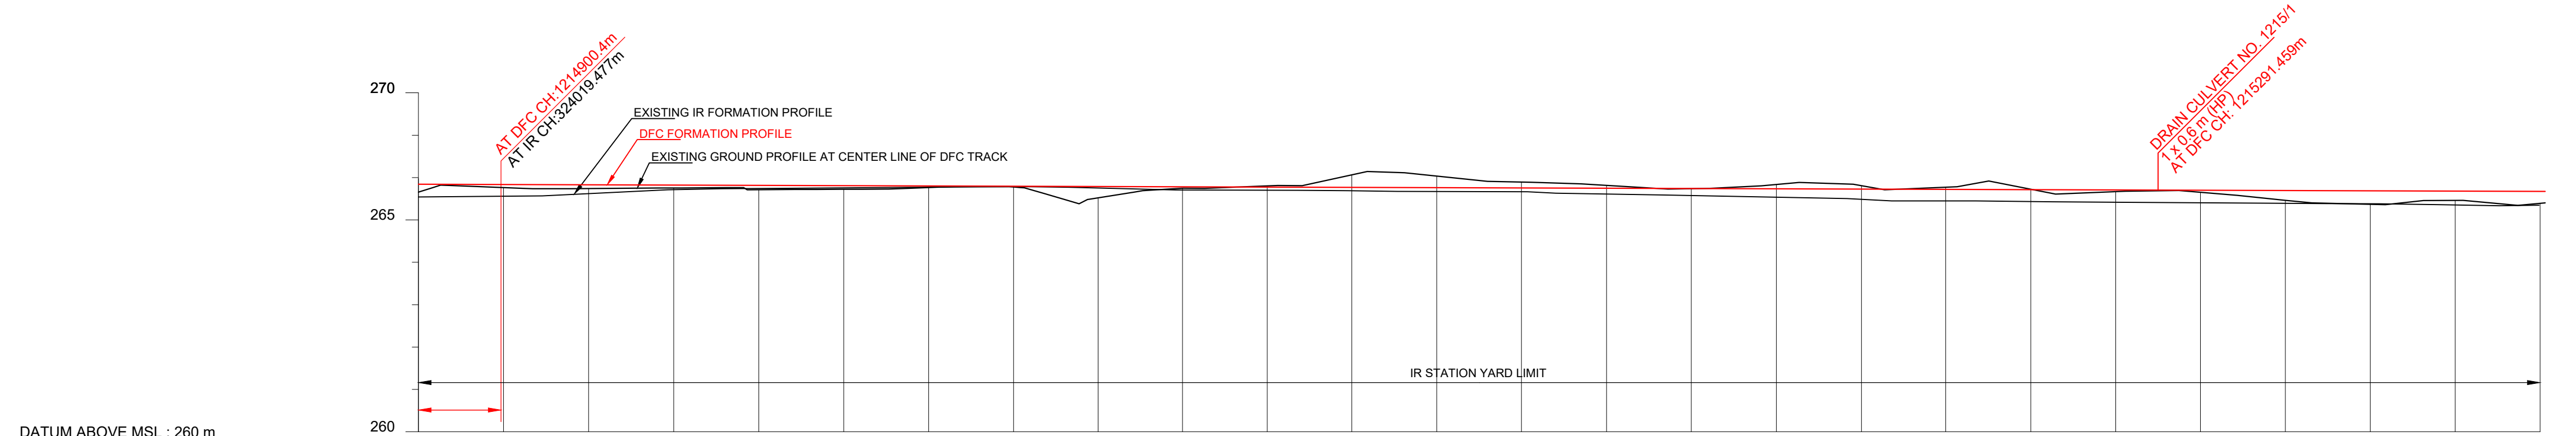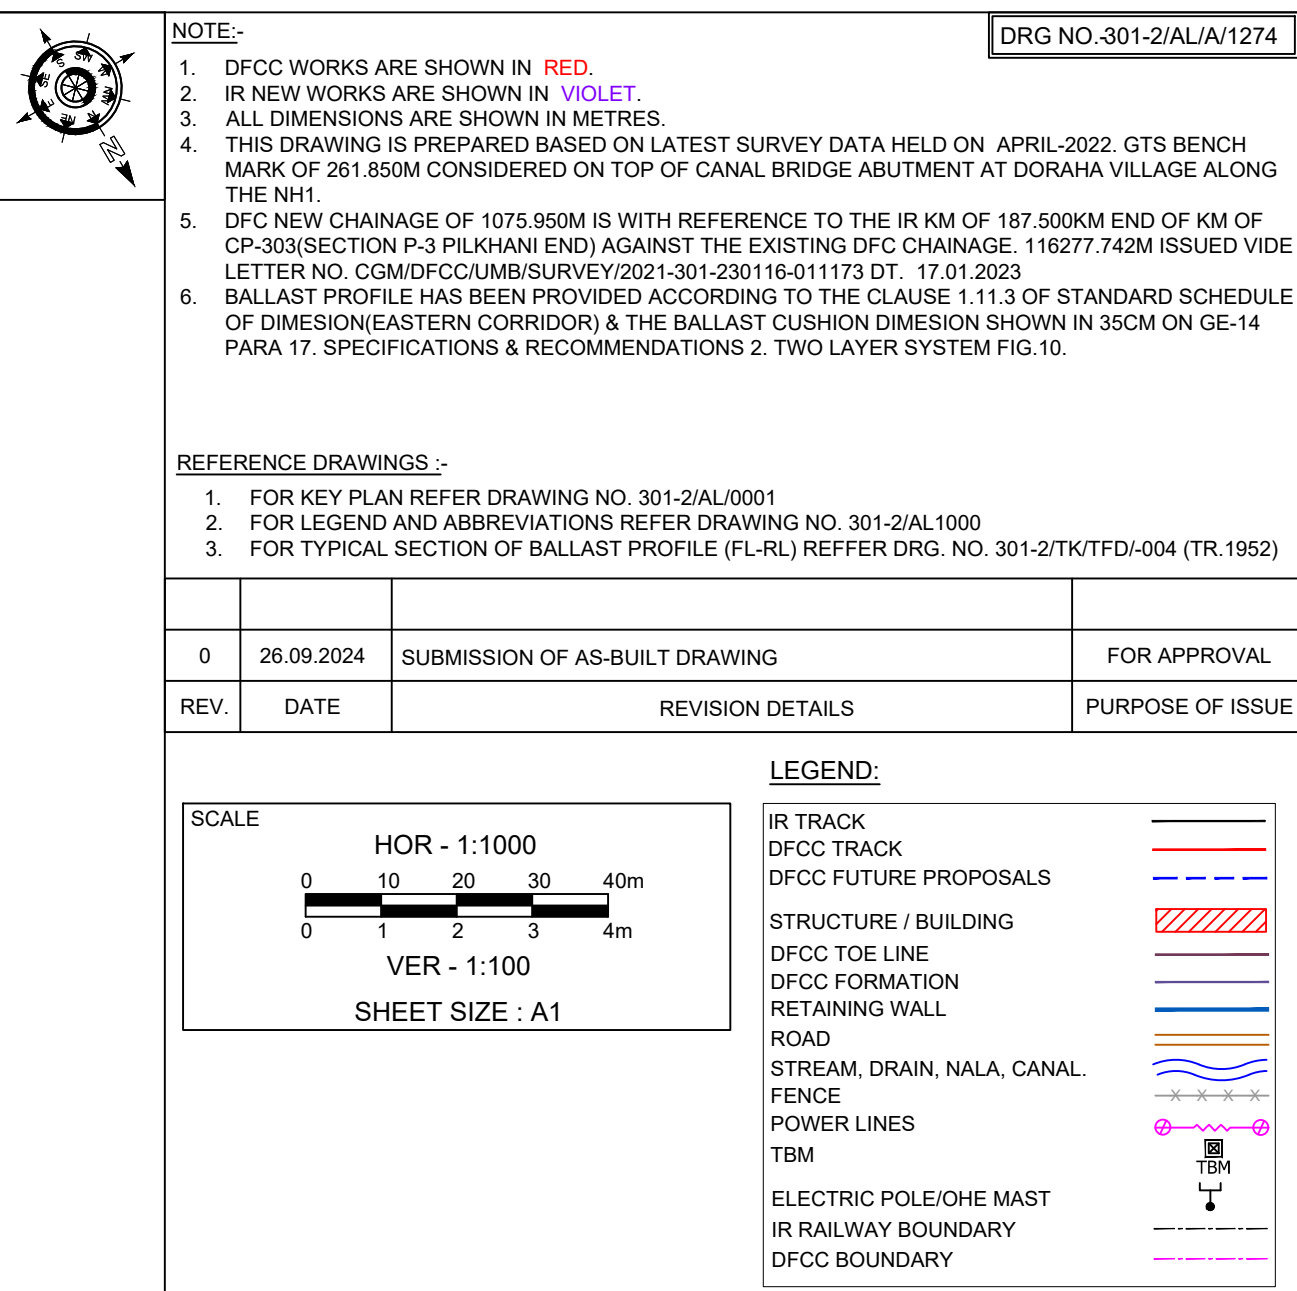

TRACK STRUCTURE		
RAIL SECTION: 60Kg/m (UIC 60Kg/m) DFC LINE: 60Kg/m (UIC 60Kg/m) IR MAIN LINE: 52Kg/m	Difference between FL - RL (Below Rail Seat)	
	IR Line	DFC
	172mm	172mm
RUBBER PAD	6mm	10mm
SLEEPER DEPTH	210mm	210mm
BALLAST CUSHION	300mm	350mm
Total Depth (FL TO RL)	688mm	742mm

ENGINEER:

 DB Engineering &
Consulting GmbH
Deutsche Bahn Engineering & Consulting GmbH


SUBMITTED BY	GIL - TPL JV		
	DATED	NAME	SIGNATURE
PREPARED BY			
CHECKED BY	26.09.2024	VIJAY PRATAP	
APPROVED BY	26.09.2024	PARASURAM KOTYADA	

APPROVED BY	DEUTSCHE BAHN ENGINEERING & CONSULTING GMBH		
	DATED	NAME	SIGNATURE
Sr. DE./CHIEF ENGINEER		SURESH K.YALANGI	
CHIEF TRACK ENGINEER		RAJ PAL SINGH	
T.L.		H.D. VIDJAK	

STAMP	A AS-BUILT DRAWING TR. Ref.:..... ENGINEER Sign.:
-------	---

EMPLOYER (DFCCIL):	DEDICATED FREIGHT CORRIDOR CORPORATION OF INDIA LTD.
--------------------	--

AS BUILT DRAWING		D FCC APPR. NO. -	
		ENG. APPR. NO. -	
TITLE AS-BUILT PLAN AND PROFILE FROM IR KM: 324.000 TO 324.500 DFC KM:1214.880 TO 1215.381		DRG. NO. -301-2/AL/A/1274	
		SHEET NO. : 1 OF 1 DATE : 26.09.2024	
		STATUS	
		A	

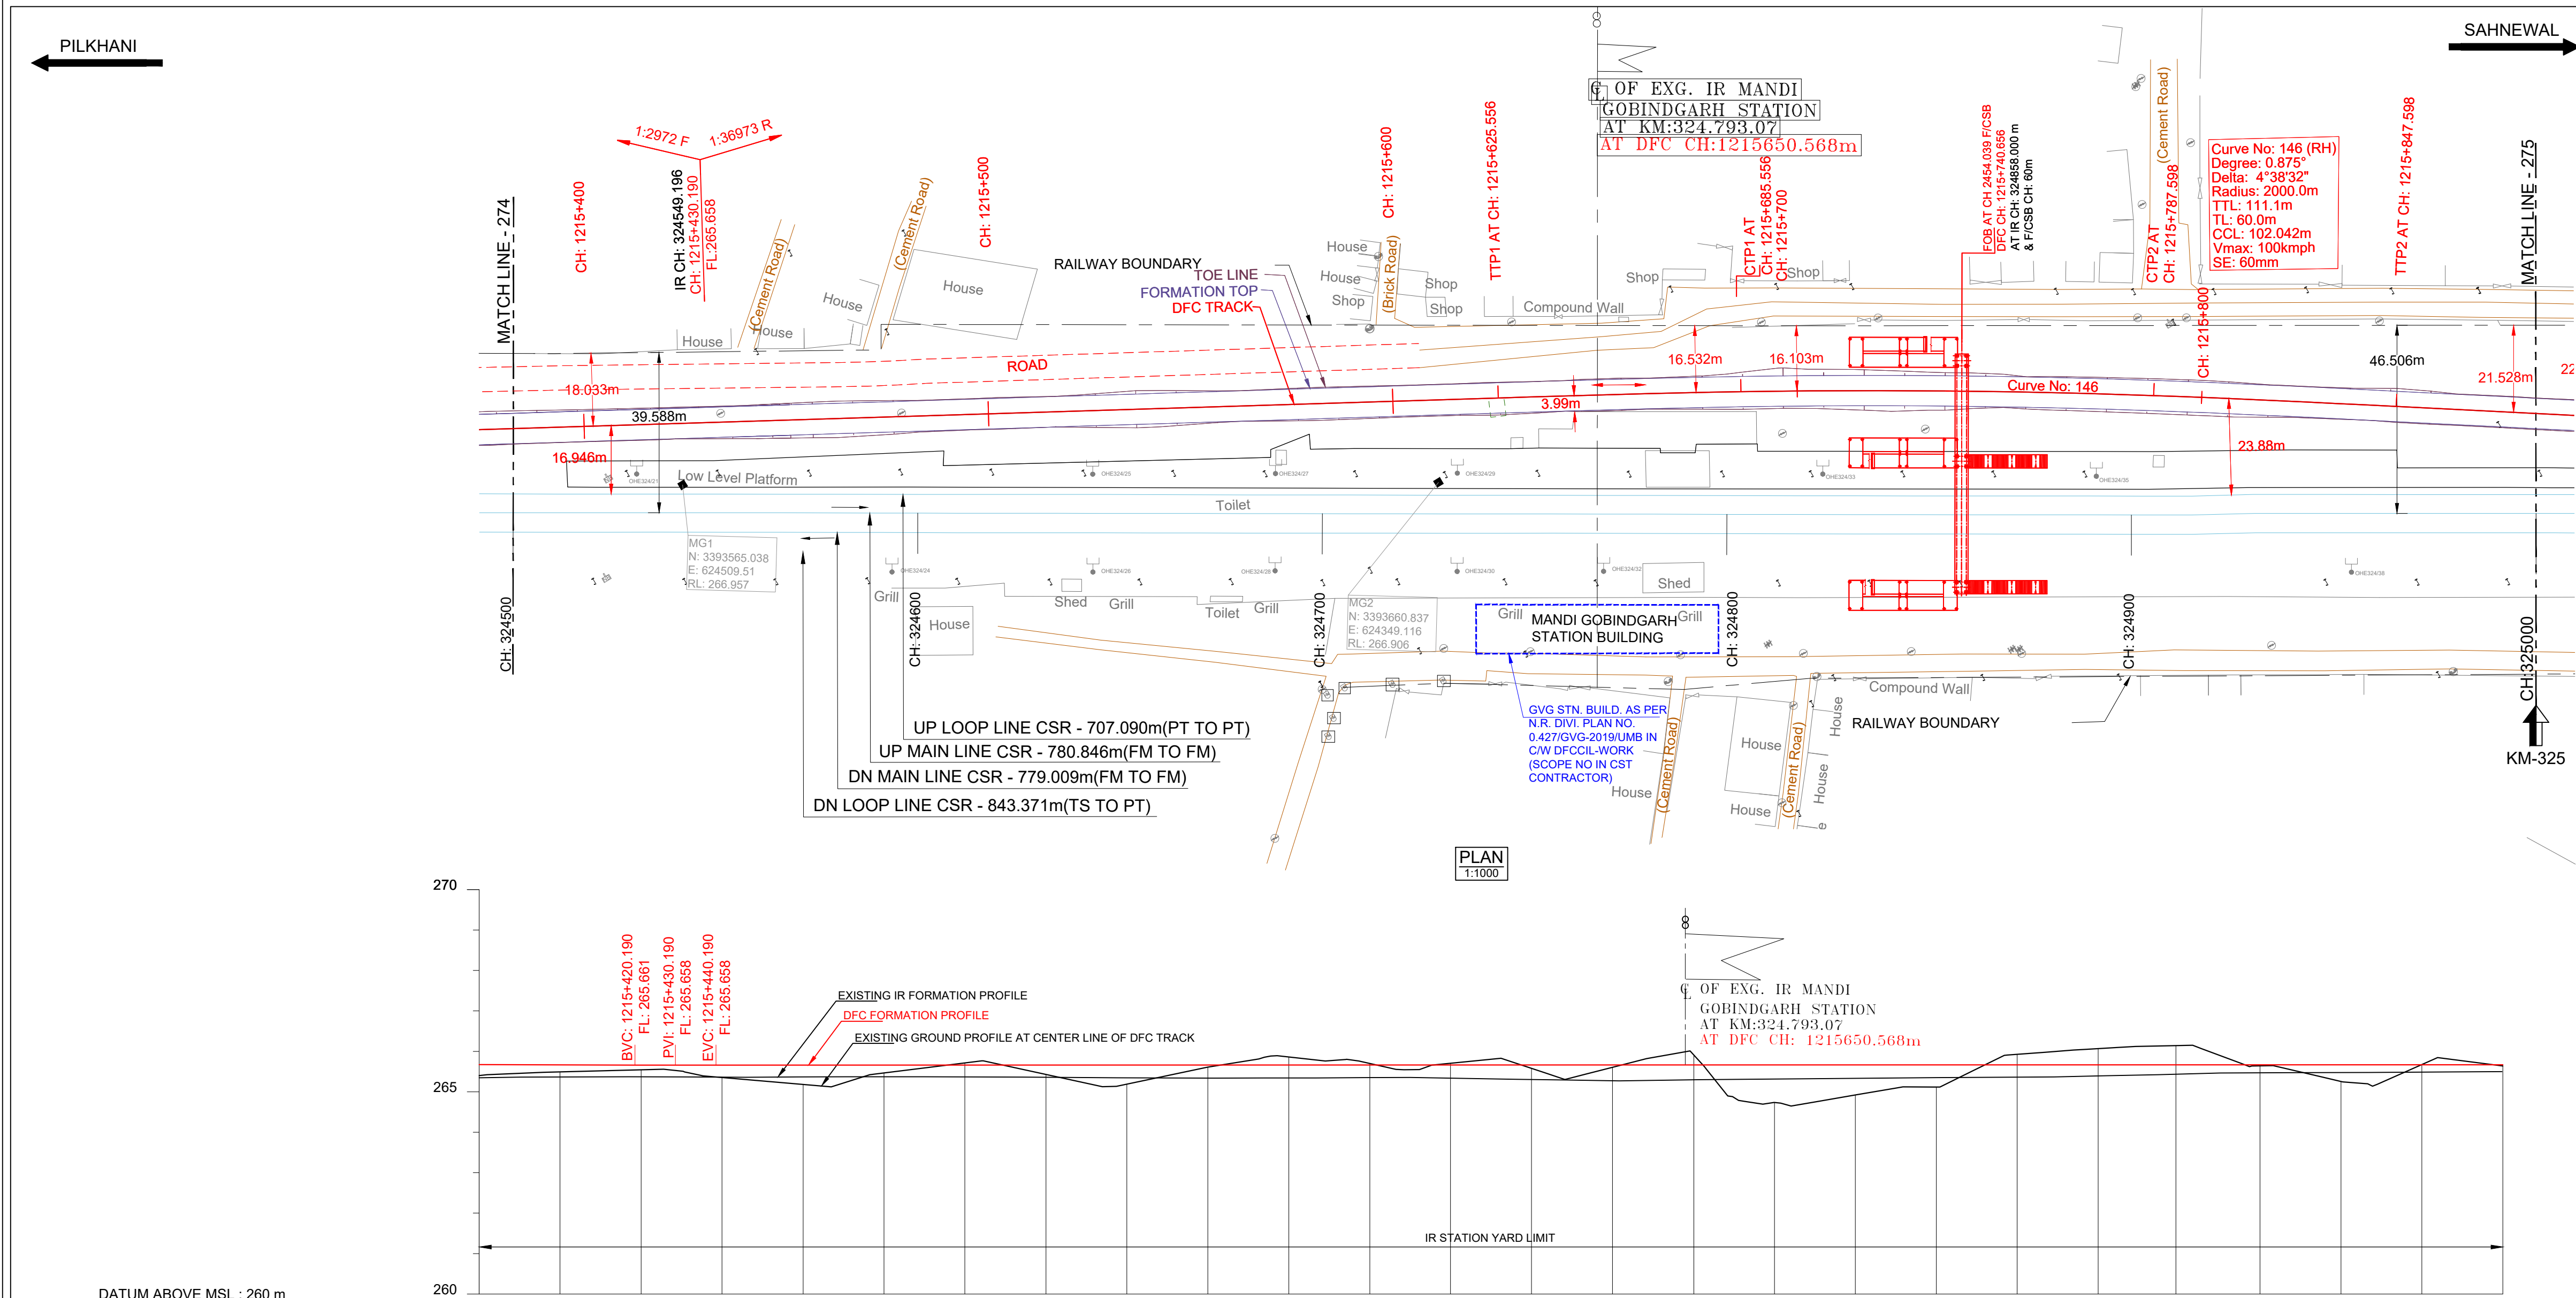


DATUM ABOVE MSL : 260 m

HORIZONTAL ALIGNMENT	L = 573.006m																									TL= 60m																									R =2000m																									TL= 60m																									L = 147.630m																																																																																																																																																																																																																																																																																																																																																																																																																																																																																																																																																																																																																																																																																																																																																																																																																																																																																																																																																																																																																																																																																																																																																																																																																																																																																																																																																																																																																																																																																																																																																																																																																																																																																																																																																																																																																																																																																																																																																																																																																																																																																																																																																																																																																																																																																																																																																																																																																																																																																																																																																																																																																																																																																																																																																																																																																																																																																																																																																																																																																																																																																																																																																																																																																																																																																																																																																																																																																																																																																																																																																																																																																																																																																																																																																																																																																																																																																																																																																																																																																																																																																																																																																																																																																	
VERTICAL ALIGNMENT	L=1549.010 m 1 IN 2971.880 F L=20.0 m R=55020 m L=1480.354 m 1 IN 36972.745 R																																																																																																																																																																																																																																																																																																																																																																																																																																																																																																																																																																																																																																																																																																																																																																																																																																																																																																																																																																																																																																																																																																																																																																																																																																																																																																																																																																																																																																																																																																																																																																																																																																																																																																																																																																																																																																																																																																																																																																																																																																																																																																																																																																																																																																																																																																																																																																																																																																																																																																																																																																																																																																																																																																																																																																																																																																																																																																																																																																																																																																																																																																																																																																																																																																																																																																																																																																																																																																																																																																																																																																																																																																																																																																																																																																																																																																																																																																																																																																																																																																																																																																																																																																																																																																																																																																																					
TRACK DISTANCE FROM EXISTING NEAREST IR UP MAIN LINE TO DFC MAIN LINE	20.806																									21.430																									22.040																									22.681																									23.349																									24.019																									24.657																									25.293																									25.957																									26.593																									27.252																									27.920																									28.568																									29.193																									29.771																									30.277																									30.574																									30.664																									30.546																									30.219																									29.698																									28.891																									27.689																									26.719																									25.719																									24.715																																																																																																																																																																																																																																																																																																																																																																																																																																																																																																																																																																																																																																																																																																																																																																																																																																																																																																																																																																																																																																																																																																																																																																																																																																																																																																																																																																																																																																																																																																																																																																																																																																																																																																																																																																																																																																																																																																																																																																																																																																																																																																																																																																																																																																																																																																																																																																																																																																																																																																																																																																																																																																																																																																																																																																																																																																																																																																																																																																																																																																																																																																																																																																																																																																																																																																																																																																																																																																																																																																																																																																																																																																																																				
HEIGHT OF BANKING(+) / DEPTH OF CUTTING(-) (PFL-GL)	+0.271																									+0.175																									+0.116																									+0.303																									+0.477																									+0.191																									-0.054																									+0.232																									+0.472																									+0.050																									-0.198																									-0.037																									-0.043																									+0.085																									+0.057																									-0.245																									+0.929																									+0.744																									+0.549																									-0.259																									-0.399																									-0.473																									+0.026																									+0.415																									-0.004																									+0.033																																																																																																																																																																																																																																																																																																																																																																																																																																																																																																																																																																																																																																																																																																																																																																																																																																																																																																																																																																																																																																																																																																																																																																																																																																																																																																																																																																																																																																																																																																																																																																																																																																																																																																																																																																																																																																																																																																																																																																																																																																																																																																																																																																																																																																																																																																																																																																																																																																																																																																																																																																																																																																																																																																																																																																																																																																																																																																																																																																																																																																																																																																																																																																																																																																																																																																																																																																																																																																																																																																																																																																																																																																																																				
EXG GROUND LEVEL AT CENTER LINE OF DFC TRACK (GL)	265.403																									265.492																									265.545																									265.355																									265.182																									265.468																									265.714																									265.428																									265.189																									265.611																									265.860																									265.699																									265.706																									265.582																									265.607																									265.909																									264.736																									264.922																									265.117																									265.926																									266.066																									266.141																									265.642																									265.254																									265.673																									265.637																																																																																																																																																																																																																																																																																																																																																																																																																																																																																																																																																																																																																																																																																																																																																																																																																																																																																																																																																																																																																																																																																																																																																																																																																																																																																																																																																																																																																																																																																																																																																																																																																																																																																																																																																																																																																																																																																																																																																																																																																																																																																																																																																																																																																																																																																																																																																																																																																																																																																																																																																																																																																																																																																																																																																																																																																																																																																																																																																																																																																																																																																																																																																																																																																																																																																																																																																																																																																																																																																																																																																																																																																																																																				
EXG GROUND LEVEL AT TOE LOCATION OF DFC TRACK	265.252																									265.376																									265.421																									265.440																									265.275																									265.497																									265.737																									265.443																									265.206																									265.586																									265.775																									265.632																									265.606																									265.238																									264.777																									264.968																									265.167																									265.915																									265.632																									265.226																									265.621																									265.598																																																																																																																																																																																																																																																																																																																																																																																																																																																																																																																																																																																																																																																																																																																																																																																																																																																																																																																																																																																																																																																																																																																																																																																																																																																																																																																																																																																																																																																																																																																																																																																																																																																																																																																																																																																																																																																																																																																																																																																																																																																																																																																																																																																																																																																																																																																																																																																																																																																																																																																																																																																																																																																																																																																																																																																																																																																																																																																																																																																																																																																																																																																																																																																																																																																																																																																																																																																																																																																																																																																																																																																																																																																																																																																																																																								
DIFFERENCE BETWEEN DFC FORMATION LEVEL AND EXG.FORMATION LEVEL (PFL-EFL)	0.326																									0.301																									0.288																									0.295																									0.290																									0.286																									0.291																									0.302																									0.315																									0.322																									0.321																									0.312																									0.326																									0.360																									0.390																									0.367																									0.349																									0.332																									0.332																									0.314																									0.305																									0.277																									0.230																									0.200																									0.194																									0.184																									0.170																																																																																																																																																																																																																																																																																																																																																																																																																																																																																																																																																																																																																																																																																																																																																																																																																																																																																																																																																																																																																																																																																																																																																																																																																																																																																																																																																																																																																																																																																																																																																																																																																																																																																																																																																																																																																																																																																																																																																																																																																																																																																																																																																																																																																																																																																																																																																																																																																																																																																																																																																																																																																																																																																																																																																																																																																																																																																																																																																																																																																																																																																																																																																																																																																																																																																																																																																																																																																																																																																																																																																																																																																																											
DFC FORMATION LEVEL (PFL)	265.674																									265.687																									265.681																									265.658																									265.659																									265.659																									265.680																									265.680																									265.681																									265.682																									265.683																									265.663																									265.664																									265.664																									265.665																									265.666																									265.666																									265.667																									265.667																									265.668																									265.668																									265.669																									265.669																									265.670																																																																																																																																																																																																																																																																																																																																																																																																																																																																																																																																																																																																																																																																																																																																																																																																																																																																																																																																																																																																																																																																																																																																																																																																																																																																																																																																																																																																																																																																																																																																																																																																																																																																																																																																																																																																																																																																																																																																																																																																																																																																																																																																																																																																																																																																																																																																																																																																																																																																																																																																																																																																																																																																																																																																																																																																																																																																																																																																																																																																																																																																																																																																																																																																																																																																																																																																																																																																																																																																																																																																																																																																																																																																																																																						
EXG. FORMATION LEVEL OF EXG IR UP MAIN LINE (EFL)	265.348																									265.367																									265.372																									265.363																									265.368																									265.373																									265.368																									265.358																									265.346																									265.339																									265.341																									265.350																									265.337																									265.298																									265.316																									265.334																									265.352																									265.362																									265.390																									265.438																									265.469																									265.475																									265.486																									265.499																																																																																																																																																																																																																																																																																																																																																																																																																																																																																																																																																																																																																																																																																																																																																																																																																																																																																																																																																																																																																																																																																																																																																																																																																																																																																																																																																																																																																																																																																																																																																																																																																																																																																																																																																																																																																																																																																																																																																																																																																																																																																																																																																																																																																																																																																																																																																																																																																																																																																																																																																																																																																																																																																																																																																																																																																																																																																																																																																																																																																																																																																																																																																																																																																																																																																																																																																																																																																																																																																																																																																																																																																																																																																																																						
DIFFERENCE BETWEEN DFC RAIL LEVEL AND EXG. RAIL LEVEL (PRL - ERL)	0.367																									0.342																									0.330																									0.336																									0.332																									0.327																									0.333																									0.343																									0.356																									0.364																									0.362																									0.354																									0.368																									0.401																									0.431																									0.408																									0.390																									0.373																									0.355																									0.346																									0.318																									0.271																									0.241																									0.236																									0.225																									0.212																																																																																																																																																																																																																																																																																																																																																																																																																																																																																																																																																																																																																																																																																																																																																																																																																																																																																																																																																																																																																																																																																																																																																																																																																																																																																																																																																																																																																																																																																																																																																																																																																																																																																																																																																																																																																																																																																																																																																																																																																																																																																																																																																																																																																																																																																																																																																																																																																																																																																																																																																																																																																																																																																																																																																																																																																																																																																																																																																																																																																																																																																																																																																																																																																																																																																																																																																																																																																																																																																																																																																																																																																																																																				
DFC RAIL LEVEL (PRL)	266.387																									266.381																									266.374																									266.371																									266.372																									266.372																									266.373																									266.373																									266.374																									266.375																									266.376																									266.376																									266.377																									266.377																									266.378																									266.378																									266.379																									266.379																									266.380																									266.381																									266.381																									266.382																									266.382																									266.383																									266.383																																																																																																																																																																																																																																																																																																																																																																																																																																																																																																																																																																																																																																																																																																																																																																																																																																																																																																																																																																																																																																																																																																																																																																																																																																																																																																																																																																																																																																																																																																																																																																																																																																																																																																																																																																																																																																																																																																																																																																																																																																																																																																																																																																																																																																																																																																																																																																																																																																																																																																																																																																																																																																																																																																																																																																																																																																																																																																																																																																																																																																																																																																																																																																																																																																																																																																																																																																																																																																																																																																																																																																																																																																																																																													
EXG.RAIL LEVEL OF NEAREST IR UP MAIN LINE(ERL)	266.020																									266.039																									266.044																									266.035																									266.040																									266.045																									266.040																									266.030																									266.018																									266.011																									266.013																									266.022																									266.009																									266.016																									266.016																									
L - SECTION

SAHNEWAL

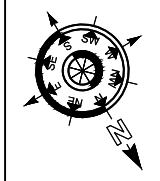

- NOTE:-
- DFCC WORKS ARE SHOWN IN RED.
 - IR NEW WORKS ARE SHOWN IN VIOLET.
 - ALL DIMENSIONS ARE SHOWN IN METRES.
 - THIS DRAWING IS PREPARED BASED ON LATEST SURVEY DATA HELD ON APRIL-2022. GTS BENCH MARK OF 261.850M CONSIDERED ON TOP OF CANAL BRIDGE ABUTMENT AT DORHA VILLAGE ALONG THE NH1.
 - DFC NEW CHAINAGE OF 1075.950M IS WITH REFERENCE TO THE IR KM OF 187.500KM END OF KM OF CP-303(SECTION P-3 PILKHANI END) AGAINST THE EXISTING DFC CHAINAGE. 116277.742M ISSUED VIDE LETTER NO. COM/DFCC/UM/SURVEY/2021-301-230116-011173 DT. 17.01.2023.
 - BALLAST PROFILE HAS BEEN PROVIDED ACCORDING TO THE CLAUSE 1.11.3 OF STANDARD SCHEDULE OF DIMENSION(EASTERN CORRIDOR) & THE BALLAST CUSHION DIMENSION SHOWN IN 35CM ON GE-14 PARA 17. SPECIFICATIONS & RECOMMENDATIONS 2. TWO LAYER SYSTEM FIG.10.

REFERENCE DRAWINGS:-


- FOR KEY PLAN REFER DRAWING NO. 301-2/AL/0001
- FOR LEGEND AND ABBREVIATIONS REFER DRAWING NO. 301-2/AL/1000
- FOR TYPICAL SECTION OF BALLAST PROFILE (FL-RL) REFER DRG. NO. 301-2/TK/TFDI-004 (TR.1952)

REV.	DATE	SUBMISSION OF AS-BUILT DRAWING	FOR APPROVAL
0	26.09.2024	SUBMISSION OF AS-BUILT DRAWING	FOR APPROVAL

LEGEND:

IR TRACK
DFCC TRACK
DFCC FUTURE PROPOSALS
STRUCTURE / BUILDING
DFCC TOE LINE
DFCC FORMATION
RETAINING WALL
ROAD
STREAM, DRAIN, NALA, CANAL.
FENCE
POWER LINES
TBM
ELECTRIC POLE/OHE MAST
IR RAILWAY BOUNDARY
DFCC BOUNDARY

SCALE
HOR - 1:1000
VER - 1:100
SHEET SIZE : A1

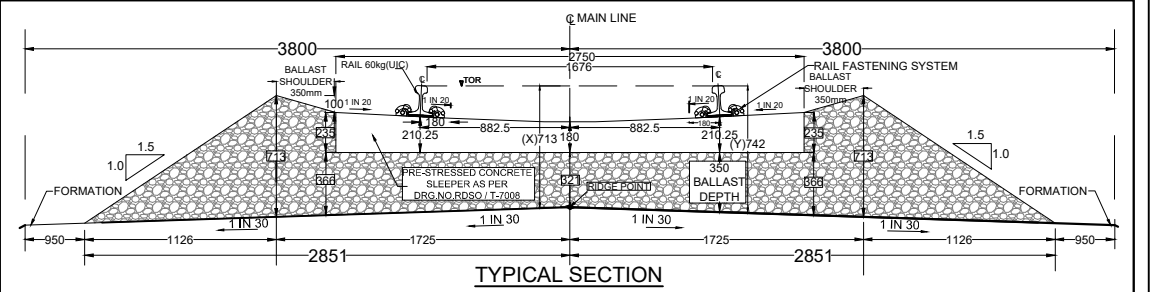

TRACK STRUCTURE		
RAIL SECTION: 60Kg/m (UIC 60Kg/m) DFC LINE: 60Kg/m (UIC 60Kg/m) IR MAIN LINE: 52Kg/m	Difference between FL- RL (Below Rail Seat)	
	IR Line	DFC
RUBBER PAD	172mm	172mm
SLEEPER DEPTH	210mm	210mm
BALLAST CUSHION	300mm	350mm
Total Depth (FL TO RL)	688mm	742mm

OWNER
DEDICATED FREIGHT CORRIDOR CORPORATION OF INDIA LTD.
(A GOVERNMENT OF INDIA ENTERPRISE)
PROJECT OFFICE(AMBALA UNIT): OLD RAILWAY COLONY (NEAR ANAND MARKET),AMBALA CANTT-133001.
CORPORATE IDENTITY NO. : U60232DL2006GGI155068

ENGINEER:
DB Engineering & Consulting GmbH
Deutsche Bahn Engineering & Consulting GmbH

CONTRACTOR:
GIL - TPL JV
GAR TATA


SUBMITTED BY	GIL - TPL JV		
	DATED	NAME	SIGNATURE
PREPARED BY	26.09.2024	VIJAY PRATAP	
CHECKED BY	26.09.2024	PARASURAM KOTYADA	
APPROVED BY	26.09.2024	PARASURAM KOTYADA	

APPROVED BY	DEUTSCHE BAHN ENGINEERING & CONSULTING GMBH		
	DATED	NAME	SIGNATURE
Sr. DE./CHIEF ENGINEER		SURESH K.YALANGI	
CHIEF TRACK ENGINEER		RAJ PAL SINGH	
T.L.		H.D. VIDJAK	

STAMP	A AS-BUILT DRAWING TR. Ref.:..... ENGINEER Sign.:.....		
EMPLOYER (DFCCIL):	DEDICATED FREIGHT CORRIDOR CORPORATION OF INDIA LTD.		

AS BUILT DRAWING			
TITLE	AS-BUILT PLAN AND PROFILE	DFCC APPR. NO. -	
	FROM IR KM: 324.500 TO 325.000	ENGG. APPR. NO. -	
	DFC KM:1215.381 TO 1215.881	DRG. NO. -301-2/AL/A/1275	
		SHEET NO. : 1 OF 1	STATUS
		DATE : 26.09.2024	A

TR.

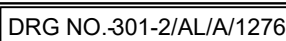

- REFERENCE DRAWINGS :-**
1. FOR KEY PLAN REFER DRAWING NO. 301-2/AL/0001
 2. FOR LEGEND AND ABBREVIATIONS REFER DRAWING NO. 301-2/AL/1000
 3. FOR TYPICAL SECTION OF BALLAST PROFILE (FL-RL) REFER DRG. NO. 301-2/TK/TFD/004 (TR.1952)

SCALE


HOR - 1:1000

VER - 1:100

SHEET SIZE : A1

LEGEND

IR TRACK	
DFCC TRACK	
DFCC FUTURE PROPOSALS	
STRUCTURE / BUILDING	
DFCC TOE LINE	
DFCC FORMATION	
RETAINING WALL	
ROAD	
STREAM, DRAIN, NALA, CANAL	
FENCE	
POWER LINES	
TBM	
ELECTRIC POLE/OHE MAST	
IR RAILWAY BOUNDARY	
DFCC BOUNDARY	

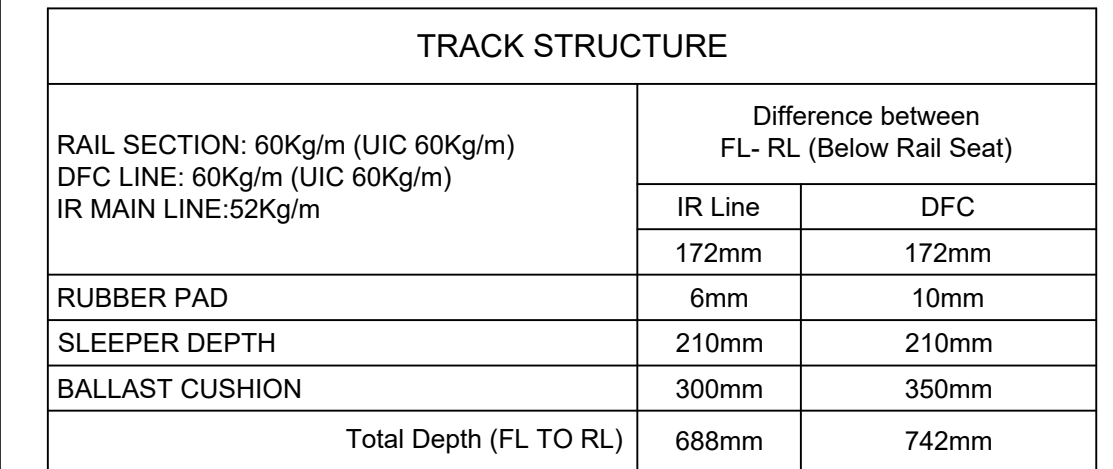

ENGINEER:

 **DB Engineering & Consulting GmbH**
Deutsche Bahn Engineering & Consulting GmbH

SUBMITTED BY	GIL - TPL JV		
	DATED	NAME	SIGNATURE
PREPARED BY			
CHECKED BY	26.09.2024	VIJAY PRATAP	
APPROVED BY	26.09.2024	PARASURAM KOTYADA	

[illegible]

EMPLOYER (DFCCIL):	DEDICATED FREIGHT CORRIDOR CORPORATION OF INDIA LTD		

--	--	--	--

--	--	--	--

--	--	--	--

--	--	--	--

AS BUILT DRAWING


TITLE	DFCC APPR. NO. -
-------	------------------

AS-BUILT PLAN AND PROFILE	ENGG. APPR. NO. -
	DES. NO. - 221 C/A/ (A) 1070


FROM IR KM: 325.000 TO 325.500
DEC KM:1215.881 TO 1216.382

	DATE : 26.09.2024	A
--	-------------------	---

TR.

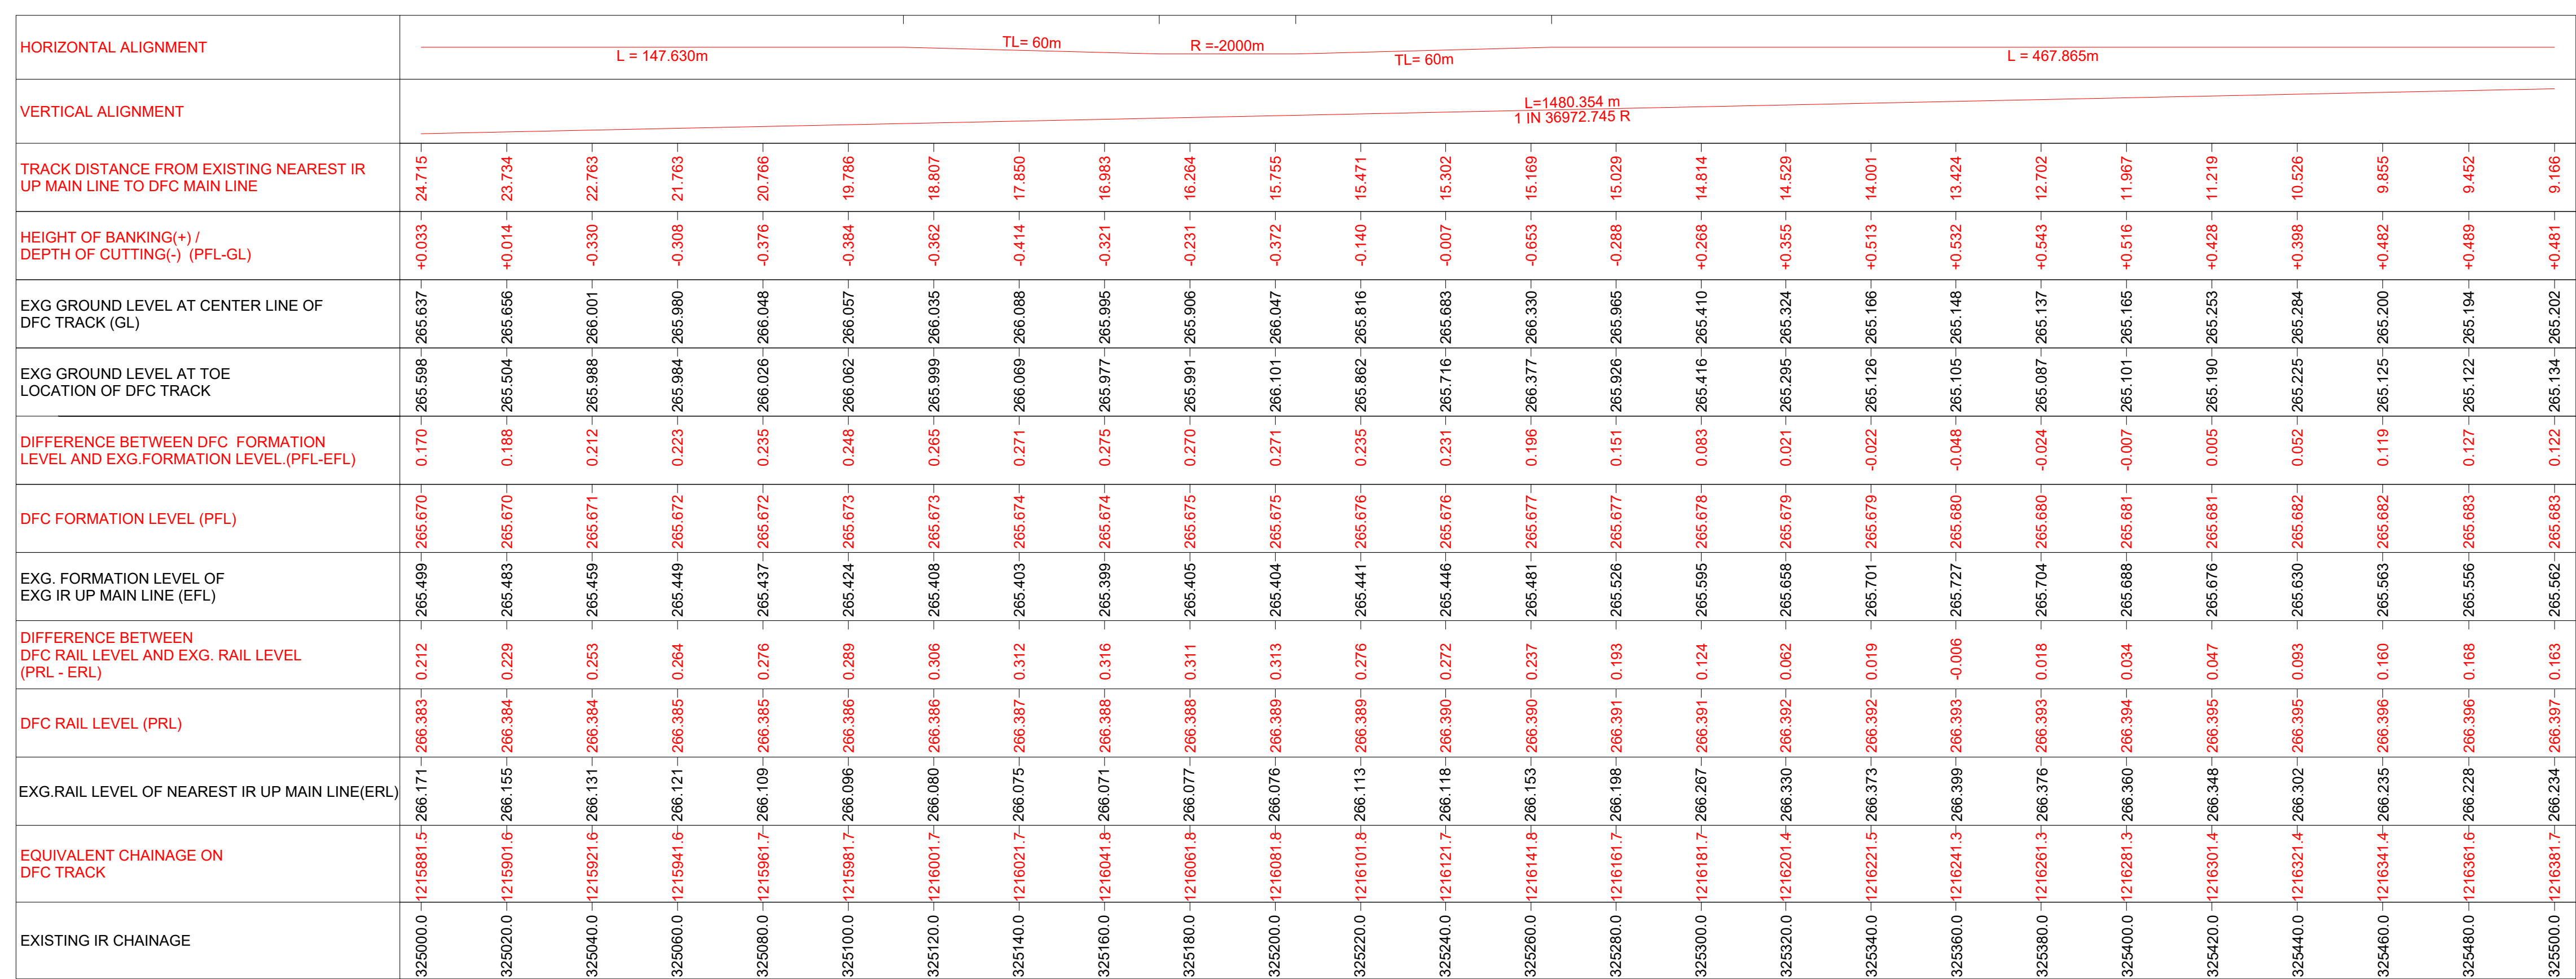

TR

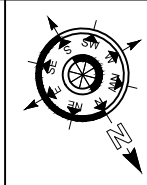

NOTE:-

1. DFCO WORKS ARE SHOWN IN RED.
2. IR NEW WORKS ARE SHOWN IN VIOLET.
3. ALL DIMENSIONS ARE SHOWN IN METRES.
4. THIS DRAWING IS PREPARED BASED ON LATEST SURVEY DATA HELD ON APRIL 2024. ITS BENCH MARK OF 261.850M CONSIDERED ON TOP OF CANAL BRIDGE ABUTMENT AT DORAJA VILLAGE.
5. THE NEW OFFICE CHANGE OF 1075.950M IS WITH REFERENCE TO THE IR KM OF 1827.722M END OF KM OF DORAJA PONTON. PONTON PILE NO. 1075.950M IS WITH REFERENCE TO THE IR KM OF 1827.742M ISSUED VIDE DFCO NO. CGM/DFCC/CM/ISSUED/2021-301236-1161173.DTD. 17. 01. 2023.
6. BALLAST PROFILE HAS BEEN PROVIDED ACCORDING TO THE CLAUSE 111.3 OF STANDARD SCHEDULE OF MATERIALS AND SPECIFICATIONS OF IR. BALLAST CUSHION DIMENSION IS 55CM ON GE-14
7. BALLAST SPECIFICATIONS ARE RECOMMENDED 2. TWO LAYER SYSTEM FIG. 10.

REFERENCE DRAWINGS :-

1. FOR KEY PLAN REFER DRAWING NO. 301-2/AL/0001
2. FOR LEGEND AND ABBREVIATIONS REFER DRAWING NO. 301-2/AL1000
3. FOR TYPICAL SECTION OF BALLAST PROFILE (FL-RL) REFFER DRG. NO. 301-2/TK/TFD/-004 (TR.1952)

SCALE


HOR - 1:1000

VER - 1:100

SHEET SIZE : A1

LEGEND:

IR TRACK DFCC TRACK DFCC FUTURE PROPOSALS STRUCTURE / BUILDING DFCC TOE LINE DFCC FORMATION RETAINING WALL ROAD STREAM, DRAIN, NALA, CANAL. FENCE POWER LINES TBM ELECTRIC POLE/OHE MAST IR RAILWAY BOUNDARY DFCC BOUNDARY	
---	--

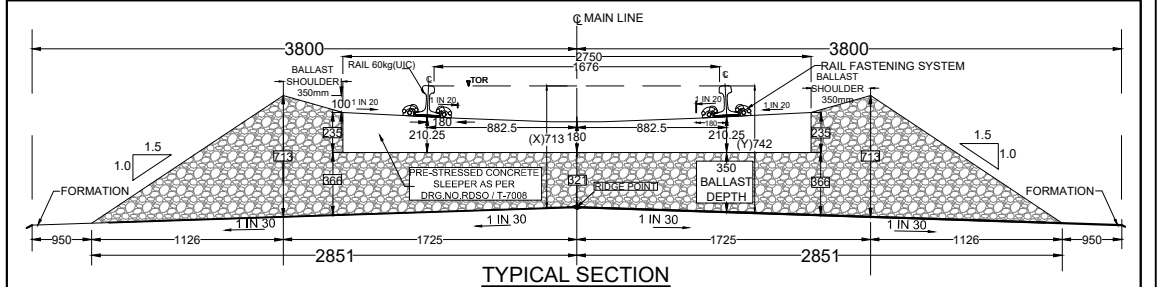

TRACK STRUCTURE		
RAIL SECTION: 60Kg/m (UIC 60Kg/m) DFC LINE: 60Kg/m (UIC 60Kg/m) IR MAIN LINE: 52Kg/m	Difference between FL- RL (Below Rail Seat)	
	IR Line	DFC
	172mm	172mm
RUBBER PAD	6mm	10mm
SLEEPER DEPTH	210mm	210mm
BALLAST CUSHION	300mm	350mm
Total Depth (FL TO RL)	688mm	742mm

OWNER	DEDICATED FREIGHT CORRIDOR CORPORATION OF INDIA LTD.
-------	--



DEDICATED FREIGHT CORRIDOR CORPORATION OF INDIA LTD.
(A GOVERNMENT OF INDIA ENTERPRISE)
PROJECT OFFICE(AMBALA UNIT): OLD RAILWAY COLONY (NEAR
ANAND MARKET),AMBALA CANTT-133001.
CORPORATE IDENTITY NO. : U60232DL2006GOI155068

ENGINEER:



DB Engineering & Consulting GmbH
Deutsche Bahn Engineering & Consulting GmbH

CONTRACTOR:

CH TRL IV

CONTRACTOR: GIL - TPL JV

SUBMITTED BY		GIL - TPL JV	
	DATED	NAME	SIGNATURE
PREPARED BY			
CHECKED BY	26.09.2024	VIJAY PRATAP	
APPROVED BY	26.09.2024	PARASURAM KOTYADA	
APPROVED BY	DEUTSCHE BAHN ENGINEERING & CONSULTING GMBH		
	DATED	NAME	SIGNATURE
Sr. DE./CHIEF ENGINEER		SURESH K.YALANGI	
CHIEF TRACK ENGINEER		RAJ PAL SINGH	
T.L.		H.D. VIDJAK	

[illegible]

	AS BUILT DRAWING
--	------------------

STAMP	A AS-BUILT DRAWING TR. Ref..... ENGINEER Sign.:
-------	--

EMPLOYER (DECOIL):	BERGATED FREIGHT CORRIDOR CORPORATION OF INDIA LTD.

EMPLOYER (DFCCIL):	DEDICATED FREIGHT CORRIDOR CORPORATION OF INDIA LTD.		

--	--	--	--	--

--	--	--	--	--	--

--	--	--	--	--



AS BUILT DRAWING

TITLE		DFCC APPR. NO. -
-------	--	------------------

AS-BUILT PLAN AND PROFILE	ENGG. APPR. NO. -
FROM IR KM: 325.500 TO 326.000	DRG. NO. - 301-2/AL/A/1277

FROM KILOM: 525.500 TO 526.000	SHEET NO.: 1 OF 1	STATUS
DFC KM:1216.381 TO 1216.877		A


		DATE : 26.09.2024	A
			TR.

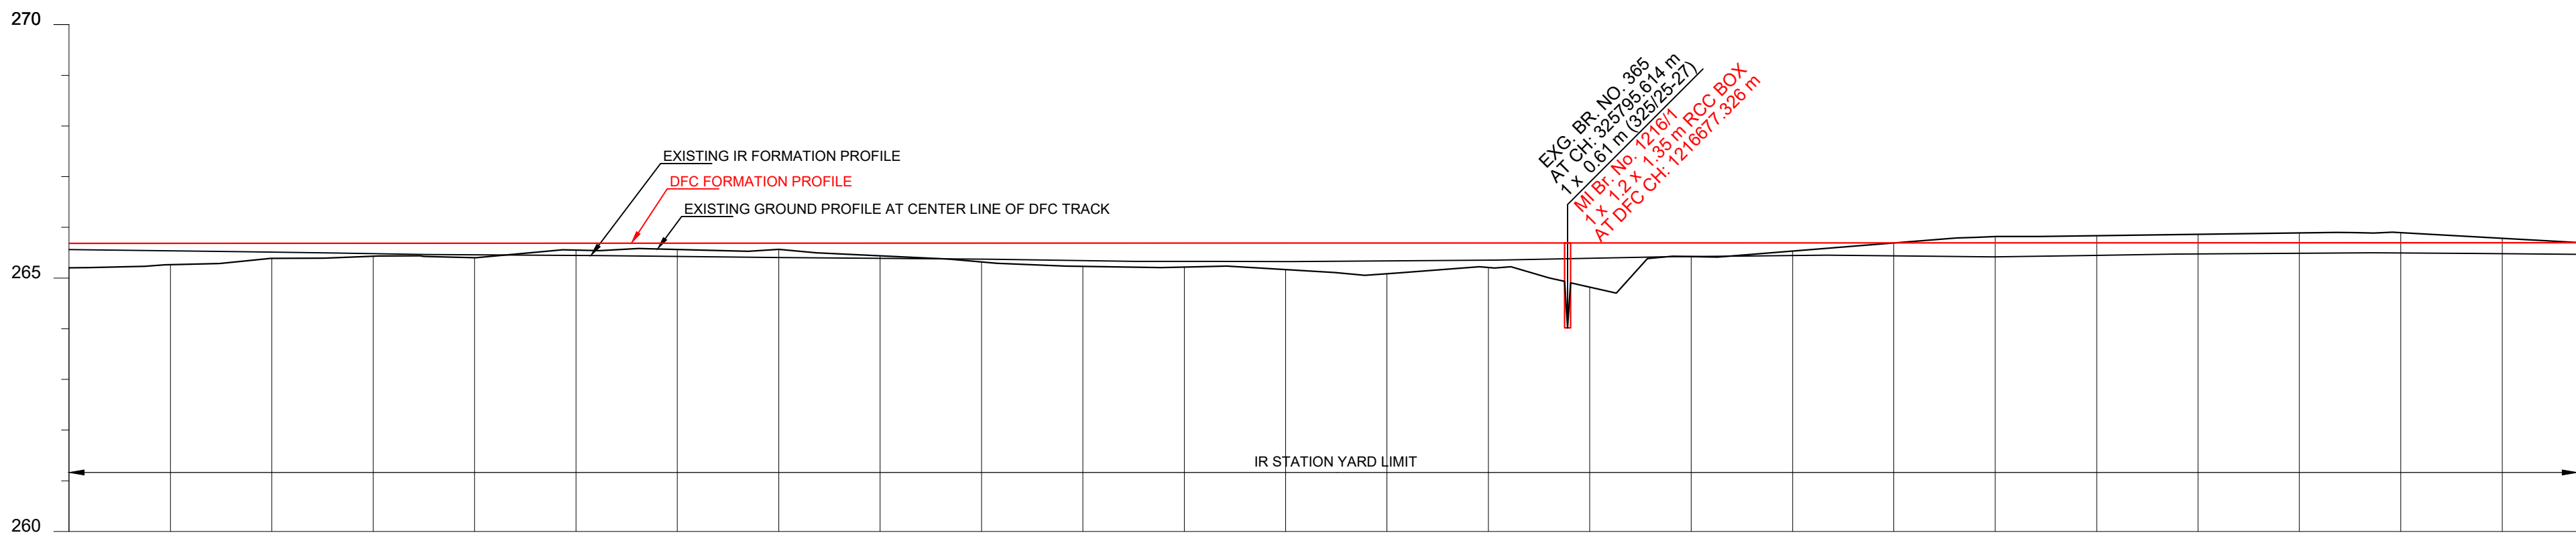
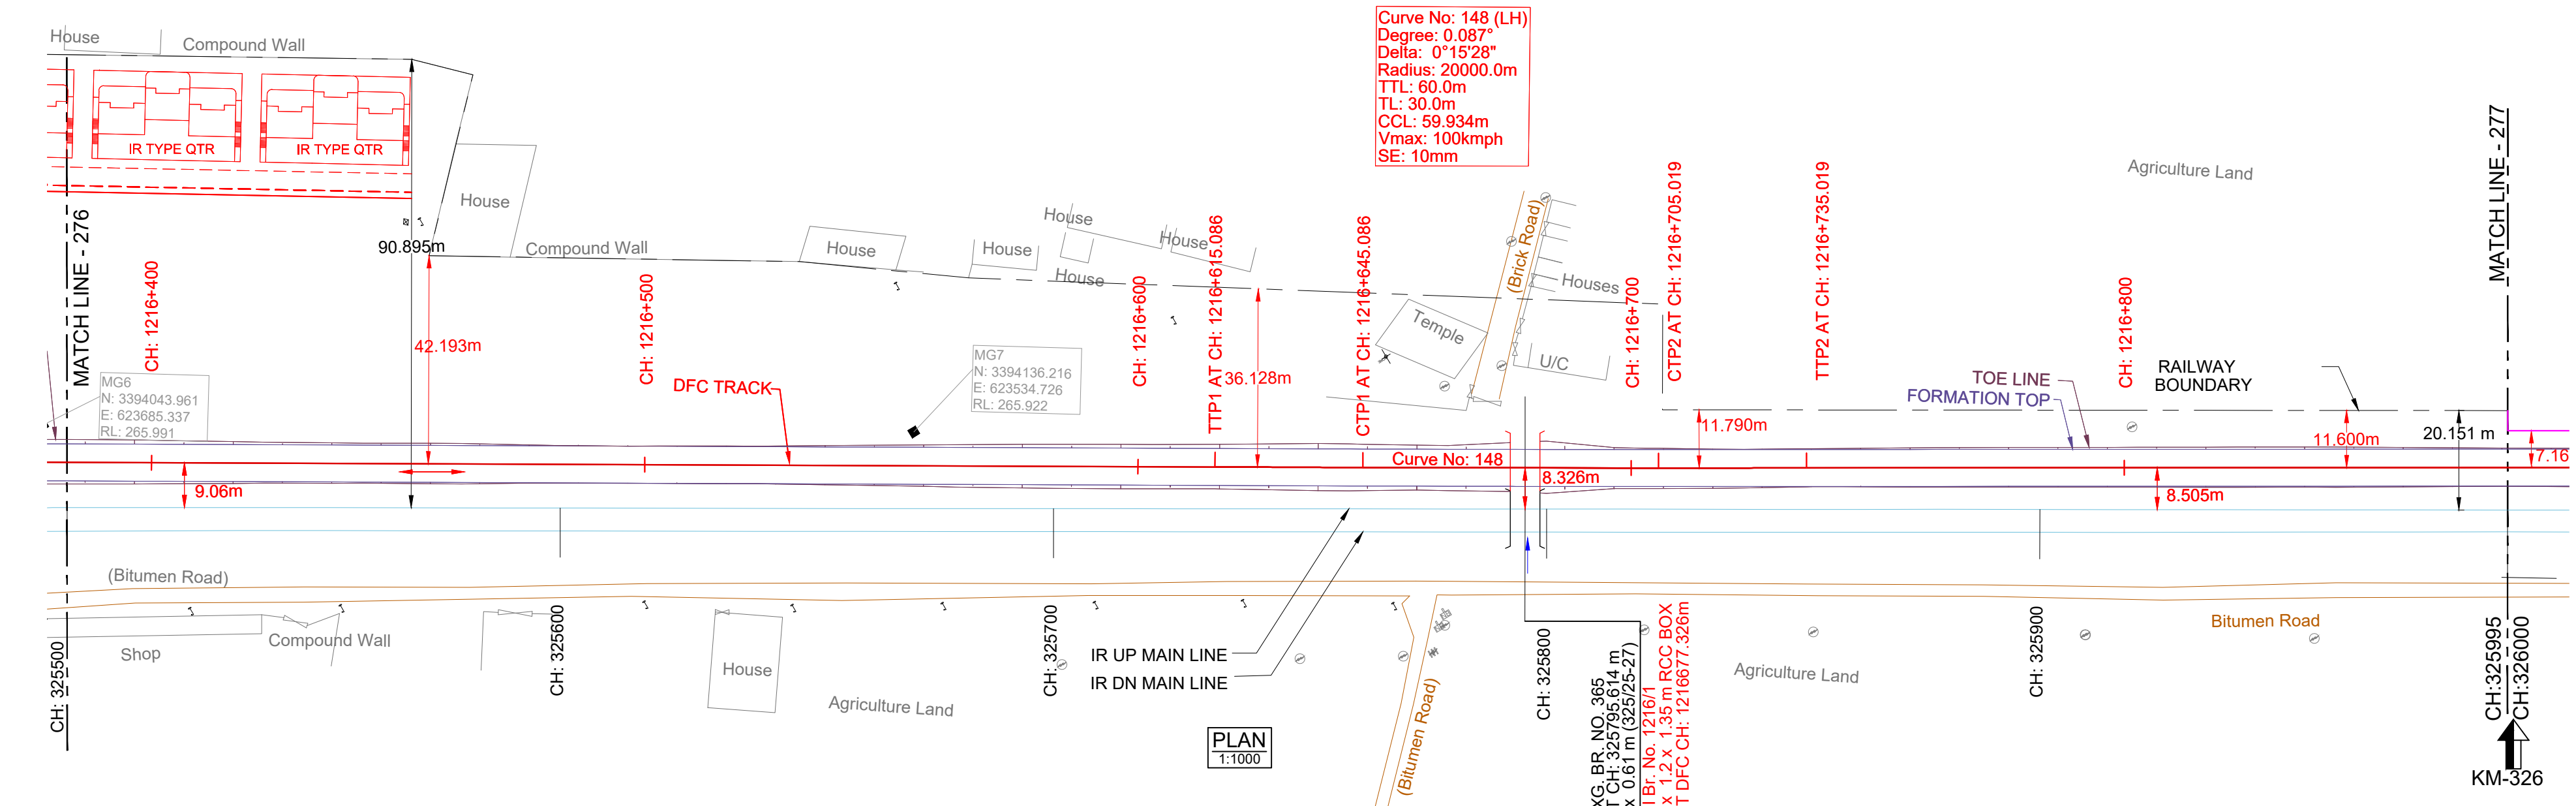


HORIZONTAL ALIGNMENT	L = 467.865m										TL= 30m										R =-20000m										TL= 30m										L = 5592.259m																			
VERTICAL ALIGNMENT	L=1480.354 m 1 IN 36972.745 R																																																											
TRACK DISTANCE FROM EXISTING NEAREST IR UP MAIN LINE TO DFC MAIN LINE	9.166																																																											
HEIGHT OF BANKING(+) / DEPTH OF CUTTING(-) (PFL-GL)	+0.481																																																											
EXG GROUND LEVEL AT CENTER LINE OF DFC TRACK (GL)	265.134 - 265.202																																																											
EXG GROUND LEVEL AT TOE LOCATION OF DFC TRACK	265.108 - 265.261																																																											
DIFFERENCE BETWEEN DFC FORMATION LEVEL AND EXG.FORMATION LEVEL(PFL-EFL)	0.173																																																											
DFC FORMATION LEVEL (PFL)	265.683																																																											
EXG. FORMATION LEVEL OF EXG IR UP MAIN LINE (EFL)	265.538																																																											
DIFFERENCE BETWEEN DFC RAIL LEVEL AND EXG. RAIL LEVEL (PRL - ERL)	0.163																																																											
DFC RAIL LEVEL (PRL)	266.234																																																											
EXG.RAIL LEVEL OF NEAREST IR UP MAIN LINE(ERL)	266.076																																																											
EQUIVALENT CHAINEGE ON DFC TRACK	-1216381.7																																																											
EXISTING IR CHAINEGE	3235500.0																																																											
	3235520.0																																																											
	3235540.0																																																											
	3235560.0																																																											
	3235998.8																																																											
	3236000.0																																																											

L - SECTION

TR.

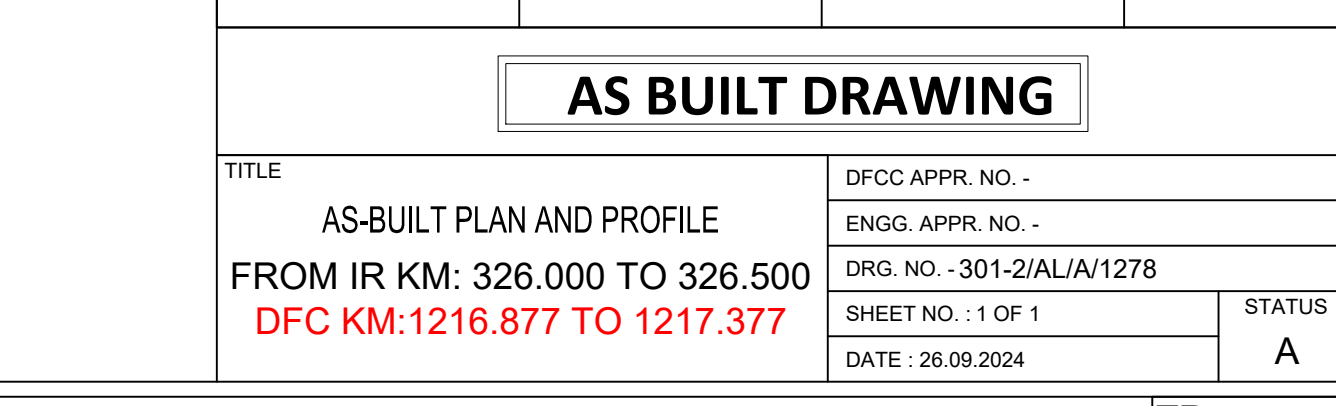

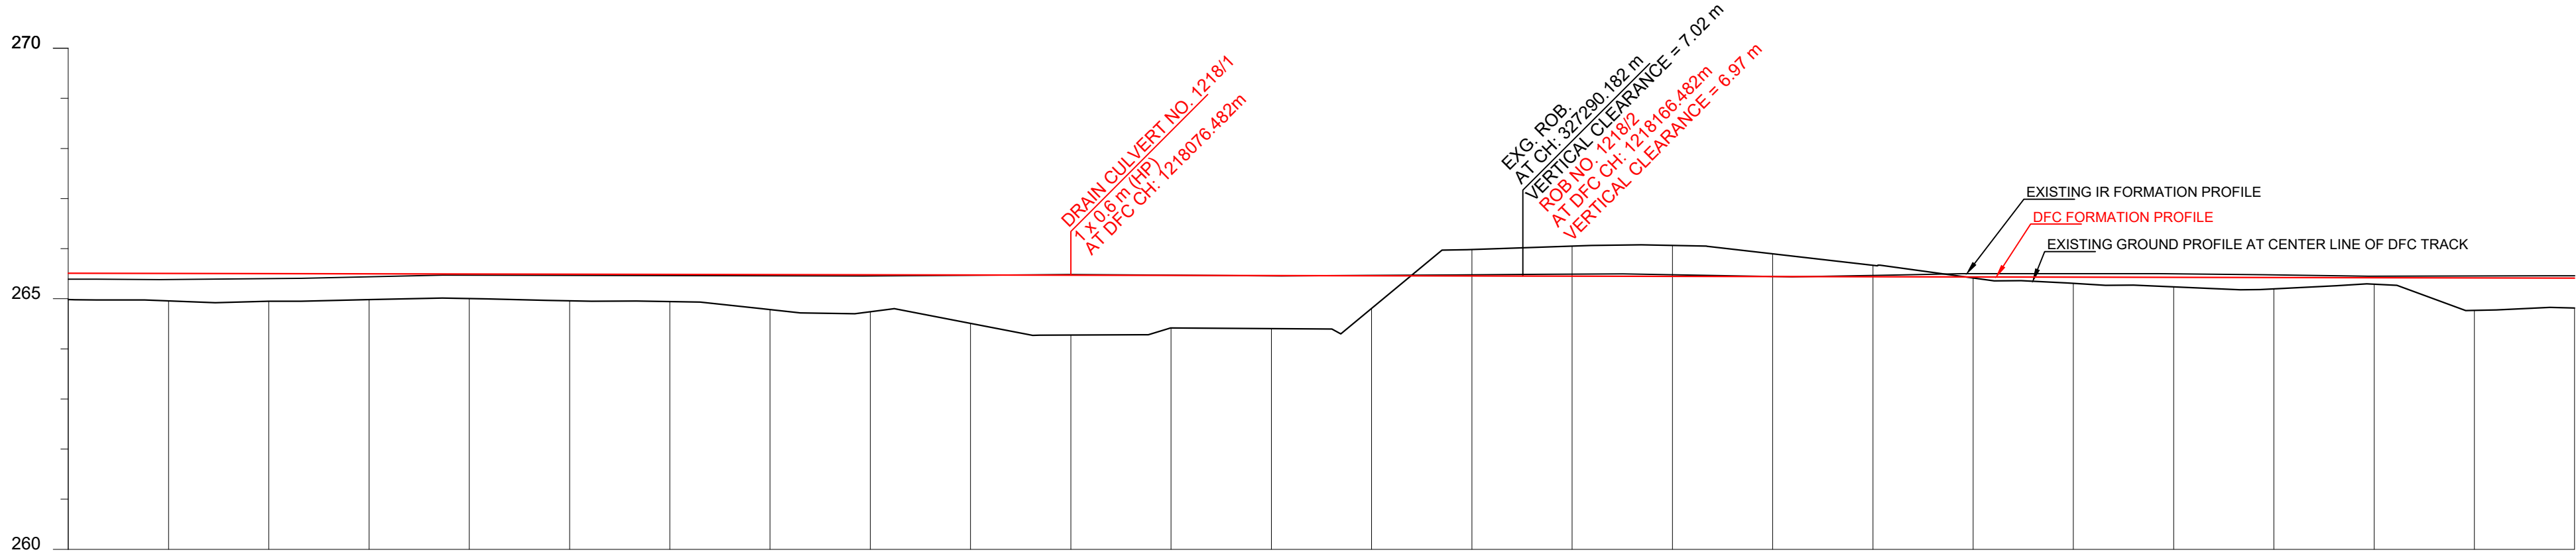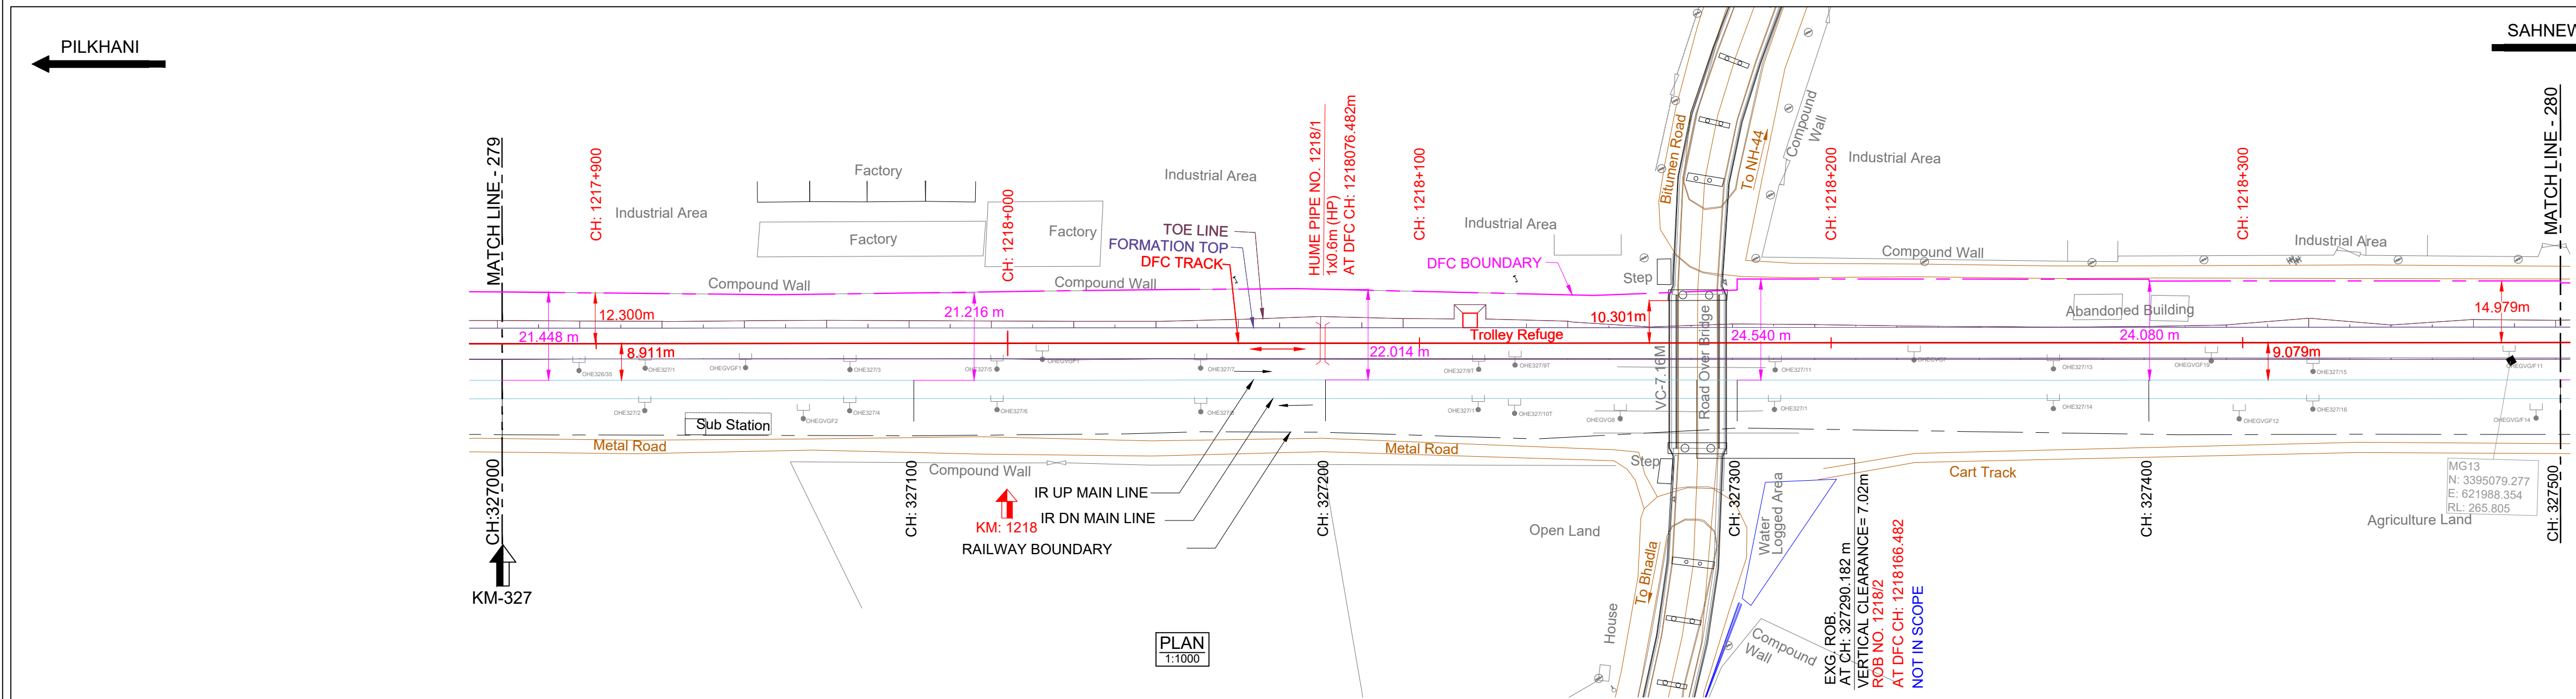


DATUM ABOVE MSL : 260 m

HORIZONTAL ALIGNMENT	L = 5592.259m																			
VERTICAL ALIGNMENT	L=1479.996 m 1 IN 5071.478 F																			
TRACK DISTANCE FROM EXISTING NEAREST IR UP MAIN LINE TO DFC MAIN LINE	8.906	8.914	8.908	8.904	8.911	8.947	8.975	8.959	8.943	8.932	8.921	8.938	8.955	8.973	8.991	9.013	9.030	9.043	9.074	9.102
HEIGHT OF BANKING(+) / DEPTH OF CUTTING(-) (PFL-GL)	+0.527	+0.549	+0.555	+0.517	+0.493	+0.532	+0.544	+0.701	+0.740	+0.967	+1.194	+1.048	+1.059	+0.654	-0.525	-0.597	-0.616	-0.452	-0.225	-0.596
EXG GROUND LEVEL AT CENTER LINE OF DFC TRACK (GL)	264.985	264.959	264.949	264.983	265.003	264.950	264.944	264.783	264.740	264.509	264.278	264.420	264.406	264.806	265.981	266.050	266.065	265.897	265.666	264.817
EXG GROUND LEVEL AT TOE LOCATION OF DFC TRACK	264.481	264.534	264.606	264.513	264.468	264.504	264.545	264.595	264.588	264.332	264.026	264.261	264.331	264.681	265.517	266.205	266.008	265.669	265.529	264.474
DIFFERENCE BETWEEN DFC FORMATION LEVEL AND EXG.FORMATION LEVEL(PFL-EFL)	0.119	0.124	0.103	0.062	0.025	0.026	0.027	0.027	0.025	0.007	-0.011	-0.003	0.007	-0.008	-0.023	-0.039	-0.031	0.000	-0.027	-0.047
DFC FORMATION LEVEL (PFL)	265.512	265.508	265.504	265.500	265.498	265.492	265.488	265.484	265.480	265.476	265.472	265.468	265.464	265.460	265.456	265.451	265.449	265.445	265.441	265.413
EXG. FORMATION LEVEL OF EXG IR UP MAIN LINE (EFL)	265.393	265.384	265.401	265.438	265.471	265.465	265.461	265.457	265.455	265.469	265.483	265.471	265.458	265.468	265.480	265.491	265.480	265.445	265.468	265.460
DIFFERENCE BETWEEN DFC RAIL LEVEL AND EXG. RAIL LEVEL (PRL - ERL)	0.159	0.165	0.144	0.102	0.066	0.067	0.068	0.068	0.066	0.048	0.030	0.038	0.047	0.033	0.018	0.002	0.009	0.040	0.014	-0.006
DFC RAIL LEVEL (PRL)	266.224	266.221	266.217	266.213	266.209	266.205	266.201	266.197	266.193	266.189	266.177	266.173	266.170	266.157	266.150	266.142	266.142	266.142	266.138	266.126
EXG.RAIL LEVEL OF NEAREST IR UP MAIN LINE(ERL)	266.065	266.056	266.073	266.110	266.143	266.137	266.133	266.129	266.127	266.141	266.155	266.143	266.130	266.140	266.152	266.163	266.152	266.170	266.149	266.132
EQUIVALENT CHAINAGE ON DFC TRACK	1217876.5	1217896.5	1217916.5	1217936.5	1217956.5	1217976.5	1217996.5	1218016.5	1218036.5	1218056.5	1218076.5	1218096.5	1218116.5	1218136.5	1218156.5	1218176.5	1218196.5	1218216.5	1218236.5	1218256.5
EXISTING IR CHAINAGE	327000.0	327020.0	327040.0	327060.0	327080.0	327100.0	327120.0	327140.0	327160.0	327180.0	327200.0	327220.0	327240.0	327260.0	327280.0	327300.0	327320.0	327340.0	327360.0	327380.0

L - SECTION

SAHNEWAL

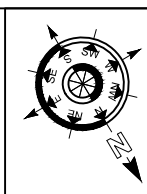

- NOTE:-
1. DFC WORKS ARE SHOWN IN RED.
 2. IR NEW WORKS ARE SHOWN IN VIOLET.
 3. ALL DIMENSIONS ARE SHOWN IN METRES.
 4. THIS DRAWING IS PREPARED BASED ON LATEST SURVEY DATA HELD ON APRIL-2022. GTS BENCH MARK OF 261.85M CONSIDERED ON TOP OF CANAL BRIDGE ABUTMENT AT DORANA VILLAGE ALONG THE NH1.
 5. DFC NEW CHAINAGE OF 1075.950M IS WITH REFERENCE TO THE IR KM OF 187.500KM END OF KM OF CP-303(SECTION P-3 PILKHANI END) AGAINST THE EXISTING DFC CHAINAGE. 116277.742M ISSUED VIDE LETTER NO. COM/DFCC/UMS/SURVEY/2021-301-230116-011173 DT. 17.01.2023.
 6. BALLAST PROFILE HAS BEEN PROVIDED ACCORDING TO THE CLAUSE 1.11.3 OF STANDARD SCHEDULE OF DIMENSION(EASTERN CORRIDOR) & THE BALLAST CUSHION DIMENSION SHOWN IN 35CM ON GE-14 PARA 17. SPECIFICATIONS & RECOMMENDATIONS 2. TWO LAYER SYSTEM FIG.10.

- REFERENCE DRAWINGS :-
1. FOR KEY PLAN REFER DRAWING NO. 301-2/AL/0001
 2. FOR LEGEND AND ABBREVIATIONS REFER DRAWING NO. 301-2/AL/1000
 3. FOR TYPICAL SECTION OF BALLAST PROFILE (FL-RL) REFER DRG. NO. 301-2/TK/TFD/-004 (TR.1952)

0	26.09.2024	SUBMISSION OF AS-BUILT DRAWING	FOR APPROVAL
REV.	DATE	REVISION DETAILS	PURPOSE OF ISSUE

LEGEND:

SCALE

HOR - 1:1000

VER - 1:100

SHEET SIZE : A1

IR TRACK

DFCC TRACK

DFCC FUTURE PROPOSALS

STRUCTURE / BUILDING

DFCC TOE LINE

DFCC FORMATION

RETAINING WALL

ROAD

STREAM, DRAIN, NALA, CANAL

FENCE


POWER LINES

TBM

ELECTRIC POLE/OHE MAST

IR RAILWAY BOUNDARY

DFCC BOUNDARY

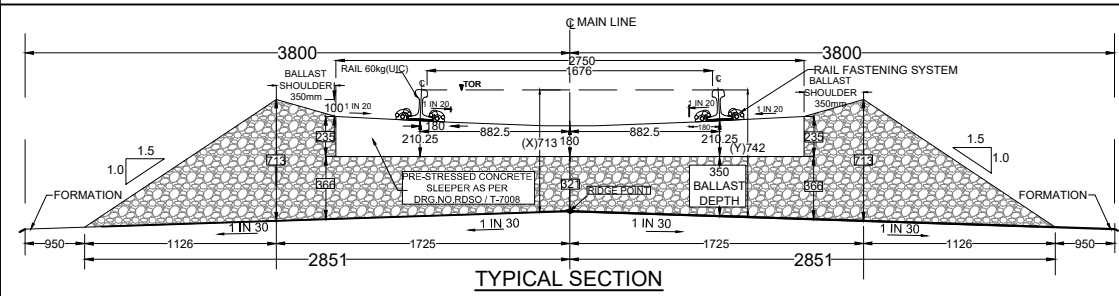

TRACK STRUCTURE		
RAIL SECTION: 60Kg/m (UIC 60Kg/m) DFC LINE: 60Kg/m (UIC 60Kg/m) IR MAIN LINE: 52Kg/m	Difference between FL- RL (Below Rail Seat)	
	IR Line	DFC
RUBBER PAD	172mm	172mm
SLEEPER DEPTH	6mm	10mm
BALLAST CUSHION	210mm	210mm
Total Depth (FL TO RL)	300mm	350mm
	688mm	742mm

OWNER

DEDICATED FREIGHT CORRIDOR CORPORATION OF INDIA LTD.

(A GOVERNMENT OF INDIA ENTERPRISE)

PROJECT OFFICE(AMBALA UNIT): OLD RAILWAY COLONY (NEAR ANAND MARKET),AMBALA CANTT-133001.

CORPORATE IDENTITY NO. : U60232DL2006GGI155068

ENGINEER:

DB Engineering & Consulting GmbH

Deutsche Bahn Engineering & Consulting GmbH

CONTRACTOR:

GIL - TPL JV

GAR TATA



SUBMITTED BY	GIL - TPL JV		
	DATED	NAME	SIGNATURE
PREPARED BY			
CHECKED BY	26.09.2024	VIJAY PRATAP	
APPROVED BY	26.09.2024	PARASURAM KOTYADA	

APPROVED BY	DEUTSCHE BAHN ENGINEERING & CONSULTING GMBH		
	DATED	NAME	SIGNATURE
Sr. DE./CHIEF ENGINEER		SURESH K.YALANGI	
CHIEF TRACK ENGINEER		RAJ PAL SINGH	
T.L.		H.D. VIDJAK	

STAMP	A AS-BUILT DRAWING TR. Ref.:..... ENGINEER Sign.:.....		
EMPLOYER (DFCCIL):	DEDICATED FREIGHT CORRIDOR CORPORATION OF INDIA LTD.		

AS BUILT DRAWING			
TITLE	AS-BUILT PLAN AND PROFILE		
FROM IR KM: 327.000 TO 327.500	DFC KM:1217.876 TO 1218.376		
DFCC APPR. NO. -	ENGG. APPR. NO. -		
DRG. NO. - 301-2/AL/A/1280	SHEET NO. : 1 OF 1		
DATE : 26.09.2024	STATUS		
	A		

TR.

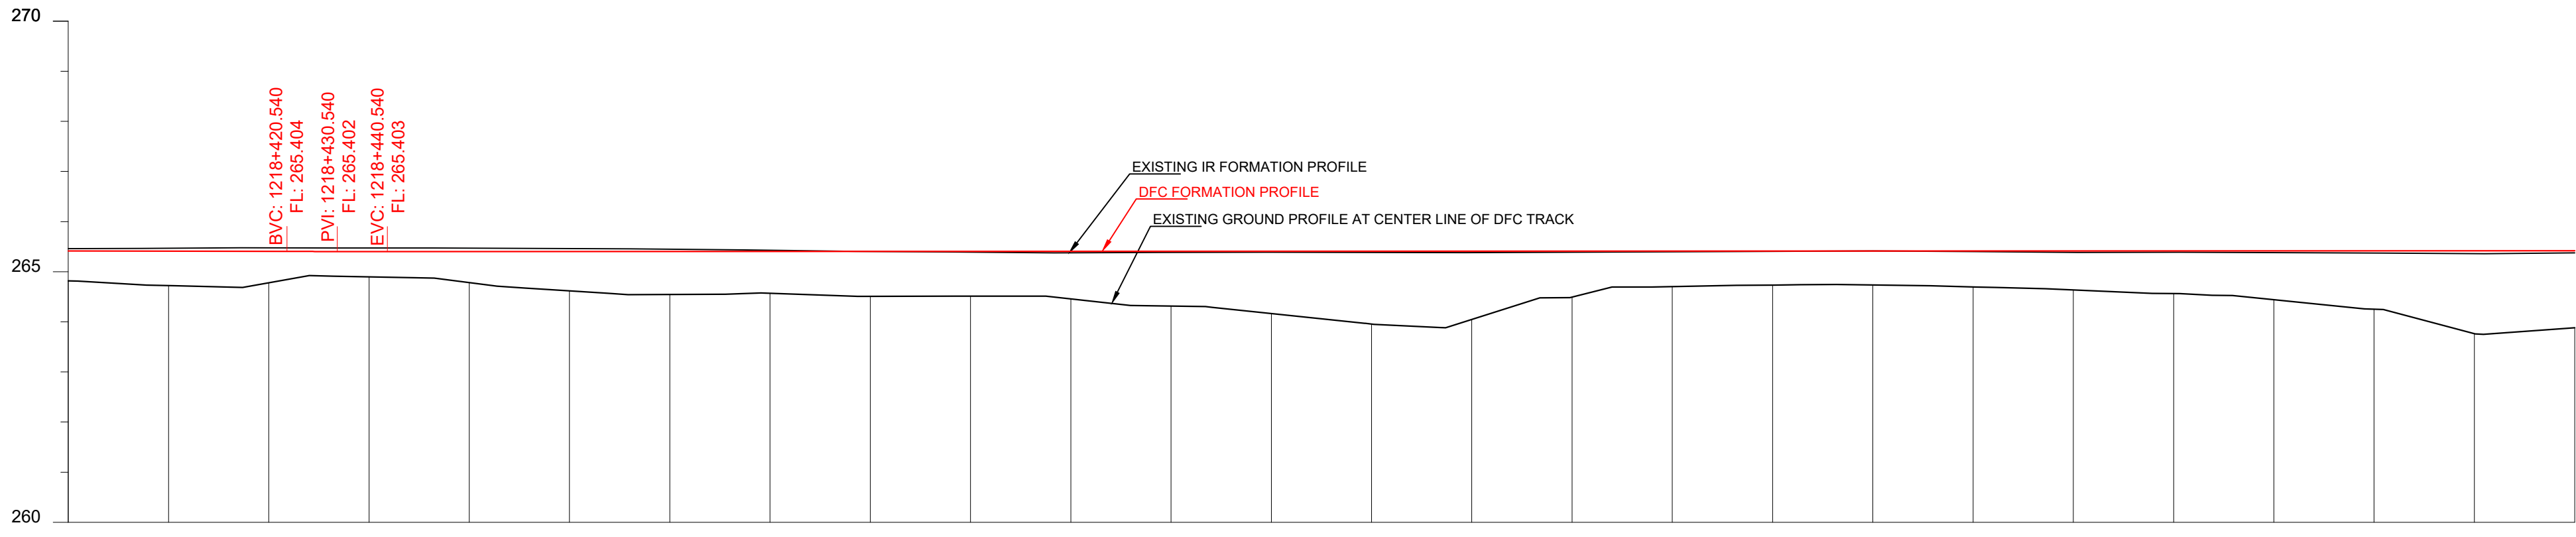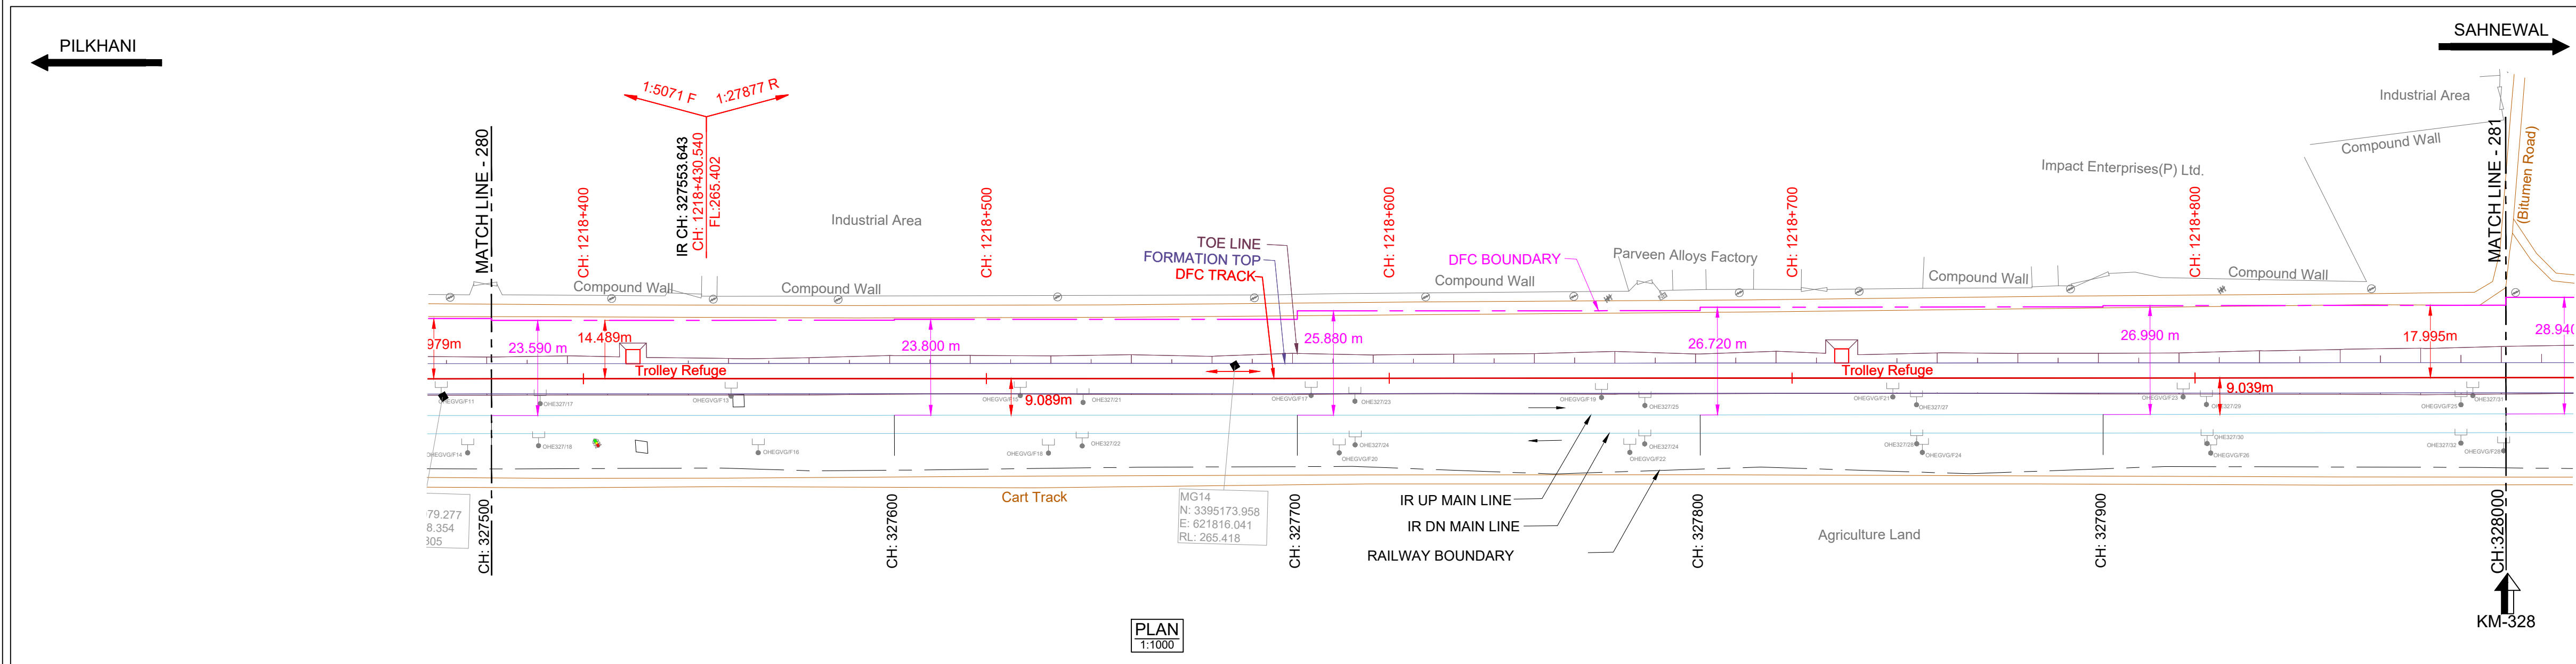

DATUM ABOVE MSL : 260 m

HORIZONTAL ALIGNMENT	L = 5592.259m																			
VERTICAL ALIGNMENT	L=1479.996 m 1 IN 5077.478 F L=20.0 m R=85817 m L=1480.101 m 1 IN 27877.218 R																			
TRACK DISTANCE FROM EXISTING NEAREST IR UP MAIN LINE TO DFC MAIN LINE	9.102	9.105	9.110	9.117	9.116	9.098	9.088	9.090	9.095	9.114	9.131	9.135	9.140	9.142	9.143	9.128	9.113	9.101	9.090	9.077
HEIGHT OF BANKING(+) / DEPTH OF CUTTING(-) (PFL-GL)	+0.596	+0.586	+0.527	+0.505	+0.521	+0.786	+0.859	+0.837	+0.896	+0.897	+0.949	+1.094	+1.243	+1.454	+1.362	+0.918	+0.709	+0.683	+0.679	+0.719
EXG GROUND LEVEL AT CENTER LINE OF DFC TRACK (GL)	-264.817	-264.723	-264.778	-264.898	-264.782	-264.618	-264.547	-264.569	-264.510	-264.510	-264.459	-264.314	-264.166	-263.956	-263.868	-264.403	-264.703	-264.730	-264.734	-264.695
EXG GROUND LEVEL AT TOE LOCATION OF DFC TRACK	-264.474	-264.346	-264.552	-264.675	-264.552	-264.342	-264.307	-264.362	-264.235	-264.389	-264.094	-264.264	-264.187	-264.101	-263.868	-264.184	-263.869	-264.273	-264.049	-264.128
DIFFERENCE BETWEEN DFC FORMATION LEVEL AND EXG FORMATION LEVEL (PFL-EFL)	-0.047	-0.059	-0.071	-0.071	-0.066	-0.059	-0.046	-0.023	0.002	0.018	0.031	0.024	0.019	0.026	0.031	0.022	0.014	0.006	-0.001	0.011
DFC FORMATION LEVEL (PFL)	-265.413	-265.409	-265.405	-265.403	-265.403	-265.404	-265.405	-265.406	-265.406	-265.407	-265.408	-265.408	-265.409	-265.410	-265.411	-265.411	-265.412	-265.413	-265.414	-265.414
EXG. FORMATION LEVEL OF EXG IR UP MAIN LINE (EFL)	-265.460	-265.468	-265.476	-265.474	-265.470	-265.463	-265.450	-265.428	-265.404	-265.389	-265.377	-265.384	-265.390	-265.384	-265.379	-265.390	-265.398	-265.406	-265.414	-265.403
DIFFERENCE BETWEEN DFC RAIL LEVEL AND EXG. RAIL LEVEL (PRL - ERL)	-0.006	-0.019	-0.030	-0.031	-0.026	-0.018	-0.005	0.018	0.043	0.059	0.071	0.065	0.059	0.066	0.072	0.062	0.054	0.047	0.039	0.052
DFC RAIL LEVEL (PRL)	-266.126	-266.122	-266.118	-266.115	-266.116	-266.117	-266.117	-266.118	-266.119	-266.120	-266.120	-266.121	-266.122	-266.122	-266.123	-266.124	-266.125	-266.125	-266.126	-266.127
EXG. RAIL LEVEL OF NEAREST IR UP MAIN LINE (ERL)	-266.132	-266.140	-266.148	-266.146	-266.142	-266.135	-266.122	-266.100	-266.076	-266.061	-266.049	-266.056	-266.062	-266.056	-266.051	-266.062	-266.070	-266.078	-266.086	-266.075
EQUIVALENT CHAINAGE ON DFC TRACK	-1218376.5	-1218396.5	-1218416.5	-1218436.5	-1218456.5	-1218476.5	-1218496.5	-1218516.5	-1218536.5	-1218556.5	-1218576.5	-1218596.5	-1218616.5	-1218636.5	-1218656.5	-1218676.5	-1218696.5	-1218716.5	-1218736.5	-1218756.5
EXISTING IR CHAINAGE	327500.0	327520.0	327540.0	327560.0	327580.0	327600.0	327620.0	327640.0	327660.0	327680.0	327700.0	327720.0	327740.0	327760.0	327780.0	327800.0	327820.0	327840.0	327860.0	327880.0

L - SECTION

- NOTE:-
- DFCC WORKS ARE SHOWN IN RED.
 - IR NEW WORKS ARE SHOWN IN VIOLET.
 - ALL DIMENSIONS ARE SHOWN IN METRES.
 - THIS DRAWING IS PREPARED BASED ON LATEST SURVEY DATA HELD ON APRIL-2022. GTS BENCH MARK OF 261.850M CONSIDERED ON TOP OF CANAL BRIDGE ABUTMENT AT DORANA VILLAGE ALONG THE NH1.
 - DFC NEW CHAINAGE OF 1075.950M IS WITH REFERENCE TO THE IR KM OF 187.500KM END OF KM OF CP-303(SECTION P-3 PILKHANI END) AGAINST THE EXISTING DFC CHAINAGE. 116277.742M ISSUED VIDE LETTER NO. COM/DFCC/UMS/SURVEY/2021-301-230116-011173 DT. 17.01.2023.
 - BALLAST PROFILE HAS BEEN PROVIDED ACCORDING TO THE CLAUSE 1.11.3 OF STANDARD SPECIFICATION OF DIMENSION (EASTERN CORRIDOR) & THE BALLAST CUSHION DIMENSION SHOWN IN 35CM ON GE-14 PARA 17. SPECIFICATIONS & RECOMMENDATIONS 2. TWO LAYER SYSTEM FIG.10.

- REFERENCE DRAWINGS :-
- FOR KEY PLAN REFER DRAWING NO. 301-2/AL/0001
 - FOR LEGEND AND ABBREVIATIONS REFER DRAWING NO. 301-2/AL/1000
 - FOR TYPICAL SECTION OF BALLAST PROFILE (FL-RL) REFER DRG. NO. 301-2/TK/TFDI-004 (TR. 1952)

0	26.09.2024	SUBMISSION OF AS-BUILT DRAWING	FOR APPROVAL
REV.	DATE	REVISION DETAILS	PURPOSE OF ISSUE

LEGEND:


SCALE

HOR - 1:1000

VER - 1:100

SHEET SIZE : A1

IR TRACK
DFCC TRACK
DFCC FUTURE PROPOSALS
STRUCTURE / BUILDING
DFCC TOE LINE
DFCC FORMATION
RETAINING WALL
ROAD
STREAM, DRAIN, NALA, CANAL.
FENCE
POWER LINES
TBM
ELECTRIC POLE/OHE MAST
IR RAILWAY BOUNDARY
DFCC BOUNDARY

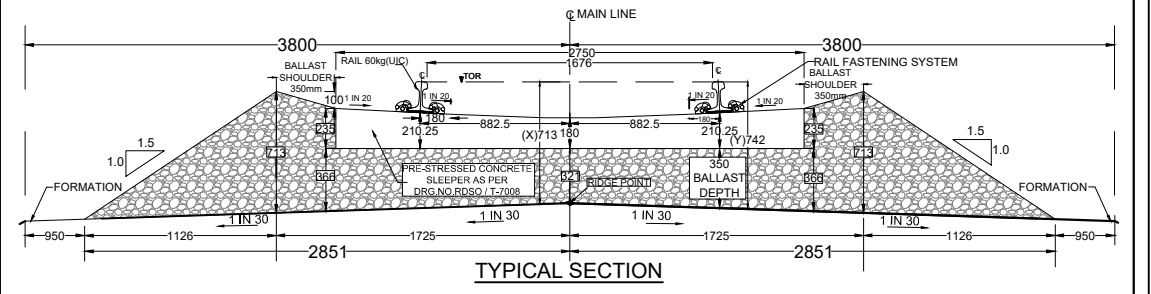

TRACK STRUCTURE		
RAIL SECTION: 60Kg/m (UIC 60Kg/m) DFC LINE: 60Kg/m (UIC 60Kg/m) IR MAIN LINE: 52Kg/m	Difference between FL - RL (Below Rail Seat)	
	IR Line	DFC
RUBBER PAD	172mm	172mm
SLEEPER DEPTH	6mm	10mm
BALLAST CUSHION	210mm	210mm
Total Depth (FL TO RL)	300mm	350mm

OWNER

DEDICATED FREIGHT CORRIDOR CORPORATION OF INDIA LTD.

(A GOVERNMENT OF INDIA ENTERPRISE)

PROJECT OFFICE (AMBALA UNIT): OLD RAILWAY COLONY (NEAR ANAND MARKET), AMBALA CANTT-133001.

CORPORATE IDENTITY NO. : U60232DL2006GGI155068

ENGINEER:

DB Engineering & Consulting GmbH

Deutsche Bahn Engineering & Consulting GmbH

CONTRACTOR:

GIL - TPL JV

GAR TATA

SUBMITTED BY	GIL - TPL JV		
	DATED	NAME	SIGNATURE
PREPARED BY			
CHECKED BY	26.09.2024	VIJAY PRATAP	
APPROVED BY	26.09.2024	PARASURAM KOTYADA	
APPROVED BY	DEUTSCHE BAHN ENGINEERING & CONSULTING GMBH		
	DATED	NAME	SIGNATURE
Sr. DE./CHIEF ENGINEER		SURESH K.YALANGI	
CHIEF TRACK ENGINEER		RAJ PAL SINGH	
T.L.		H.D. VIDJAK	

STAMP

A AS-BUILT DRAWING
TR. Ref.:.....
ENGINEER Sign.:.....

EMPLOYER (DFCCIL): DEDICATED FREIGHT CORRIDOR CORPORATION OF INDIA LTD.

AS BUILT DRAWING

TITLE

AS-BUILT PLAN AND PROFILE

FROM IR KM: 327.500 TO 328.000

DFC KM: 1218.376 TO 1218.876

DFCC APPR. NO. -

ENGG. APPR. NO. -

DRG. NO. - 301-2/AL/A/1281



SHEET NO. : 1 OF 1

DATE : 26.09.2024

STATUS

A

TR.

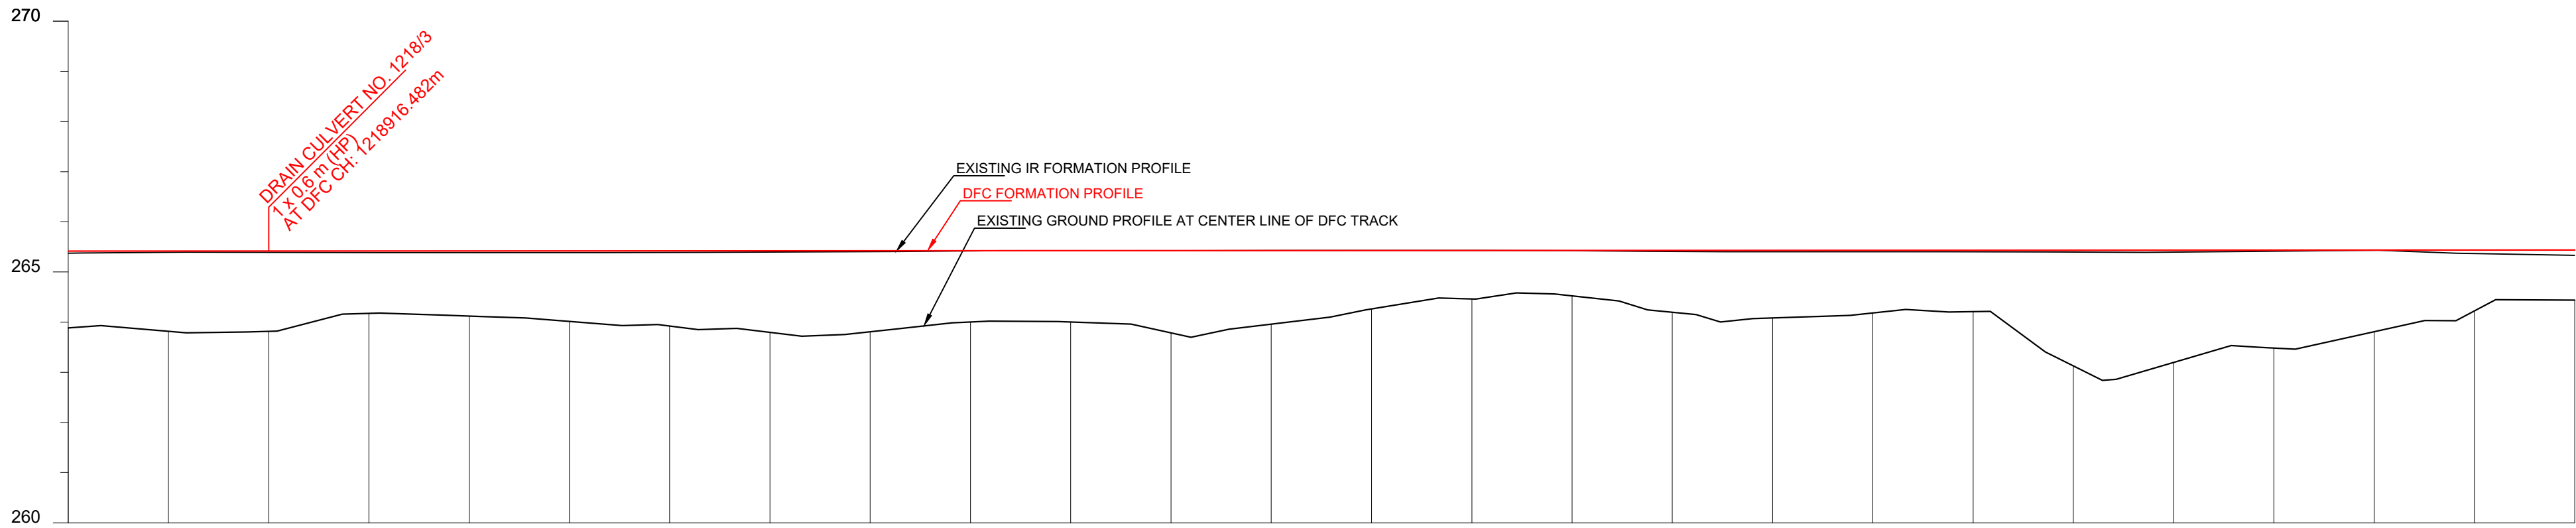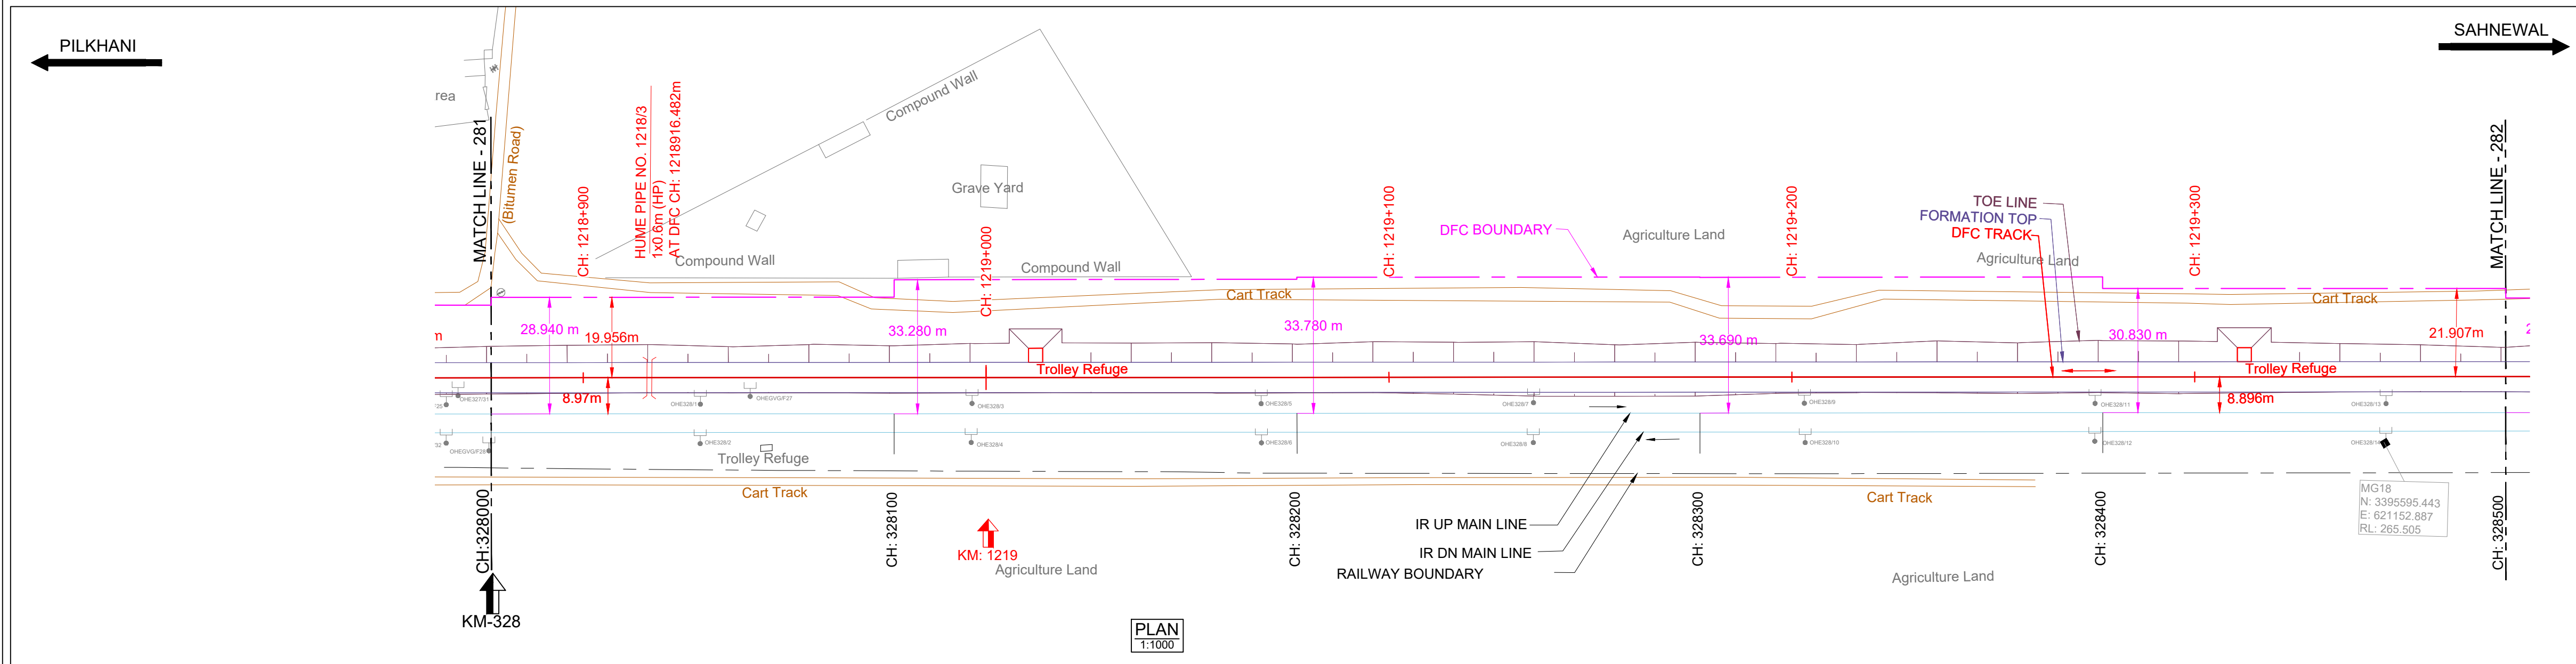


DATUM ABOVE MSL : 260 m

HORIZONTAL ALIGNMENT	L = 5592.259m																			
VERTICAL ALIGNMENT	L=1480.101 m 1 IN 27877.218 R																			
TRACK DISTANCE FROM EXISTING NEAREST IR UP MAIN LINE TO DFC MAIN LINE	8.979	8.969	8.973	8.979	8.988	8.996	8.989	8.976	8.965	8.957	8.934	8.906	8.901	8.903	8.915	8.928	8.910	8.891	8.870	8.859
HEIGHT OF BANKING(+) / DEPTH OF CUTTING(-) (PFL-GL)	+1.537	+1.603	+1.604	+1.246	+1.299	+1.409	+1.501	+1.629	+1.614	+1.423	+1.424	+1.639	+1.466	+1.166	+0.969	+0.906	+1.232	+1.346	+1.248	+1.221
EXG GROUND LEVEL AT CENTER LINE OF DFC TRACK (GL)	263.882	263.816	263.816	264.175	264.122	264.013	263.922	263.795	263.810	264.002	264.002	263.787	263.959	264.262	264.460	264.523	264.198	264.085	264.183	264.211
EXG GROUND LEVEL AT TOE LOCATION OF DFC TRACK	263.279	263.165	263.088	263.370	263.063	263.244	262.982	262.897	262.938	262.895	263.087	262.785	262.867	262.818	263.196	262.891	263.014	263.145	262.733	262.944
DIFFERENCE BETWEEN DFC FORMATION LEVEL AND EXG.FORMATION LEVEL.(PFL-EFL)	0.043	0.027	0.028	0.033	0.034	0.035	0.034	0.027	0.019	0.006	0.002	0.003	0.000	-0.002	0.001	0.006	0.020	0.027	0.027	0.028
DFC FORMATION LEVEL (PFL)	265.419	265.419	265.420	265.421	265.421	265.422	265.423	265.424	265.405	265.419	265.426	265.426	265.427	265.428	265.428	265.429	265.430	265.430	265.431	265.432
EXG. FORMATION LEVEL OF EXG IR UP MAIN LINE (EFL)	265.375	265.392	265.392	265.388	265.388	265.387	265.389	265.396	265.405	265.419	265.424	265.424	265.427	265.430	265.428	265.429	265.410	265.404	265.404	265.404
DIFFERENCE BETWEEN DFC RAIL LEVEL AND EXG. RAIL LEVEL (PRL - ERL)	0.084	0.068	0.069	0.073	0.074	0.076	0.075	0.068	0.06	0.046	0.043	0.043	0.041	0.038	0.041	0.047	0.060	0.067	0.067	0.069
DFC RAIL LEVEL (PRL)	266.131	266.132	266.132	266.133	266.134	266.135	266.135	266.136	266.137	266.137	266.138	266.139	266.140	266.140	266.141	266.142	266.142	266.143	266.144	266.145
EXG.RAIL LEVEL OF NEAREST IR UP MAIN LINE(ERL)	266.047	266.064	266.064	266.060	266.060	266.059	266.061	266.068	266.077	266.091	266.096	266.096	266.099	266.102	266.100	266.095	266.082	266.076	266.077	266.076
EQUIVALENT CHAINAGE ON DFC TRACK	1218876.5	12188906.5	1218916.5	1218936.5	1218956.5	1218976.5	1218996.5	1219016.5	1219036.5	1219056.5	1219076.5	1219096.5	1219116.5	1219136.5	1219156.5	1219176.5	1219196.5	1219216.5	1219236.5	1219256.5
EXISTING IR CHAINAGE	328000.0	328020.0	328040.0	328060.0	328080.0	328100.0	328120.0	328140.0	328160.0	328180.0	328200.0	328220.0	328240.0	328260.0	328280.0	328300.0	328320.0	328340.0	328360.0	328380.0

L - SECTION

SAHNEWAL

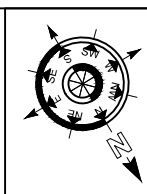

- NOTE:-
- DFCC WORKS ARE SHOWN IN RED.
 - IR NEW WORKS ARE SHOWN IN VIOLET.
 - ALL DIMENSIONS ARE SHOWN IN METRES.
 - THIS DRAWING IS PREPARED BASED ON LATEST SURVEY DATA HELD ON APRIL-2022. GTS BENCH MARK OF 261.850M CONSIDERED ON TOP OF CANAL BRIDGE ABUTMENT AT DORAHA VILLAGE ALONG THE NH1.
 - DFC NEW CHAINAGE OF 1075.950M IS WITH REFERENCE TO THE IR KM OF 187.500KM END OF KM OF CP-303(SECTION P-3 PILKHANI END) AGAINST THE EXISTING DFC CHAINAGE. 116277.742M ISSUED VIDE LETTER NO. COM/DFCC/UM/SURVEY/2021-301-230116-011173 DT. 17.01.2023.
 - BALLAST PROFILE HAS BEEN PROVIDED ACCORDING TO THE CLAUSE 1.11.3 OF STANDARD SCHEDULE OF DIMENSION(EASTERN CORRIDOR) & THE BALLAST CUSHION DIMENSION SHOWN IN 35CM ON GE-14 PARA 17. SPECIFICATIONS & RECOMMENDATIONS 2. TWO LAYER SYSTEM FIG.10.

- REFERENCE DRAWINGS :-
- FOR KEY PLAN REFER DRAWING NO. 301-2/AL/0001
 - FOR LEGEND AND ABBREVIATIONS REFER DRAWING NO. 301-2/AL/1000
 - FOR TYPICAL SECTION OF BALLAST PROFILE (FL-RL) REFER DRG. NO. 301-2/TK/TFD/-004 (TR.1952)

0	26.09.2024	SUBMISSION OF AS-BUILT DRAWING	FOR APPROVAL
REV.	DATE	REVISION DETAILS	PURPOSE OF ISSUE

LEGEND:


SCALE

HOR - 1:1000

VER - 1:100

SHEET SIZE : A1

IR TRACK
DFCC TRACK
DFCC FUTURE PROPOSALS
STRUCTURE / BUILDING
DFCC TOE LINE
DFCC FORMATION
RETAINING WALL
ROAD
STREAM, DRAIN, NALA, CANAL.
FENCE
POWER LINES
TBM
ELECTRIC POLE/OHE MAST
IR RAILWAY BOUNDARY
DFCC BOUNDARY

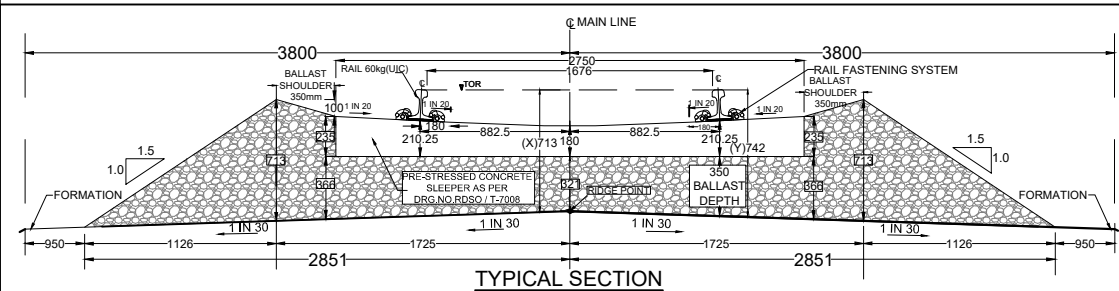

TRACK STRUCTURE		
RAIL SECTION: 60Kg/m (UIC 60Kg/m) DFC LINE: 60Kg/m (UIC 60Kg/m) IR MAIN LINE: 52Kg/m	Difference between FL- RL (Below Rail Seat)	
	IR Line	DFC
RUBBER PAD	172mm	172mm
SLEEPER DEPTH	6mm	10mm
BALLAST CUSHION	210mm	210mm
Total Depth (FL TO RL)	300mm	350mm
	688mm	742mm

OWNER

DEDICATED FREIGHT CORRIDOR CORPORATION OF INDIA LTD.

(A GOVERNMENT OF INDIA ENTERPRISE)

PROJECT OFFICE(AMBALA UNIT): OLD RAILWAY COLONY (NEAR ANAND MARKET),AMBALA CANTT-133001.

CORPORATE IDENTITY NO. : U60232DL2006GGI155068

ENGINEER:

DB Engineering & Consulting GmbH

Deutsche Bahn Engineering & Consulting GmbH

CONTRACTOR:

GIL - TPL JV

GAR TATA



SUBMITTED BY	GIL - TPL JV		
	DATED	NAME	SIGNATURE
PREPARED BY			
CHECKED BY	26.09.2024	VIJAY PRATAP	
APPROVED BY	26.09.2024	PARASURAM KOTYADA	


APPROVED BY	DEUTSCHE BAHN ENGINEERING & CONSULTING GMBH		
	DATED	NAME	SIGNATURE
Sr. DE./CHIEF ENGINEER		SURESH K.YALANGI	
CHIEF TRACK ENGINEER		RAJ PAL SINGH	
T.L.		H.D. VIDJAK	

STAMP	A AS-BUILT DRAWING TR. Ref.:..... ENGINEER Sign.:.		
EMPLOYER (DFCCIL):	DEDICATED FREIGHT CORRIDOR CORPORATION OF INDIA LTD.		

AS BUILT DRAWING			
TITLE	DFCC APPR. NO. -		
AS-BUILT PLAN AND PROFILE	ENGG. APPR. NO. -		
FROM IR KM: 328.000 TO 328.500	DRG. NO. - 301-2/AL/A/1282		
DFC KM:1218.876 TO 1219.376	SHEET NO. : 1 OF 1	STATUS	
	DATE : 26.09.2024	A	

TR.

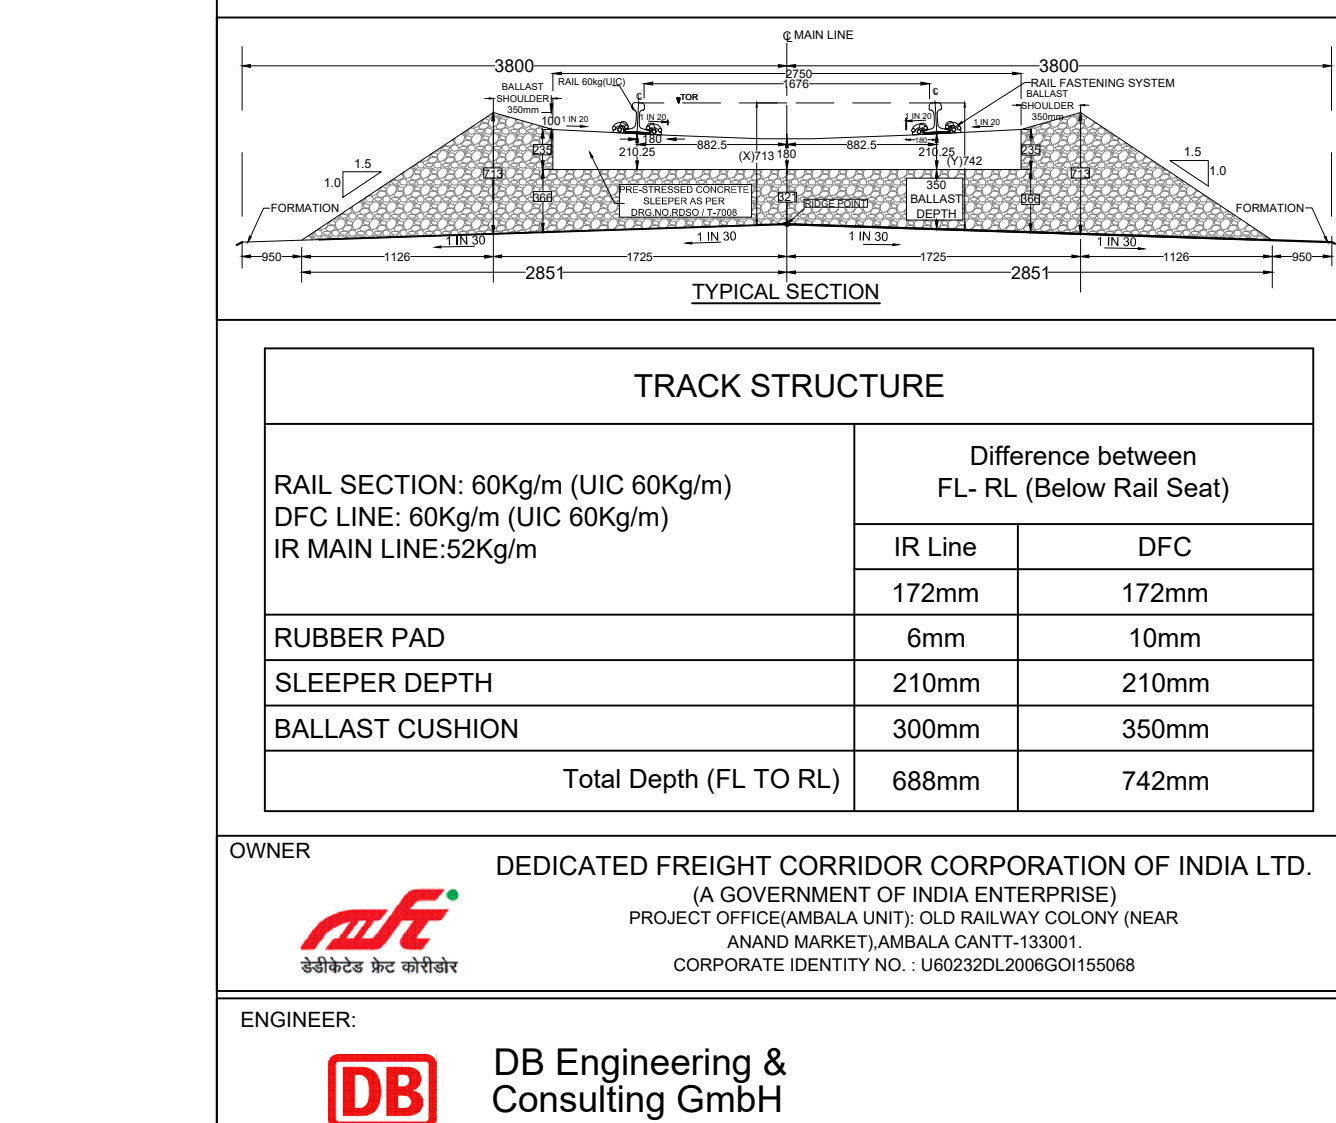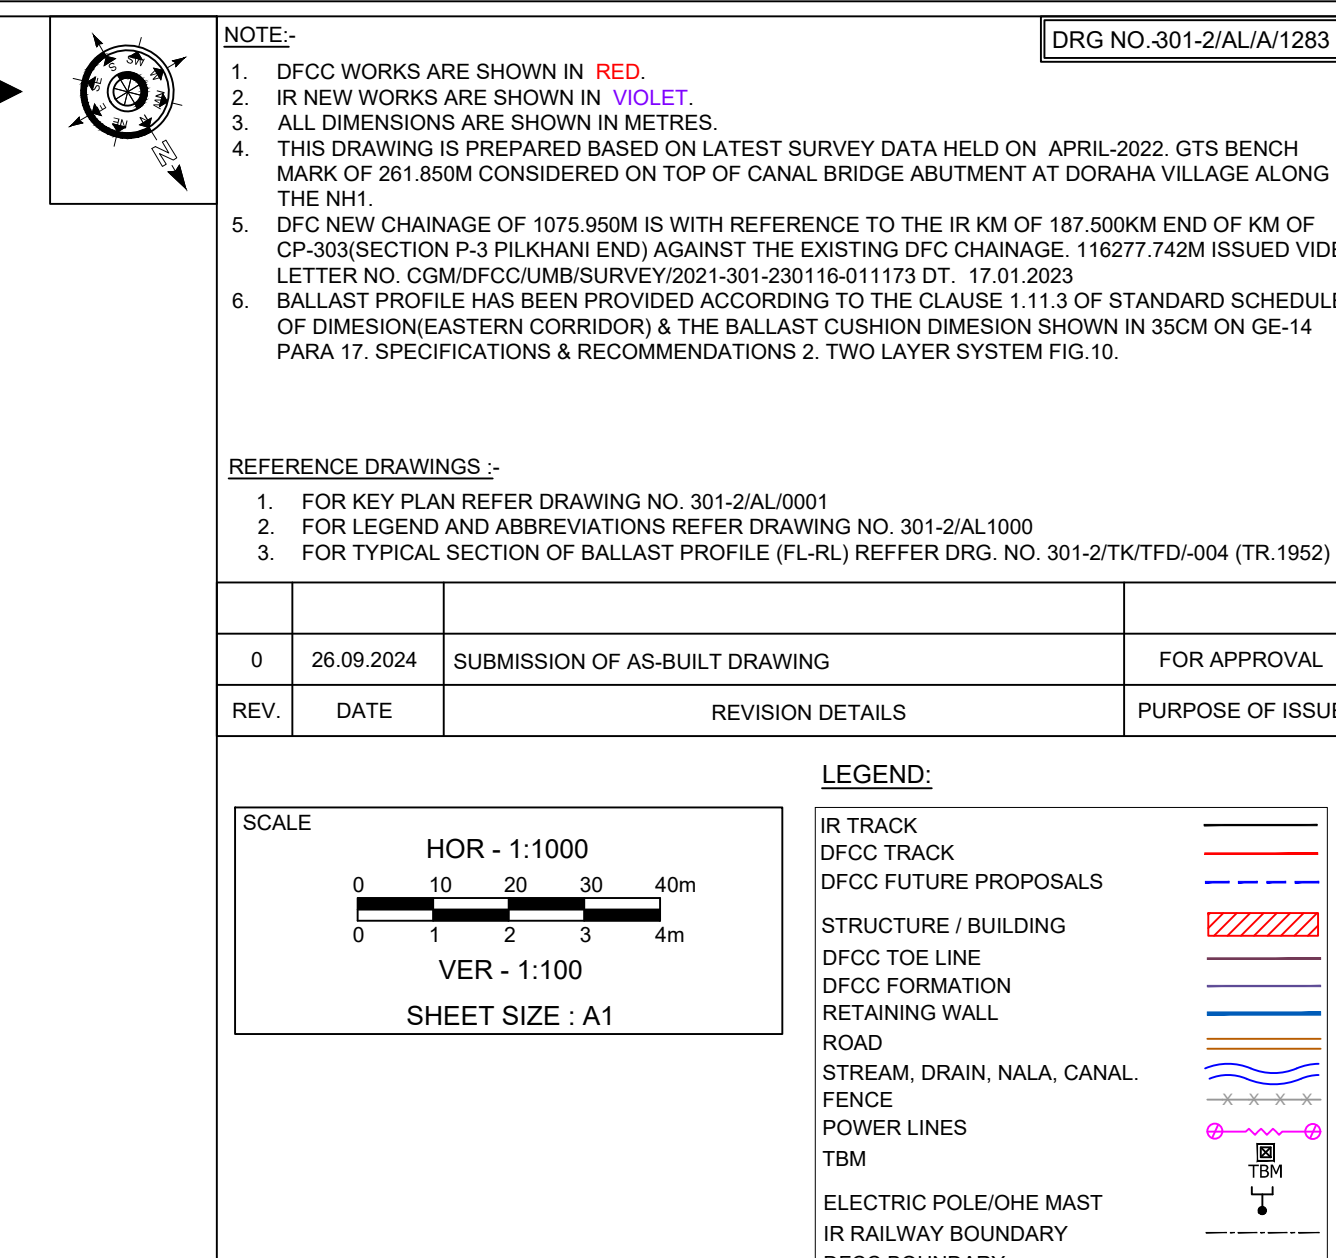

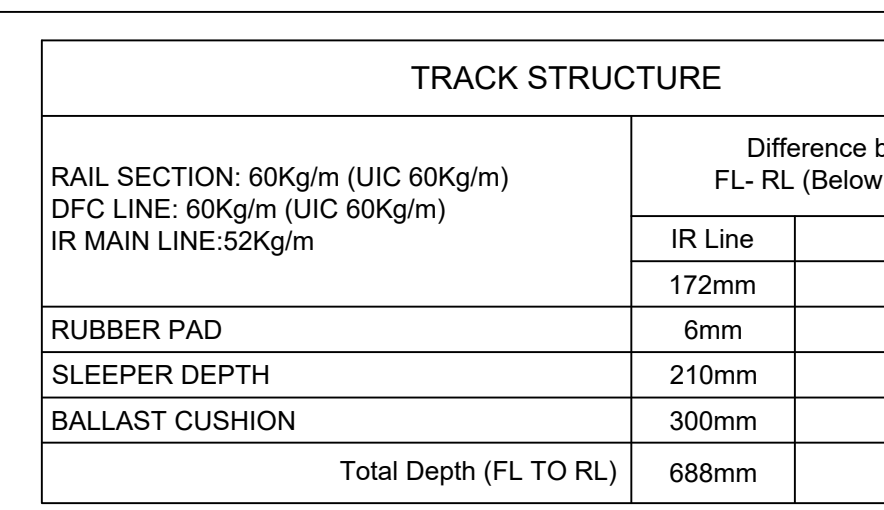

TYPICAL SECTION

TRACK STRUCTURE			
RAIL SECTION: 60Kg/m (UIC 60Kg/m) DFC LINE: 60Kg/m (UIC 60Kg/m) IR MAIN LINE: 52Kg/m		Difference between FL - RL (Below Rail Seat)	
		IR Line	DFC
		172mm	172mm
RUBBER PAD		6mm	10mm
SLEEPER DEPTH		210mm	210mm
BALLAST CUSHION		300mm	350mm
Total Depth (FL TO RL)		688mm	742mm

OWNER



महाराष्ट्र फ्रीट कॉरिडोर

DEDICATED FREIGHT CORRIDOR CORPORATION OF INDIA LTD.
 (A GOVERNMENT OF INDIA ENTERPRISE)
 PROJECT OFFICE:(AMBALA UNIT), OLD RAILWAY COLONY (NEAR ANAND MARKET),AMBALA CANTT-133001.
 CORPORATE IDENTITY NO. : U60323DL2006GOI155068

ENGINEER:



DB Engineering & Consulting GmbH
 Deutsche Bahn Engineering & Consulting GmbH

CONTRACTOR:

GIL - TPL JV




SUBMITTED BY	GIL - TPL JV		
	DATED	NAME	SIGNATURE
PREPARED BY			
CHECKED BY	26.09.2024	VIJAY PRATAP	
APPROVED BY	26.09.2024	PARASURAM KOTYADA	

APPROVED BY	DEUTSCHE BAHN ENGINEERING & CONSULTING GMBH		
	DATED	NAME	SIGNATURE
Sr. DE/CHIEF ENGINEER		SURESH K.YALANGI	
CHIEF TRACK ENGINEER		RAJ PAL SINGH	
T.L.		H.D. VIDJAK	

STAMP

A

AS-BUILT DRAWING

TR. Ref.:.....

ENGINEER Sign.:.....

EMPLOYER (DFCCIL):

DEDICATED FREIGHT CORRIDOR CORPORATION OF INDIA LTD.

AS BUILT DRAWING

TITLE



AS-BUILT PLAN AND PROFILE

FROM IR KM: 222.500 TO 222.500

DFCC APPR. NO. -

ENGG. APPR. NO. -

DWG. NO. - 301.3/IA/IA/1783

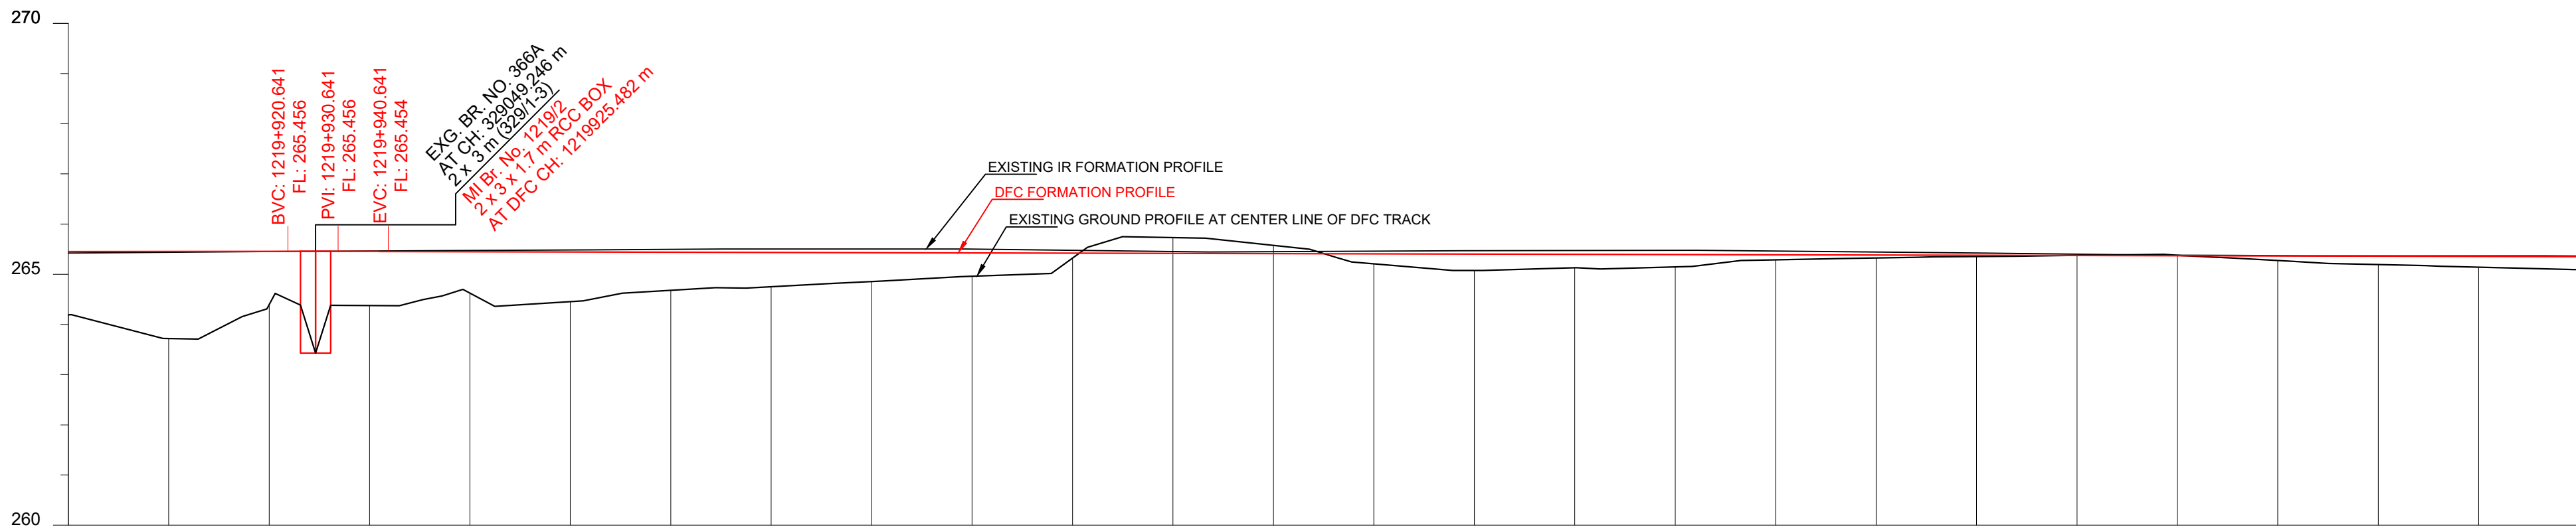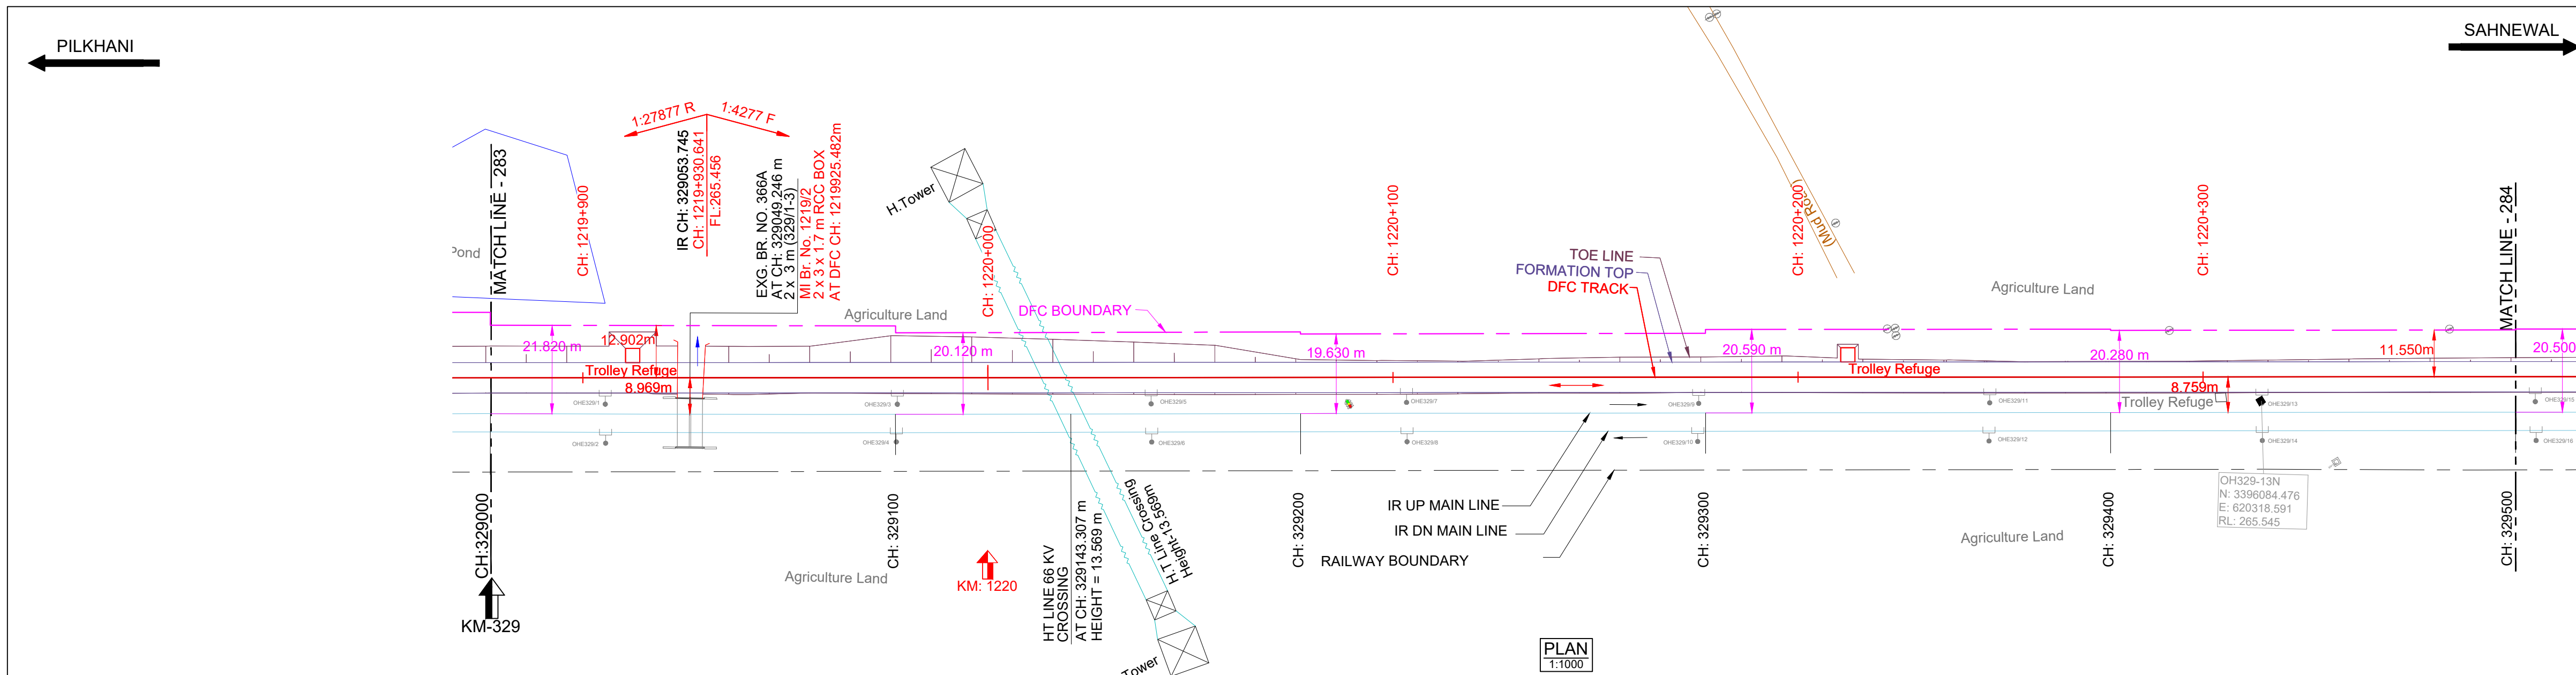

DATUM ABOVE MSL : 260 m

HORIZONTAL ALIGNMENT	L = 5592.259m																			
VERTICAL ALIGNMENT	L=1480.101 m 1 IN 27877.218 R L=20.0 m R=74160 m L=1479.968 m 1 IN 4276.874 F																			
TRACK DISTANCE FROM EXISTING NEAREST IR UP MAIN LINE TO DFC MAIN LINE	8.830	8.887	8.943	9.000	9.052	9.039	9.025	9.003	8.971	8.939	8.905	8.871	8.851	8.840	8.827	8.807	8.787	8.781	8.779	8.719
HEIGHT OF BANKING(+) / DEPTH OF CUTTING(-) (PFL-GL)	+1.262	+1.736	+1.063	+1.080	+0.825	+0.990	+0.760	+0.684	+0.577	+0.468	+0.101	-0.313	-0.162	+0.201	+0.327	+0.271	+0.246	+0.101	+0.060	+0.253
EXG GROUND LEVEL AT CENTER LINE OF DFC TRACK (GL)	264.192	263.719	264.393	264.375	264.625	264.455	264.681	264.752	264.854	264.959	265.321	265.730	265.575	265.207	265.076	265.128	265.148	265.288	265.325	265.099
EXG GROUND LEVEL AT TOE LOCATION OF DFC TRACK	263.303	263.326	263.314	263.359	263.258	262.044	262.215	262.514	262.849	263.304	264.995	265.742	265.508	264.863	264.692	264.673	264.540	264.949	265.040	264.770
DIFFERENCE BETWEEN DFC FORMATION LEVEL AND EXG.FORMATION LEVEL.(PFL-EFL)	0.033	0.019	0.005	-0.007	-0.023	-0.039	-0.056	-0.067	-0.072	-0.076	-0.056	-0.036	-0.038	-0.053	-0.067	-0.076	-0.084	-0.073	-0.058	-0.012
DFC FORMATION LEVEL (PFL)	265.454	265.455	265.456	265.455	265.450	265.445	265.441	265.436	265.431	265.427	265.422	265.417	265.413	265.408	265.403	265.399	265.394	265.389	265.385	265.352
EXG. FORMATION LEVEL OF EXG IR UP MAIN LINE (EFL)	265.421	265.436	265.451	265.482	265.473	265.485	265.497	265.503	265.504	265.503	265.478	265.454	265.451	265.461	265.470	265.474	265.478	265.483	265.443	265.364
DIFFERENCE BETWEEN DFC RAIL LEVEL AND EXG. RAIL LEVEL (PRL - ERL)	0.074	0.059	0.045	0.033	0.018	0.001	-0.015	-0.026	-0.031	-0.035	-0.015	-0.005	0.003	-0.012	-0.026	-0.035	-0.043	-0.033	-0.017	0.029
DFC RAIL LEVEL (PRL)	266.167	266.168	266.168	266.168	266.163	266.158	266.154	266.149	266.144	266.140	266.135	266.130	266.126	266.121	266.116	266.112	266.107	266.102	266.097	266.065
EXG.RAIL LEVEL OF NEAREST IR UP MAIN LINE(ERL)	266.093	266.108	266.123	266.134	266.145	266.157	266.169	266.175	266.176	266.175	266.150	266.126	266.123	266.133	266.142	266.146	266.150	266.135	266.115	266.036
EQUIVALENT CHAINAGE ON DFC TRACK	1219976.7	1219996.6	1219916.6	1219936.6	1219956.5	1219976.5	1219996.5	1220016.5	1220036.5	1220056.5	1220076.5	1220096.5	1220116.5	1220136.5	1220156.5	1220176.5	1220196.5	1220216.5	1220236.5	1220256.5
EXISTING IR CHAINAGE	329000.0	329020.0	329040.0	329060.0	329080.0	329100.0	329120.0	329140.0	329160.0	329180.0	329200.0	329220.0	329240.0	329260.0	329280.0	329300.0	329320.0	329340.0	329360.0	329380.0

L - SECTION

- NOTE:-
- DFCC WORKS ARE SHOWN IN RED.
 - IR NEW WORKS ARE SHOWN IN VIOLET.
 - ALL DIMENSIONS ARE SHOWN IN METRES.
 - THIS DRAWING IS PREPARED BASED ON LATEST SURVEY DATA HELD ON APRIL-2022. GTS BENCH MARK OF 261.850M CONSIDERED ON TOP OF CANAL BRIDGE ABUTMENT AT DORAHA VILLAGE ALONG THE NH1.
 - DFC NEW CHAINAGE OF 1075.950M IS WITH REFERENCE TO THE IR KM OF 187.500KM END OF KM OF CP-303(SECTION P-3 PILKHANI END) AGAINST THE EXISTING DFC CHAINAGE. 116277.742M ISSUED VIDE LETTER NO. COM/DFCC/MB/SURVEY/2021-301-230116-011173 DT. 17.01.2023.
 - BALLAST PROFILE HAS BEEN PROVIDED ACCORDING TO THE CLAUSE 1.11.3 OF STANDARD SCHEDULE OF DIMENSION(EASTERN CORRIDOR) & THE BALLAST CUSHION DIMENSION SHOWN IN 35CM ON GE-14 PARA 17. SPECIFICATIONS & RECOMMENDATIONS 2. TWO LAYER SYSTEM FIG.10.

- REFERENCE DRAWINGS :-
- FOR KEY PLAN REFER DRAWING NO. 301-2/AL/0001
 - FOR LEGEND AND ABBREVIATIONS REFER DRAWING NO. 301-2/AL/1000
 - FOR TYPICAL SECTION OF BALLAST PROFILE (FL-RL) REFER DRG. NO. 301-2/TK/TFD/-004 (TR.1952)

0	26.09.2024	SUBMISSION OF AS-BUILT DRAWING	FOR APPROVAL
REV.	DATE	REVISION DETAILS	PURPOSE OF ISSUE

LEGEND:


SCALE

HOR - 1:1000

VER - 1:100

SHEET SIZE : A1

IR TRACK
DFCC TRACK
DFCC FUTURE PROPOSALS
STRUCTURE / BUILDING
DFCC TOE LINE
DFCC FORMATION
RETAINING WALL
ROAD
STREAM, DRAIN, NALA, CANAL.
FENCE
POWER LINES
TBM
ELECTRIC POLE/OHE MAST
IR RAILWAY BOUNDARY
DFCC BOUNDARY

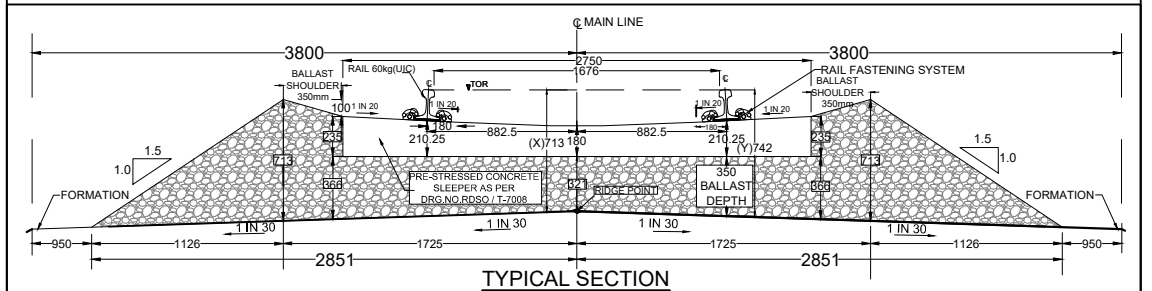

TRACK STRUCTURE		
RAIL SECTION: 60Kg/m (UIC 60Kg/m) DFC LINE: 60Kg/m (UIC 60Kg/m) IR MAIN LINE: 52Kg/m	Difference between FL- RL (Below Rail Seat)	
	IR Line	DFC
RUBBER PAD	172mm	172mm
SLEEPER DEPTH	6mm	10mm
BALLAST CUSHION	210mm	210mm
Total Depth (FL TO RL)	300mm	350mm

OWNER

DEDICATED FREIGHT CORRIDOR CORPORATION OF INDIA LTD.

(A GOVERNMENT OF INDIA ENTERPRISE)

PROJECT OFFICE(AMBALA UNIT): OLD RAILWAY COLONY (NEAR ANAND MARKET),AMBALA CANTT-133001.

CORPORATE IDENTITY NO. : U60232DL2006GGI155068

ENGINEER:

DB Engineering & Consulting GmbH

Deutsche Bahn Engineering & Consulting GmbH

CONTRACTOR:

GIL - TPL JV

GAR TATA



SUBMITTED BY	GIL - TPL JV		
	DATED	NAME	SIGNATURE
PREPARED BY			
CHECKED BY	26.09.2024	VIJAY PRATAP	
APPROVED BY	26.09.2024	PARASURAM KOTYADA	

APPROVED BY	DEUTSCHE BAHN ENGINEERING & CONSULTING GMBH		
	DATED	NAME	SIGNATURE
Sr. DE./CHIEF ENGINEER		SURESH K.YALANGI	
CHIEF TRACK ENGINEER		RAJ PAL SINGH	
T.L.		H.D. VIDJAK	

STAMP	A AS-BUILT DRAWING TR. Ref.:..... ENGINEER Sign.:.....		
EMPLOYER (DFCCIL):	DEDICATED FREIGHT CORRIDOR CORPORATION OF INDIA LTD.		

AS BUILT DRAWING			
TITLE AS-BUILT PLAN AND PROFILE FROM IR KM: 329.000 TO 329.500 DFC KM:1219.877 TO 1220.376		DFCC APPR. NO. -	
		ENGG. APPR. NO. -	
		DRG. NO. -301-2/AL/A/1284	
		SHEET NO. : 1 OF 1	
		DATE : 26.09.2024	STATUS A

TR.

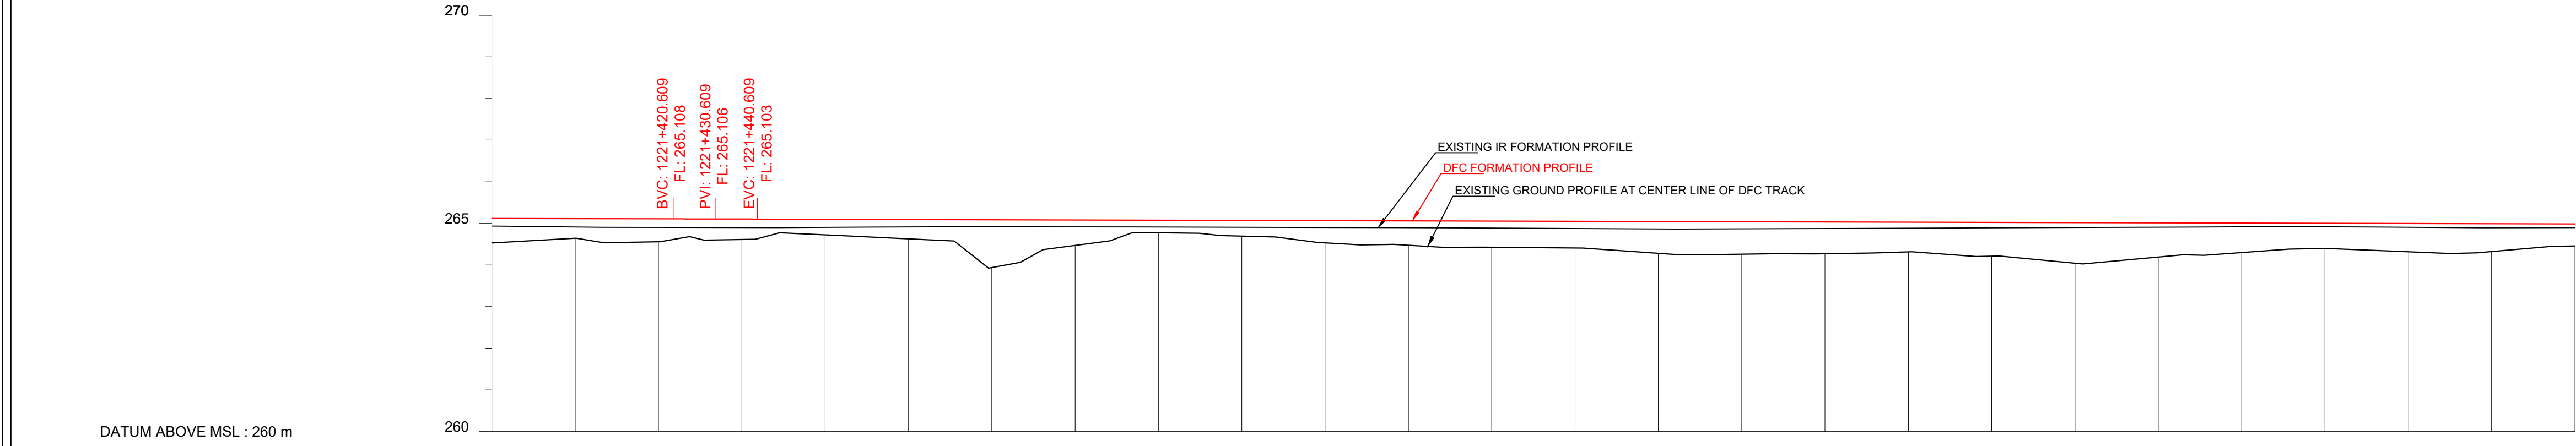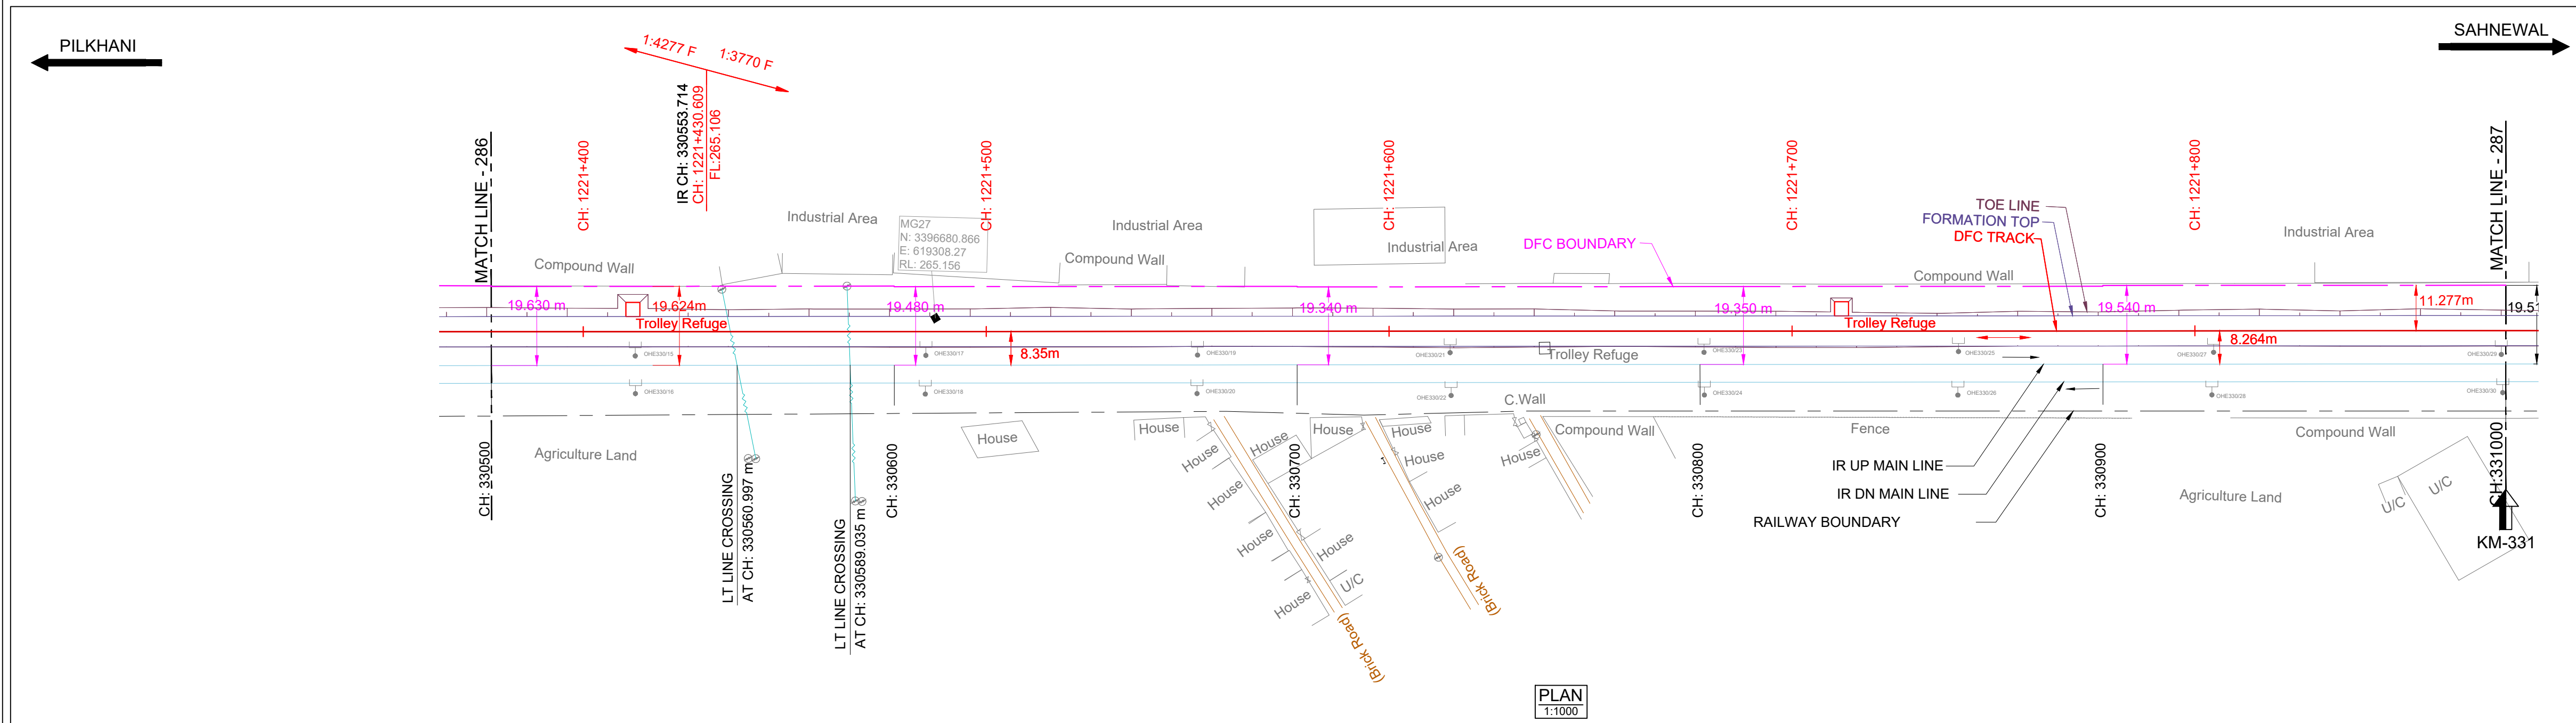

HORIZONTAL ALIGNMENT	L = 5592.259m																			
VERTICAL ALIGNMENT	L=1479.968 m 1 IN 4276.874 F L=20.0 m R=636737 m L=1480.269 m 1 IN 3770.373 F																			
TRACK DISTANCE FROM EXISTING NEAREST IR UP MAIN LINE TO DFC MAIN LINE	8.406	8.391	8.377	8.363	8.354	8.349	8.348	8.352	8.352	8.340	8.328	8.321	8.314	8.306	8.298	8.292	8.287	8.282	8.278	8.273
HEIGHT OF BANKING(+) / DEPTH OF CUTTING(-) (PFL-GL)	+0.587	+0.469	+0.551	+0.491	+0.375	+0.464	+1.151	+0.613	+0.301	+0.378	+0.534	+0.587	+0.628	+0.641	+0.764	+0.780	+0.763	+0.716	+0.811	+0.978
EXG GROUND LEVEL AT CENTER LINE OF DFC TRACK (GL)	-264.531	-264.644	-264.558	-264.613	-264.724	-264.629	-263.937	-264.470	-264.776	-264.694	-264.533	-264.474	-264.428	-264.410	-264.282	-264.260	-264.272	-264.314	-264.213	-264.041
EXG GROUND LEVEL AT TOE LOCATION OF DFC TRACK	-263.897	-263.973	-264.020	-264.161	-264.072	-264.085	-264.068	-263.888	-264.068	-264.001	-263.940	-263.979	-264.075	-264.071	-264.333	-264.343	-264.363	-264.492	-264.191	-264.348
DIFFERENCE BETWEEN DFC FORMATION LEVEL AND EXG.FORMATION LEVEL.(PFL-EFL)	0.184	0.200	0.204	0.204	0.195	0.180	0.171	0.168	0.166	0.166	0.166	0.166	0.167	0.173	0.179	0.170	0.157	0.144	0.131	0.118
DFC FORMATION LEVEL (PFL)	-265.118	-265.113	-265.109	-265.104	-265.099	-265.093	-265.088	-265.083	-265.077	-265.072	-265.067	-265.061	-265.056	-265.051	-265.046	-265.040	-265.035	-265.030	-265.024	-265.019
EXG. FORMATION LEVEL OF EXG IR UP MAIN LINE (EFL)	-264.934	-264.913	-264.905	-264.900	-264.903	-264.913	-264.917	-264.915	-264.912	-264.906	-264.901	-264.896	-264.889	-264.878	-264.866	-264.870	-264.878	-264.886	-264.909	-264.901
DIFFERENCE BETWEEN DFC RAIL LEVEL AND EXG. RAIL LEVEL (PRL - ERL)	0.225	0.241	0.245	0.246	0.237	0.222	0.213	0.209	0.207	0.207	0.208	0.207	0.209	0.215	0.221	0.211	0.198	0.185	0.172	0.159
DFC RAIL LEVEL (PRL)	-265.831	-265.826	-265.822	-265.817	-265.812	-265.807	-265.802	-265.796	-265.791	-265.786	-265.78	-265.775	-265.77	-265.764	-265.759	-265.754	-265.748	-265.738	-265.727	-265.717
EXG.RAIL LEVEL OF NEAREST IR UP MAIN LINE(ERL)	-265.606	-265.585	-265.577	-265.572	-265.575	-265.585	-265.589	-265.587	-265.584	-265.578	-265.573	-265.568	-265.561	-265.550	-265.538	-265.542	-265.550	-265.558	-265.581	-265.589
EQUIVALENT CHAINAGE ON DFC TRACK	-1221376.5	-1221396.5	-1221416.5	-1221436.5	-1221456.5	-1221476.5	-1221496.5	-1221516.5	-1221536.5	-1221556.5	-1221576.5	-1221596.5	-1221616.5	-1221636.5	-1221656.5	-1221676.5	-1221696.5	-1221716.5	-1221736.5	-1221756.5
EXISTING IR CHAINAGE	330500.0	330520.0	330540.0	330560.0	330580.0	330600.0	330620.0	330640.0	330660.0	330680.0	330700.0	330720.0	330740.0	330760.0	330780.0	330800.0	330820.0	330840.0	330860.0	330880.0

L - SECTION

NOTE:-

- DFCC WORKS ARE SHOWN IN RED.
- IR NEW WORKS ARE SHOWN IN VIOLET.
- ALL DIMENSIONS ARE SHOWN IN METRES.
- THIS DRAWING IS PREPARED BASED ON LATEST SURVEY DATA HELD ON APRIL-2022. GTS BENCH MARK OF 261.850M CONSIDERED ON TOP OF CANAL BRIDGE ABUTMENT AT DORANA VILLAGE ALONG THE NH1.
- DFC NEW CHAINAGE OF 1075.950M IS WITH REFERENCE TO THE IR KM OF 187.500KM END OF KM OF CP-303(SECTION P-3 PILKHANI END) AGAINST THE EXISTING DFC CHAINAGE. 116277.742M ISSUED VIDE LETTER NO. COM/DFCC/UMS/SURVEY/2021-301-230116-011173 DT. 17.01.2023.
- BALLAST PROFILE HAS BEEN PROVIDED ACCORDING TO THE CLAUSE 1.11.3 OF STANDARD SPECIFICATION OF DIMENSION(EASTERN CORRIDOR) & THE BALLAST CUSHION DIMENSION SHOWN IN 35CM ON GE-14 PARA 17. SPECIFICATIONS & RECOMMENDATIONS 2. TWO LAYER SYSTEM FIG.10.

REFERENCE DRAWINGS :-

- FOR KEY PLAN REFER DRAWING NO. 301-2/AL/0001
- FOR LEGEND AND ABBREVIATIONS REFER DRAWING NO. 301-2/AL/1000
- FOR TYPICAL SECTION OF BALLAST PROFILE (FL-RL) REFER DRG. NO. 301-2/TK/TFD/-004 (TR.1952)

LEGEND:

IR TRACK
DFCC TRACK
DFCC FUTURE PROPOSALS
STRUCTURE / BUILDING
DFCC TOE LINE
DFCC FORMATION
RETAINING WALL
ROAD
STREAM, DRAIN, NALA, CANAL.
FENCE
POWER LINES
TBM
ELECTRIC POLE/OHE MAST
IR RAILWAY BOUNDARY
DFCC BOUNDARY

SCALE

HOR - 1:1000
VER - 1:100
SHEET SIZE : A1

TYPICAL SECTION

TRACK STRUCTURE		
RAIL SECTION: 60Kg/m (UIC 60Kg/m) DFC LINE: 60Kg/m (UIC 60Kg/m) IR MAIN LINE: 52Kg/m	Difference between FL- RL (Below Rail Seat)	
	IR Line	DFC
RUBBER PAD	172mm	172mm
SLEEPER DEPTH	6mm	10mm
BALLAST CUSHION	210mm	210mm
Total Depth (FL TO RL)	300mm	350mm

OWNER

DEDICATED FREIGHT CORRIDOR CORPORATION OF INDIA LTD.
(A GOVERNMENT OF INDIA ENTERPRISE)
PROJECT OFFICE(AMBALA UNIT): OLD RAILWAY COLONY (NEAR ANAND MARKET),AMBALA CANTT-133001.
CORPORATE IDENTITY NO. : U60232DL2006GCI155068

ENGINEER:

DB Engineering & Consulting GmbH
Deutsche Bahn Engineering & Consulting GmbH

CONTRACTOR:

GIL - TPL JV
GAR TATA

SUBMITTED BY	GIL - TPL JV		
	DATED	NAME	SIGNATURE
PREPARED BY			
CHECKED BY	26.09.2024	VIJAY PRATAP	
APPROVED BY	26.09.2024	PARASURAM KOTYADA	
APPROVED BY	DEUTSCHE BAHN ENGINEERING & CONSULTING GMBH		
	DATED	NAME	SIGNATURE
Sr. DE./CHIEF ENGINEER		SURESH K.YALANGI	
CHIEF TRACK ENGINEER		RAJ PAL SINGH	
T.L.		H.D. VIDJAK	

STAMP

A AS-BUILT DRAWING
TR. Ref.....
ENGINEER Sign.:

EMPLOYER (DFCCIL): DEDICATED FREIGHT CORRIDOR CORPORATION OF INDIA LTD.

AS BUILT DRAWING

TITLE	DFCC APPR. NO. -	STATUS
AS-BUILT PLAN AND PROFILE	ENGG. APPR. NO. -	
FROM IR KM: 330.500 TO 331.000	DRG. NO. - 301-2/AL/A/1287	A
DFC KM:1221.376 TO 1221.876	SHEET NO. : 1 OF 1	
	DATE : 26.09.2024	

TR.