


PILKHANI

SAHNEWAL

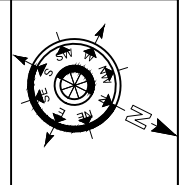

DRG NO.-301-2/AL/A/1263

NOTE:-

- DFCC WORKS ARE SHOWN IN RED.
- IR NEW WORKS ARE SHOWN IN VIOLET.
- ALL DIMENSIONS ARE SHOWN IN METRES.
- THIS DRAWING IS PREPARED BASED ON LATEST SURVEY DATA HELD ON APRIL-2022. GTS BENCH MARK OF 261.850M CONSIDERED ON TOP OF CANAL BRIDGE ABUTMENT AT DORANA VILLAGE ALONG THE NH1.
- DFC NEW CHAINAGE OF 1075.950M IS WITH REFERENCE TO THE IR KM OF 187.500KM END OF KM OF CP-303(SECTION P-3 PILKHANI END) AGAINST THE EXISTING DFC CHAINAGE. 116277.742M ISSUED VIDE LETTER NO. COM/DFCC/UM/SURVEY/2021-301-230116-011173 DT. 17.01.2023.
- BALLAST PROFILE HAS BEEN PROVIDED ACCORDING TO THE CLAUSE 1.11.3 OF STANDARD SCHEDULE OF DIMENSION(EASTERN CORRIDOR) & THE BALLAST CUSHION DIMENSION SHOWN IN 35CM ON GE-14 PARA 17. SPECIFICATIONS & RECOMMENDATIONS 2. TWO LAYER SYSTEM FIG.10.

REFERENCE DRAWINGS :-

- FOR KEY PLAN REFER DRAWING NO. 301-2/AL/0001
- FOR LEGEND AND ABBREVIATIONS REFER DRAWING NO. 301-2/AL/1000
- FOR TYPICAL SECTION OF BALLAST PROFILE (FL-RL) REFER DRG. NO. 301-2/TK/TFD/004 (TR.1952)


REV.	DATE	REVISION DETAILS	PURPOSE OF ISSUE
0	26.09.2024	SUBMISSION OF AS-BUILT DRAWING	FOR APPROVAL

LEGEND:

SCALE

HOR - 1:1000
VER - 1:100
SHEET SIZE : A1

IR TRACK
DFCC TRACK
DFCC FUTURE PROPOSALS
STRUCTURE / BUILDING
DFCC TOE LINE
DFCC FORMATION
RETAINING WALL
ROAD
STREAM, DRAIN, NALA, CANAL.
FENCE
POWER LINES
TBM
ELECTRIC POLE/OHE MAST
IR RAILWAY BOUNDARY
DFCC BOUNDARY

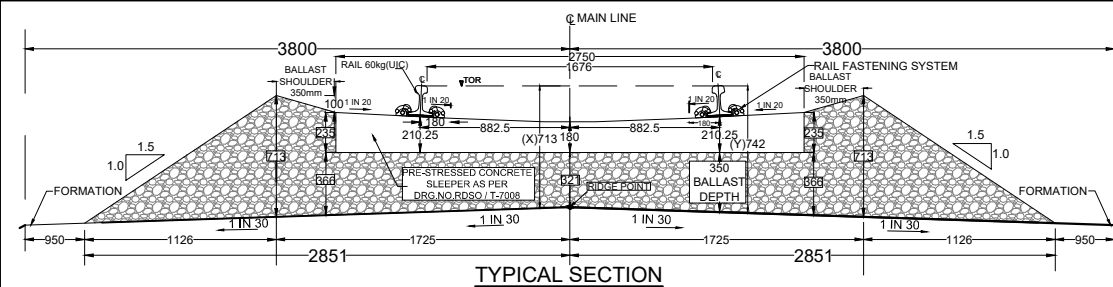

TRACK STRUCTURE		
RAIL SECTION: 60Kg/m (UIC 60Kg/m) DFC LINE: 60Kg/m (UIC 60Kg/m) IR MAIN LINE: 52Kg/m	Difference between FL- RL (Below Rail Seat)	
	IR Line	DFC
RUBBER PAD	172mm	172mm
SLEEPER DEPTH	6mm	10mm
BALLAST CUSHION	210mm	210mm
	300mm	350mm
Total Depth (FL TO RL)	688mm	742mm

OWNER: DEDICATED FREIGHT CORRIDOR CORPORATION OF INDIA LTD.
(A GOVERNMENT OF INDIA ENTERPRISE)
PROJECT OFFICE/AMBALA UNIT: OLD RAILWAY COLONY (NEAR ANAND MARKET), AMBALA CANTT-133001.
CORPORATE IDENTITY NO. : U60232DL2006GGI155068

ENGINEER: DB Engineering & Consulting GmbH
Deutsche Bahn Engineering & Consulting GmbH

CONTRACTOR: GIL - TPL JV
GAR TATA


SUBMITTED BY	GIL - TPL JV		
	DATED	NAME	SIGNATURE
PREPARED BY			
CHECKED BY	26.09.2024	VIJAY PRATAP	
APPROVED BY	26.09.2024	PARASURAM KOTYADA	

APPROVED BY	DEUTSCHE BAHN ENGINEERING & CONSULTING GMBH		
	DATED	NAME	SIGNATURE
Sr. DE./CHIEF ENGINEER		SURESH K.YALANGI	
CHIEF TRACK ENGINEER		RAJ PAL SINGH	
T.L.		H.D. VIDJAK	

STAMP	A AS-BUILT DRAWING TR. Ref.:..... ENGINEER Sign.:.....		
	EMPLOYER (DFCCIL): DEDICATED FREIGHT CORRIDOR CORPORATION OF INDIA LTD.		

AS BUILT DRAWING			
TITLE AS-BUILT PLAN AND PROFILE DFC KM:1209.405 TO 1209.905 (DETOUR)	DFCC APPR. NO. -		
	ENGG. APPR. NO. -		
	DRG. NO. - 301-2/AL/A/1263		
	SHEET NO. : 1 OF 1		STATUS A
	DATE : 26.09.2024		

TR.

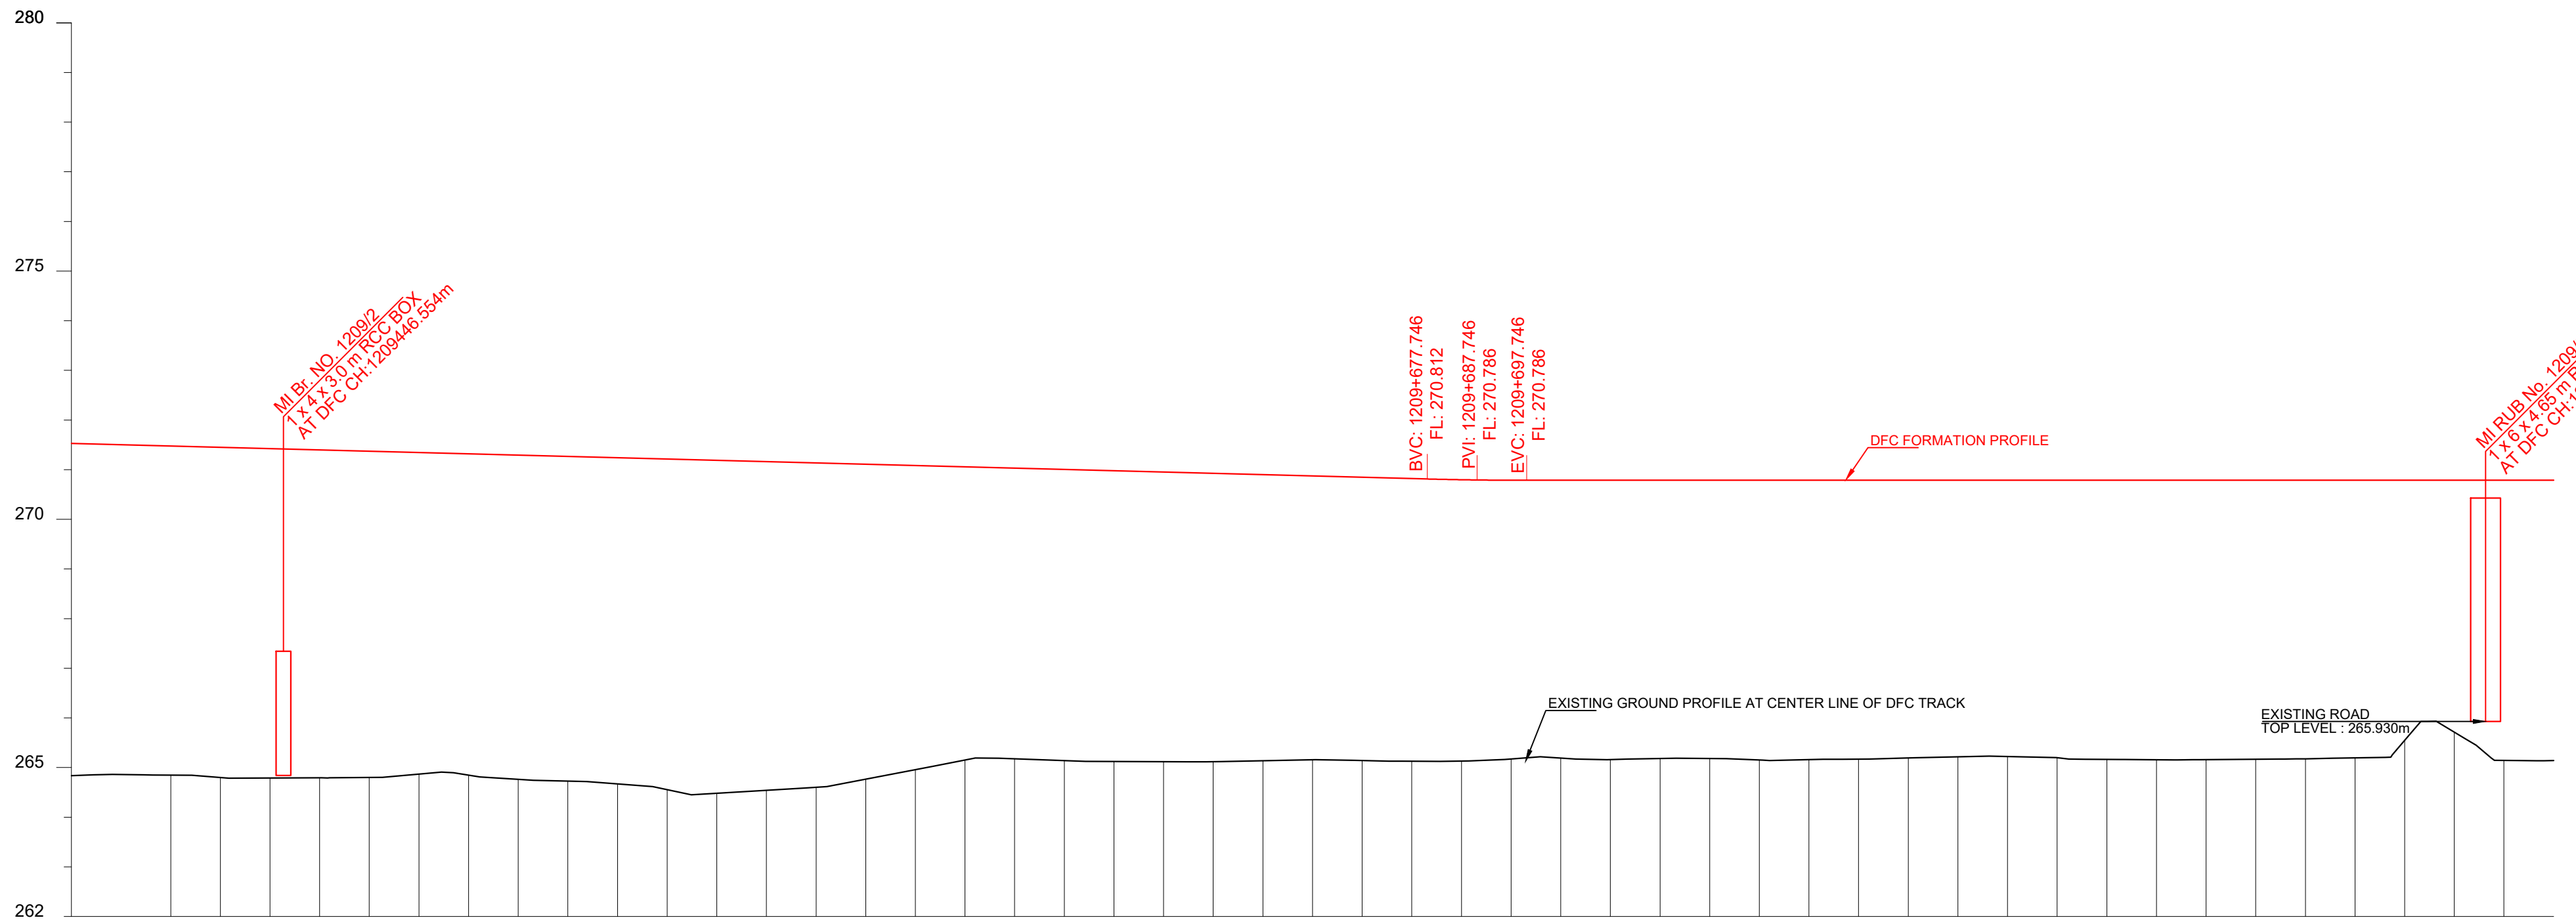

DATUM ABOVE MSL : 262 m

HORIZONTAL ALIGNMENT	L = 557.867m																								TL = 160m			
VERTICAL ALIGNMENT	L=1692.889 m 1 IN 381.150 F																								L=20.0 m R=7623 m		L=1254.449 m LEVEL	
HEIGHT OF BANKING(+) / DEPTH OF CUTTING(-) (PFL-GL)	+6.692	+6.630	+6.636	+6.569	+6.473	+6.541	+6.658	+6.620	+6.343	+5.906	+5.863	+5.834	+5.763	+5.706	+5.667	+5.595	+5.605	+5.635	+5.618	+5.569	+5.587	+5.629	+5.620	+5.592	+5.072	+5.646		
EXG GROUND LEVEL AT CENTER LINE OF DFC TRACK (GL)	264.837	264.846	264.788	264.802	264.846	264.725	264.556	264.542	264.766	265.151	265.141	265.118	265.136	265.141	265.130	265.191	265.181	265.151	265.168	265.217	265.199	265.157	265.166	265.194	265.714	265.140		
DFC FORMATION LEVEL (PFL)	271.529	271.476	271.424	271.371	271.319	271.266	271.214	271.162	271.109	271.057	271.004	270.952	270.899	270.847	270.797	270.786	270.786	270.786	270.786	270.786	270.786	270.786	270.786	270.786	270.786	270.786		
DFC RAIL LEVEL (PRL)	272.242	272.190	272.137	272.085	272.032	271.980	271.927	271.875	271.822	271.770	271.717	271.665	271.612	271.560	271.507	271.499	271.499	271.499	271.499	271.499	271.499	271.499	271.499	271.499	271.499	271.499		
DFC TRACK CHAINAGE	1209404.6	1209424.6	1209444.6	1209464.6	1209484.6	1209504.6	1209524.6	1209544.6	1209564.6	1209584.6	1209604.6	1209624.6	1209644.6	1209664.6	1209684.6	1209704.6	1209724.6	1209744.6	1209764.6	1209784.6	1209804.6	1209824.6	1209844.6	1209864.6	1209884.6	1209904.6		

L - SECTION