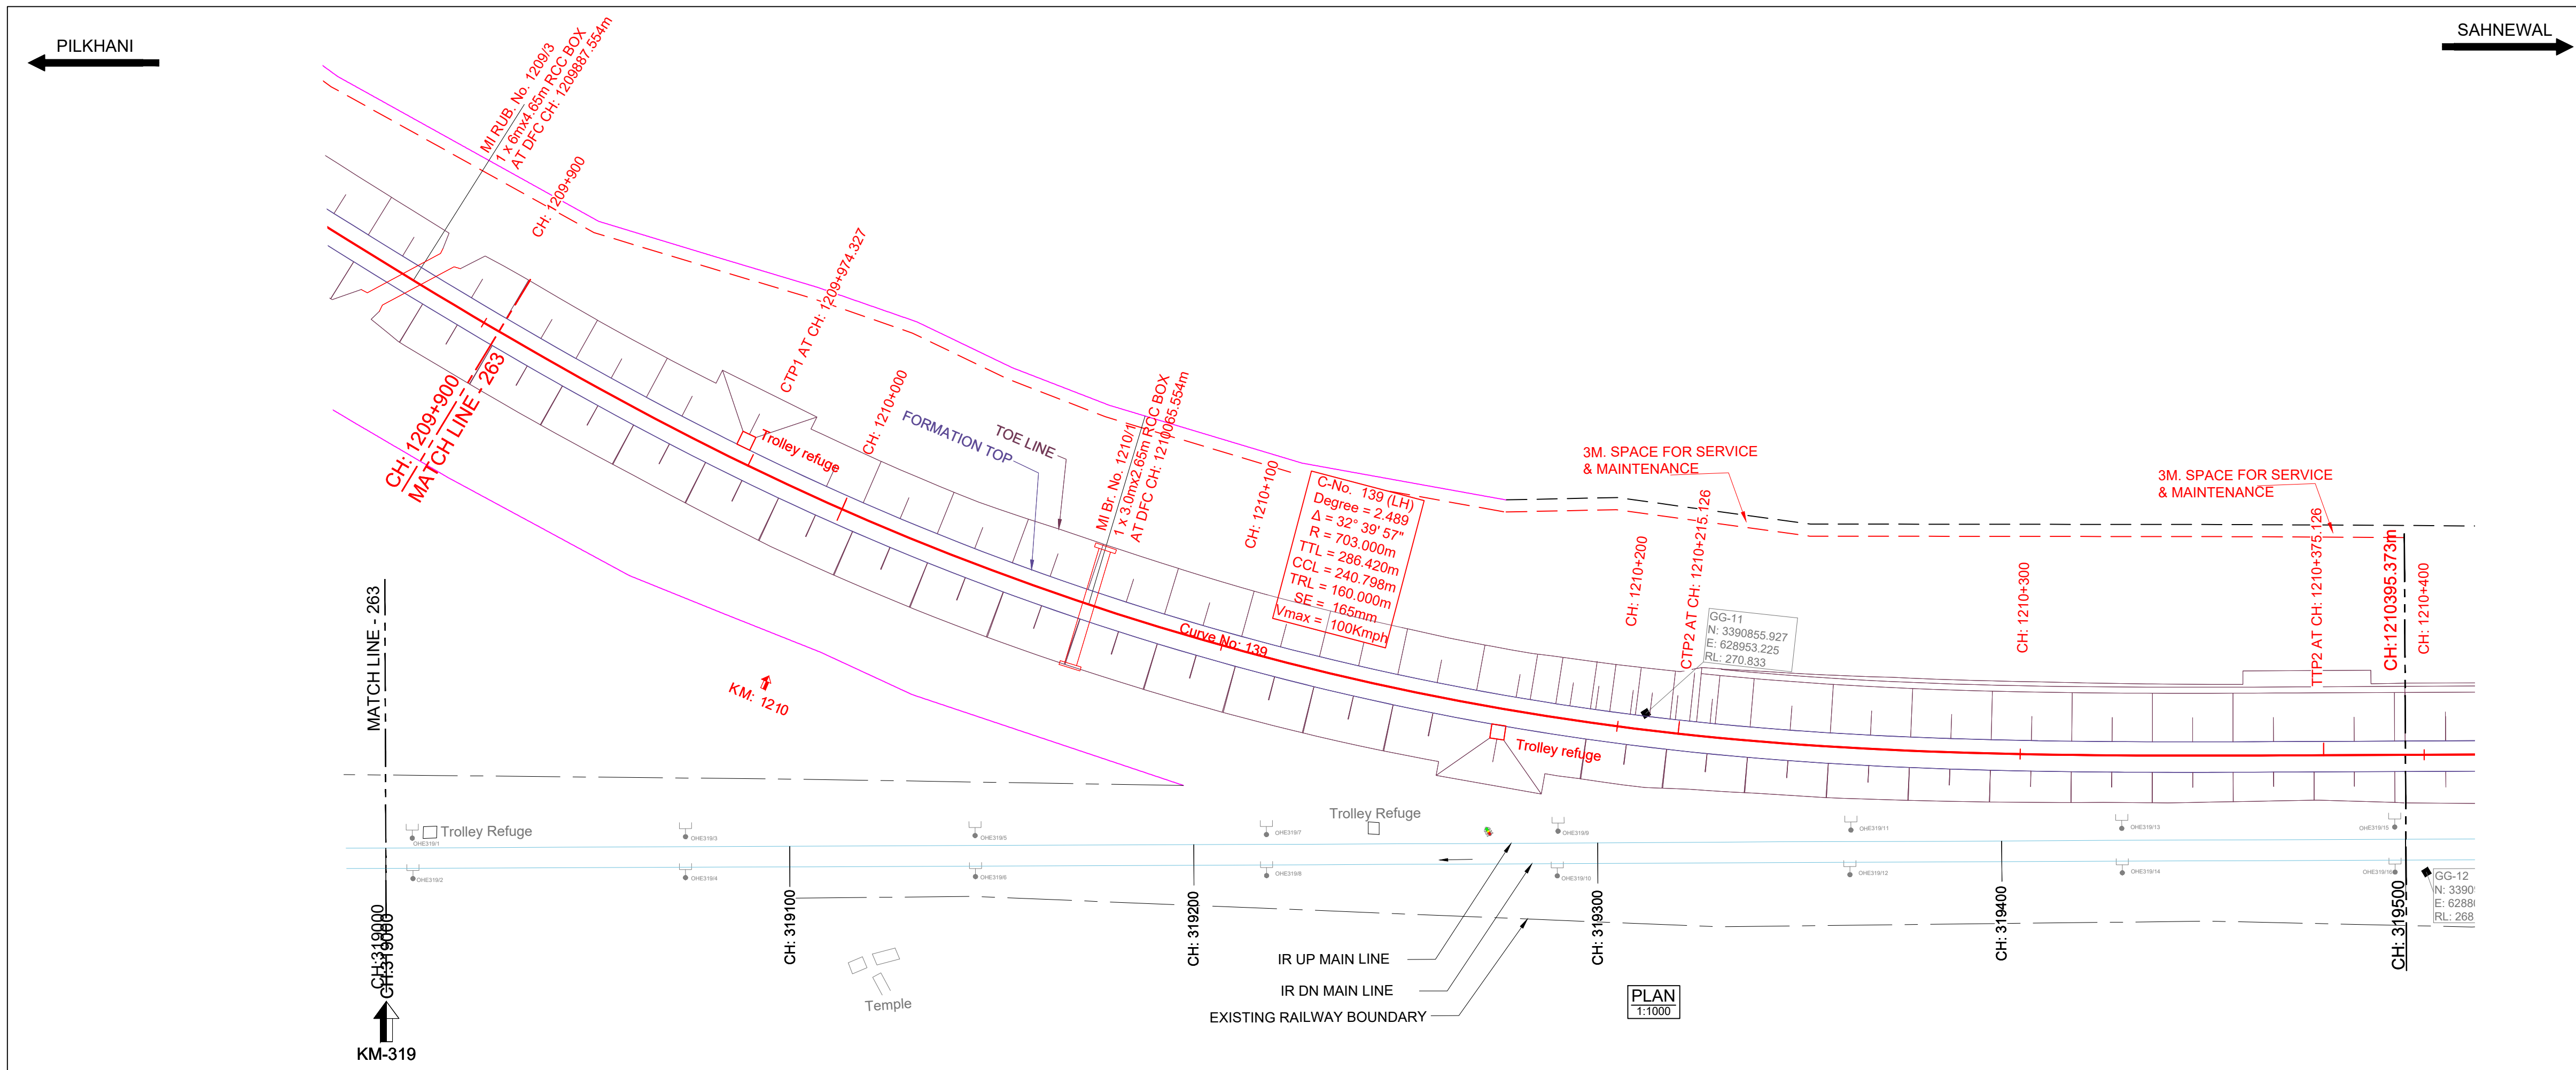


HORIZONTAL ALIGNMENT	TL = 160m R = -703m TL = 160m L = 524.648m																			
VERTICAL ALIGNMENT	L=1254.449 m LEVEL																			
TRACK DISTANCE FROM DFC MAIN LINE TO EXISTING NEAREST IR UP MAIN LINE																				
HEIGHT OF BANKING(+) / DEPTH OF CUTTING(-) (PFL-GL)	+5.646	+5.609	+5.600	+5.689	+5.678	+5.843	+5.932	+6.057	+6.073	+6.042	+5.943	+5.936	+5.936	+5.917	+5.877	+5.818	+6.081	+6.072	+6.226	+6.179
EXG GROUND LEVEL AT CENTER LINE OF DFC TRACK (GL)	265.140	265.177	265.177	265.097	264.908	264.943	264.854	264.729	264.713	264.744	264.843	264.850	264.869	264.909	264.905	264.714	264.580	264.807	264.297	264.274
DFC FORMATION LEVEL (PFL)	270.786	270.786	270.786	270.786	270.786	270.786	270.786	270.786	270.786	270.786	270.786	270.786	270.786	270.786	270.786	270.786	270.786	270.786	270.786	270.786
DFC RAIL LEVEL (PRL)	271.499	271.499	271.499	271.499	271.499	271.499	271.499	271.499	271.499	271.499	271.499	271.499	271.499	271.499	271.499	271.499	271.499	271.499	271.499	271.499
DFC TRACK CHAINAGE	1209904.6	1209924.6	1209944.6	1209964.6	1209984.6	1210004.6	1210024.6	1210044.6	1210064.6	1210084.6	1210104.6	1210124.6	1210144.6	1210164.6	1210184.6	1210204.6	1210224.6	1210244.6	1210264.6	1210284.6
EQUIVALENT CHAINAGE ON EXISTING IR TRACK																				

L - SECTION

NOTE:-

- DFCC WORKS ARE SHOWN IN RED.
- IR NEW WORKS ARE SHOWN IN VIOLET.
- ALL DIMENSIONS ARE SHOWN IN METRES.
- THIS DRAWING IS PREPARED BASED ON LATEST SURVEY DATA HELD ON APRIL-2022. GTS BENCH MARK OF 261.850M CONSIDERED ON TOP OF CANAL BRIDGE ABUTMENT AT DORAH VILLAGE ALONG THE NH1.
- DFC NEW CHAINAGE OF 1075.950M IS WITH REFERENCE TO THE IR KM OF 187.500KM END OF KM OF CP-303(SECTION P-3 PILKHANI END) AGAINST THE EXISTING DFC CHAINAGE. 116277.742M ISSUED VIDE LETTER NO. COM/DFCC/MB/SURVEY/2021-301-230116-011173 DT. 17.01.2023.
- BALLAST PROFILE HAS BEEN PROVIDED ACCORDING TO THE CLAUSE 1.11.3 OF STANDARD SCHEDULE OF DIMENSION(EASTERN CORRIDOR) & THE BALLAST CUSHION DIMENSION SHOWN IN 35CM ON GE-14 PARA 17. SPECIFICATIONS & RECOMMENDATIONS 2. TWO LAYER SYSTEM FIG.10.

REFERENCE DRAWINGS :-

- FOR KEY PLAN REFER DRAWING NO. 301-2/AL/0001
- FOR LEGEND AND ABBREVIATIONS REFER DRAWING NO. 301-2/AL/1000
- FOR TYPICAL SECTION OF BALLAST PROFILE (FL-RL) REFER DRG. NO. 301-2/TK/TFDI-004 (TR.1952)

0	26.09.2024	SUBMISSION OF AS-BUILT DRAWING	FOR APPROVAL
REV.	DATE	REVISION DETAILS	PURPOSE OF ISSUE

SCALE
HOR - 1:1000
VER - 1:100
SHEET SIZE : A1

LEGEND:

- IR TRACK
- DFCC TRACK
- DFCC FUTURE PROPOSALS
- STRUCTURE / BUILDING
- DFCC TOE LINE
- DFCC FORMATION
- RETAINING WALL
- ROAD
- STREAM, DRAIN, NALA, CANAL.
- FENCE
- POWER LINES
- TBM
- ELECTRIC POLE/OHE MAST
- IR RAILWAY BOUNDARY
- DFCC BOUNDARY

TYPICAL SECTION

TRACK STRUCTURE	
RAIL SECTION: 60Kg/m (UIC 60Kg/m)	Difference between FL- RL (Below Rail Seat)
DFC LINE: 60Kg/m (UIC 60Kg/m)	IR Line DFC
IR MAIN LINE: 52Kg/m	172mm 172mm
RUBBER PAD	6mm 10mm
SLEEPER DEPTH	210mm 210mm
BALLAST CUSHION	300mm 350mm
Total Depth (FL TO RL)	688mm 742mm

OWNER
DEDICATED FREIGHT CORRIDOR CORPORATION OF INDIA LTD.
(A GOVERNMENT OF INDIA ENTERPRISE)
PROJECT OFFICE (AMBALA UNIT): OLD RAILWAY COLONY (NEAR ANAND MARKET), AMBALA CANTT-133001.
CORPORATE IDENTITY NO. : U60232DL2006GCI155068

ENGINEER:
DB Engineering & Consulting GmbH
Deutsche Bahn Engineering & Consulting GmbH

CONTRACTOR:
GIL - TPL JV
GAR TATA

SUBMITTED BY	GIL - TPL JV		
	DATED	NAME	SIGNATURE
PREPARED BY			
CHECKED BY	26.09.2024	VIJAY PRATAP	
APPROVED BY	26.09.2024	PARASURAM KOTYADA	
APPROVED BY	DEUTSCHE BAHN ENGINEERING & CONSULTING GMBH		
	DATED	NAME	SIGNATURE
Sr. DE./CHIEF ENGINEER		SURESH K.YALANGI	
CHIEF TRACK ENGINEER		RAJ PAL SINGH	
T.L.		H.D. VIJAK	

STAMP
A AS-BUILT DRAWING
TR. Ref.:.....
ENGINEER Sign.:

EMPLOYER (DFCCIL): DEDICATED FREIGHT CORRIDOR CORPORATION OF INDIA LTD.

AS BUILT DRAWING

TITLE AS-BUILT PLAN AND PROFILE DFC KM:1209.905 TO 1210.395 (DETOUR END CH: 1210395.373)	DFCC APPR. NO. - ENGG. APPR. NO. - DRG. NO. - 301-2/AL/A/1264 SHEET NO. : 1 OF 1 DATE : 26.09.2024	STATUS A
---	--	-------------

TR.