


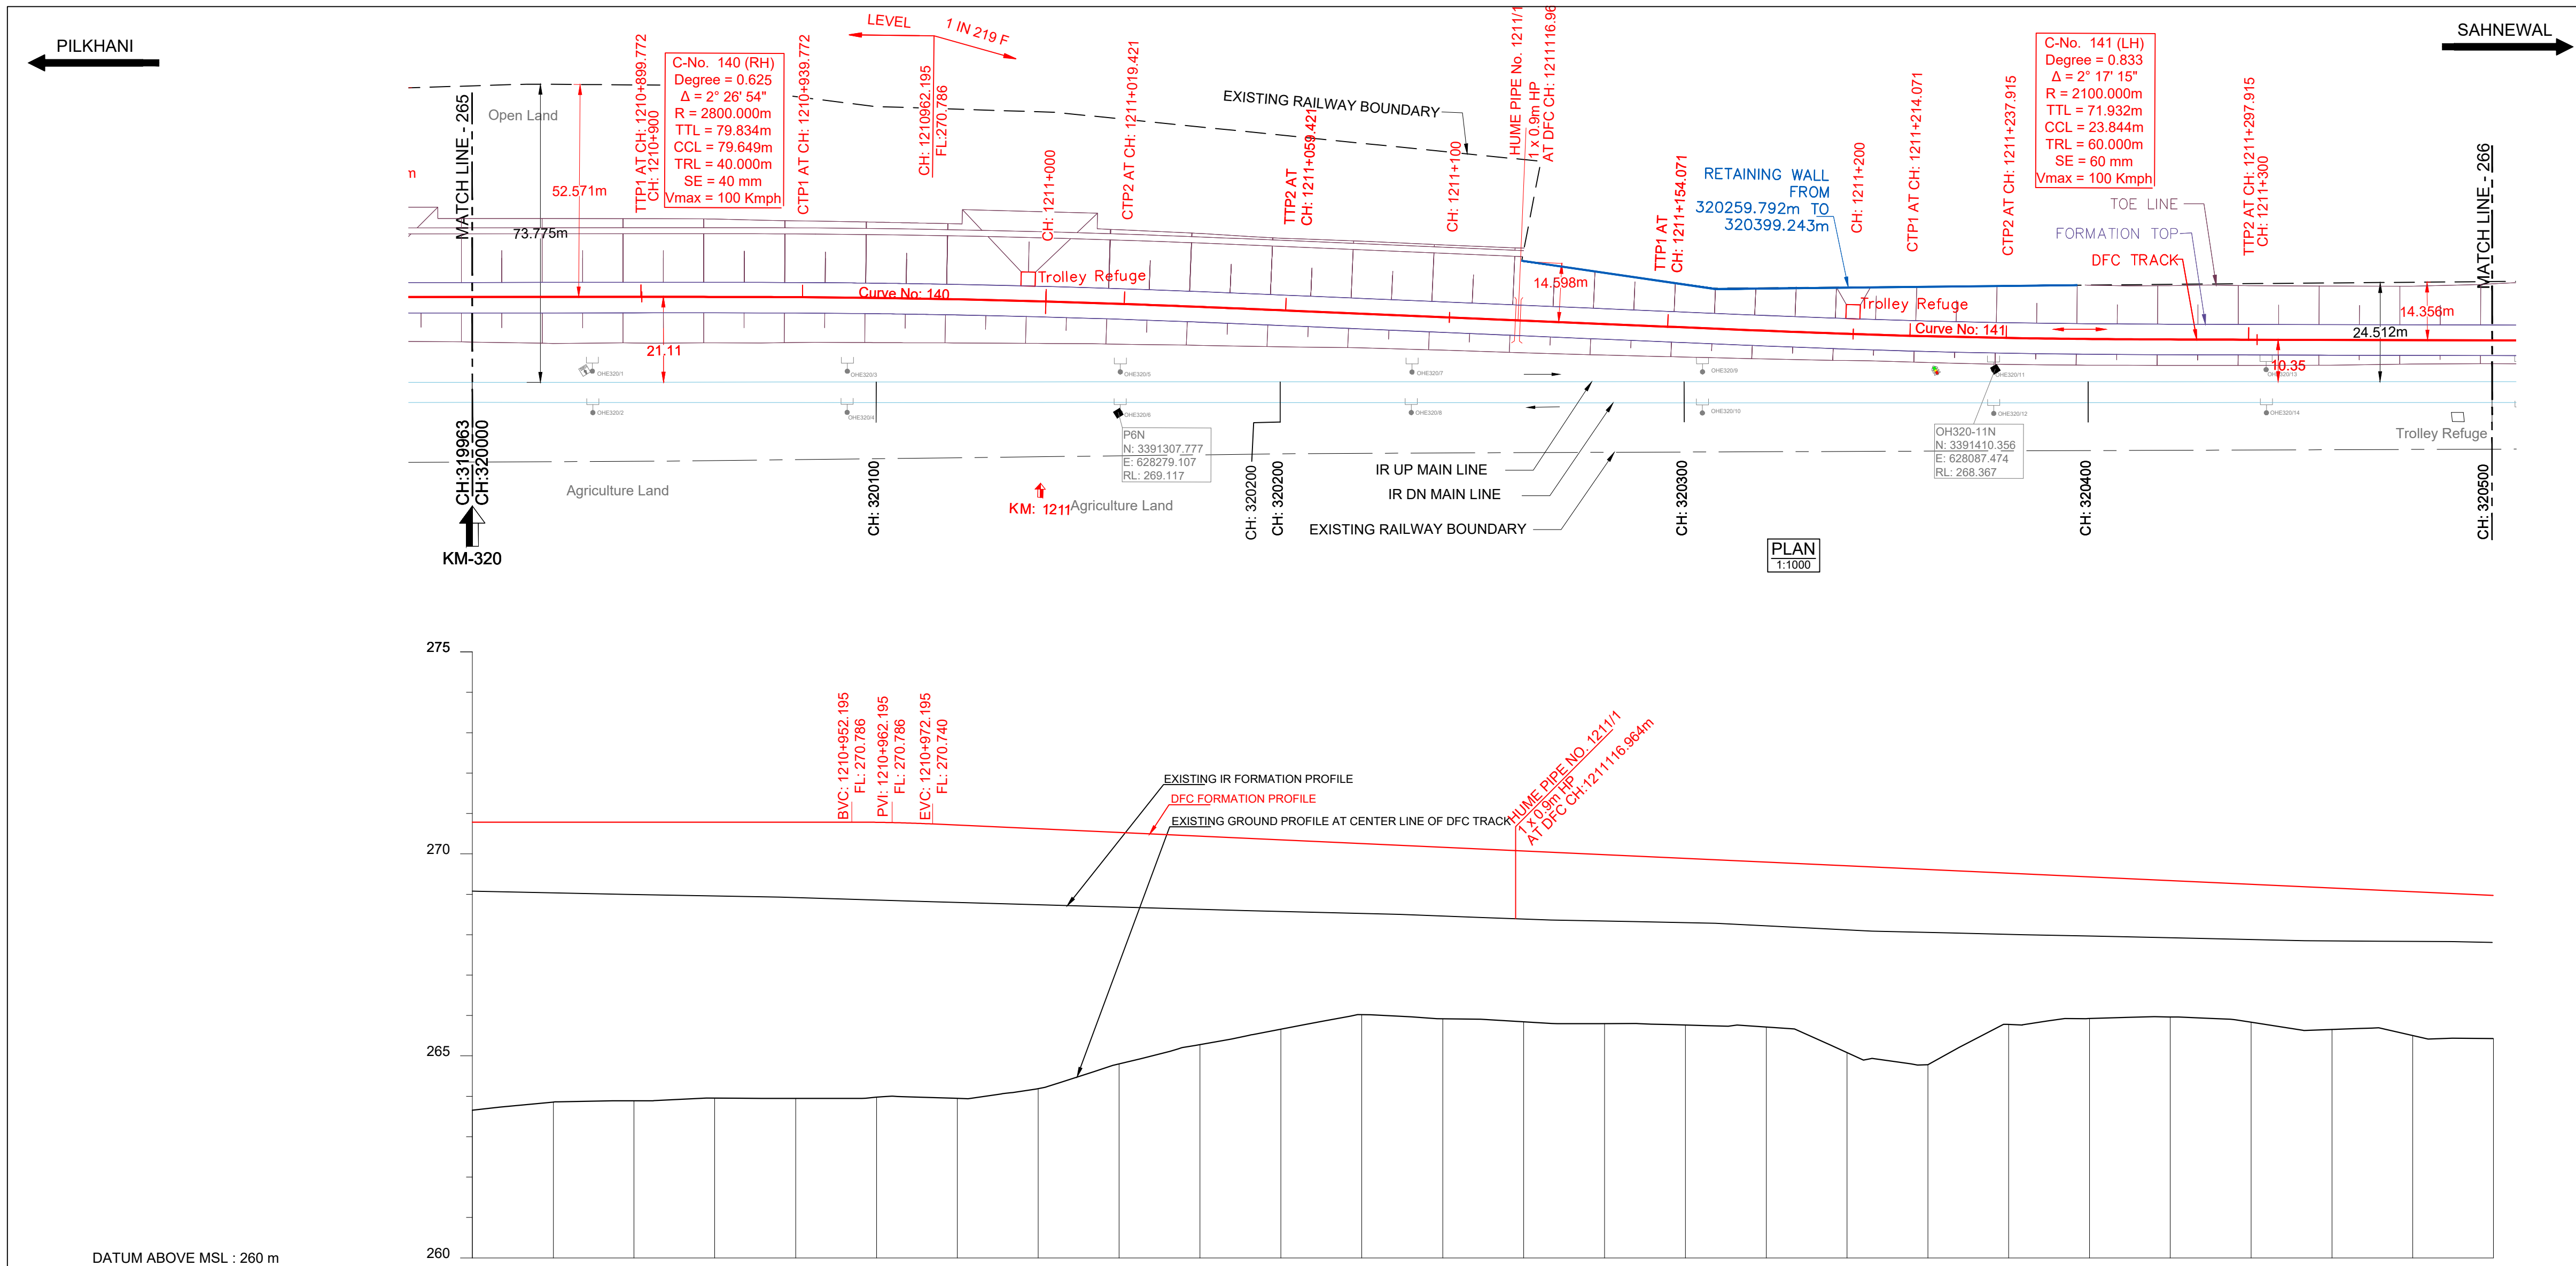


DATUM ABOVE MSL : 260 m

HORIZONTAL ALIGNMENT	L = 524.646m TL= 40m R=2800m TL= 40m L = 94.650m TL= 60m R =2100m TL= 60m L = 170.347m																							
VERTICAL ALIGNMENT	L=1254.449 m LEVEL L=20.0 m R=4372 m L=465.900 m 1 IN 218.578 F																							
TRACK DISTANCE FROM EXISTING NEAREST IR UP MAIN LINE TO DFC MAIN LINE	21.120	21.120	21.125	21.127	21.073	20.965	20.782	20.444	19.936	19.297	18.547	17.711	16.846	15.992	15.147	14.287	13.422	12.587	11.841	11.236	10.569	9.877	9.280	8.687
HEIGHT OF BANKING(+) / DEPTH OF CUTTING(-) (PFL-GL)	+7.131	+6.929	+6.897	+6.832	+6.837	+6.804	+6.764	+6.433	+5.730	+5.160	+4.687	+4.234	+4.245	+4.228	+4.181	+4.124	+4.081	+3.744	+3.829	+3.376	+3.413	+3.503	+3.560	+3.545
EXG GROUND LEVEL AT CENTER LINE OF DFC TRACK (GL)	263.655	263.857	263.889	263.954	263.949	263.978	263.948	264.188	264.799	265.278	265.660	266.021	265.918	265.844	265.800	265.765	265.716	265.779	265.925	265.964	265.836	265.654	265.506	265.429
EXG GROUND LEVEL AT TOE LOCATION OF DFC TRACK	263.513	263.517	263.540	263.596	263.796	263.870	263.853	263.796	263.881	263.887	263.970	263.822	263.765	263.638	263.539	263.431	263.300	263.398	264.085	264.465	264.342	264.281	264.183	264.066
DIFFERENCE BETWEEN DFC FORMATION LEVEL AND EXG.FORMATION LEVEL.(PFL-EFL)	1.706	1.750	1.792	1.828	1.868	1.928	1.913	1.879	1.844	1.810	1.773	1.731	1.700	1.682	1.643	1.591	1.576	1.587	1.558	1.416	1.369	1.312	1.232	1.164
DFC FORMATION LEVEL (PFL)	270.786	270.786	270.786	270.786	270.786	270.786	270.712	270.621	270.529	270.438	270.347	270.255	270.163	270.072	269.981	269.889	269.797	269.706	269.614	269.523	269.340	269.249	269.157	269.066
EXG. FORMATION LEVEL OF EXG IR UP MAIN LINE (EFL)	269.080	269.036	268.994	268.958	268.918	268.858	268.799	268.742	268.685	268.628	268.574	268.524	268.463	268.390	268.338	268.298	268.221	268.119	268.056	268.008	267.924	267.880	267.845	267.834
DIFFERENCE BETWEEN DFC RAIL LEVEL AND EXG. RAIL LEVEL (PRL - ERL)	1.747	1.791	1.833	1.869	1.909	1.969	1.954	1.918	1.883	1.849	1.811	1.769	1.740	1.721	1.681	1.630	1.616	1.627	1.598	1.558	1.457	1.412	1.353	1.273
DFC RAIL LEVEL (PRL)	271.499	271.499	271.499	271.499	271.499	271.499	271.425	271.333	271.241	271.149	271.057	270.966	270.874	270.783	270.692	270.600	270.509	270.418	270.327	270.238	270.145	269.963	269.870	269.779
EXG.RAIL LEVEL OF NEAREST IR UP MAIN LINE(ERL)	269.752	269.708	269.666	269.630	269.590	269.530	269.471	269.414	269.357	269.300	269.246	269.196	269.135	269.062	269.010	268.970	268.893	268.791	268.728	268.680	268.596	268.552	268.517	268.506
EQUIVALENT CHAINAGE ON DFC TRACK	1210857.9	1210878.0	1210898.0	1210918.0	1210938.1	1210958.2	1210978.4	1210998.5	1211018.7	1211038.7	1211058.8	1211078.7	1211098.7	1211118.7	1211138.7	1211158.6	1211178.6	1211198.5	1211218.4	1211237.8	1211258.2	1211278.2	1211297.8	1211318.2
EXISTING IR CHAINAGE	319962.7	320000.0	320020.0	320040.0	320060.0	320080.0	320100.0	320120.0	320140.0	320160.0	320180.0	320200.0	320220.0	320240.0	320260.0	320280.0	320300.0	320320.0	320340.0	320360.0	320380.0	320400.0	320420.0	320440.0

L - SECTION

SAHNEWAL

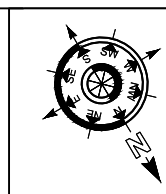

- NOTE:-
- DFCC WORKS ARE SHOWN IN RED.
 - IR NEW WORKS ARE SHOWN IN VIOLET.
 - ALL DIMENSIONS ARE SHOWN IN METRES.
 - THIS DRAWING IS PREPARED BASED ON LATEST SURVEY DATA HELD ON APRIL-2022. GTS BENCH MARK OF 261.850M CONSIDERED ON TOP OF CANAL BRIDGE ABUTMENT AT DORANA VILLAGE ALONG THE NH1.
 - DFC NEW CHAINAGE OF 1075.950M IS WITH REFERENCE TO THE IR KM OF 187.500KM END OF KM OF CP-303(SECTION P-3 PILKHANI END) AGAINST THE EXISTING DFC CHAINAGE. 116277.742M ISSUED VIDE LETTER NO. COM/DFCC/MB/SURVEY/2021-301-2301/16-011/73 DT. 17.01.2023
 - BALLAST PROFILE HAS BEEN PROVIDED ACCORDING TO THE CLAUSE 1.11.3 OF STANDARD SCHEDULE OF DIMENSION(EASTERN CORRIDOR) & THE BALLAST CUSHION DIMENSION SHOWN IN 35CM ON GE-14 PARA 17. SPECIFICATIONS & RECOMMENDATIONS 2. TWO LAYER SYSTEM FIG.10.

- REFERENCE DRAWINGS :-
- FOR KEY PLAN REFER DRAWING NO. 301-2/AL/0001
 - FOR LEGEND AND ABBREVIATIONS REFER DRAWING NO. 301-2/AL/1000
 - FOR TYPICAL SECTION OF BALLAST PROFILE (FL-RL) REFER DRG. NO. 301-2/TK/TFD/004 (TR.1952)

0	26.09.2024	SUBMISSION OF AS-BUILT DRAWING	FOR APPROVAL
REV.	DATE	REVISION DETAILS	PURPOSE OF ISSUE

LEGEND:


SCALE

HOR - 1:1000

VER - 1:100

SHEET SIZE : A1

IR TRACK
DFCC TRACK
DFCC FUTURE PROPOSALS
STRUCTURE / BUILDING
DFCC TOE LINE
DFCC FORMATION
RETAINING WALL
ROAD
STREAM, DRAIN, NALA, CANAL.
FENCE
POWER LINES
TBM
ELECTRIC POLE/OHE MAST
IR RAILWAY BOUNDARY
DFCC BOUNDARY

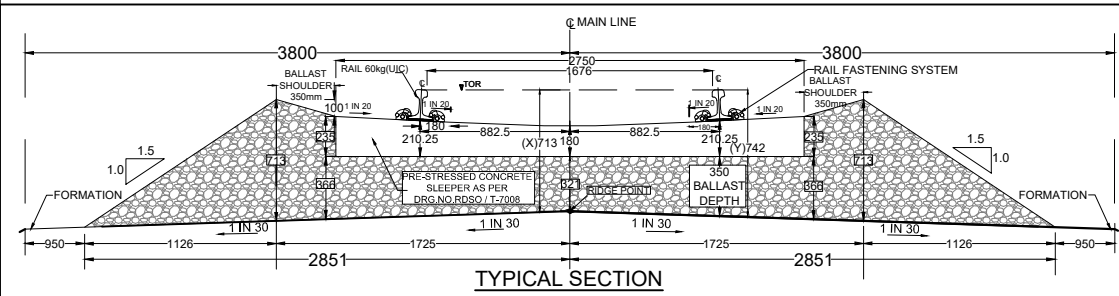

TRACK STRUCTURE		
RAIL SECTION: 60Kg/m (UIC 60Kg/m) DFC LINE: 60Kg/m (UIC 60Kg/m) IR MAIN LINE: 52Kg/m	Difference between FL- RL (Below Rail Seat)	
	IR Line	DFC
RUBBER PAD	172mm	172mm
SLEEPER DEPTH	6mm	10mm
BALLAST CUSHION	210mm	210mm
	300mm	350mm
Total Depth (FL TO RL)	688mm	742mm

OWNER

DEDICATED FREIGHT CORRIDOR CORPORATION OF INDIA LTD.

(A GOVERNMENT OF INDIA ENTERPRISE)

PROJECT OFFICE(AMBALA UNIT): OLD RAILWAY COLONY (NEAR ANAND MARKET),AMBALA CANTT-133001.

CORPORATE IDENTITY NO. : U60232DL2006GGI155068

ENGINEER:

DB Engineering & Consulting GmbH

Deutsche Bahn Engineering & Consulting GmbH

CONTRACTOR:

GIL - TPL JV

GAR TATA

SUBMITTED BY	GIL - TPL JV		
	DATED	NAME	SIGNATURE
PREPARED BY			
CHECKED BY	26.09.2024	VIJAY PRATAP	
APPROVED BY	26.09.2024	PARASURAM KOTYADA	
APPROVED BY	DEUTSCHE BAHN ENGINEERING & CONSULTING GMBH		
	DATED	NAME	SIGNATURE
Sr. DE./CHIEF ENGINEER		SURESH K.YALANGI	
CHIEF TRACK ENGINEER		RAJ PAL SINGH	
T.L.		H.D. VIDJAK	

STAMP

AS-BUILT DRAWING

TR. Ref.....

ENGINEER Sign.:

EMPLOYER (DFCCIL): DEDICATED FREIGHT CORRIDOR CORPORATION OF INDIA LTD.

AS BUILT DRAWING		
TITLE	DFCC APPR. NO. -	
AS-BUILT PLAN AND PROFILE	ENGG. APPR. NO. -	
FROM IR KM: 320.000 TO 320.500	DRG. NO. - 301-2/AL/A/1266	
DFC KM:1210.858 TO 1211.358	SHEET NO. : 1 OF 1	STATUS
	DATE : 26.09.2024	A

TR.