


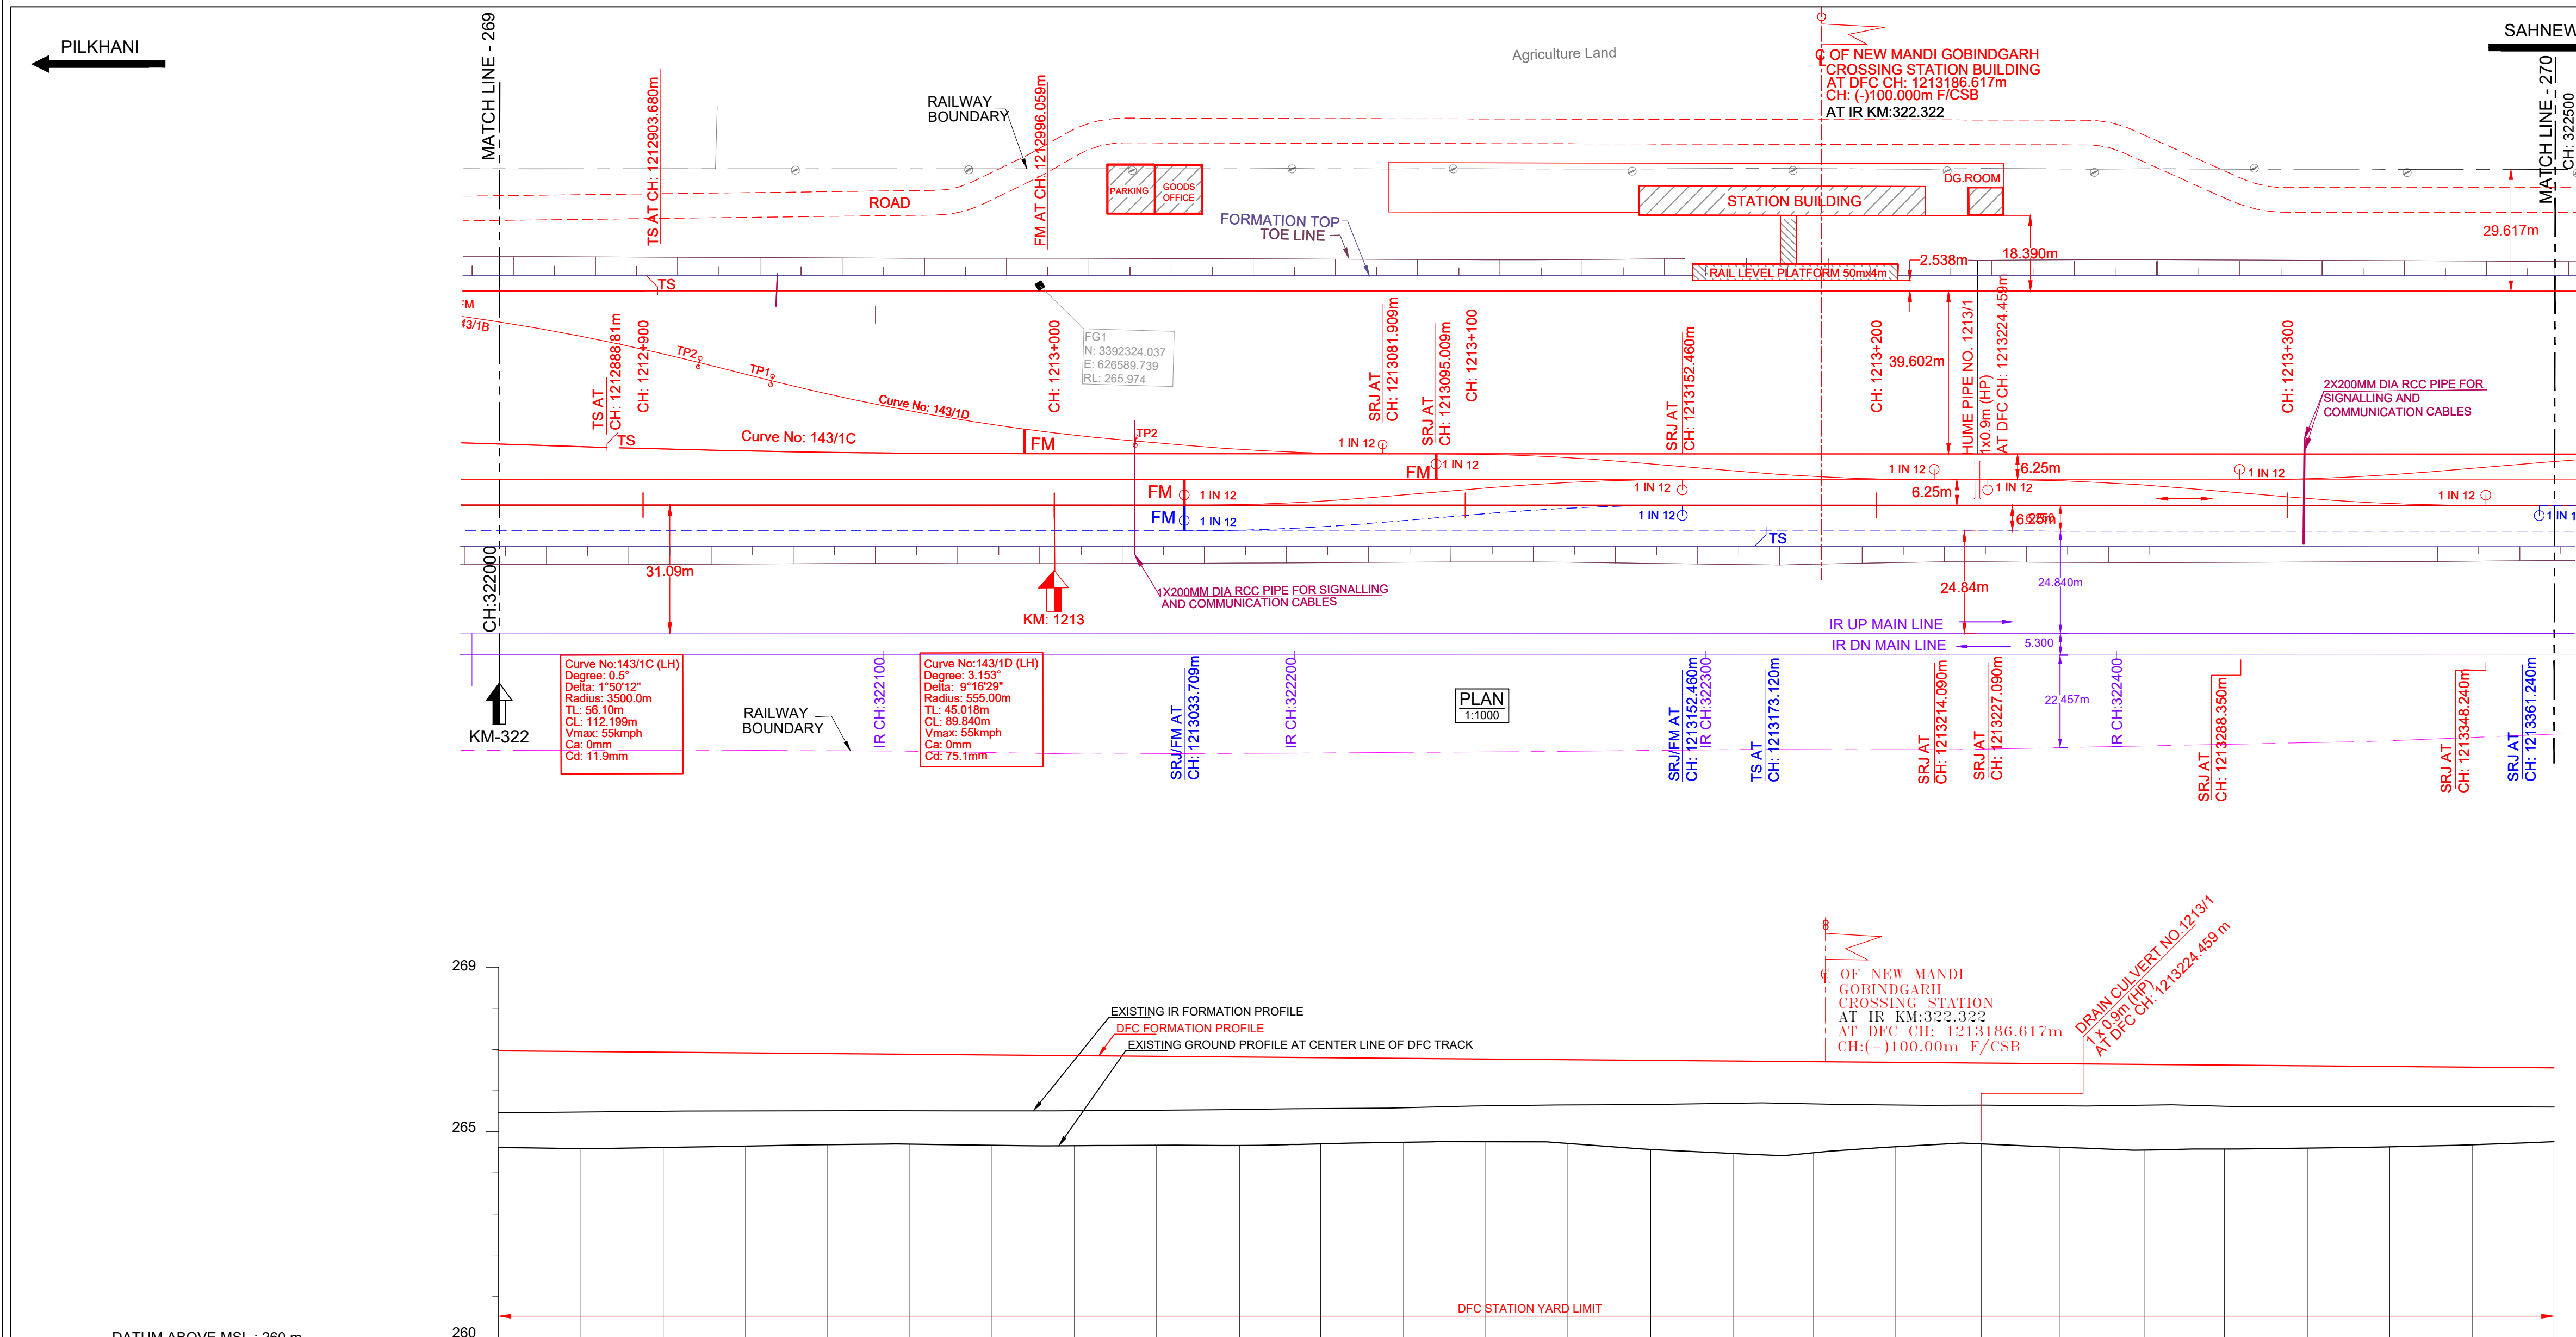

HORIZONTAL ALIGNMENT	L = 2464.208m																			
VERTICAL ALIGNMENT	L=1915.351 m 1 IN 1200 F																			
TRACK DISTANCE FROM EXISTING NEAREST IR UP MAIN LINE TO DFC MAIN LINE	60.743	60.742	60.742	60.742	60.749	60.758	60.759	60.751	60.746	60.753	60.765	60.779	60.749	60.770	60.741	60.763	60.828	60.813	60.744	60.842
HEIGHT OF BANKING(+) / DEPTH OF CUTTING(-) (PFL-GL)	+2.411	+2.421	+2.377	+2.326	+2.273	+2.247	+2.256	+2.250	+2.223	+2.213	+2.164	+2.099	+2.071	+2.094	+2.222	+2.306	+2.272	+2.110	+2.021	+2.087
EXG GROUND LEVEL AT CENTER LINE OF DFC TRACK (GL)	264.616	264.589	264.617	264.651	264.687	264.697	264.671	264.660	264.671	264.684	264.706	264.745	264.756	264.716	264.612	264.521	264.502	264.624	264.705	264.623
EXG GROUND LEVEL AT TOE LOCATION OF DFC TRACK	264.601	264.586	264.615	264.636	264.679	264.692	264.676	264.664	264.672	264.674	264.706	264.739	264.745	264.718	264.612	264.521	264.502	264.624	264.698	264.624
DIFFERENCE BETWEEN DFC FORMATION LEVEL AND EXG.FORMATION LEVEL (PFL-EFL)	1.563	1.530	1.494	1.470	1.451	1.434	1.419	1.400	1.369	1.335	1.296	1.259	1.197	1.156	1.132	1.087	1.095	1.094	1.078	1.079
DFC FORMATION LEVEL (PFL)	267.027	267.010	266.994	266.977	266.960	266.944	266.927	266.910	266.894	266.877	266.860	266.844	266.827	266.810	266.793	266.777	266.760	266.744	266.726	266.710
EXG. FORMATION LEVEL OF EXG IR UP MAIN LINE (EFL)	265.464	265.480	265.500	265.507	265.509	265.510	265.508	265.510	265.525	265.542	265.564	265.585	265.630	265.654	265.661	265.680	265.675	265.650	265.648	265.631
DIFFERENCE BETWEEN DFC RAIL LEVEL AND EXG. RAIL LEVEL (PRL - ERL)	1.604	1.571	1.534	1.511	1.492	1.475	1.460	1.441	1.409	1.376	1.338	1.299	1.238	1.197	1.174	1.127	1.126	1.135	1.120	1.121
DFC RAIL LEVEL (PRL)	267.740	267.723	267.707	267.690	267.673	267.657	267.640	267.623	267.607	267.590	267.573	267.557	267.540	267.523	267.506	267.490	267.473	267.457	267.439	267.423
EXG.RAIL LEVEL OF NEAREST IR UP MAIN LINE(ERL)	266.136	266.152	266.172	266.179	266.181	266.182	266.180	266.182	266.197	266.214	266.236	266.257	266.302	266.326	266.333	266.362	266.347	266.322	266.293	266.303
EQUIVALENT CHAINAGE ON DFC TRACK	1212863.9	1212883.9	1212903.9	1212923.9	1212943.9	1212963.9	1212983.9	1213003.9	1213023.9	1213043.9	1213063.9	1213083.9	1213103.9	1213124.0	1213144.0	1213164.1	1213183.7	1213203.7	1213224.0	1213240.0
EXISTING IR CHAINAGE	322000.0	322020.0	322040.0	322060.0	322080.0	322100.0	322120.0	322140.0	322160.0	322180.0	322200.0	322220.0	322240.0	322260.0	322280.0	322300.0	322320.0	322340.0	322360.0	322380.0

L - SECTION

NOTE:-

- DFCC WORKS ARE SHOWN IN RED.
- IR NEW WORKS ARE SHOWN IN VIOLET.
- ALL DIMENSIONS ARE SHOWN IN METRES.
- THIS DRAWING IS PREPARED BASED ON LATEST SURVEY DATA HELD ON APRIL-2022. GTS BENCH MARK OF 261.850M CONSIDERED ON TOP OF CANAL BRIDGE ABUTMENT AT DORANA VILLAGE ALONG THE NH1.
- DFC NEW CHAINAGE OF 1075.950M IS WITH REFERENCE TO THE IR KM OF 187.500KM END OF KM OF CP-303(SECTION P-3 PILKHANI END) AGAINST THE EXISTING DFC CHAINAGE. 116277.742M ISSUED VIDE LETTER NO. COM/DFCC/UMBSURVEY/2021-301-230116-011173 DT. 17.01.2023.
- BALLAST PROFILE HAS BEEN PROVIDED ACCORDING TO THE CLAUSE 1.11.3 OF STANDARD SCHEDULE OF DIMENSION(EASTERN CORRIDOR) & THE BALLAST CUSHION DIMENSION SHOWN IN 35CM ON GE-14 PARA 17. SPECIFICATIONS & RECOMMENDATIONS 2. TWO LAYER SYSTEM FIG.10.

REFERENCE DRAWINGS :-

- FOR KEY PLAN REFER DRAWING NO. 301-2/AL/0001
- FOR LEGEND AND ABBREVIATIONS REFER DRAWING NO. 301-2/AL/1000
- FOR TYPICAL SECTION OF BALLAST PROFILE (FL-RL) REFER DRG. NO. 301-2/TK/TFDI-004 (TR.1952)

0	26.09.2024	SUBMISSION OF AS-BUILT DRAWING	FOR APPROVAL
REV.	DATE	REVISION DETAILS	PURPOSE OF ISSUE

SCALE
HOR - 1:1000
VER - 1:100
SHEET SIZE : A1

LEGEND:

- IR TRACK
- DFCC TRACK
- DFCC FUTURE PROPOSALS
- STRUCTURE / BUILDING
- DFCC TOE LINE
- DFCC FORMATION
- RETAINING WALL
- ROAD
- STREAM, DRAIN, NALA, CANAL.
- FENCE
- POWER LINES
- TBM
- ELECTRIC POLE/OHE MAST
- IR RAILWAY BOUNDARY
- DFCC BOUNDARY

TYPICAL SECTION

TRACK STRUCTURE													
RAIL SECTION: 60Kg/m (UIC 60Kg/m) DFC LINE: 60Kg/m (UIC 60Kg/m) IR MAIN LINE: 52Kg/m	Difference between FL- RL (Below Rail Seat) <table><tr><th>IR Line</th><th>DFC</th></tr><tr><td>172mm</td><td>172mm</td></tr><tr><td>6mm</td><td>10mm</td></tr><tr><td>210mm</td><td>210mm</td></tr><tr><td>300mm</td><td>350mm</td></tr><tr><td>Total Depth (FL TO RL)</td><td>688mm 742mm</td></tr></table>	IR Line	DFC	172mm	172mm	6mm	10mm	210mm	210mm	300mm	350mm	Total Depth (FL TO RL)	688mm 742mm
IR Line	DFC												
172mm	172mm												
6mm	10mm												
210mm	210mm												
300mm	350mm												
Total Depth (FL TO RL)	688mm 742mm												
RUBBER PAD													
SLEEPER DEPTH													
BALLAST CUSHION													

OWNER
DEDICATED FREIGHT CORRIDOR CORPORATION OF INDIA LTD.
(A GOVERNMENT OF INDIA ENTERPRISE)
PROJECT OFFICE(AMBALA UNIT): OLD RAILWAY COLONY (NEAR ANAND MARKET),AMBALA CANTT-133001.
CORPORATE IDENTITY NO. : U60232DL20060G0155068

ENGINEER:
DB Engineering & Consulting GmbH
Deutsche Bahn Engineering & Consulting GmbH

CONTRACTOR:
GIL - TPL JV
GAR TATA

SUBMITTED BY	GIL - TPL JV		
	DATED	NAME	SIGNATURE
PREPARED BY			
CHECKED BY	26.09.2024	VIJAY PRATAP	
APPROVED BY	26.09.2024	PARASURAM KOTYADA	
APPROVED BY	DEUTSCHE BAHN ENGINEERING & CONSULTING GMBH		
	DATED	NAME	SIGNATURE
Sr. DE./CHIEF ENGINEER		SURESH K.YALANGI	
CHIEF TRACK ENGINEER		RAJ PAL SINGH	
T.L.		H.D. VIDJAK	

STAMP
A AS-BUILT DRAWING
TR. Ref.:.....
ENGINEER Sign.:.....

EMPLOYER (DFCCIL): DEDICATED FREIGHT CORRIDOR CORPORATION OF INDIA LTD.

AS BUILT DRAWING

TITLE AS-BUILT PLAN AND PROFILE FROM IR KM: 322.000 TO 322.500 DFC KM:1212.864 TO 1213.364	DFCC APPR. NO. - ENGG. APPR. NO. - DRG. NO. -301-2/AL/A/1270 SHEET NO.: 1 OF 1 DATE : 26.09.2024	STATUS A
---	--	-------------

TR.