


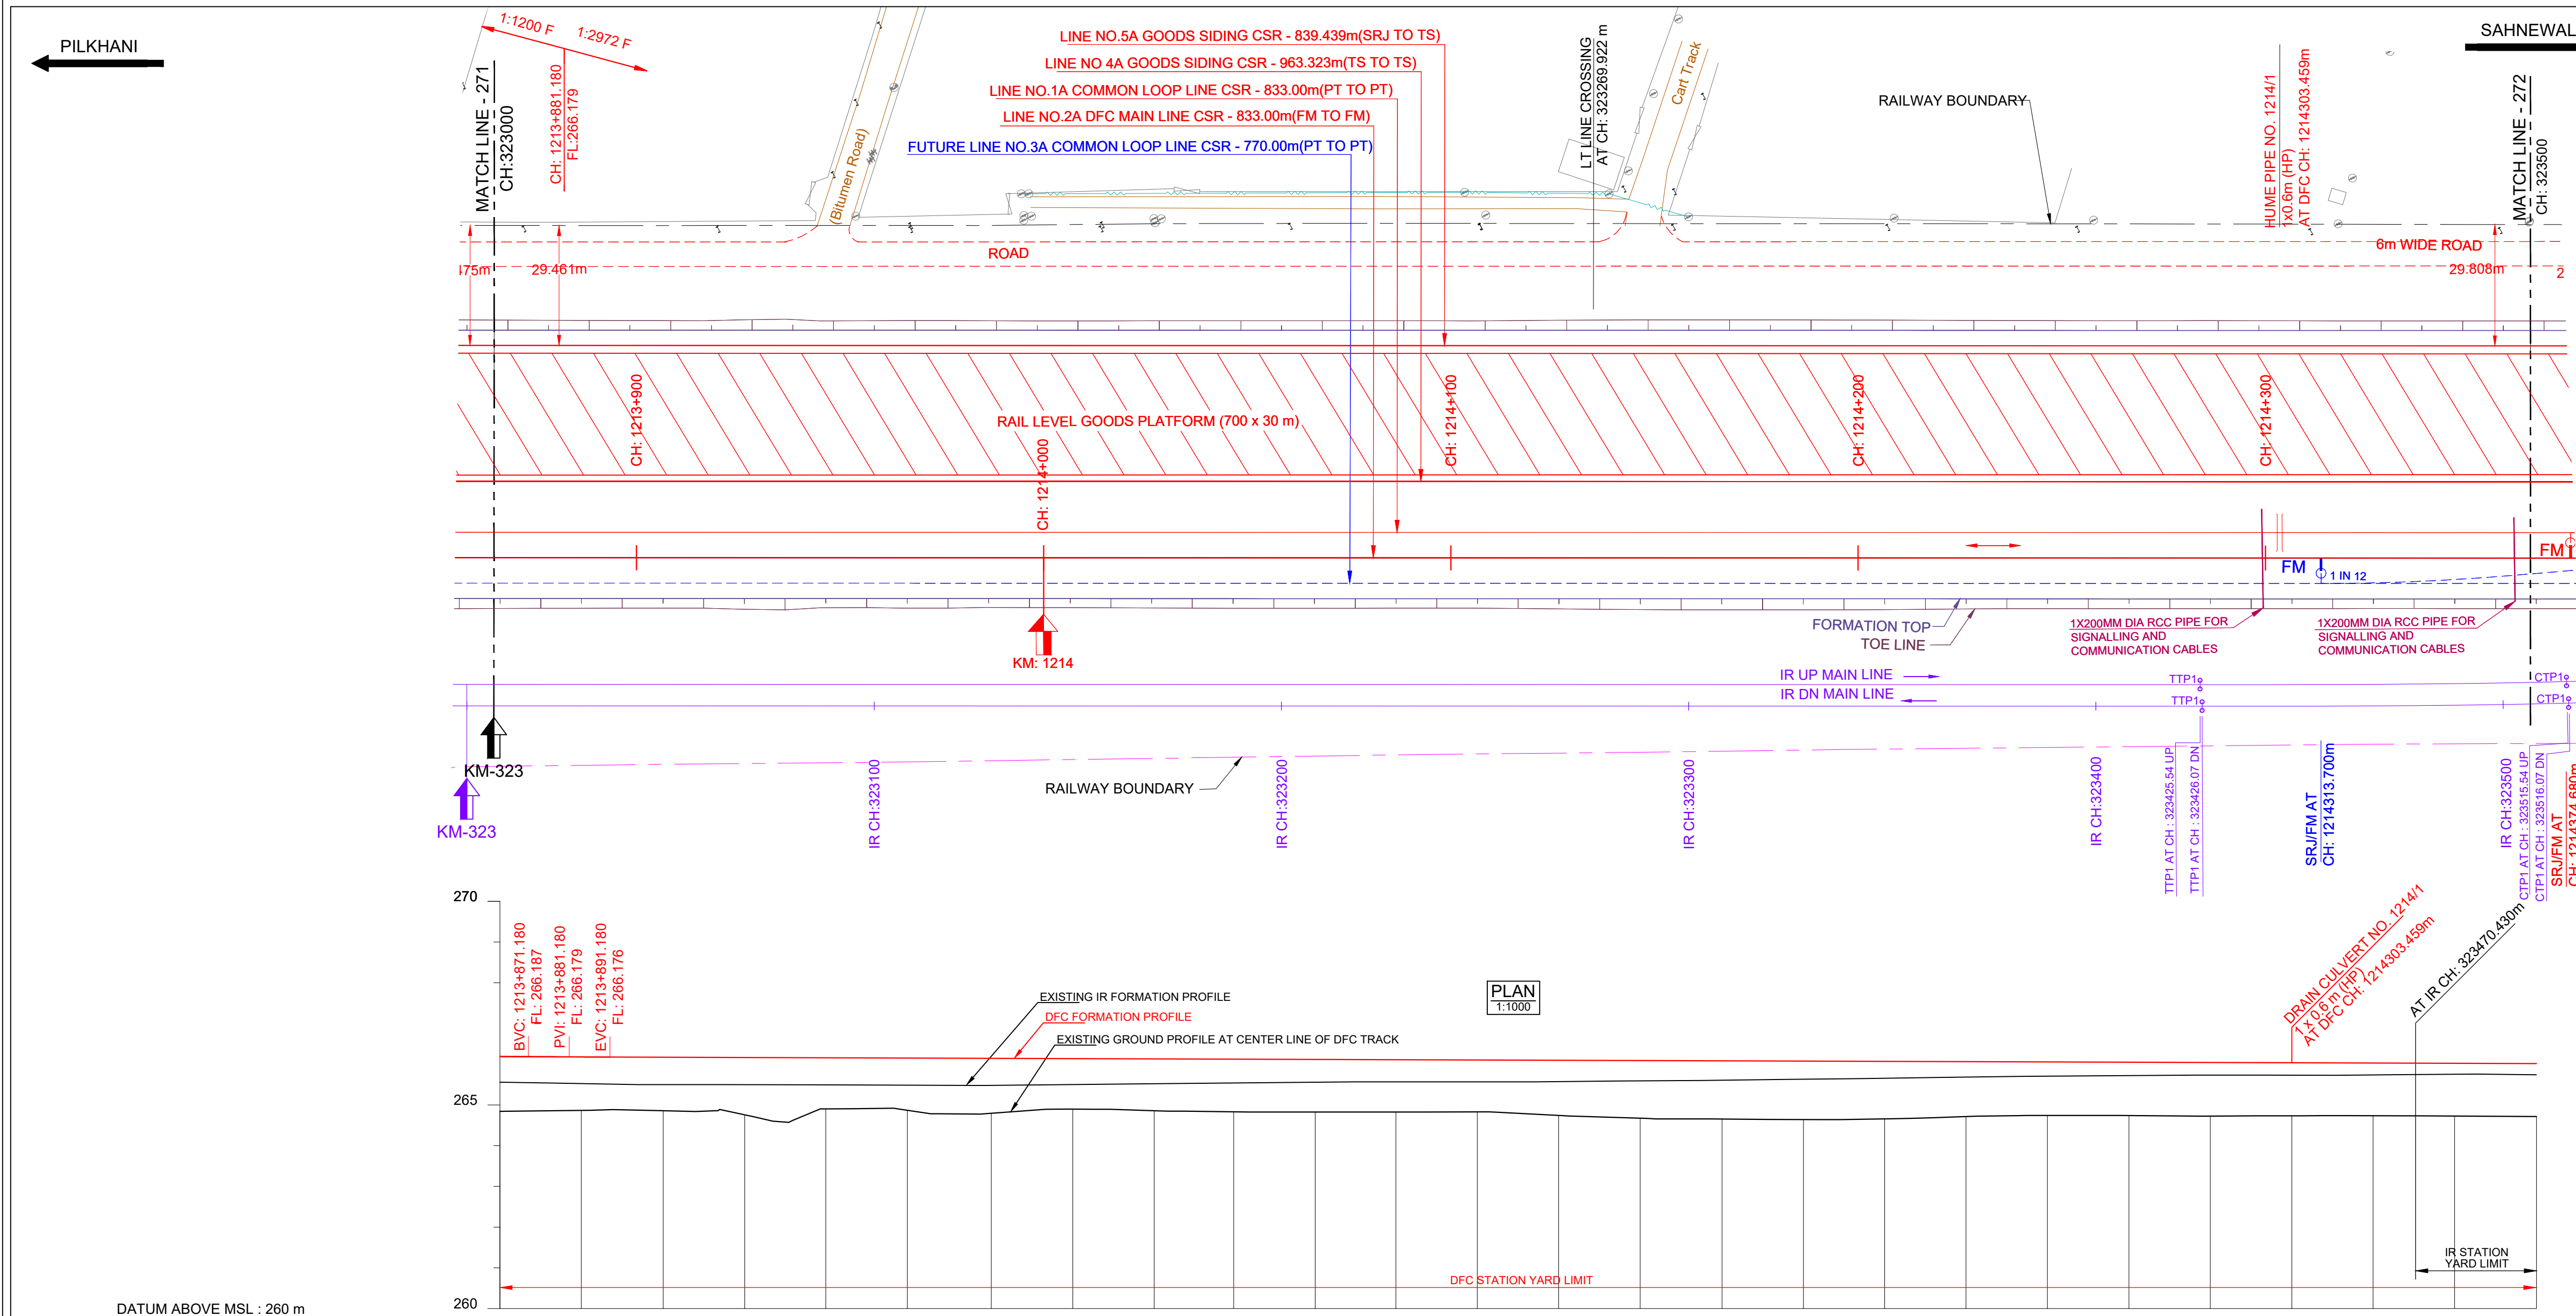

HORIZONTAL ALIGNMENT	L = 2464.208m																						
VERTICAL ALIGNMENT	L=1915.335 m T IN 2000 F L=20.0 m R=40254 m L=1549.010 m T IN 2971.880 F																						
TRACK DISTANCE FROM EXISTING NEAREST IR UP MAIN LINE TO DFC MAIN LINE	60.543	60.530	60.528	60.550	60.566	60.560	60.573	60.774	60.975	61.050	61.094	61.109	61.095	61.045	61.055	61.058	61.023	60.999	60.976	60.951	60.889	60.882	
HEIGHT OF BANKING(+) / DEPTH OF CUTTING(-) (PFL-GL)	+1.353	+1.312	+1.314	+1.407	+1.254	+1.282	+1.348	+1.238	+1.272	+1.294	+1.291	+1.285	+1.274	+1.431	+1.437	+1.414	+1.348	+1.315	+1.311	+1.304	+1.298	+1.301	
EXG GROUND LEVEL AT CENTER LINE OF DFC TRACK (GL)	264.841	264.866	264.857	264.757	264.904	264.869	264.796	264.895	264.859	264.830	264.826	264.826	264.833	264.653	264.640	264.656	264.715	264.742	264.739	264.733	264.735	264.715	
EXG GROUND LEVEL AT TOE LOCATION OF DFC TRACK	264.831	264.870	264.892	264.796	264.899	264.850	264.865	264.885	264.857	264.839	264.828	264.824	264.833	264.741	264.686	264.684	264.718	264.744	264.745	264.737	264.729	264.721	
DIFFERENCE BETWEEN DFC FORMATION LEVEL AND EXG.FORMATION LEVEL.(PFL-EFL)	0.636	0.654	0.672	0.668	0.665	0.666	0.665	0.638	0.611	0.584	0.559	0.543	0.536	0.477	0.447	0.416	0.381	0.350	0.329	0.306	0.270	0.276	
DFC FORMATION LEVEL (PFL)	266.194	266.178	266.171	266.164	266.158	266.151	266.144	266.137	266.131	266.124	266.117	266.111	266.104	266.084	266.077	266.070	266.063	266.057	266.050	266.043	266.037	266.023	
EXG. FORMATION LEVEL OF EXG IR UP MAIN LINE (EFL)	265.558	265.524	265.499	265.497	265.493	265.485	265.479	265.499	265.520	265.540	265.559	265.568	265.568	265.607	265.630	265.654	265.683	265.707	265.721	265.733	265.753	265.740	
DIFFERENCE BETWEEN DFC RAIL LEVEL AND EXG. RAIL LEVEL (PRL - ERL)	0.677	0.695	0.714	0.709	0.706	0.707	0.706	0.679	0.652	0.625	0.600	0.584	0.577	0.518	0.488	0.457	0.422	0.391	0.370	0.334	0.311	0.317	
DFC RAIL LEVEL (PRL)	266.907	266.881	266.884	266.878	266.871	266.864	266.857	266.850	266.844	266.837	266.830	266.824	266.817	266.797	266.790	266.783	266.777	266.770	266.763	266.757	266.750	266.736	
EXG.RAIL LEVEL OF NEAREST IR UP MAIN LINE(ERL)	266.230	266.196	266.171	266.169	266.165	266.157	266.151	266.171	266.192	266.212	266.231	266.240	266.240	266.279	266.302	266.326	266.355	266.379	266.393	266.405	266.425	266.412	
EQUIVALENT CHAINAGE ON DFC TRACK	-1213863.9	-1213883.9	-1213904.0	-1213924.0	-1213943.9	-1213963.9	-1213984.5	-1214004.5	-1214024.5	-1214044.0	-1214064.0	-1214083.9	-1214103.9	-1214123.8	-1214143.8	-1214203.9	-1214223.9	-1214243.8	-1214263.8	-1214283.8	-1214303.8	-1214363.9	
EXISTING IR CHAINAGE	323000.0	323020.0	323040.0	323060.0	323080.0	323100.0	323120.0	323140.0	323160.0	323180.0	323200.0	323220.0	323240.0	323260.0	323280.0	323300.0	323320.0	323340.0	323360.0	323380.0	323400.0	323460.0	

L - SECTION

NOTE:-

- DFCC WORKS ARE SHOWN IN RED.
- IR NEW WORKS ARE SHOWN IN VIOLET.
- ALL DIMENSIONS ARE SHOWN IN METRES.
- THIS DRAWING IS PREPARED BASED ON LATEST SURVEY DATA HELD ON APRIL-2022. GTS BENCH MARK OF 261.850M CONSIDERED ON TOP OF CANAL BRIDGE ABUTMENT AT DORAH VILLAGE ALONG THE NH1.
- DFC NEW CHAINAGE OF 1075.950M IS WITH REFERENCE TO THE IR KM OF 187.500KM END OF KM OF CP-303(SECTION P-3 PILKHANI END) AGAINST THE EXISTING DFC CHAINAGE. 116277.742M ISSUED VIDE LETTER NO. COM/DFCC/UMS/SURVEY/2021-301-230116-011173.DT. 17.01.2023.
- BALLAST PROFILE HAS BEEN PROVIDED ACCORDING TO THE CLAUSE 1.11.3 OF STANDARD SCHEDULE OF DIMENSION(EASTERN CORRIDOR) & THE BALLAST CUSHION DIMENSION SHOWN IN 35CM ON GE-14 PARA 17. SPECIFICATIONS & RECOMMENDATIONS 2. TWO LAYER SYSTEM FIG.10.

REFERENCE DRAWINGS :-

- FOR KEY PLAN REFER DRAWING NO. 301-2/AL/0001
- FOR LEGEND AND ABBREVIATIONS REFER DRAWING NO. 301-2/AL/1000
- FOR TYPICAL SECTION OF BALLAST PROFILE (FL-RL) REFER DRG. NO. 301-2/TK/TFDI-004 (TR.1952)

SCALE

HOR - 1:1000

VER - 1:100

SHEET SIZE : A1

LEGEND:

IR TRACK
DFCC TRACK
DFCC FUTURE PROPOSALS
STRUCTURE / BUILDING
DFCC TOE LINE
DFCC FORMATION
RETAINING WALL
ROAD
STREAM, DRAIN, NALA, CANAL.
FENCE
POWER LINES
TBM
ELECTRIC POLE/OHE MAST
IR RAILWAY BOUNDARY
DFCC BOUNDARY

TYPICAL SECTION

TRACK STRUCTURE

RAIL SECTION: 60Kg/m (UIC 60Kg/m) DFC LINE: 60Kg/m (UIC 60Kg/m) IR MAIN LINE: 52Kg/m	Difference between FL- RL (Below Rail Seat)	
	IR Line	DFC
RUBBER PAD	172mm	172mm
SLEEPER DEPTH	210mm	210mm
BALLAST CUSHION	300mm	350mm
Total Depth (FL TO RL)	688mm	742mm

OWNER

DEDICATED FREIGHT CORRIDOR CORPORATION OF INDIA LTD.

(A GOVERNMENT OF INDIA ENTERPRISE)

PROJECT OFFICE(AMBALA UNIT): OLD RAILWAY COLONY (NEAR ANAND MARKET),AMBALA CANTT-133001.

CORPORATE IDENTITY NO. : U60232DL2006GGI155068

ENGINEER:

DB Engineering & Consulting GmbH

Deutsche Bahn Engineering & Consulting GmbH

CONTRACTOR:

GIL - TPL JV

GAR TATA

SUBMITTED BY	GIL - TPL JV		
	DATED	NAME	SIGNATURE
PREPARED BY			
CHECKED BY	26.09.2024	VIJAY PRATAP	
APPROVED BY	26.09.2024	PARASURAM KOTYADA	

APPROVED BY

DEUTSCHE BAHN ENGINEERING & CONSULTING GMBH

	DATED	NAME	SIGNATURE
Sr. DE./CHIEF ENGINEER		SURESH K.YALANGI	
CHIEF TRACK ENGINEER		RAJ PAL SINGH	
T.L.		H.D. VIDJAK	

STAMP

A AS-BUILT DRAWING TR. Ref.:..... ENGINEER Sign.:.

EMPLOYER (DFCCIL): DEDICATED FREIGHT CORRIDOR CORPORATION OF INDIA LTD.

AS BUILT DRAWING

TITLE

AS-BUILT PLAN AND PROFILE

FROM IR KM: 323.000 TO 323.500

DFC KM:1213.864 TO 1214.364

DFCC APPR. NO. -

ENGG. APPR. NO. -

DRG. NO. -301-2/AL/A/1272

SHEET NO.: 1 OF 1

DATE: 26.09.2024

STATUS

A

TR.