


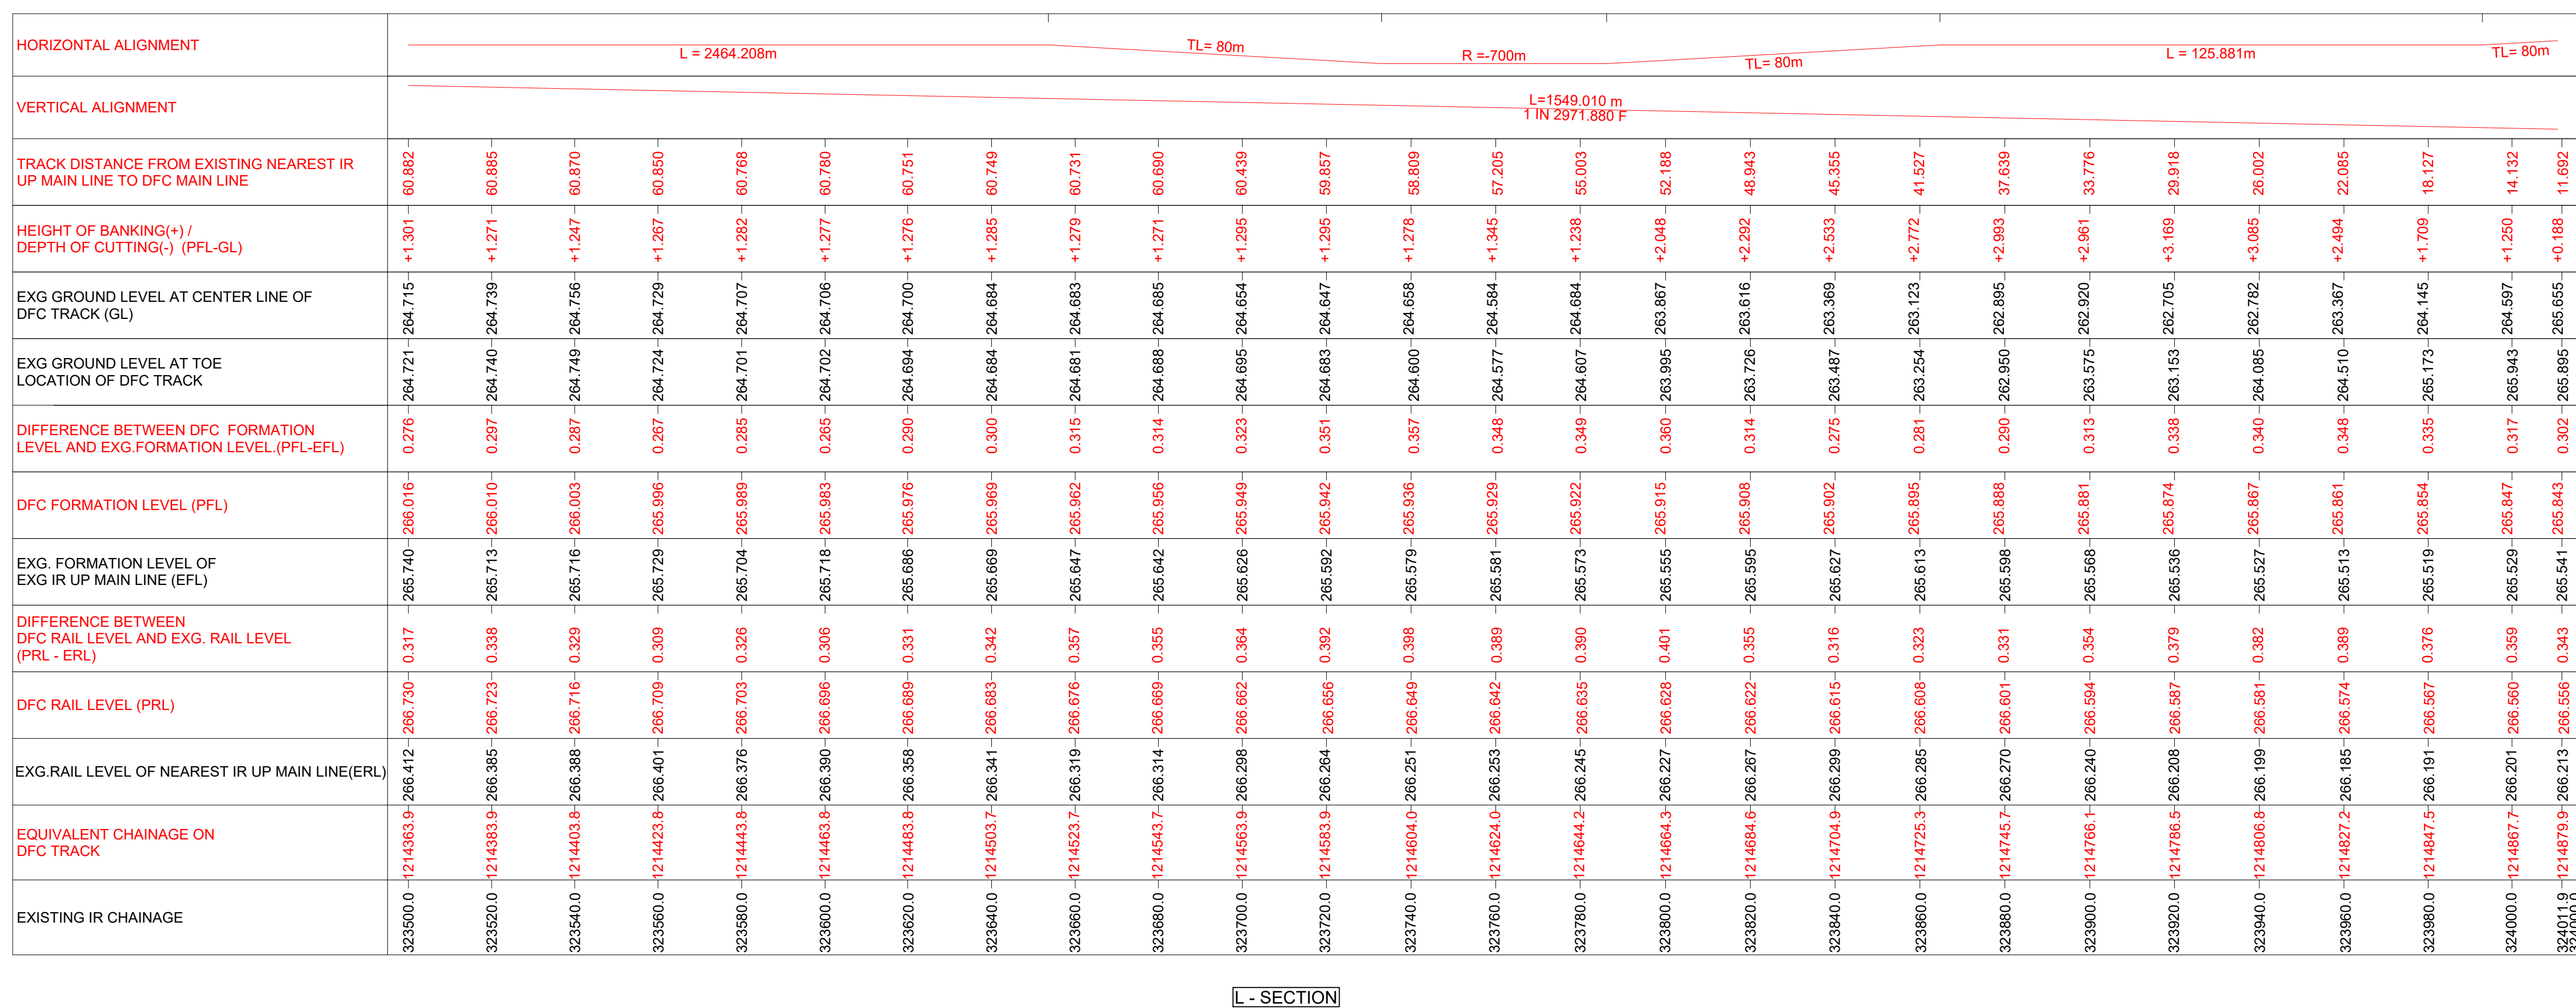

AS BUILT DRAWING	
TITLE AS-BUILT PLAN AND PROFILE FROM IR KM: 323.500 TO 324.000 DFC KM: 1214.364 TO 1214.880	DFCC APPR. NO. - ENG. APPR. NO. - DRG. NO. -301-2/AL/A/1273 SHEET NO. : 1 OF 1 DATE : 26.09.2024 STATUS A

TR