


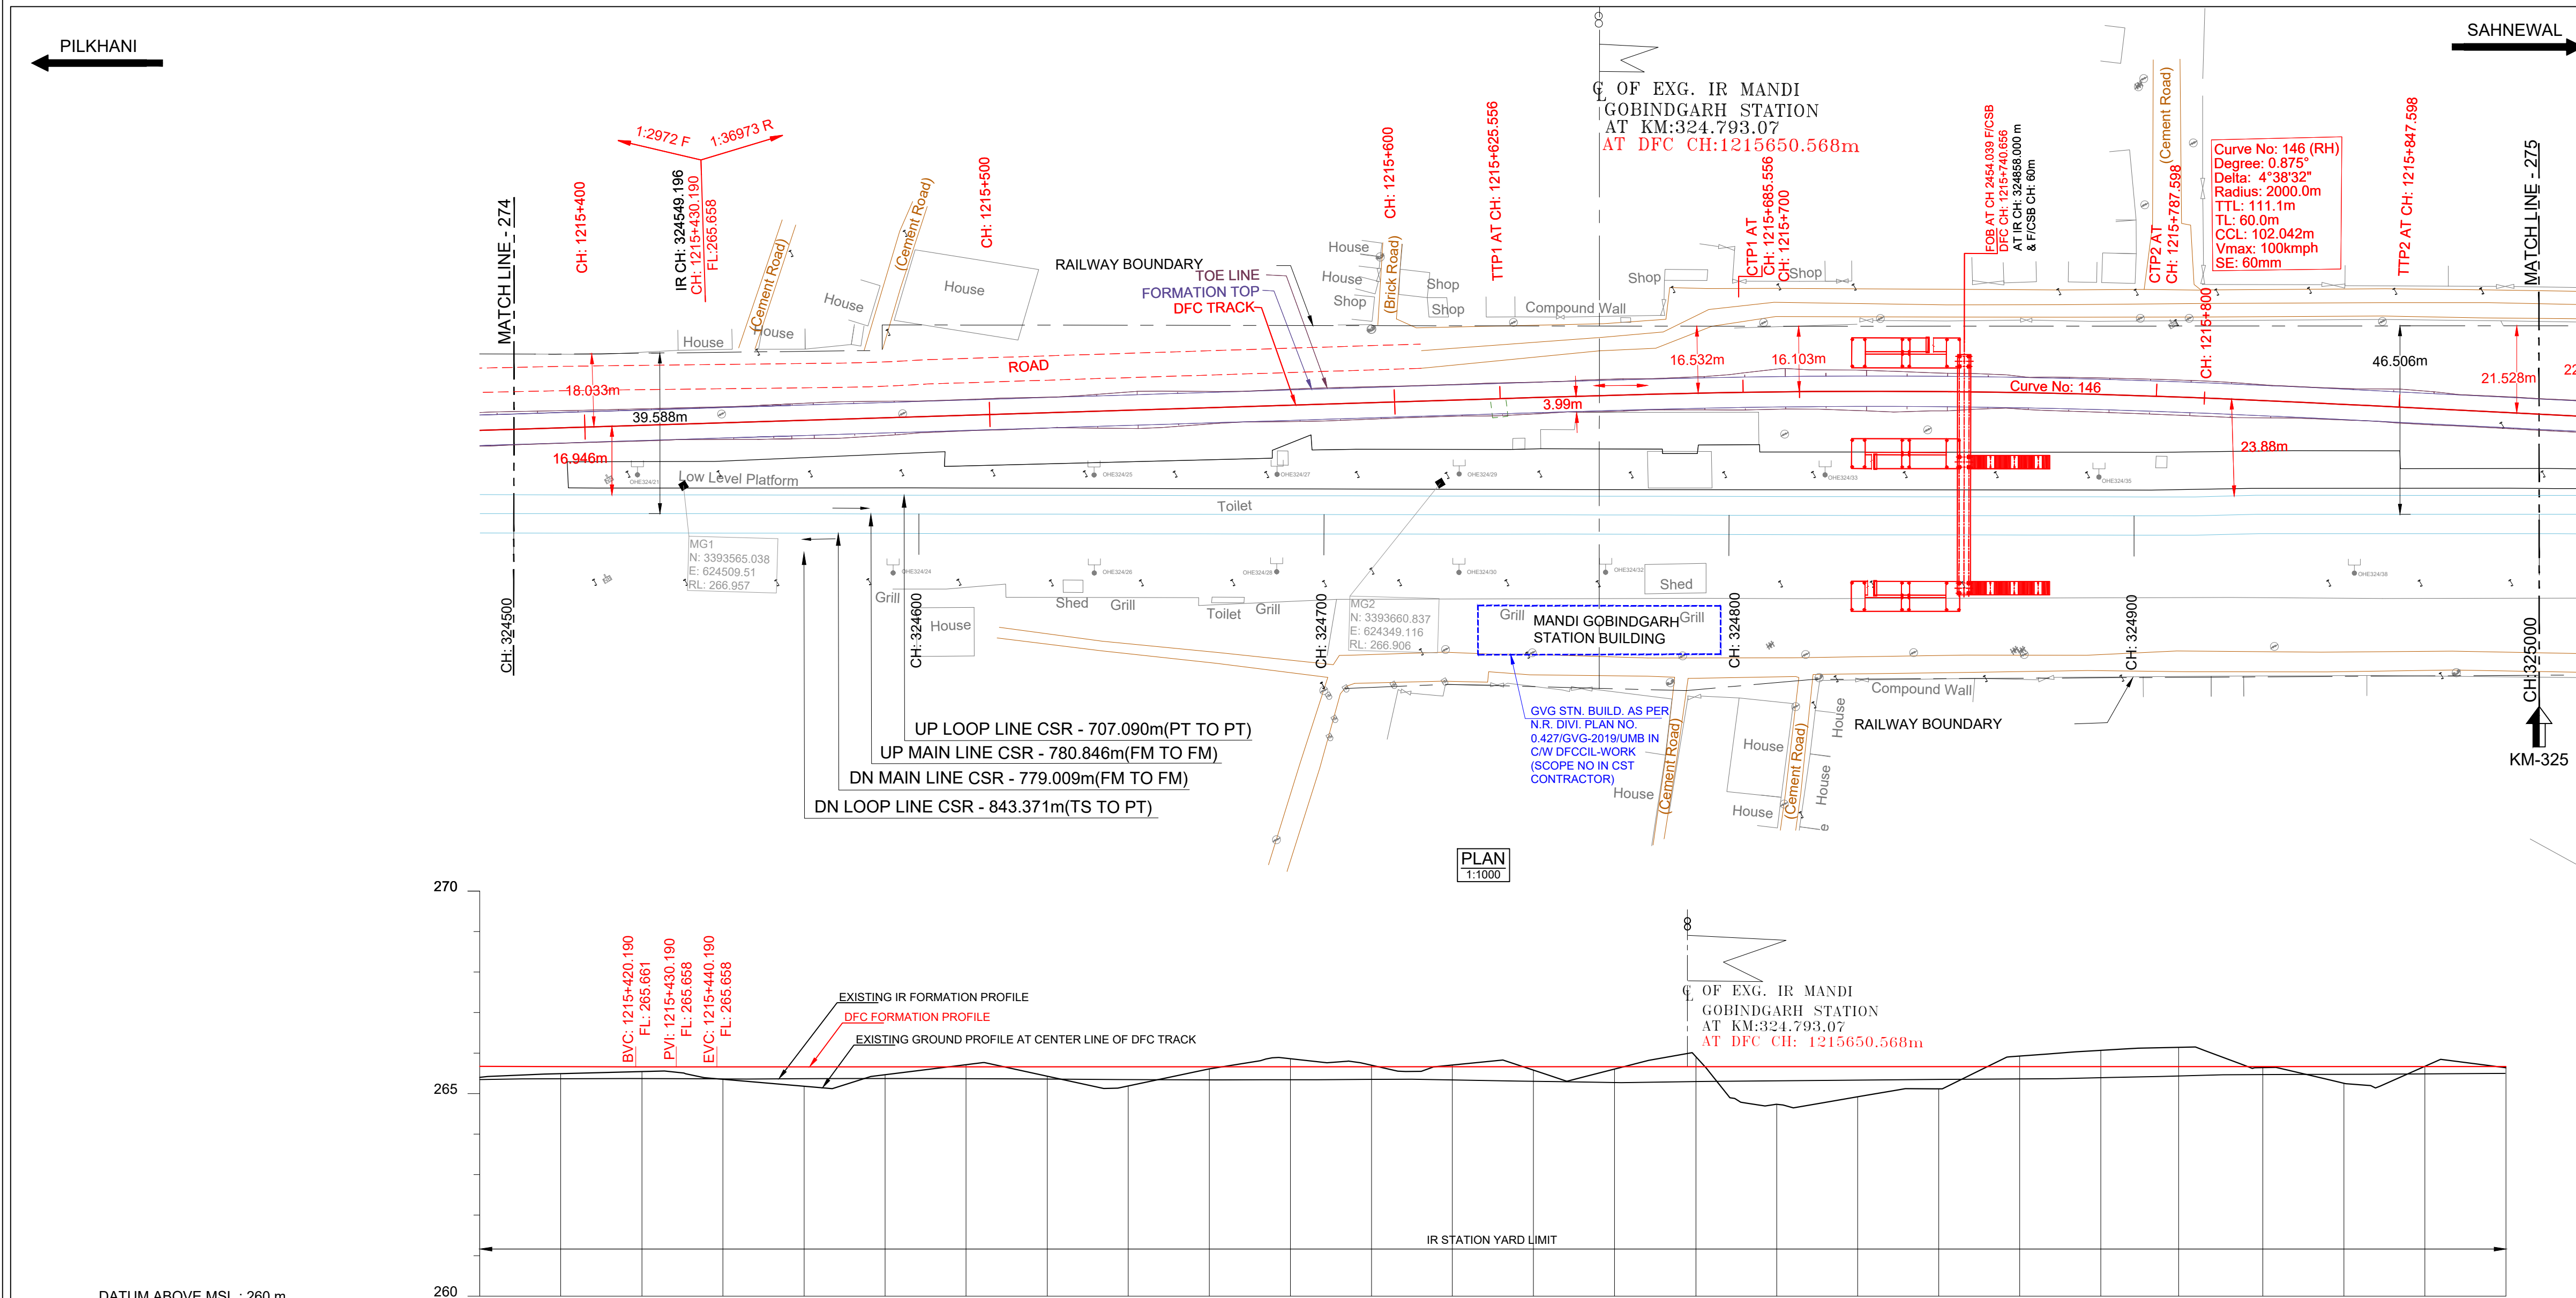

	HORIZONTAL ALIGNMENT	L = 573.006m TL= 60m R =2000m TL= 60m L = 147.630m																									
	VERTICAL ALIGNMENT	L=1549.010 m 1 IN 2971.880 F L=20.0 m R=55020 m L=1480.354 m 1 IN 36972.745 R																									
	TRACK DISTANCE FROM EXISTING NEAREST IR UP MAIN LINE TO DFC MAIN LINE	20.806	21.430	22.040	22.681	23.349	24.019	24.657	25.283	25.957	26.593	27.252	27.920	28.588	29.193	29.771	30.277	30.574	30.664	30.546	30.219	29.698	28.891	27.689	26.719	25.719	24.715
	HEIGHT OF BANKING(+)/ DEPTH OF CUTTING(-) (PFL-GL)	+0.271	+0.175	+0.116	+0.303	+0.477	+0.191	-0.054	+0.232	+0.472	+0.050	-0.198	-0.037	-0.043	+0.085	+0.057	-0.245	+0.929	+0.744	+0.549	-0.259	-0.399	-0.473	+0.026	+0.415	-0.004	+0.033
	EXG GROUND LEVEL AT CENTER LINE OF DFC TRACK (GL)	265.403	265.492	265.545	265.355	265.182	265.468	265.714	265.428	265.189	265.611	265.860	265.699	265.706	265.578	265.607	265.909	264.736	264.922	265.117	265.926	266.066	266.141	265.642	265.254	265.673	265.637
	EXG GROUND LEVEL AT TOE LOCATION OF DFC TRACK	265.592	265.376	265.421	265.440	265.275	265.497	265.737	265.443	265.206	265.586	265.775	265.632	265.473	265.582	265.606	265.238	264.777	264.968	265.167	265.785	265.915	265.992	265.632	265.326	265.621	265.598
	DIFFERENCE BETWEEN DFC FORMATION LEVEL AND EXG.FORMATION LEVEL.(PFL-EFL)	0.326	0.301	0.288	0.295	0.290	0.286	0.291	0.302	0.315	0.322	0.321	0.312	0.326	0.360	0.330	0.367	0.349	0.332	0.314	0.305	0.277	0.230	0.200	0.194	0.164	0.170
	DFC FORMATION LEVEL (PFL)	265.674	265.667	265.561	265.658	265.659	265.659	265.660	265.660	265.661	265.661	265.662	265.662	265.663	265.663	265.664	265.664	265.665	265.665	265.666	265.667	265.667	265.668	265.668	265.668	265.669	265.670
	EXG. FORMATION LEVEL OF EXG IR UP MAIN LINE (EFL)	265.348	265.367	265.372	265.363	265.368	265.373	265.368	265.358	265.346	265.339	265.341	265.350	265.337	265.304	265.274	265.298	265.316	265.334	265.352	265.362	265.390	265.438	265.469	265.475	265.486	265.499
	DIFFERENCE BETWEEN DFC RAIL LEVEL AND EXG. RAIL LEVEL (PRL - ERL)	0.367	0.342	0.330	0.336	0.332	0.327	0.333	0.343	0.356	0.364	0.362	0.354	0.368	0.401	0.431	0.408	0.390	0.373	0.355	0.346	0.318	0.271	0.241	0.236	0.225	0.212
	DFC RAIL LEVEL (PRL)	266.387	266.381	266.374	266.371	266.372	266.372	266.373	266.373	266.374	266.375	266.376	266.376	266.376	266.377	266.377	266.378	266.378	266.378	266.379	266.379	266.38	266.381	266.381	266.382	266.382	266.383
	EXG.RAIL LEVEL OF NEAREST IR UP MAIN LINE(ERL)	266.020	266.039	266.044	266.035	266.040	266.045	266.040	266.030	266.018	266.011	266.013	266.022	266.009	265.976	265.946	265.970	265.988	266.006	266.024	266.034	266.062	266.110	266.141	266.147	266.158	266.171
	EQUIVALENT CHAINAGE ON DFC TRACK	1215381.3	1215401.3	1215421.3	1215441.4	1215461.4	1215481.4	1215501.4	1215521.4	1215541.4	1215561.4	1215581.5	1215601.5	1215621.5	1215641.5	1215661.5	1215681.6	1215701.5	1215721.5	1215741.5	1215761.5	1215781.5	1215800.7	1215821.5	1215841.5	1215861.5	1215881.5
	EXISTING IR CHAINAGE	324500.0	324520.0	324540.0	324560.0	324580.0	324600.0	324620.0	324640.0	324660.0	324680.0	324700.0	324720.0	324740.0	324760.0	324780.0	324800.0	324820.0	324840.0	324860.0	324880.0	324900.0	324920.0	324940.0	324960.0	324980.0	325000.0

L - SECTION

NOTE:-

- DFCC WORKS ARE SHOWN IN RED.
- IR NEW WORKS ARE SHOWN IN VIOLET.
- ALL DIMENSIONS ARE SHOWN IN METRES.
- THIS DRAWING IS PREPARED BASED ON LATEST SURVEY DATA HELD ON APRIL-2022. GTS BENCH MARK OF 261.850M CONSIDERED ON TOP OF CANAL BRIDGE ABUTMENT AT DORAH VILLAGE ALONG THE NH1.
- DFC NEW CHAINAGE OF 1075.950M IS WITH REFERENCE TO THE IR KM OF 187.500KM END OF KM OF CP-303(SECTION P-3 PILKHANI END) AGAINST THE EXISTING DFC CHAINAGE. 116277.742M ISSUED VIDE LETTER NO. COM/DFCC/UM/SURVEY/2021-301-230116-011173 DT. 17.01.2023.
- BALLAST PROFILE HAS BEEN PROVIDED ACCORDING TO THE CLAUSE 1.11.3 OF STANDARD SCHEDULE OF DIMENSION(EASTERN CORRIDOR) & THE BALLAST CUSHION DIMENSION SHOWN IN 35CM ON GE-14 PARA 17. SPECIFICATIONS & RECOMMENDATIONS 2. TWO LAYER SYSTEM FIG.10.

REFERENCE DRAWINGS :-

- FOR KEY PLAN REFER DRAWING NO. 301-2/AL/0001
- FOR LEGEND AND ABBREVIATIONS REFER DRAWING NO. 301-2/AL/1000
- FOR TYPICAL SECTION OF BALLAST PROFILE (FL-RL) REFER DRG. NO. 301-2/TK/TFDI-004 (TR.1952)

026.09.2024SUBMISSION OF AS-BUILT DRAWINGFOR APPROVAL

REV. DATE REVISION DETAILS PURPOSE OF ISSUE

SCALE
HOR - 1:1000
VER - 1:100
SHEET SIZE : A1

LEGEND:

- IR TRACK
- DFCC TRACK
- DFCC FUTURE PROPOSALS
- STRUCTURE / BUILDING
- DFCC TOE LINE
- DFCC FORMATION
- RETAINING WALL
- ROAD
- STREAM, DRAIN, NALA, CANAL.
- FENCE
- POWER LINES
- TBM
- ELECTRIC POLE/OHE MAST
- IR RAILWAY BOUNDARY
- DFCC BOUNDARY

TRACK STRUCTURE

RAIL SECTION: 60Kg/m (UIC 60Kg/m)	Difference between FL- RL (Below Rail Seat)	
DFC LINE: 60Kg/m (UIC 60Kg/m)	IR Line	DFC
IR MAIN LINE: 52Kg/m	172mm	172mm
RUBBER PAD	6mm	10mm
SLEEPER DEPTH	210mm	210mm
BALLAST CUSHION	300mm	350mm
Total Depth (FL TO RL)	688mm	742mm

OWNER

DEDICATED FREIGHT CORRIDOR CORPORATION OF INDIA LTD.
(A GOVERNMENT OF INDIA ENTERPRISE)
PROJECT OFFICE(AMBALA UNIT): OLD RAILWAY COLONY (NEAR ANAND MARKET),AMBALA CANTT-133001.
CORPORATE IDENTITY NO. : U60232DL2006GGI155068

ENGINEER:

DB Engineering & Consulting GmbH
Deutsche Bahn Engineering & Consulting GmbH

CONTRACTOR:

GIL - TPL JV
GAR TATA

SUBMITTED BY	GIL - TPL JV		
	DATED	NAME	SIGNATURE
PREPARED BY			
CHECKED BY	26.09.2024	VIJAY PRATAP	
APPROVED BY	26.09.2024	PARASURAM KOTYADA	

APPROVED BY	DEUTSCHE BAHN ENGINEERING & CONSULTING GMBH		
	DATED	NAME	SIGNATURE
Sr. DE./CHIEF ENGINEER		SURESH K.YALANGI	
CHIEF TRACK ENGINEER		RAJ PAL SINGH	
T.L.		H.D. VIDJAK	

STAMP

AAS-BUILT DRAWINGTR. Ref.....ENGINEER Sign.:

EMPLOYER (DFCCIL):

DEDICATED FREIGHT CORRIDOR CORPORATION OF INDIA LTD.

AS BUILT DRAWING

TITLEAS-BUILT PLAN AND PROFILEDFCC APPR. NO. -ENGNG. APPR. NO. -DRG. NO. -301-2/AL/A/1275FROM IR KM: 324.500 TO 325.000DFC KM:1215.381 TO 1215.881SHEET NO. : 1 OF 1STATUSA

DATE : 26.09.2024

TR.