


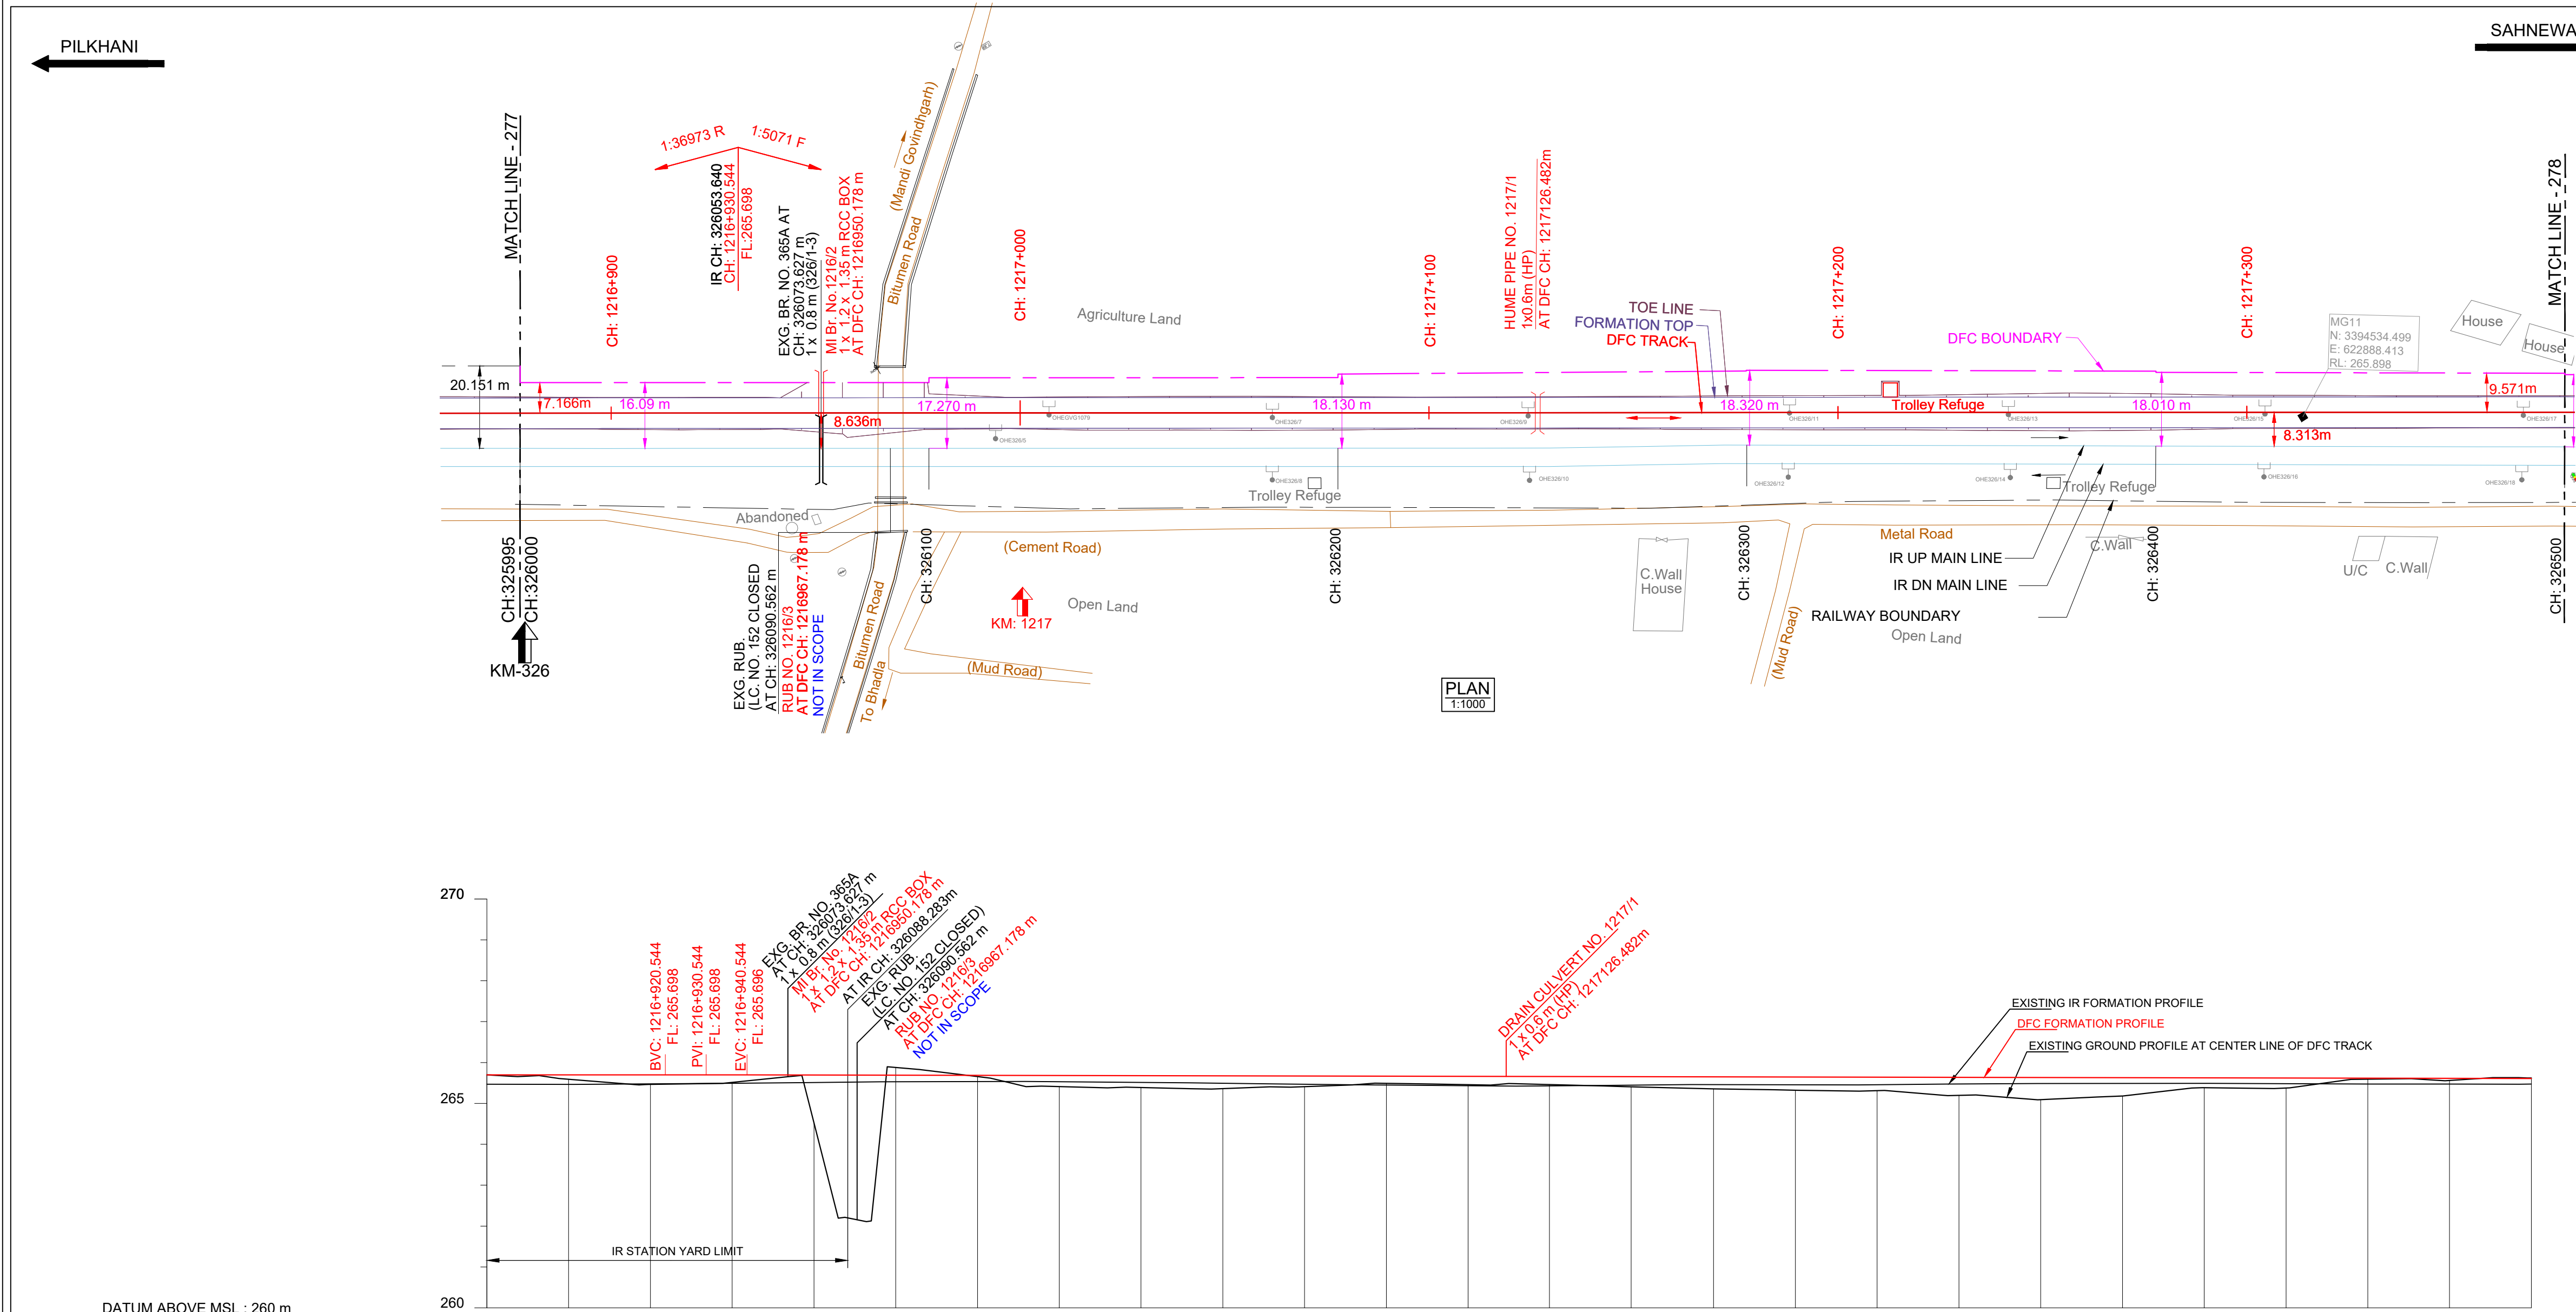


DATUM ABOVE MSL : 260 m

HORIZONTAL ALIGNMENT	L = 5592.259m																																																	
VERTICAL ALIGNMENT	L=1480.354 m 1 IN 36972.745 R L=20.0 m R=89195 m L=1479.996 m 1 IN 5071.478 F																																																	
TRACK DISTANCE FROM EXISTING NEAREST IR UP MAIN LINE TO DFC MAIN LINE	8.601		8.627	8.628		8.628		8.639		8.650		8.659		8.664		8.666		8.665		8.663		8.656		8.643		8.504		8.182		7.962		8.014		8.066		8.118		8.171		8.229		8.287		8.345		8.403		8.446		8.490
HEIGHT OF BANKING(+) / DEPTH OF CUTTING(-) (PFL-GL)	-0.002		+0.105	+0.232		+0.184		+1.167		-0.189		+0.029		+0.269		+0.288		+0.310		+0.260		+0.174		+0.203		+0.197		+0.248		+0.296		+0.323		+0.329		+0.443		+0.544		+0.448		+0.241		+0.247		+0.025		+0.051		-0.014
EXG GROUND LEVEL AT CENTER LINE OF DFC TRACK (GL)	265.699		265.592	265.486		265.513		264.526		265.878		265.656		265.412		265.389		265.363		265.409		265.491		265.459		265.461		265.406		265.354		265.323		265.313		265.195		265.090		265.182		265.385		265.375		265.593		265.563		265.624
EXG GROUND LEVEL AT TOE LOCATION OF DFC TRACK	265.795		265.678	265.548		265.538		261.056		265.112		265.647		265.468		265.428		265.417		265.476		265.529		265.497		265.469		265.416		265.368		265.340		265.315		265.176		265.031		265.129		265.308		265.334		265.376		265.371		265.624
DIFFERENCE BETWEEN DFC FORMATION LEVEL AND EXG.FORMATION LEVEL (PFL-EFL)	0.228		0.233	0.219		0.204		0.181		0.160		0.150		0.151		0.165		0.181		0.201		0.218		0.230		0.228		0.206		0.190		0.189		0.183		0.163		0.146		0.141		0.135		0.138		0.142		0.142		0.138
DFC FORMATION LEVEL (PFL)	265.697		265.697	265.698		265.697		265.693		265.689		265.685		265.681		265.677		265.673		265.669		265.665		265.662		265.658		265.654		265.650		265.646		265.642		265.638		265.634		265.630		265.626		265.622		265.618		265.614		265.610
EXG. FORMATION LEVEL OF EXG IR UP MAIN LINE (EFL)	265.469		265.465	265.479		265.493		265.512		265.529		265.535		265.531		265.512		265.492		265.468		265.448		265.431		265.429		265.448		265.460		265.457		265.458		265.475		265.488		265.489		265.491		265.484		265.476		265.472		265.472
DIFFERENCE BETWEEN DFC RAIL LEVEL AND EXG. RAIL LEVEL (PRL - ERL)	0.269		0.274	0.261		0.244		0.222		0.201		0.191		0.192		0.206		0.222		0.242		0.258		0.271		0.269		0.247		0.231		0.230		0.224		0.203		0.187		0.181		0.176		0.179		0.183		0.183		0.179
DFC RAIL LEVEL (PRL)	266.410		266.411	266.411		266.410		266.406		266.402		266.398		266.394		266.390		266.386		266.382		266.378		266.374		266.37		266.366		266.362		266.359		266.355		266.351		266.347		266.343		266.339		266.335		266.331		266.327		266.323
EXG.RAIL LEVEL OF NEAREST IR UP MAIN LINE(ERL)	266.141		266.137	266.151		266.165		266.184		266.201		266.207		266.203		266.184		266.164		266.140		266.120		266.103		266.101		266.120		266.132		266.129		266.130		266.147		266.161		266.161		266.163		266.156		266.148		266.144		266.144
EQUIVALENT CHAINAGE ON DFC TRACK	-1216876.6		-1216896.6	-1216916.5		-1216936.6		-1216956.6		-1216976.6		-1216996.6		-1217016.5		-1217036.5		-1217056.5		-1217076.5		-1217096.5		-1217116.5		-1217136.4		-1217156.4		-1217176.6		-1217196.6		-1217216.6		-1217236.6		-1217256.6		-1217276.6		-1217296.6		-1217316.6		-1217336.6		-1217356.6		-1217376.6
EXISTING IR CHAINAGE	325994.8		326000.0	326004.0		326006.0		326008.0		326010.0		326012.0		326014.0		326016.0		326018.0		326020.0		326022.0		326024.0		326026.0		326028.0		326030.0		326032.0		326034.0		326036.0		326038.0		326040.0		326042.0		326044.0		326046.0		326048.0		326050.0

L - SECTION

SAHNEWAL

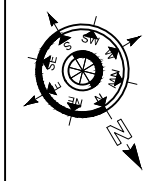

NOTE:-

1. DFC WORKS ARE SHOWN IN RED.
2. IR NEW WORKS ARE SHOWN IN VIOLET.
3. ALL DIMENSIONS ARE SHOWN IN METRES.
4. THIS DRAWING IS PREPARED BASED ON LATEST SURVEY DATA HELD ON APRIL-2022. GTS BENCH MARK OF 261.850M CONSIDERED ON TOP OF CANAL BRIDGE ABUTMENT AT DORAH VILLAGE ALONG THE NH1.
5. DFC NEW CHAINAGE OF 1075.950M IS WITH REFERENCE TO THE IR KM OF 187.500KM END OF KM OF CP-303(SECTION P-3 PILKHANI END) AGAINST THE EXISTING DFC CHAINAGE. 116277.742M ISSUED VIDE LETTER NO. COM/DFCC/MB/SURVEY/2021-301-230116-011173 DT. 17.01.2023.
6. BALLAST PROFILE HAS BEEN PROVIDED ACCORDING TO THE CLAUSE 1.11.3 OF STANDARD SCHEDULE OF DIMENSION(EASTERN CORRIDOR) & THE BALLAST CUSHION DIMENSION SHOWN IN 35CM ON GE-14 PARA 17. SPECIFICATIONS & RECOMMENDATIONS 2. TWO LAYER SYSTEM FIG.10.

REFERENCE DRAWINGS :-

1. FOR KEY PLAN REFER DRAWING NO. 301-2/AL/0001
2. FOR LEGEND AND ABBREVIATIONS REFER DRAWING NO. 301-2/AL/1000
3. FOR TYPICAL SECTION OF BALLAST PROFILE (FL-RL) REFER DRG. NO. 301-2/TK/TFD/004 (TR.1952)

REV.	DATE	REVISION DETAILS	PURPOSE OF ISSUE
0	26.09.2024	SUBMISSION OF AS-BUILT DRAWING	FOR APPROVAL

LEGEND:


SCALE

HOR - 1:1000

VER - 1:100

SHEET SIZE : A1

IR TRACK
DFCC TRACK
DFCC FUTURE PROPOSALS
STRUCTURE / BUILDING
DFCC TOE LINE
DFCC FORMATION
RETAINING WALL
ROAD
STREAM, DRAIN, NALA, CANAL.
FENCE
POWER LINES
TBM
ELECTRIC POLE/OHE MAST
IR RAILWAY BOUNDARY
DFCC BOUNDARY

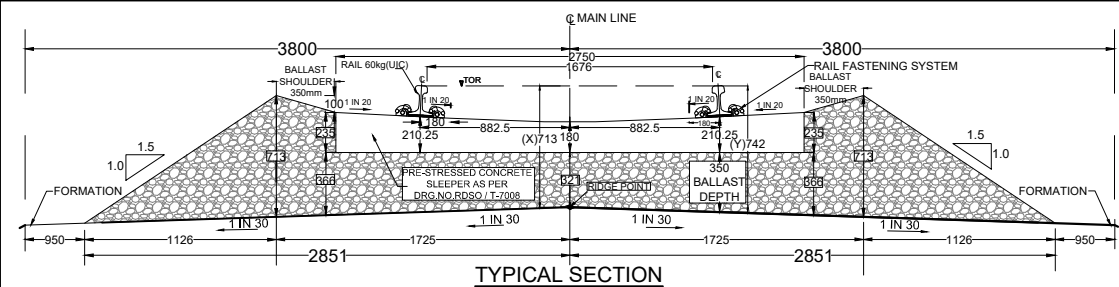

TRACK STRUCTURE		
RAIL SECTION: 60Kg/m (UIC 60Kg/m) DFC LINE: 60Kg/m (UIC 60Kg/m) IR MAIN LINE: 52Kg/m	Difference between FL - RL (Below Rail Seat)	
	IR Line	DFC
RUBBER PAD	172mm	172mm
SLEEPER DEPTH	6mm	10mm
BALLAST CUSHION	210mm	210mm
	300mm	350mm
Total Depth (FL TO RL)	688mm	742mm

OWNER

DEDICATED FREIGHT CORRIDOR CORPORATION OF INDIA LTD.

(A GOVERNMENT OF INDIA ENTERPRISE)

PROJECT OFFICE(AMBALA UNIT): OLD RAILWAY COLONY (NEAR ANAND MARKET),AMBALA CANTT-133001.

CORPORATE IDENTITY NO. : U60232DL2006GGI155068

ENGINEER:

DB Engineering & Consulting GmbH

Deutsche Bahn Engineering & Consulting GmbH

CONTRACTOR:

GIL - TPL JV

GAR TATA

SUBMITTED BY	GIL - TPL JV		
	DATED	NAME	SIGNATURE
PREPARED BY	26.09.2024	VIJAY PRATAP	
CHECKED BY	26.09.2024	PARASURAM KOTYADA	
APPROVED BY	26.09.2024	PARASURAM KOTYADA	

APPROVED BY	DEUTSCHE BAHN ENGINEERING & CONSULTING GMBH		
	DATED	NAME	SIGNATURE
Sr. DE./CHIEF ENGINEER		SURESH K.YALANGI	
CHIEF TRACK ENGINEER		RAJ PAL SINGH	
T.L.		H.D. VIDJAK	

STAMP	A AS-BUILT DRAWING TR. Ref.:..... ENGINEER Sign.:.....		
EMPLOYER (DFCCIL):	DEDICATED FREIGHT CORRIDOR CORPORATION OF INDIA LTD.		

AS BUILT DRAWING			
TITLE	AS-BUILT PLAN AND PROFILE	DFCC APPR. NO. -	
	FROM IR KM: 326.000 TO 326.500	ENGG. APPR. NO. -	
	DFC KM:1216.877 TO 1217.377	DRG. NO. - 301-2/AL/A/1278	
		SHEET NO. : 1 OF 1	STATUS
		DATE : 26.09.2024	A

TR.