
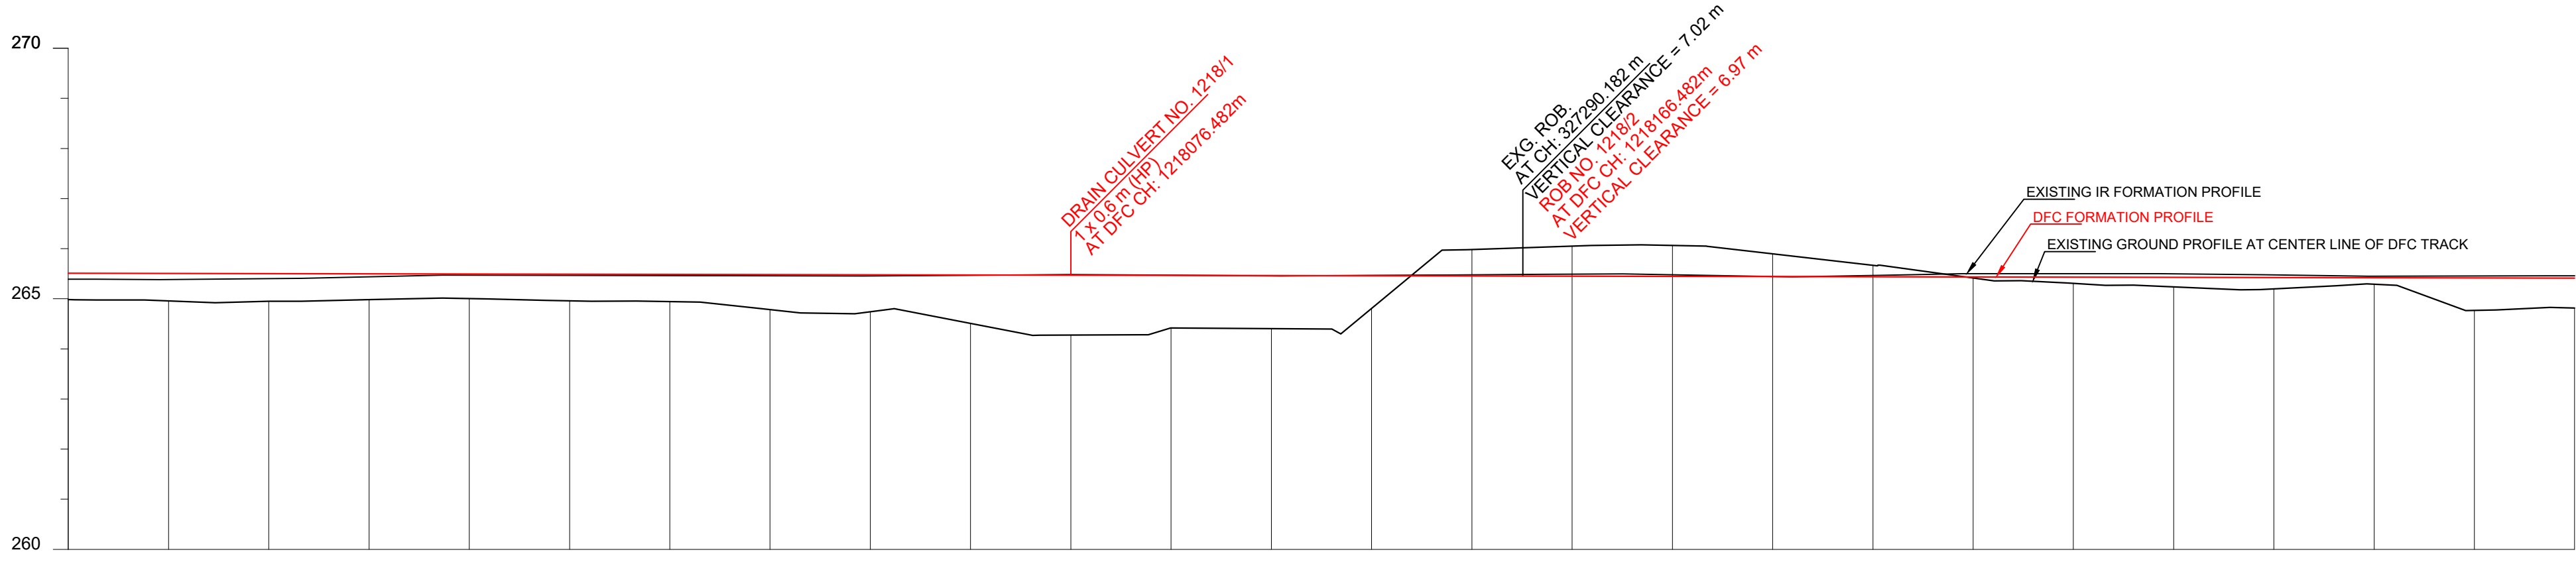


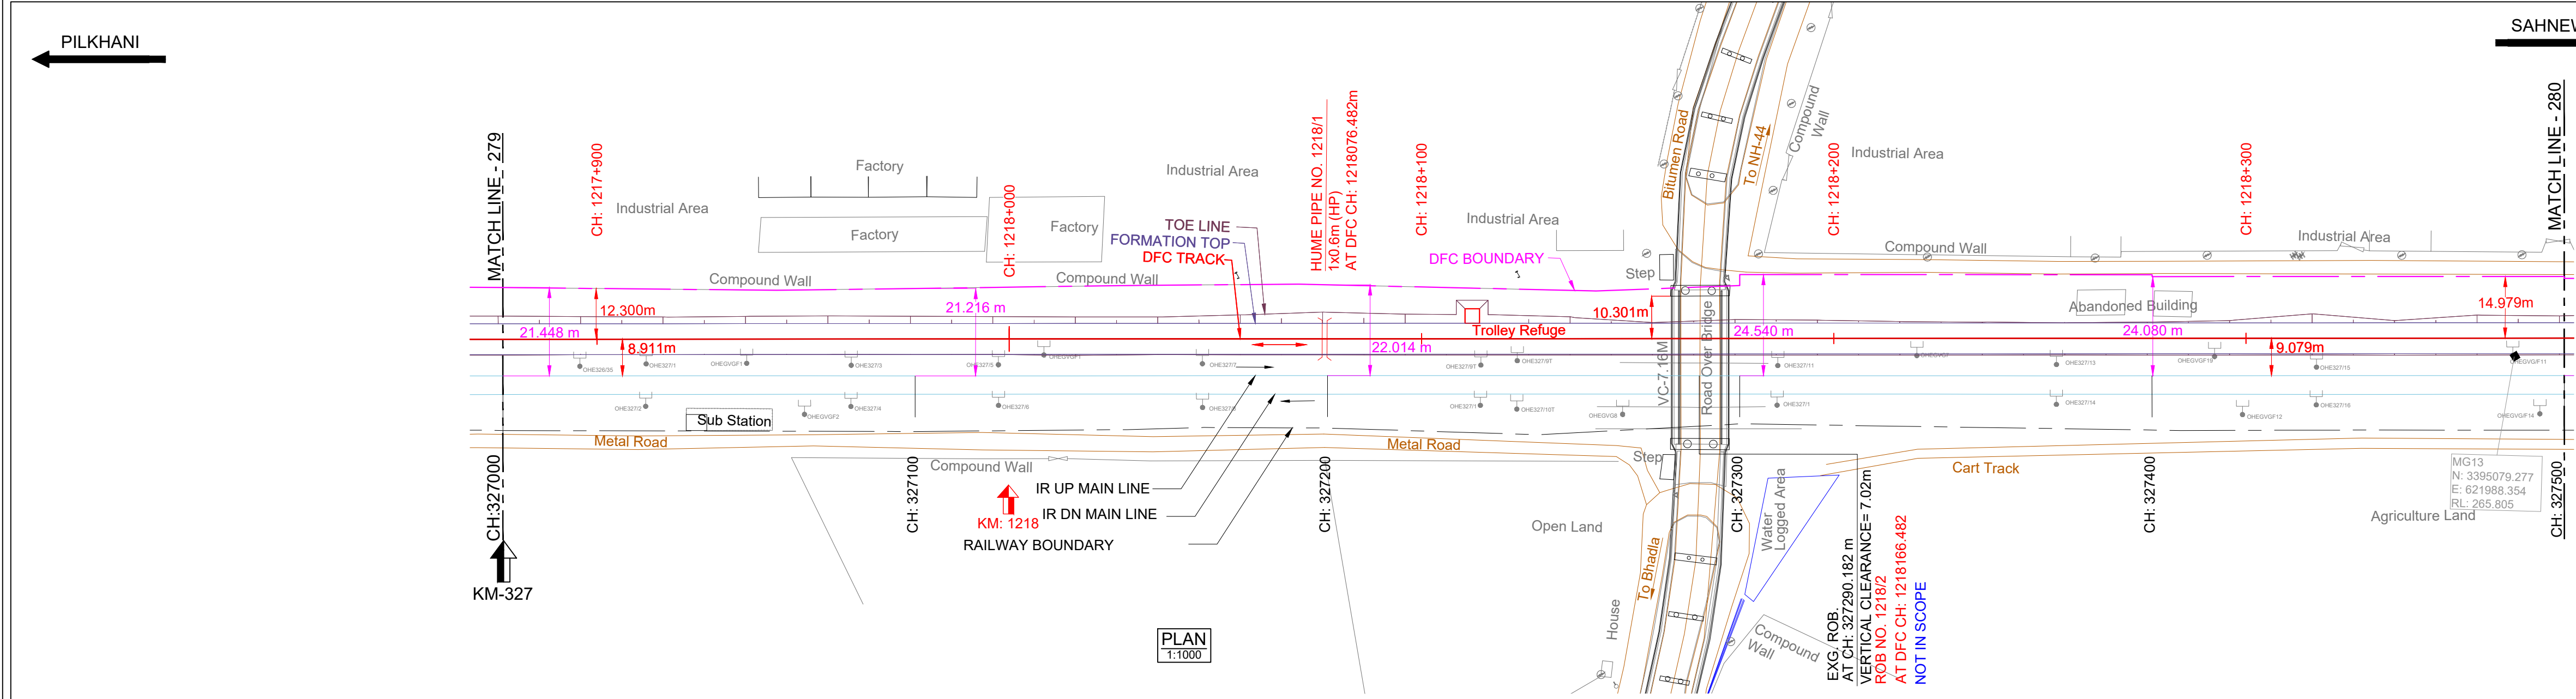

DATUM ABOVE MSL : 260 m

HORIZONTAL ALIGNMENT	L = 5592.259m																			
VERTICAL ALIGNMENT	L=1479.996 m 1 IN 5071.478 F																			
TRACK DISTANCE FROM EXISTING NEAREST IR UP MAIN LINE TO DFC MAIN LINE	8.906	8.914	8.908	8.904	8.911	8.947	8.975	8.959	8.943	8.932	8.921	8.938	8.955	8.973	8.991	9.013	9.030	9.043	9.074	9.102
HEIGHT OF BANKING(+) / DEPTH OF CUTTING(-) (PFL-GL)	+0.527	+0.549	+0.555	+0.517	+0.493	+0.532	+0.544	+0.701	+0.740	+0.967	+1.194	+1.048	+1.059	+0.654	-0.525	-0.597	-0.616	-0.452	-0.225	-0.596
EXG GROUND LEVEL AT CENTER LINE OF DFC TRACK (GL)	264.985	264.959	264.949	264.983	265.003	264.950	264.944	264.783	264.740	264.509	264.278	264.420	264.406	264.806	265.981	266.050	266.065	265.897	265.666	264.817
EXG GROUND LEVEL AT TOE LOCATION OF DFC TRACK	264.481	264.534	264.606	264.513	264.468	264.504	264.545	264.595	264.588	264.332	264.026	264.261	264.331	264.681	265.517	266.205	266.008	265.669	265.529	264.474
DIFFERENCE BETWEEN DFC FORMATION LEVEL AND EXG.FORMATION LEVEL.(PFL-EFL)	0.119	0.124	0.103	0.062	0.025	0.026	0.027	0.027	0.025	0.007	-0.011	-0.003	0.007	-0.008	-0.023	-0.039	-0.031	0.000	-0.027	-0.047
DFC FORMATION LEVEL (PFL)	265.512	265.508	265.504	265.500	265.498	265.492	265.488	265.484	265.480	265.476	265.472	265.468	265.464	265.460	265.456	265.491	265.449	265.445	265.441	265.413
EXG. FORMATION LEVEL OF EXG IR UP MAIN LINE (EFL)	265.393	265.384	265.401	265.438	265.471	265.465	265.461	265.457	265.455	265.469	265.483	265.471	265.458	265.468	265.480	265.491	265.480	265.445	265.468	265.460
DIFFERENCE BETWEEN DFC RAIL LEVEL AND EXG. RAIL LEVEL (PRL - ERL)	0.159	0.165	0.144	0.102	0.066	0.067	0.068	0.068	0.066	0.048	0.030	0.038	0.047	0.033	0.018	0.002	0.009	0.040	0.014	-0.006
DFC RAIL LEVEL (PRL)	266.224	266.221	266.217	266.213	266.209	266.205	266.201	266.197	266.193	266.189	266.177	266.173	266.170	266.157	266.150	266.153	266.146	266.142	266.138	266.126
EXG.RAIL LEVEL OF NEAREST IR UP MAIN LINE(ERL)	266.065	266.056	266.073	266.110	266.143	266.137	266.133	266.129	266.127	266.141	266.155	266.143	266.130	266.140	266.152	266.163	266.152	266.170	266.149	266.132
EQUIVALENT CHAINAGE ON DFC TRACK	1217876.5	1217896.5	1217916.5	1217936.5	1217956.5	1217976.5	1217996.5	1218016.5	1218036.5	1218056.5	1218076.5	1218096.5	1218116.5	1218136.5	1218156.5	1218176.5	1218196.5	1218216.5	1218236.5	1218256.5
EXISTING IR CHAINAGE	327000.0	327020.0	327040.0	327060.0	327080.0	327100.0	327120.0	327140.0	327160.0	327180.0	327200.0	327220.0	327240.0	327260.0	327280.0	327300.0	327320.0	327340.0	327360.0	327380.0

L - SECTION

SAHNEWAL



- NOTE:-
1. DFC WORKS ARE SHOWN IN RED.
 2. IR NEW WORKS ARE SHOWN IN VIOLET.
 3. ALL DIMENSIONS ARE SHOWN IN METRES.
 4. THIS DRAWING IS PREPARED BASED ON LATEST SURVEY DATA HELD ON APRIL-2022. GTS BENCH MARK OF 261.850M CONSIDERED ON TOP OF CANAL BRIDGE ABUTMENT AT DORANA VILLAGE ALONG THE NH1.
 5. DFC NEW CHAINAGE OF 1075.950M IS WITH REFERENCE TO THE IR KM OF 187.500KM END OF KM OF CP-303(SECTION P-3 PILKHANI END) AGAINST THE EXISTING DFC CHAINAGE. 116277.742M ISSUED VIDE LETTER NO. COM/DFCC/UM/SURVEY/2021-301-230116-011173.DT. 17.01.2023.
 6. BALLAST PROFILE HAS BEEN PROVIDED ACCORDING TO THE CLAUSE 1.11.3 OF STANDARD SCHEDULE OF DIMENSION(EASTERN CORRIDOR) & THE BALLAST CUSHION DIMENSION SHOWN IN 35CM ON GE-14 PARA 17. SPECIFICATIONS & RECOMMENDATIONS 2. TWO LAYER SYSTEM FIG.10.

- REFERENCE DRAWINGS :-
1. FOR KEY PLAN REFER DRAWING NO. 301-2/AL/0001
 2. FOR LEGEND AND ABBREVIATIONS REFER DRAWING NO. 301-2/AL/1000
 3. FOR TYPICAL SECTION OF BALLAST PROFILE (FL-RL) REFER DRG. NO. 301-2/TK/TFD/-004 (TR.1952)

0	26.09.2024	SUBMISSION OF AS-BUILT DRAWING	FOR APPROVAL
REV.	DATE	REVISION DETAILS	PURPOSE OF ISSUE

LEGEND:


SCALE

HOR - 1:1000

VER - 1:100

SHEET SIZE : A1

IR TRACK
DFCC TRACK
DFCC FUTURE PROPOSALS
STRUCTURE / BUILDING
DFCC TOE LINE
DFCC FORMATION
RETAINING WALL
ROAD
STREAM, DRAIN, NALA, CANAL.
FENCE
POWER LINES
TBM
ELECTRIC POLE/OHE MAST
IR RAILWAY BOUNDARY
DFCC BOUNDARY

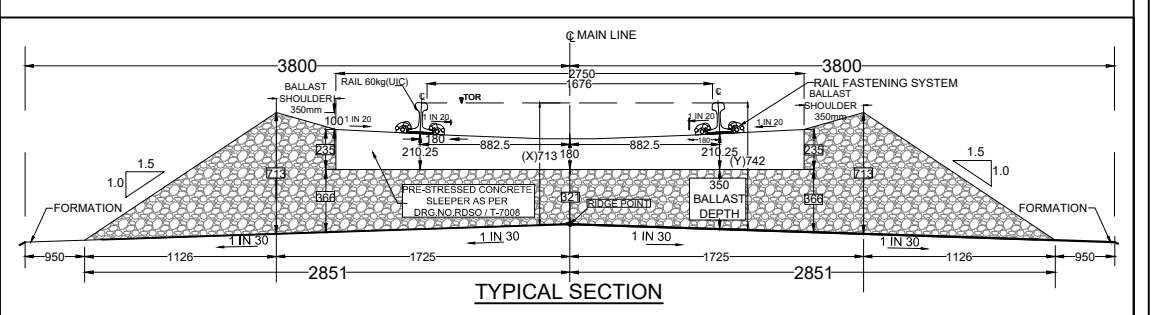

TRACK STRUCTURE		
RAIL SECTION: 60Kg/m (UIC 60Kg/m) DFC LINE: 60Kg/m (UIC 60Kg/m) IR MAIN LINE: 52Kg/m	Difference between FL- RL (Below Rail Seat)	
	IR Line	DFC
RUBBER PAD	172mm	172mm
SLEEPER DEPTH	6mm	10mm
BALLAST CUSHION	210mm	210mm
Total Depth (FL TO RL)	300mm	350mm

OWNER

DEDICATED FREIGHT CORRIDOR CORPORATION OF INDIA LTD.

(A GOVERNMENT OF INDIA ENTERPRISE)

PROJECT OFFICE/AMBALA UNIT: OLD RAILWAY COLONY (NEAR ANAND MARKET), AMBALA CANTT-133001.

CORPORATE IDENTITY NO. : U60232DL2006GGI155068

ENGINEER:

DB Engineering & Consulting GmbH

Deutsche Bahn Engineering & Consulting GmbH

CONTRACTOR:

GIL - TPL JV

GAR TATA

SUBMITTED BY	GIL - TPL JV		
	DATED	NAME	SIGNATURE
PREPARED BY			
CHECKED BY	26.09.2024	VIJAY PRATAP	
APPROVED BY	26.09.2024	PARASURAM KOTYADA	
APPROVED BY	DEUTSCHE BAHN ENGINEERING & CONSULTING GMBH		
	DATED	NAME	SIGNATURE
Sr. DE./CHIEF ENGINEER		SURESH K.YALANGI	
CHIEF TRACK ENGINEER		RAJ PAL SINGH	
T.L.		H.D. VIDJAK	

STAMP

A AS-BUILT DRAWING
TR. Ref.:.....
ENGINEER Sign.:

EMPLOYER (DFCCIL): DEDICATED FREIGHT CORRIDOR CORPORATION OF INDIA LTD.

AS BUILT DRAWING			
TITLE	AS-BUILT PLAN AND PROFILE	DFCC APPR. NO. -	
FROM IR KM: 327.000 TO 327.500	DFC KM:1217.876 TO 1218.376	ENGG. APPR. NO. -	
		DRG. NO. - 301-2/AL/A/1280	
		SHEET NO. : 1 OF 1	STATUS
		DATE : 26.09.2024	A

TR.