
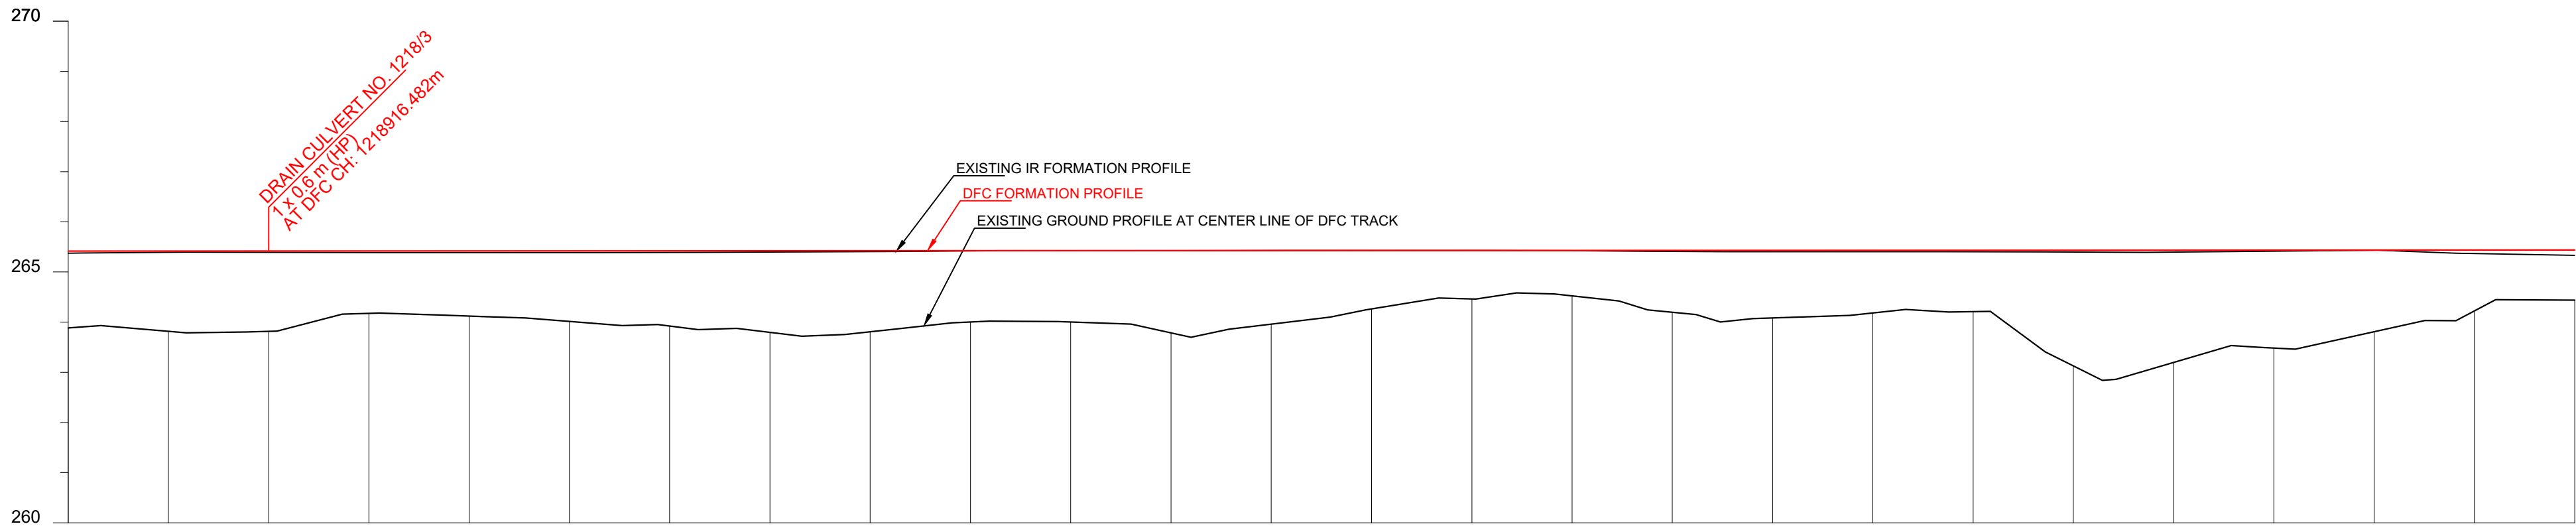


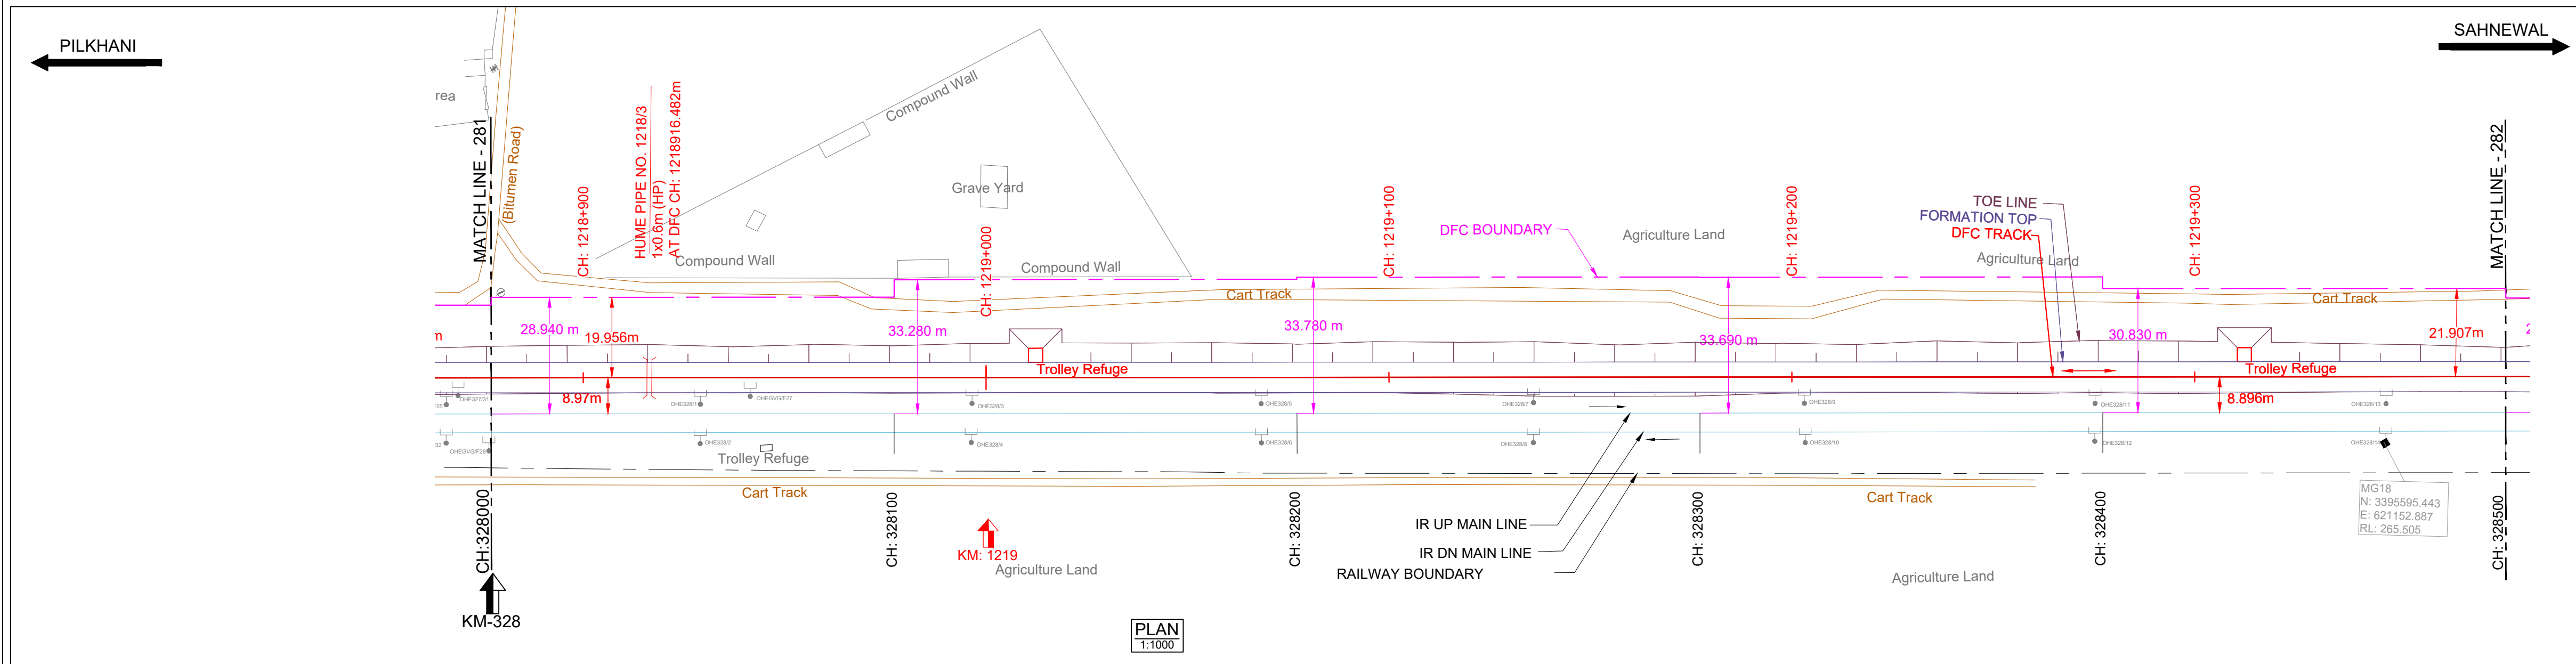


DATUM ABOVE MSL : 260 m

HORIZONTAL ALIGNMENT	L = 5592.259m																			
VERTICAL ALIGNMENT	L=1480.101 m 1 IN 27877.218 R																			
TRACK DISTANCE FROM EXISTING NEAREST IR UP MAIN LINE TO DFC MAIN LINE	8.979	8.969	8.973	8.979	8.988	8.996	8.989	8.976	8.965	8.957	8.934	8.906	8.901	8.903	8.915	8.928	8.910	8.891	8.870	8.859
HEIGHT OF BANKING(+) / DEPTH OF CUTTING(-) (PFL-GL)	+1.537	+1.603	+1.604	+1.246	+1.299	+1.409	+1.501	+1.629	+1.614	+1.423	+1.424	+1.639	+1.466	+1.166	+0.969	+0.906	+1.232	+1.346	+1.248	+1.221
EXG GROUND LEVEL AT CENTER LINE OF DFC TRACK (GL)	263.882	263.816	263.816	264.175	264.122	264.013	263.922	263.795	263.810	264.002	264.002	263.787	263.959	264.262	264.460	264.523	264.198	264.085	264.183	264.211
EXG GROUND LEVEL AT TOE LOCATION OF DFC TRACK	263.279	263.165	263.088	263.370	263.063	263.244	262.982	262.897	262.938	262.895	263.087	262.785	262.867	262.818	263.196	262.891	263.014	263.145	262.733	262.944
DIFFERENCE BETWEEN DFC FORMATION LEVEL AND EXG.FORMATION LEVEL.(PFL-EFL)	0.043	0.027	0.028	0.033	0.034	0.035	0.034	0.027	0.019	0.006	0.002	0.003	0.000	-0.002	0.001	0.006	0.020	0.027	0.027	0.028
DFC FORMATION LEVEL (PFL)	-265.375	-265.419	-265.420	-265.388	-265.421	-265.387	-265.389	-265.396	-265.405	-265.419	-265.424	-265.424	-265.427	-265.428	-265.428	-265.423	-265.410	-265.404	-265.405	-265.404
EXG. FORMATION LEVEL OF EXG IR UP MAIN LINE (EFL)	-265.375	-265.392	-265.392	-265.388	-265.388	-265.387	-265.389	-265.396	-265.405	-265.419	-265.424	-265.424	-265.427	-265.428	-265.428	-265.423	-265.410	-265.404	-265.405	-265.404
DIFFERENCE BETWEEN DFC RAIL LEVEL AND EXG. RAIL LEVEL (PRL - ERL)	0.084	0.068	0.069	0.073	0.074	0.076	0.075	0.068	0.06	0.046	0.043	0.043	0.041	0.038	0.041	0.047	0.060	0.067	0.067	0.069
DFC RAIL LEVEL (PRL)	-266.131	-266.132	-266.132	-266.133	-266.134	-266.135	-266.135	-266.136	-266.137	-266.137	-266.138	-266.139	-266.140	-266.140	-266.141	-266.142	-266.142	-266.143	-266.144	-266.145
EXG.RAIL LEVEL OF NEAREST IR UP MAIN LINE(ERL)	-266.047	-266.064	-266.064	-266.060	-266.060	-266.059	-266.061	-266.068	-266.077	-266.091	-266.096	-266.096	-266.099	-266.102	-266.100	-266.095	-266.082	-266.076	-266.077	-266.069
EQUIVALENT CHAINAGE ON DFC TRACK	-1218876.5	-12188906.5	-1218916.5	-1218936.5	-1218956.5	-1218976.5	-1218996.5	-1219016.5	-1219036.5	-1219056.5	-1219076.5	-1219096.5	-1219116.5	-1219136.5	-1219156.5	-1219176.5	-1219196.5	-1219216.5	-1219236.5	-1219256.5
EXISTING IR CHAINAGE	328000.0	328020.0	328040.0	328060.0	328080.0	328100.0	328120.0	328140.0	328160.0	328180.0	328200.0	328220.0	328240.0	328260.0	328280.0	328300.0	328320.0	328340.0	328360.0	328380.0

L - SECTION

SAHNEWAL

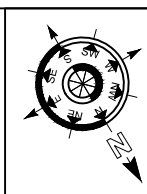

NOTE:-

1. DFC WORKS ARE SHOWN IN RED.
2. IR NEW WORKS ARE SHOWN IN VIOLET.
3. ALL DIMENSIONS ARE SHOWN IN METRES.
4. THIS DRAWING IS PREPARED BASED ON LATEST SURVEY DATA HELD ON APRIL-2022. GTS BENCH MARK OF 261.850M CONSIDERED ON TOP OF CANAL BRIDGE ABUTMENT AT DORAHA VILLAGE ALONG THE NH1.
5. DFC NEW CHAINAGE OF 1075.950M IS WITH REFERENCE TO THE IR KM OF 187.500KM END OF KM OF CP-303(SECTION P-3 PILKHANI END) AGAINST THE EXISTING DFC CHAINAGE. 116277.742M ISSUED VIDE LETTER NO. COM/DFCC/UM/SURVEY/2021-301-230116-011173 DT. 17.01.2023.
6. BALLAST PROFILE HAS BEEN PROVIDED ACCORDING TO THE CLAUSE 1.11.3 OF STANDARD SCHEDULE OF DIMENSION(EASTERN CORRIDOR) & THE BALLAST CUSHION DIMENSION SHOWN IN 35CM ON GE-14 PARA 17. SPECIFICATIONS & RECOMMENDATIONS 2. TWO LAYER SYSTEM FIG.10.


REFERENCE DRAWINGS :-

1. FOR KEY PLAN REFER DRAWING NO. 301-2/AL/0001
2. FOR LEGEND AND ABBREVIATIONS REFER DRAWING NO. 301-2/AL/1000
3. FOR TYPICAL SECTION OF BALLAST PROFILE (FL-RL) REFER DRG. NO. 301-2/TK/TFD/-004 (TR.1952)

0	26.09.2024	SUBMISSION OF AS-BUILT DRAWING	FOR APPROVAL
REV.	DATE	REVISION DETAILS	PURPOSE OF ISSUE

SCALE
HOR - 1:1000
VER - 1:100
SHEET SIZE : A1

LEGEND:
IR TRACK
DFCC TRACK
DFCC FUTURE PROPOSALS
STRUCTURE / BUILDING
DFCC TOE LINE
DFCC FORMATION
RETAINING WALL
ROAD
STREAM, DRAIN, NALA, CANAL.
FENCE
POWER LINES
TBM
ELECTRIC POLE/OHE MAST
IR RAILWAY BOUNDARY
DFCC BOUNDARY

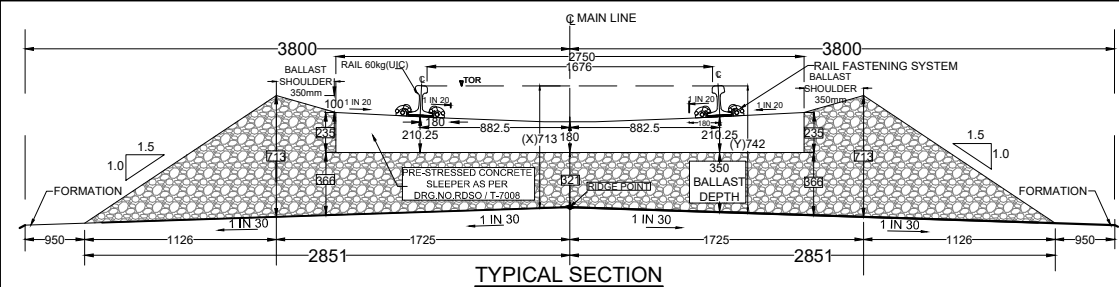

TRACK STRUCTURE		
RAIL SECTION: 60Kg/m (UIC 60Kg/m) DFC LINE: 60Kg/m (UIC 60Kg/m) IR MAIN LINE: 52Kg/m	Difference between FL- RL (Below Rail Seat)	
	IR Line	DFC
RUBBER PAD	172mm	172mm
SLEEPER DEPTH	6mm	10mm
BALLAST CUSHION	210mm	210mm
Total Depth (FL TO RL)	300mm	350mm
	688mm	742mm

OWNER
DEDICATED FREIGHT CORRIDOR CORPORATION OF INDIA LTD.
(A GOVERNMENT OF INDIA ENTERPRISE)
PROJECT OFFICE(AMBALA UNIT): OLD RAILWAY COLONY (NEAR ANAND MARKET),AMBALA CANTT-133001.
CORPORATE IDENTITY NO. : U60232DL2006GGI155068

ENGINEER:
DB Engineering & Consulting GmbH
Deutsche Bahn Engineering & Consulting GmbH

CONTRACTOR:
GIL - TPL JV
GAR TATA

SUBMITTED BY	GIL - TPL JV		
	DATED	NAME	SIGNATURE
PREPARED BY			
CHECKED BY	26.09.2024	VIJAY PRATAP	
APPROVED BY	26.09.2024	PARASURAM KOTYADA	

APPROVED BY	DEUTSCHE BAHN ENGINEERING & CONSULTING GMBH		
	DATED	NAME	SIGNATURE
Sr. DE./CHIEF ENGINEER		SURESH K.YALANGI	
CHIEF TRACK ENGINEER		RAJ PAL SINGH	
T.L.		H.D. VIDJAK	

STAMP	A AS-BUILT DRAWING TR. Ref.:..... ENGINEER Sign.:.....		
EMPLOYER (DFCCIL):	DEDICATED FREIGHT CORRIDOR CORPORATION OF INDIA LTD.		

AS BUILT DRAWING			
TITLE AS-BUILT PLAN AND PROFILE FROM IR KM: 328.000 TO 328.500 DFC KM:1218.876 TO 1219.376		DFCC APPR. NO. - ENGG. APPR. NO. - DRG. NO. -301-2/AL/A/1282 SHEET NO. : 1 OF 1 DATE : 26.09.2024	STATUS A

TR.