
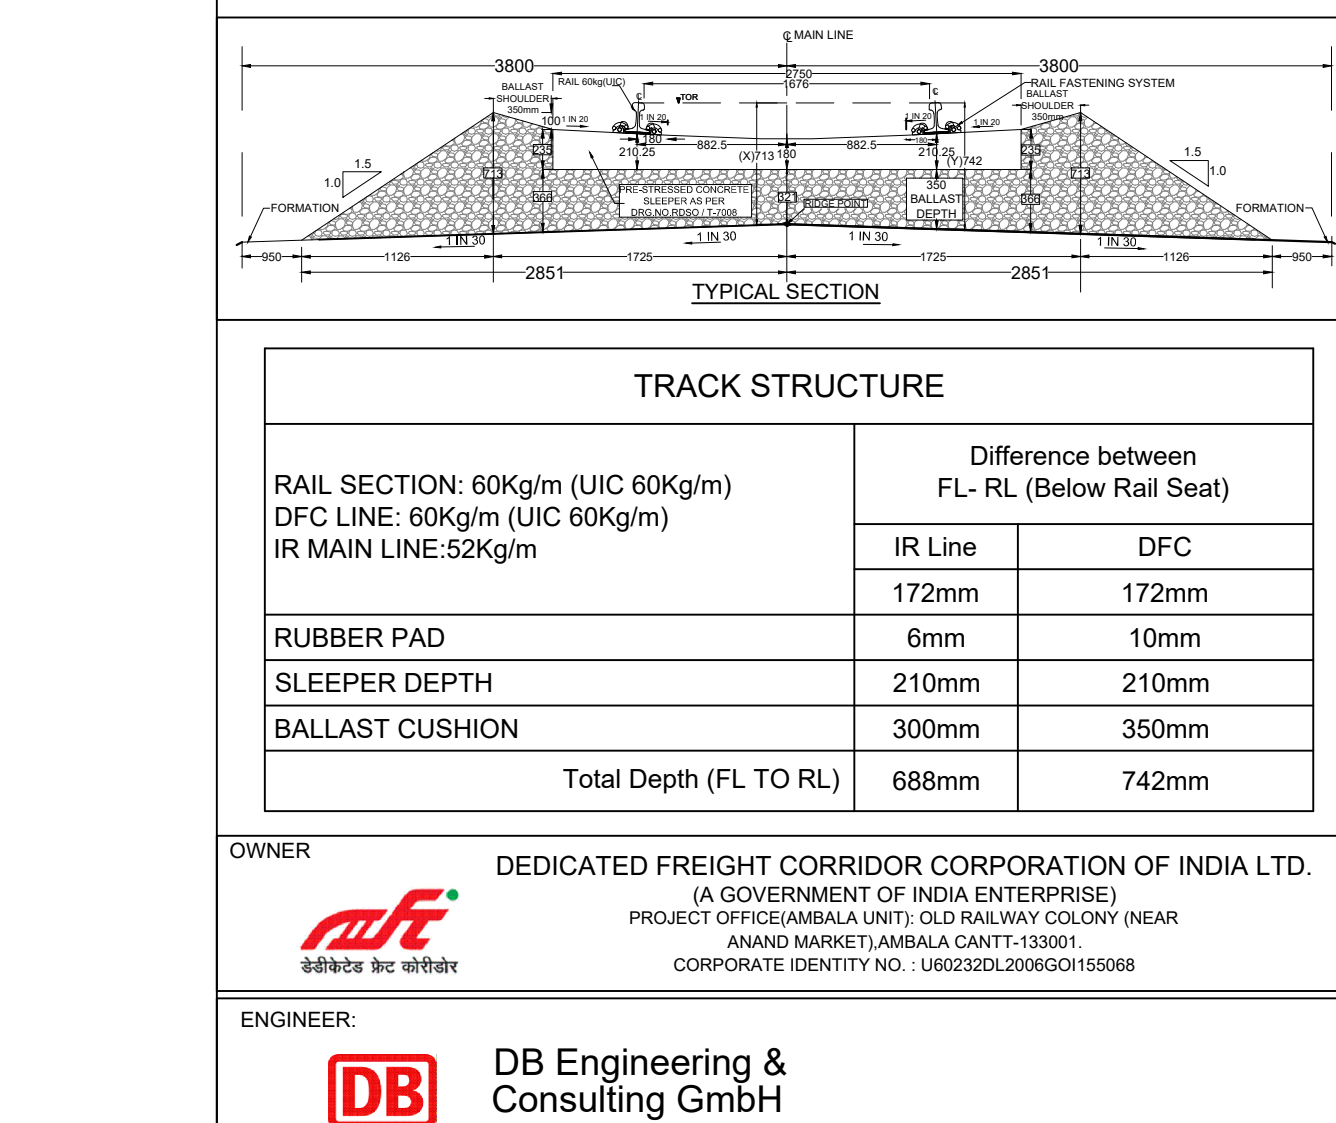


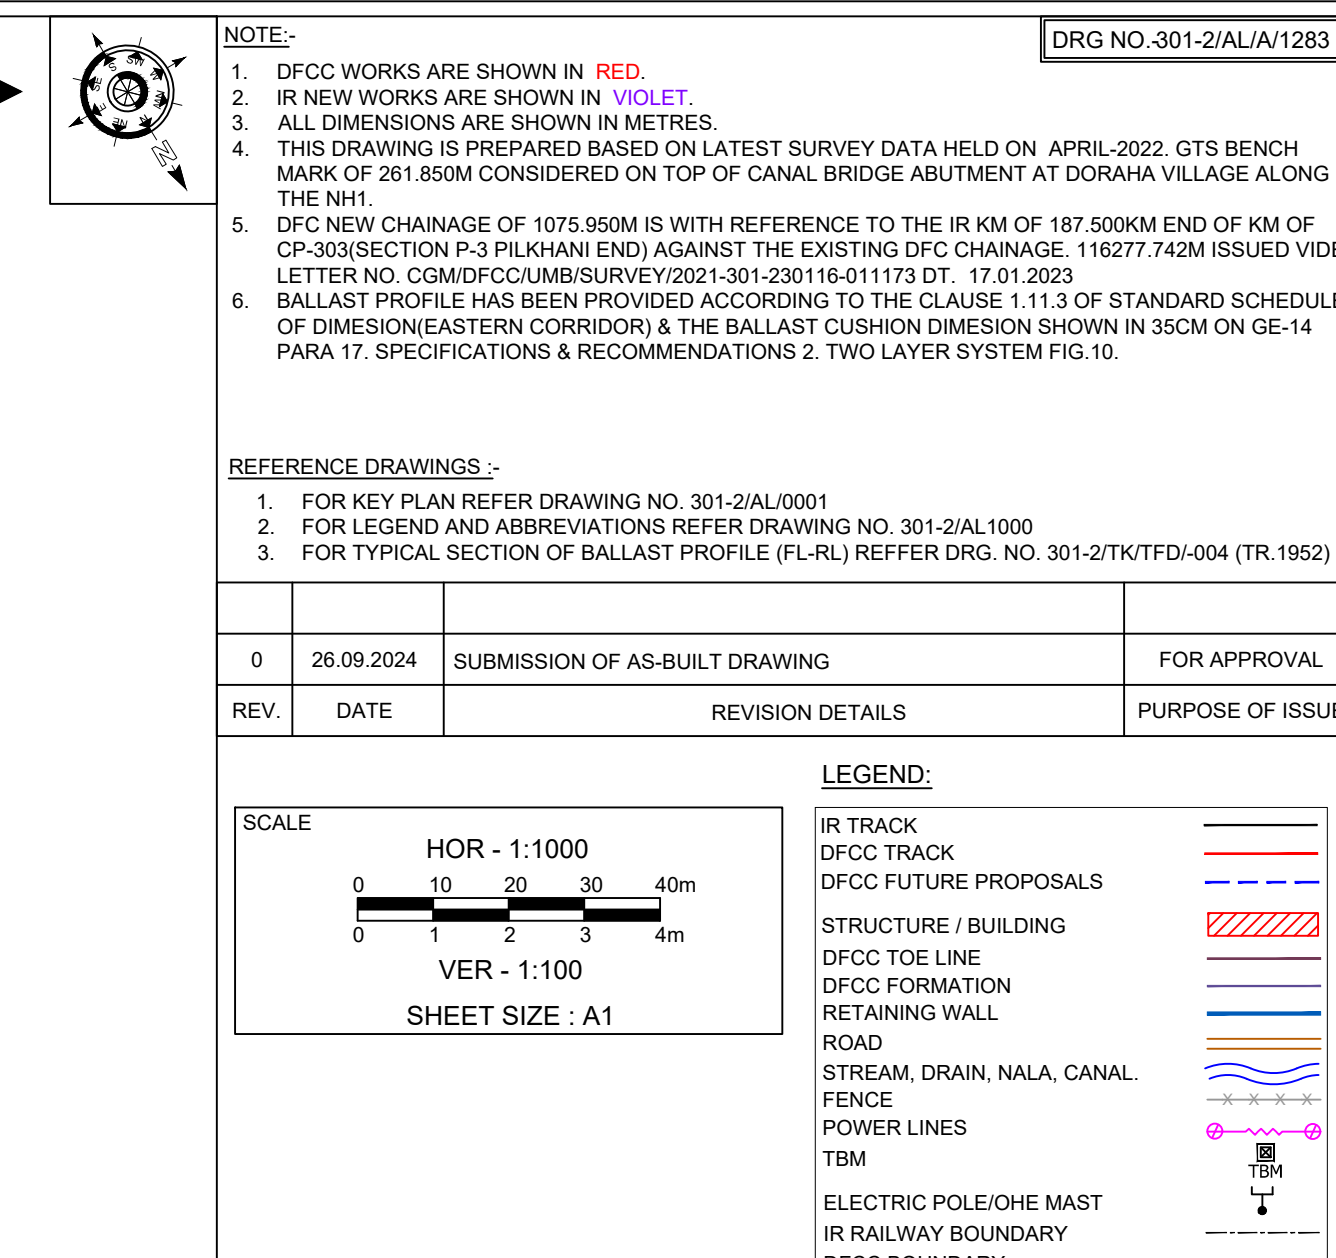

Deutsche Bahn Engineering & Consulting GmbH  			
GIL - TPL JV			
SUBMITTED BY		GIL - TPL JV	
PREPARED BY	DATED	NAME	SIGNATURE
CHECKED BY	26.09.2024	VIJAY PRATAP	
APPROVED BY	26.09.2024	PARASURAM KOTYADA	
APPROVED BY		DEUTSCHE BAHN ENGINEERING & CONSULTING GMBH	
	DATED	NAME	SIGNATURE
Sr. DE./CHIEF ENGINEER		SURESH K.YALANGI	
CHIEF TRACK ENGINEER		RAJ PAL SINGH	
T.L.		H.D. VIDJAK	
STAMP		A AS-BUILT DRAWING TR. Ref..... ENGINEER Sign.:	
EMPLOYER (DFCCIL):		DEDICATED FREIGHT CORRIDOR CORPORATION OF INDIA LTD.	
AS BUILT DRAWING			
TITLE		DFCC APPR. NO. -	
AS-BUILT PLAN AND PROFILE		ENGG. APPR. NO. -	
FROM 15 KM/200.500 TO 200.000		DRG. NO. - 301/3/A/IA/1283	