
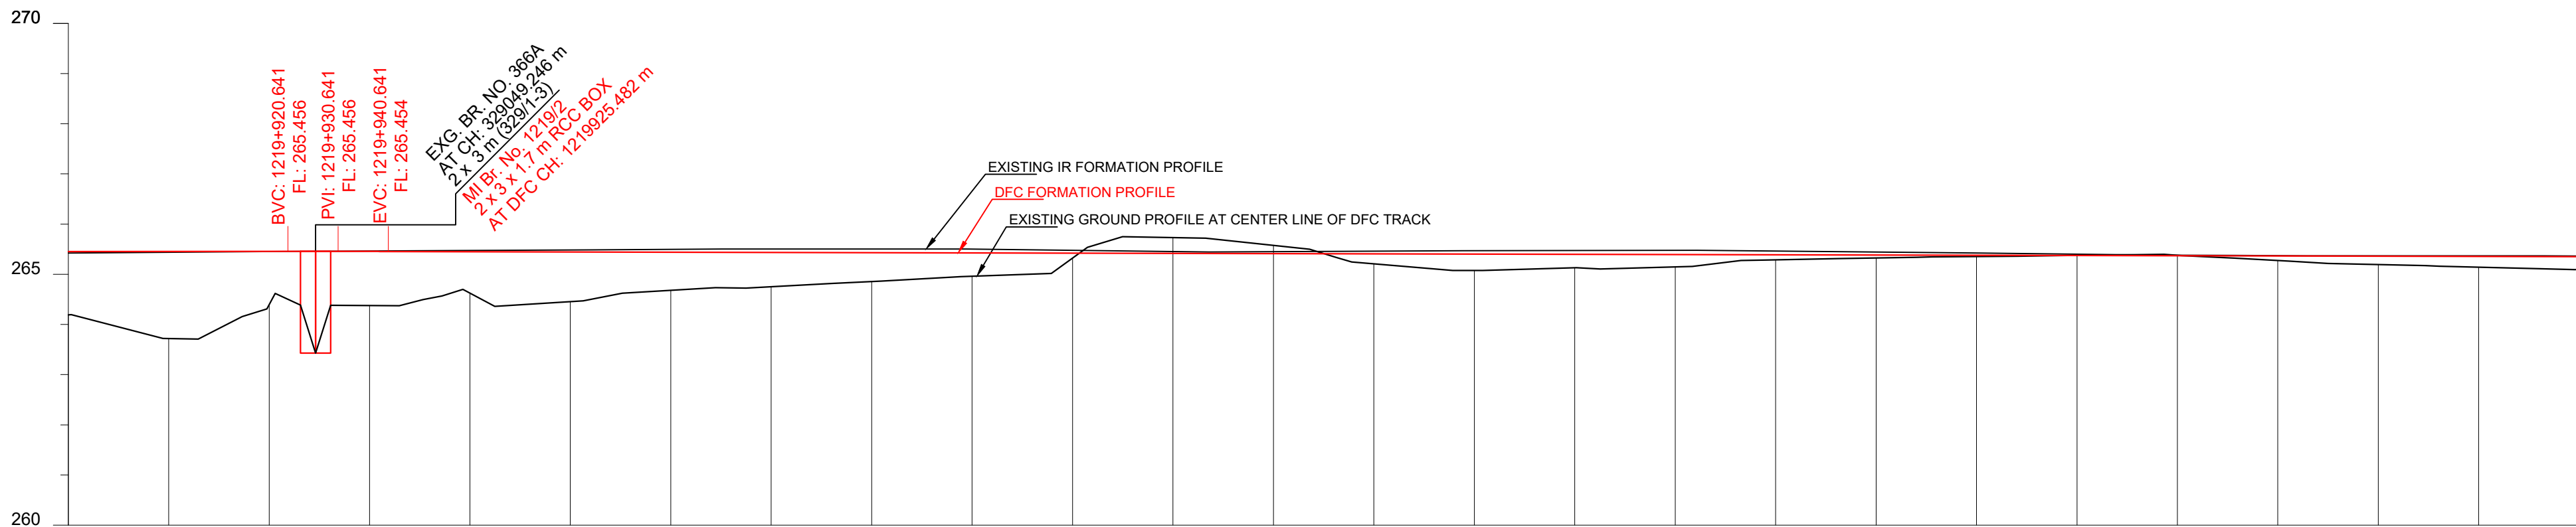


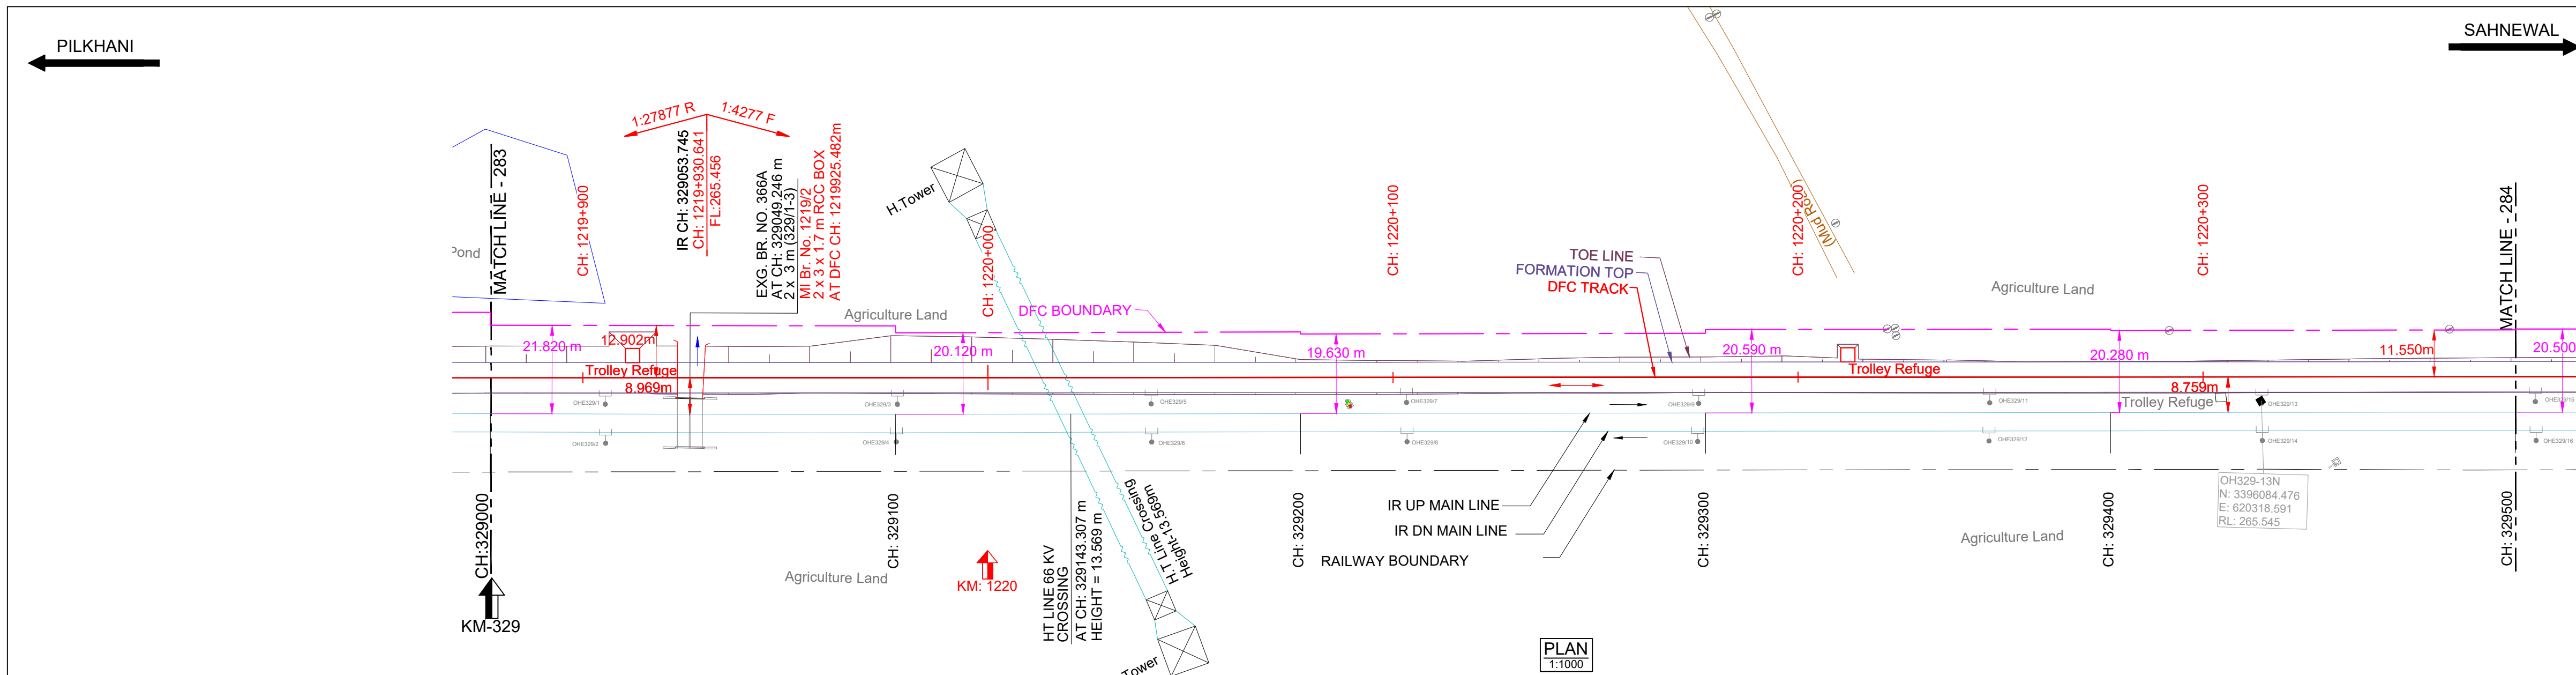

DATUM ABOVE MSL : 260 m

HORIZONTAL ALIGNMENT	L = 5592.259m																			
VERTICAL ALIGNMENT	L=1480.101 m 1 IN 27877.218 R L=20.0 m R=74160 m L=1479.968 m 1 IN 4276.874 F																			
TRACK DISTANCE FROM EXISTING NEAREST IR UP MAIN LINE TO DFC MAIN LINE	8.830	8.887	8.943	9.000	9.052	9.099	9.025	9.003	8.971	8.939	8.905	8.871	8.851	8.840	8.827	8.807	8.787	8.781	8.779	8.776
HEIGHT OF BANKING(+) / DEPTH OF CUTTING(-) (PFL-GL)	+1.262	+1.736	+1.063	+1.080	+0.825	+0.990	+0.760	+0.684	+0.577	+0.468	+0.101	-0.313	-0.162	-0.201	+0.327	+0.271	+0.246	+0.101	+0.060	+0.026
EXG GROUND LEVEL AT CENTER LINE OF DFC TRACK (GL)	264.192	263.719	264.393	264.375	264.625	264.455	264.681	264.752	264.854	264.959	265.321	265.730	265.575	265.207	265.076	265.128	265.148	265.288	265.325	265.354
EXG GROUND LEVEL AT TOE LOCATION OF DFC TRACK	263.303	263.326	263.314	263.359	263.258	262.044	262.215	262.514	262.849	263.304	264.995	265.742	265.508	264.863	264.692	264.673	264.540	264.949	265.040	265.253
DIFFERENCE BETWEEN DFC FORMATION LEVEL AND EXG.FORMATION LEVEL.(PFL-EFL)	0.033	0.019	0.005	-0.007	-0.023	-0.039	-0.056	-0.067	-0.072	-0.076	-0.056	-0.036	-0.038	-0.053	-0.067	-0.076	-0.084	-0.073	-0.058	-0.042
DFC FORMATION LEVEL (PFL)	265.454	265.455	265.456	265.455	265.450	265.445	265.441	265.436	265.431	265.427	265.422	265.417	265.413	265.408	265.403	265.399	265.394	265.389	265.385	265.380
EXG. FORMATION LEVEL OF EXG IR UP MAIN LINE (EFL)	265.421	265.436	265.451	265.482	265.473	265.485	265.497	265.503	265.504	265.503	265.478	265.454	265.451	265.461	265.470	265.474	265.478	265.483	265.443	265.422
DIFFERENCE BETWEEN DFC RAIL LEVEL AND EXG. RAIL LEVEL (PRL - ERL)	0.074	0.059	0.045	0.033	0.018	0.001	-0.015	-0.026	-0.031	-0.035	-0.015	0.005	0.003	-0.012	-0.026	-0.035	-0.043	-0.033	-0.017	-0.002
DFC RAIL LEVEL (PRL)	266.167	266.168	266.168	266.168	266.163	266.158	266.154	266.149	266.144	266.140	266.135	266.130	266.126	266.121	266.116	266.112	266.107	266.102	266.097	266.093
EXG.RAIL LEVEL OF NEAREST IR UP MAIN LINE(ERL)	266.093	266.108	266.123	266.134	266.145	266.157	266.169	266.175	266.176	266.175	266.150	266.126	266.123	266.133	266.142	266.146	266.150	266.135	266.115	266.094
EQUIVALENT CHAINAGE ON DFC TRACK	1219976.7	1219996.6	1219916.6	1219936.6	1219956.5	1219976.5	1219996.5	1220016.5	1220036.5	1220056.5	1220076.5	1220096.5	1220116.5	1220136.5	1220156.5	1220176.5	1220196.5	1220216.5	1220236.5	1220256.5
EXISTING IR CHAINAGE	329000.0	329020.0	329040.0	329060.0	329080.0	329100.0	329120.0	329140.0	329160.0	329180.0	329200.0	329220.0	329240.0	329260.0	329280.0	329300.0	329320.0	329340.0	329360.0	329380.0


L - SECTION

- NOTE:-
1. DFC WORKS ARE SHOWN IN RED.
 2. IR NEW WORKS ARE SHOWN IN VIOLET.
 3. ALL DIMENSIONS ARE SHOWN IN METRES.
 4. THIS DRAWING IS PREPARED BASED ON LATEST SURVEY DATA HELD ON APRIL-2022. GTS BENCH MARK OF 261.850M CONSIDERED ON TOP OF CANAL BRIDGE ABUTMENT AT DORAHA VILLAGE ALONG THE NH1.
 5. DFC NEW CHAINAGE OF 1075.950M IS WITH REFERENCE TO THE IR KM OF 187.500KM END OF KM OF CP-303(SECTION P-3 PILKHANI END) AGAINST THE EXISTING DFC CHAINAGE. 116277.742M ISSUED VIDE LETTER NO. COM/DFCC/MB/SURVEY/2021-301-230116-011173 DT. 17.01.2023.
 6. BALLAST PROFILE HAS BEEN PROVIDED ACCORDING TO THE CLAUSE 1.11.3 OF STANDARD SCHEDULE OF DIMENSION(EASTERN CORRIDOR) & THE BALLAST CUSHION DIMENSION SHOWN IN 35CM ON GE-14 PARA 17. SPECIFICATIONS & RECOMMENDATIONS 2. TWO LAYER SYSTEM FIG.10.

- REFERENCE DRAWINGS :-
1. FOR KEY PLAN REFER DRAWING NO. 301-2/AL/0001
 2. FOR LEGEND AND ABBREVIATIONS REFER DRAWING NO. 301-2/AL/1000
 3. FOR TYPICAL SECTION OF BALLAST PROFILE (FL-RL) REFER DRG. NO. 301-2/TK/TFD/-004 (TR.1952)

0	26.09.2024	SUBMISSION OF AS-BUILT DRAWING	FOR APPROVAL
REV.	DATE	REVISION DETAILS	PURPOSE OF ISSUE

SCALE	LEGEND:
HOR - 1:1000 VER - 1:100 SHEET SIZE : A1	IR TRACK DFCC TRACK DFCC FUTURE PROPOSALS STRUCTURE / BUILDING DFCC TOE LINE DFCC FORMATION RETAINING WALL ROAD STREAM, DRAIN, NALA, CANAL. FENCE POWER LINES TBM ELECTRIC POLE/OHE MAST IR RAILWAY BOUNDARY DFCC BOUNDARY

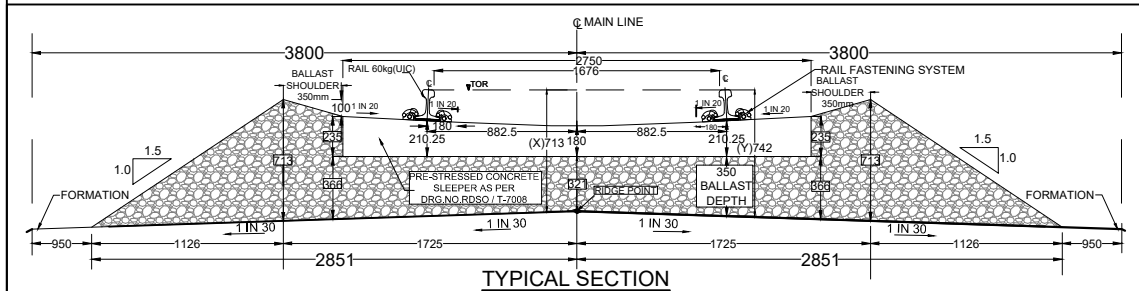

TRACK STRUCTURE		
RAIL SECTION: 60Kg/m (UIC 60Kg/m) DFC LINE: 60Kg/m (UIC 60Kg/m) IR MAIN LINE: 52Kg/m	Difference between FL- RL (Below Rail Seat)	
	IR Line	DFC
RUBBER PAD	172mm	172mm
SLEEPER DEPTH	6mm	10mm
BALLAST CUSHION	210mm	210mm
Total Depth (FL TO RL)	300mm	350mm

OWNER: DEDICATED FREIGHT CORRIDOR CORPORATION OF INDIA LTD. (A GOVERNMENT OF INDIA ENTERPRISE)
PROJECT OFFICE(AMBALA UNIT): OLD RAILWAY COLONY (NEAR ANAND MARKET),AMBALA CANTT.-130001.
CORPORATE IDENTITY NO. : U60232DL2006GGI155068

ENGINEER: DB Engineering & Consulting GmbH
Deutsche Bahn Engineering & Consulting GmbH

CONTRACTOR: GIL - TPL JV
GAR TATA

SUBMITTED BY	GIL - TPL JV		
	DATED	NAME	SIGNATURE
PREPARED BY			
CHECKED BY	26.09.2024	VIJAY PRATAP	
APPROVED BY	26.09.2024	PARASURAM KOTYADA	

APPROVED BY	DEUTSCHE BAHN ENGINEERING & CONSULTING GMBH		
	DATED	NAME	SIGNATURE
Sr. DE./CHIEF ENGINEER		SURESH K.YALANGI	
CHIEF TRACK ENGINEER		RAJ PAL SINGH	
T.L.		H.D. VIDJAK	

STAMP	A AS-BUILT DRAWING TR. Ref.:..... ENGINEER Sign.:.....		
EMPLOYER (DFCCIL):	DEDICATED FREIGHT CORRIDOR CORPORATION OF INDIA LTD.		

AS BUILT DRAWING			
TITLE AS-BUILT PLAN AND PROFILE FROM IR KM: 329.000 TO 329.500 DFC KM:1219.877 TO 1220.376	DFCC APPR. NO. -		
	ENGG. APPR. NO. -		
	DRG. NO. - 301-2/AL/A/1284		
	SHEET NO. : 1 OF 1		STATUS A
	DATE : 26.09.2024		

TR.