
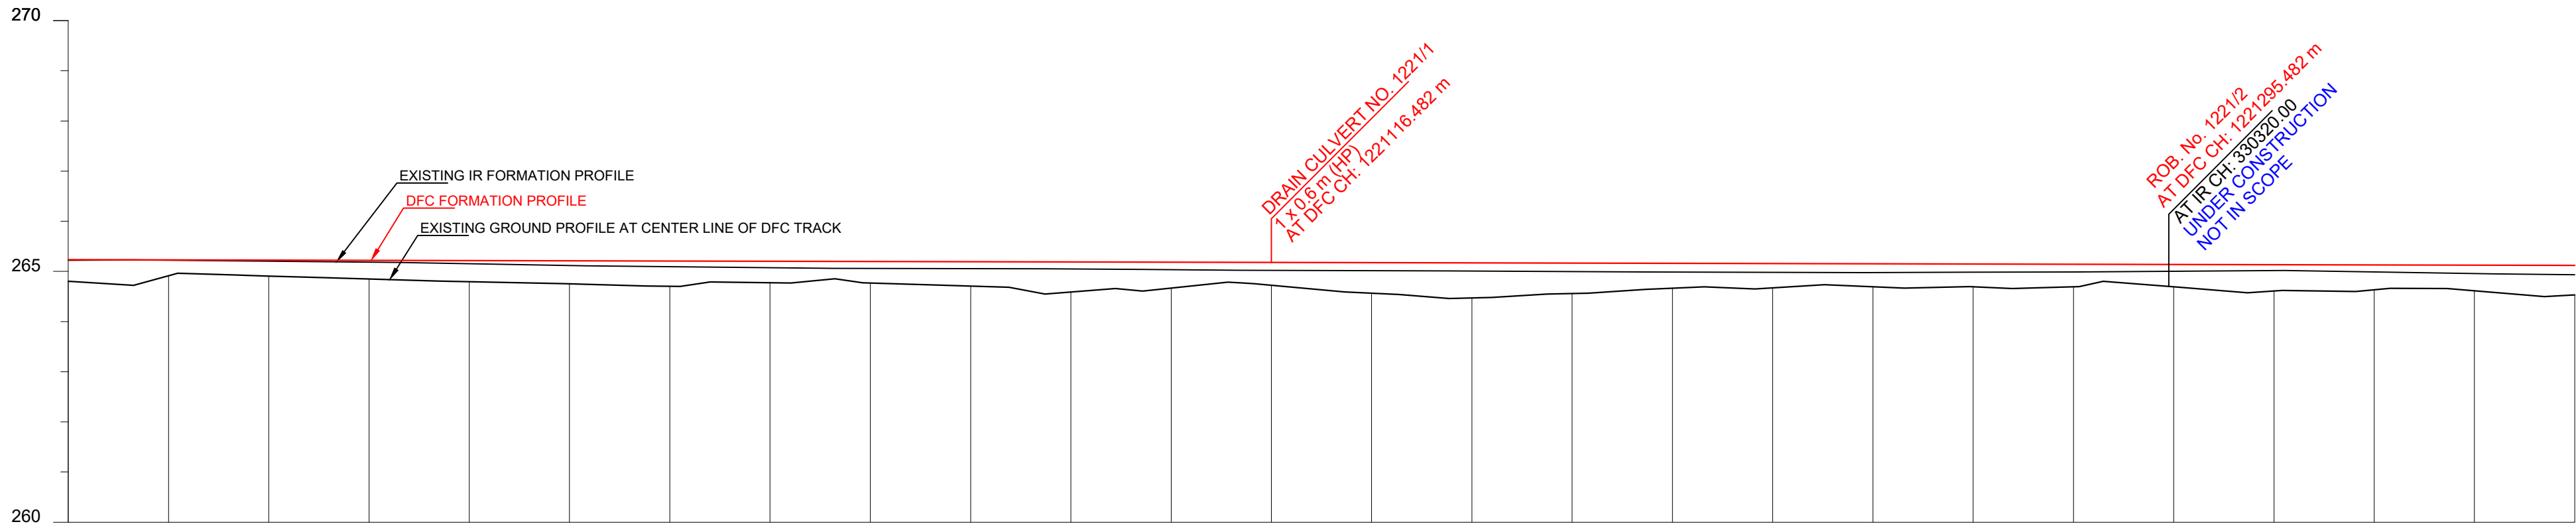


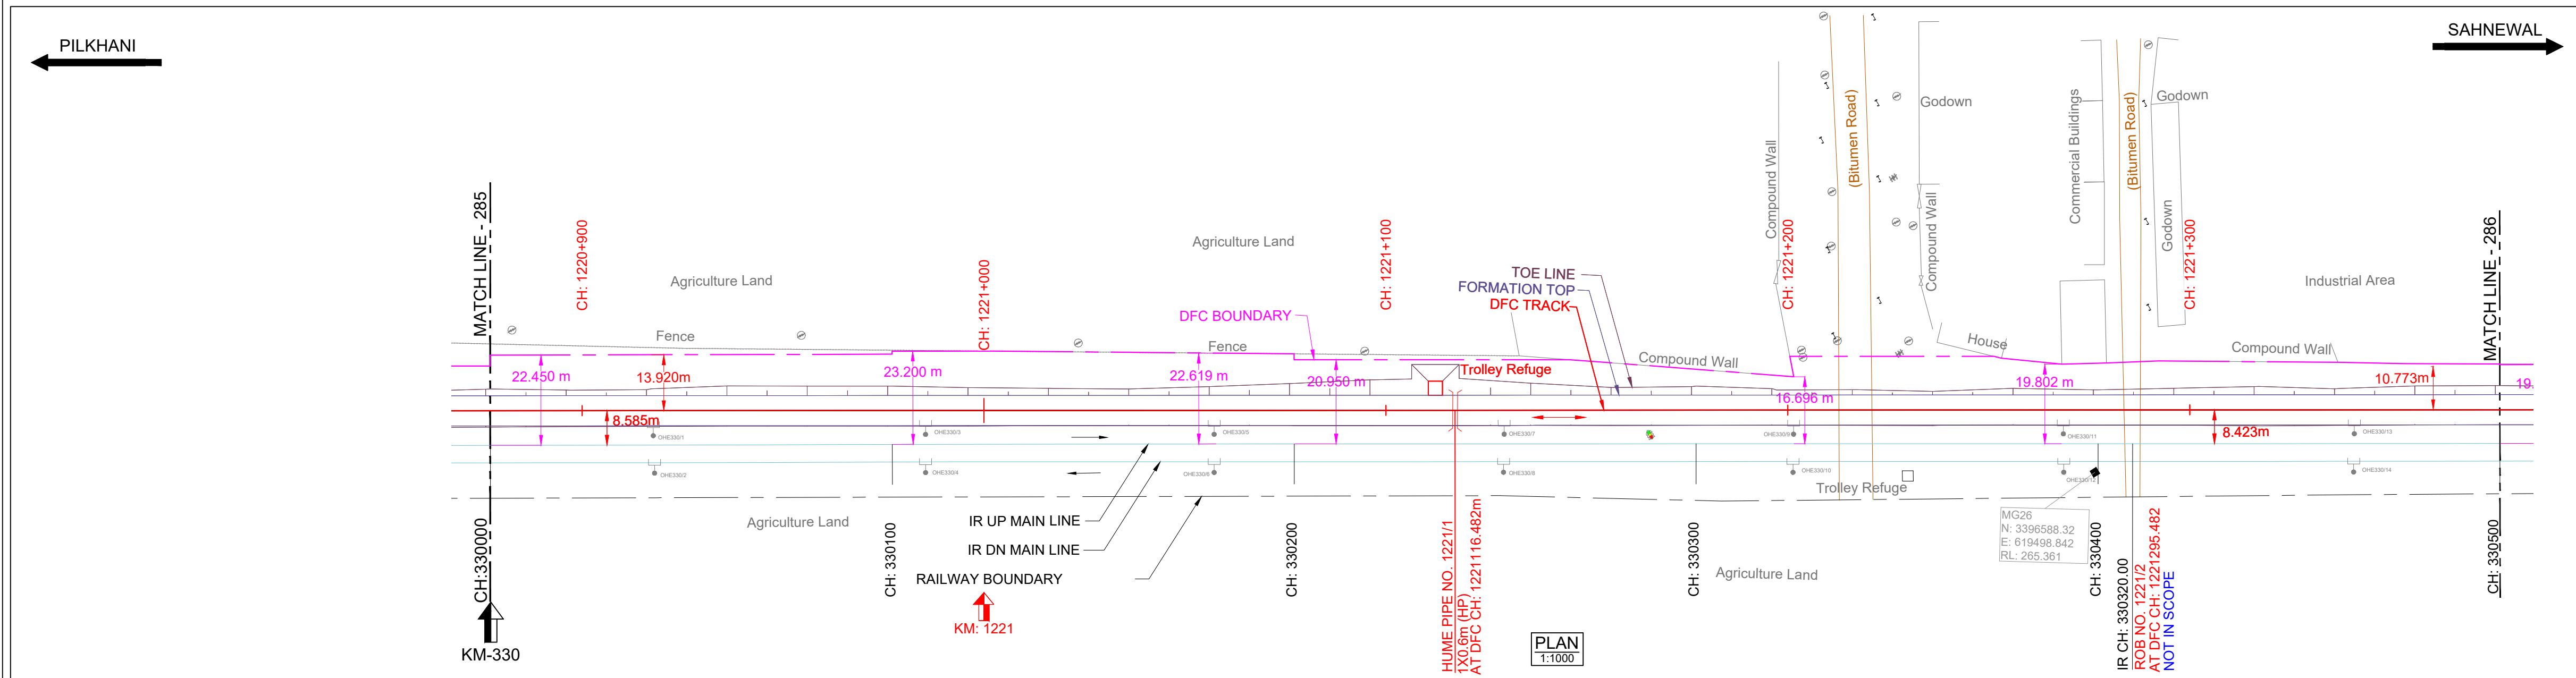


DATUM ABOVE MSL : 260 m

HORIZONTAL ALIGNMENT	L = 5592.259m																			
VERTICAL ALIGNMENT	L=1479.968 m 1 IN 4276.874 F																			
TRACK DISTANCE FROM EXISTING NEAREST IR UP MAIN LINE TO DFC MAIN LINE	8.602	8.593	8.575	8.558	8.498	8.422	8.396	8.380	8.367	8.363	8.362	8.373	8.380	8.378	8.376	8.376	8.378	8.392	8.387	8.403
HEIGHT OF BANKING(+) / DEPTH OF CUTTING(-) (PFL-GL)	+0.431	+0.318	+0.319	+0.319	+0.373	+0.422	+0.503	+0.428	+0.429	+0.486	+0.599	+0.515	+0.455	+0.608	+0.699	+0.604	+0.497	+0.483	+0.458	+0.451
EXG GROUND LEVEL AT CENTER LINE OF DFC TRACK (GL)	-264.804	-264.912	-264.907	-264.848	-264.794	-264.751	-264.704	-264.774	-264.769	-264.707	-264.569	-264.669	-264.724	-264.566	-264.471	-264.561	-264.663	-264.673	-264.693	-264.695
EXG GROUND LEVEL AT TOE LOCATION OF DFC TRACK	-264.303	-264.444	-264.269	-263.913	-263.928	-263.943	-264.127	-264.228	-264.273	-263.976	-263.609	-263.153	-262.949	-263.600	-264.114	-263.947	-264.441	-264.400	-264.592	-264.241
DIFFERENCE BETWEEN DFC FORMATION LEVEL AND EXG.FORMATION LEVEL.(PFL-EFL)	0.012	0.007	0.021	0.035	0.063	0.095	0.114	0.130	0.139	0.139	0.141	0.149	0.156	0.159	0.161	0.167	0.172	0.173	0.173	0.162
DFC FORMATION LEVEL (PFL)	-265.235	-265.230	-265.228	-265.221	-265.216	-265.212	-265.207	-265.202	-265.198	-265.193	-265.188	-265.184	-265.179	-265.174	-265.170	-265.165	-265.160	-265.156	-265.151	-265.146
EXG. FORMATION LEVEL OF EXG IR UP MAIN LINE (EFL)	-265.223	-265.224	-265.205	-265.186	-265.154	-265.117	-265.093	-265.073	-265.058	-265.054	-265.048	-265.035	-265.021	-265.016	-265.009	-264.998	-264.988	-264.983	-264.978	-264.984
DIFFERENCE BETWEEN DFC RAIL LEVEL AND EXG. RAIL LEVEL (PRL - ERL)	0.053	0.047	0.062	0.076	0.103	0.136	0.154	0.170	0.180	0.180	0.181	0.190	0.199	0.199	0.201	0.208	0.213	0.214	0.214	0.203
DFC RAIL LEVEL (PRL)	-265.948	-265.943	-265.938	-265.934	-265.929	-265.924	-265.920	-265.915	-265.910	-265.906	-265.901	-265.896	-265.892	-265.887	-265.882	-265.878	-265.873	-265.868	-265.864	-265.859
EXG.RAIL LEVEL OF NEAREST IR UP MAIN LINE(ERL)	-265.895	-265.896	-265.877	-265.858	-265.826	-265.789	-265.785	-265.745	-265.730	-265.726	-265.720	-265.707	-265.693	-265.688	-265.681	-265.670	-265.660	-265.655	-265.650	-265.641
EQUIVALENT CHAINAGE ON DFC TRACK	-1220876.5	-1220896.5	-1220916.5	-1220936.5	-1220956.5	-1220976.5	-1220996.5	-1221016.5	-1221036.5	-1221056.5	-1221076.5	-1221096.5	-1221116.5	-1221136.5	-1221156.5	-1221176.5	-1221196.5	-1221216.5	-1221236.5	-1221256.5
EXISTING IR CHAINAGE	330000.0	330020.0	330040.0	330060.0	330080.0	330100.0	330120.0	330140.0	330160.0	330180.0	330200.0	330220.0	330240.0	330260.0	330280.0	330300.0	330320.0	330340.0	330360.0	330380.0

L - SECTION

SAHNEWAL

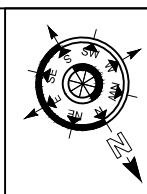

NOTE:-


1. DFC WORKS ARE SHOWN IN RED.
2. IR NEW WORKS ARE SHOWN IN VIOLET.
3. ALL DIMENSIONS ARE SHOWN IN METRES.
4. THIS DRAWING IS PREPARED BASED ON LATEST SURVEY DATA HELD ON APRIL-2022, GTS BENCH MARK OF 261.850M CONSIDERED ON TOP OF CANAL BRIDGE ABUTMENT AT DORAHA VILLAGE ALONG THE NH1.
5. DFC NEW CHAINAGE OF 1075.950M IS WITH REFERENCE TO THE IR KM OF 187.500KM END OF KM OF CP-303(SECTION P-3 PILKHANI END) AGAINST THE EXISTING DFC CHAINAGE 116277.742M ISSUED VIDE LETTER NO. COM/DFCC/UMS/SURVEY/2021-301-230116-011173 DT. 17.01.2023.
6. BALLAST PROFILE HAS BEEN PROVIDED ACCORDING TO THE CLAUSE 1.11.3 OF STANDARD SCHEDULE OF DIMENSION(EASTERN CORRIDOR) & THE BALLAST CUSHION DIMENSION SHOWN IN 35CM ON GE-14 PARA 17. SPECIFICATIONS & RECOMMENDATIONS 2. TWO LAYER SYSTEM FIG.10.

REFERENCE DRAWINGS :-

1. FOR KEY PLAN REFER DRAWING NO. 301-2/AL/0001
2. FOR LEGEND AND ABBREVIATIONS REFER DRAWING NO. 301-2/AL/1000
3. FOR TYPICAL SECTION OF BALLAST PROFILE (FL-RL) REFER DRG. NO. 301-2/TK/TFD/-004 (TR.1952)

0	26.09.2024	SUBMISSION OF AS-BUILT DRAWING	FOR APPROVAL
REV.	DATE	REVISION DETAILS	PURPOSE OF ISSUE

SCALE		LEGEND:	
HOR - 1:1000 VER - 1:100 SHEET SIZE : A1		IR TRACK DFCC TRACK DFCC FUTURE PROPOSALS STRUCTURE / BUILDING DFCC TOE LINE DFCC FORMATION RETAINING WALL ROAD STREAM, DRAIN, NALA, CANAL. FENCE POWER LINES TBM ELECTRIC POLE/OHE MAST IR RAILWAY BOUNDARY DFCC BOUNDARY	

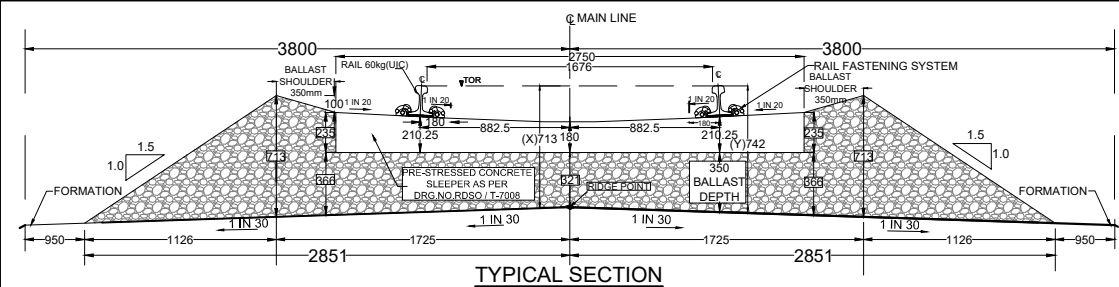

TRACK STRUCTURE		
RAIL SECTION: 60Kg/m (UIC 60Kg/m) DFC LINE: 60Kg/m (UIC 60Kg/m) IR MAIN LINE: 52Kg/m	Difference between FL- RL (Below Rail Seat)	
	IR Line	DFC
RUBBER PAD	172mm	172mm
SLEEPER DEPTH	210mm	210mm
BALLAST CUSHION	300mm	350mm
Total Depth (FL TO RL)	688mm	742mm

OWNER: DEDICATED FREIGHT CORRIDOR CORPORATION OF INDIA LTD. (A GOVERNMENT OF INDIA ENTERPRISE)
PROJECT OFFICE(AMBALA UNIT): OLD RAILWAY COLONY (NEAR ANAND MARKET),AMBALA CANTT-133001.
CORPORATE IDENTITY NO. : U60232DL2006GGI155068

ENGINEER: DB Engineering & Consulting GmbH
Deutsche Bahn Engineering & Consulting GmbH

CONTRACTOR: GIL - TPL JV
GAR TATA

SUBMITTED BY	GIL - TPL JV		
	DATED	NAME	SIGNATURE
PREPARED BY	26.09.2024	VIJAY PRATAP	
CHECKED BY	26.09.2024	PARASURAM KOTYADA	
APPROVED BY	DEUTSCHE BAHN ENGINEERING & CONSULTING GMBH		

	DATED	NAME	SIGNATURE
Sr. DE./CHIEF ENGINEER		SURESH K.YALANGI	
CHIEF TRACK ENGINEER		RAJ PAL SINGH	
T.L.		H.D. VIDJAK	

STAMP	A AS-BUILT DRAWING TR. Ref..... ENGINEER Sign.:		
EMPLOYER (DFCCIL):	DEDICATED FREIGHT CORRIDOR CORPORATION OF INDIA LTD.		

AS BUILT DRAWING			
TITLE		DFCC APPR. NO. -	
AS-BUILT PLAN AND PROFILE		ENGG. APPR. NO. -	
FROM IR KM: 330.000 TO 330.500		DRG. NO. -301-2/AL/A/1286	
DFC KM:1220.876 TO 1221.376		SHEET NO. : 1 OF 1	
		DATE : 26.09.2024	
		STATUS	
		A	

TR.