

NOTE:-



1. DFC WORKS ARE SHOWN IN RED.
2. IR NEW WORKS ARE SHOWN IN VIOLET.
3. ALL DIMENSIONS ARE GIVEN IN METERS.
4. THIS DRAWING IS PREPARED BASED ON LATEST SURVEY DATA HELD ON APRIL-2022. GTS BENCH MARK OF 261.850M CONSIDERED ON TOP OF CANAL BRIDGE ABUTMENT AT DORRAH VILLAGE ALONG THE CANAL.
5. DFC-NEW CHAINAGE OF 1075.950M IS WITH REFERENCE TO THE IR KM OF 187.500KM END OF KM OF CP-303/SECTION 3 P.5 P.ILKAN END AGAINST THE EXISTING DFC CHAINAGE. 116277.742M ISSUED VIOLET.
6. BALLAST SCUMING IS SHOWN IN GREEN. 17.00% CUSHION DITCH IS SHOWN IN SSCM ON GE-14.
7. BALLAST PROFILE HAS BEEN PROVIDED ACCORDING TO THE CLAUSE 1.11.3 OF STANDARD SCHEDULE FOR BALLAST.
8. DIMENSIONS ARE GIVEN IN METERS.
9. FOR BALLAST SPECIFICATIONS & RECOMMENDATIONS 2. TWO LAYER SYSTEM IS TO BE USED.

REFERENCE DRAWINGS :

1. FOR KEY PLAN REFER DRAWING NO. 301-2/AL/0001
2. FOR LEGEND AND ABBREVIATIONS REFER DRAWING NO. 301-2/AL/1000
3. FOR TYPICAL SECTION OF BALLAST PROFILE (FL-RL) REFFER DRG. NO. 301-2/TK/TFD/-004 (TR.1952)

0	26.09.2024	SUBMISSION OF AS-BUILT DRAWING	FOR APPROVAL
REV.	DATE	REVISION DETAILS	PURPOSE OF ISSUE

LEGEND:

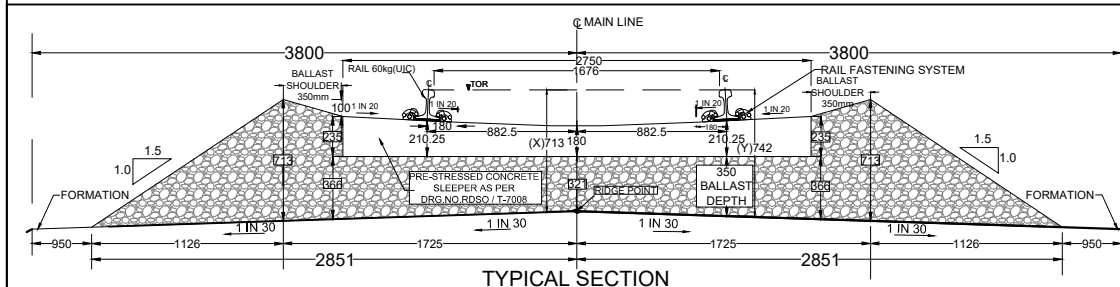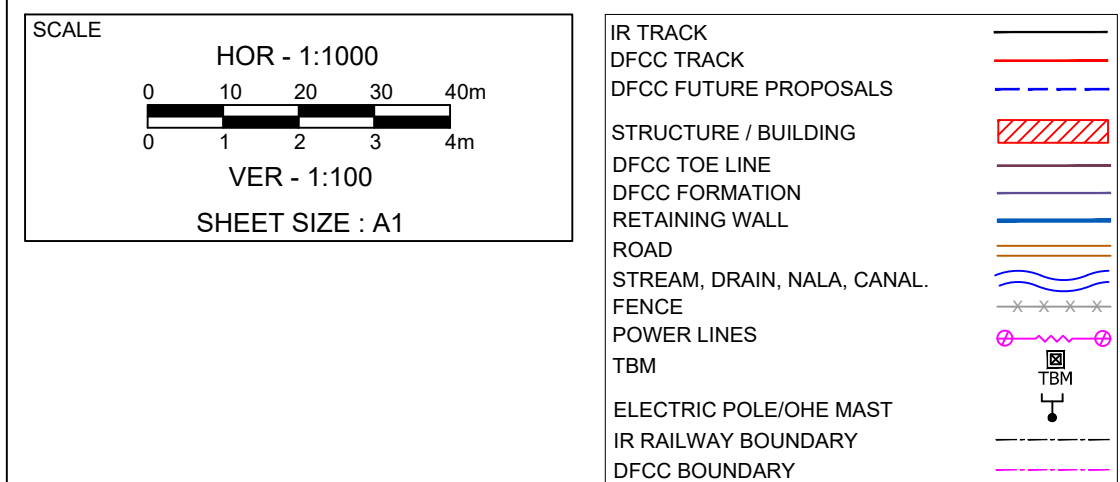

TRACK STRUCTURE		
RAIL SECTION: 60Kg/m (UIC 60Kg/m) DFC LINE: 60kg/m (UIC 60kg/m) IR MAIN LINE:52Kg/m	Difference between FL- RL (Below Rail Seat)	
	IR Line	DFC
	172mm	172mm
RUBBER PAD	6mm	10mm
SLEEPER DEPTH	210mm	210mm
BALLAST CUSHION	300mm	350mm
Total Depth (FL TO RL)	688mm	742mm

OWNER



डेडीकेटेड फ्रेट कॉरिडोर

DEDICATED FREIGHT CORRIDOR CORPORATION OF INDIA LTD.
(A GOVERNMENT OF INDIA ENTERPRISE)
PROJECT OFFICE(AMBALA UNIT): OLD RAILWAY COLONY (NEAR
ANAND MARKET),AMBALA CANTT-133001.
CORPORATE IDENTITY NO. : U60232DL200301155068

ENGINEER:

 DB Engineering &
Consulting GmbH
Deutsche Bahn Engineering & Consulting GmbH

CONTRACTOR: GIL - TPL JV

SUBMITTED BY	GIL - TPL JV		
	DATED	NAME	SIGNATURE
PREPARED BY			
CHECKED BY	26.09.2024	VIJAY PRATAP	
APPROVED BY	26.09.2024	PARASURAM KOTYADA	

APPROVED BY	DEUTSCHE BAHN ENGINEERING & CONSULTING GMBH		
	DATED	NAME	SIGNATURE
Sr. DE./CHIEF ENGINEER		SURESH K.YALANGI	
CHIEF TRACK ENGINEER		RAJ PAL SINGH	
T.L.		H.D. VIDJAK	

	
--	--

STAMP A AS BUILT DRAWING
 TR. Ref.....
 ENGINEER Sign:

ENGINEER SIGNATURE _____

EMPLOYER (DFCCIL):	DEDICATED FREIGHT CORRIDOR CORPORATION OF INDIA LTD
--------------------	---

--	--	--	--

--	--	--	--

--	--	--	--

--	--	--	--



AS BUILT DRAWING

AS BUILT DRAWING	
TITLE	AS BUILT DRAWING

AS-BUILT PLAN AND PROFILE	DFCC APPR. NO. -
	ENGG. APPR. NO. -

FROM IR KM: 330.500 TO 331.000	DRG. NO. - 301-2/AL/A/1287	
DEC KM: 1231.376 TO 1231.876	SHEET NO. : 1 OF 1	STATUS

DATE : 26.09.2024		A
-------------------	--	---

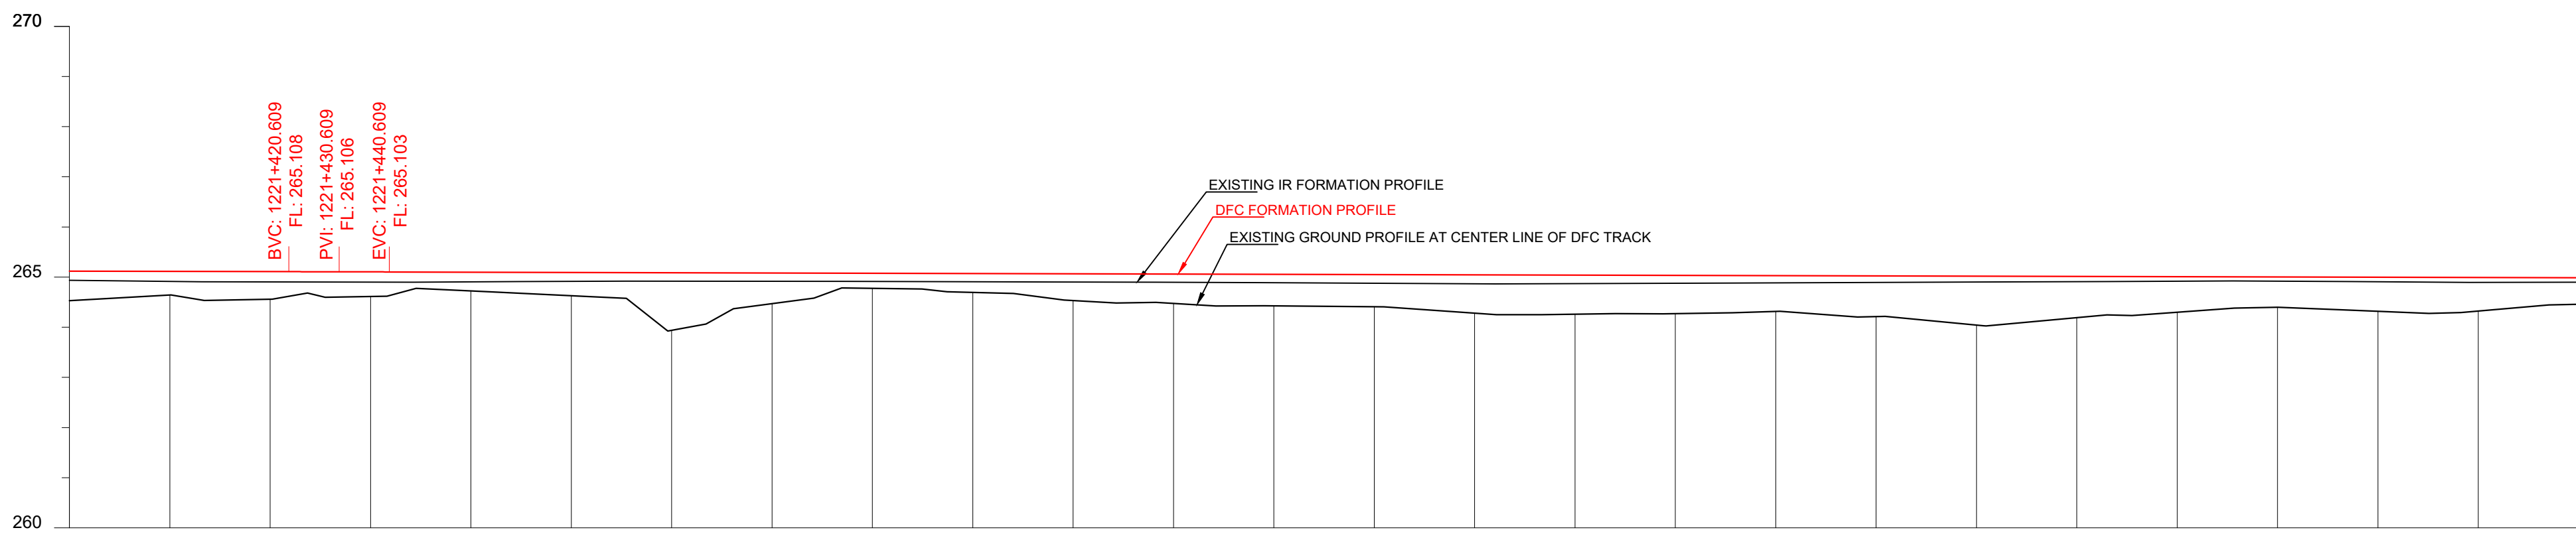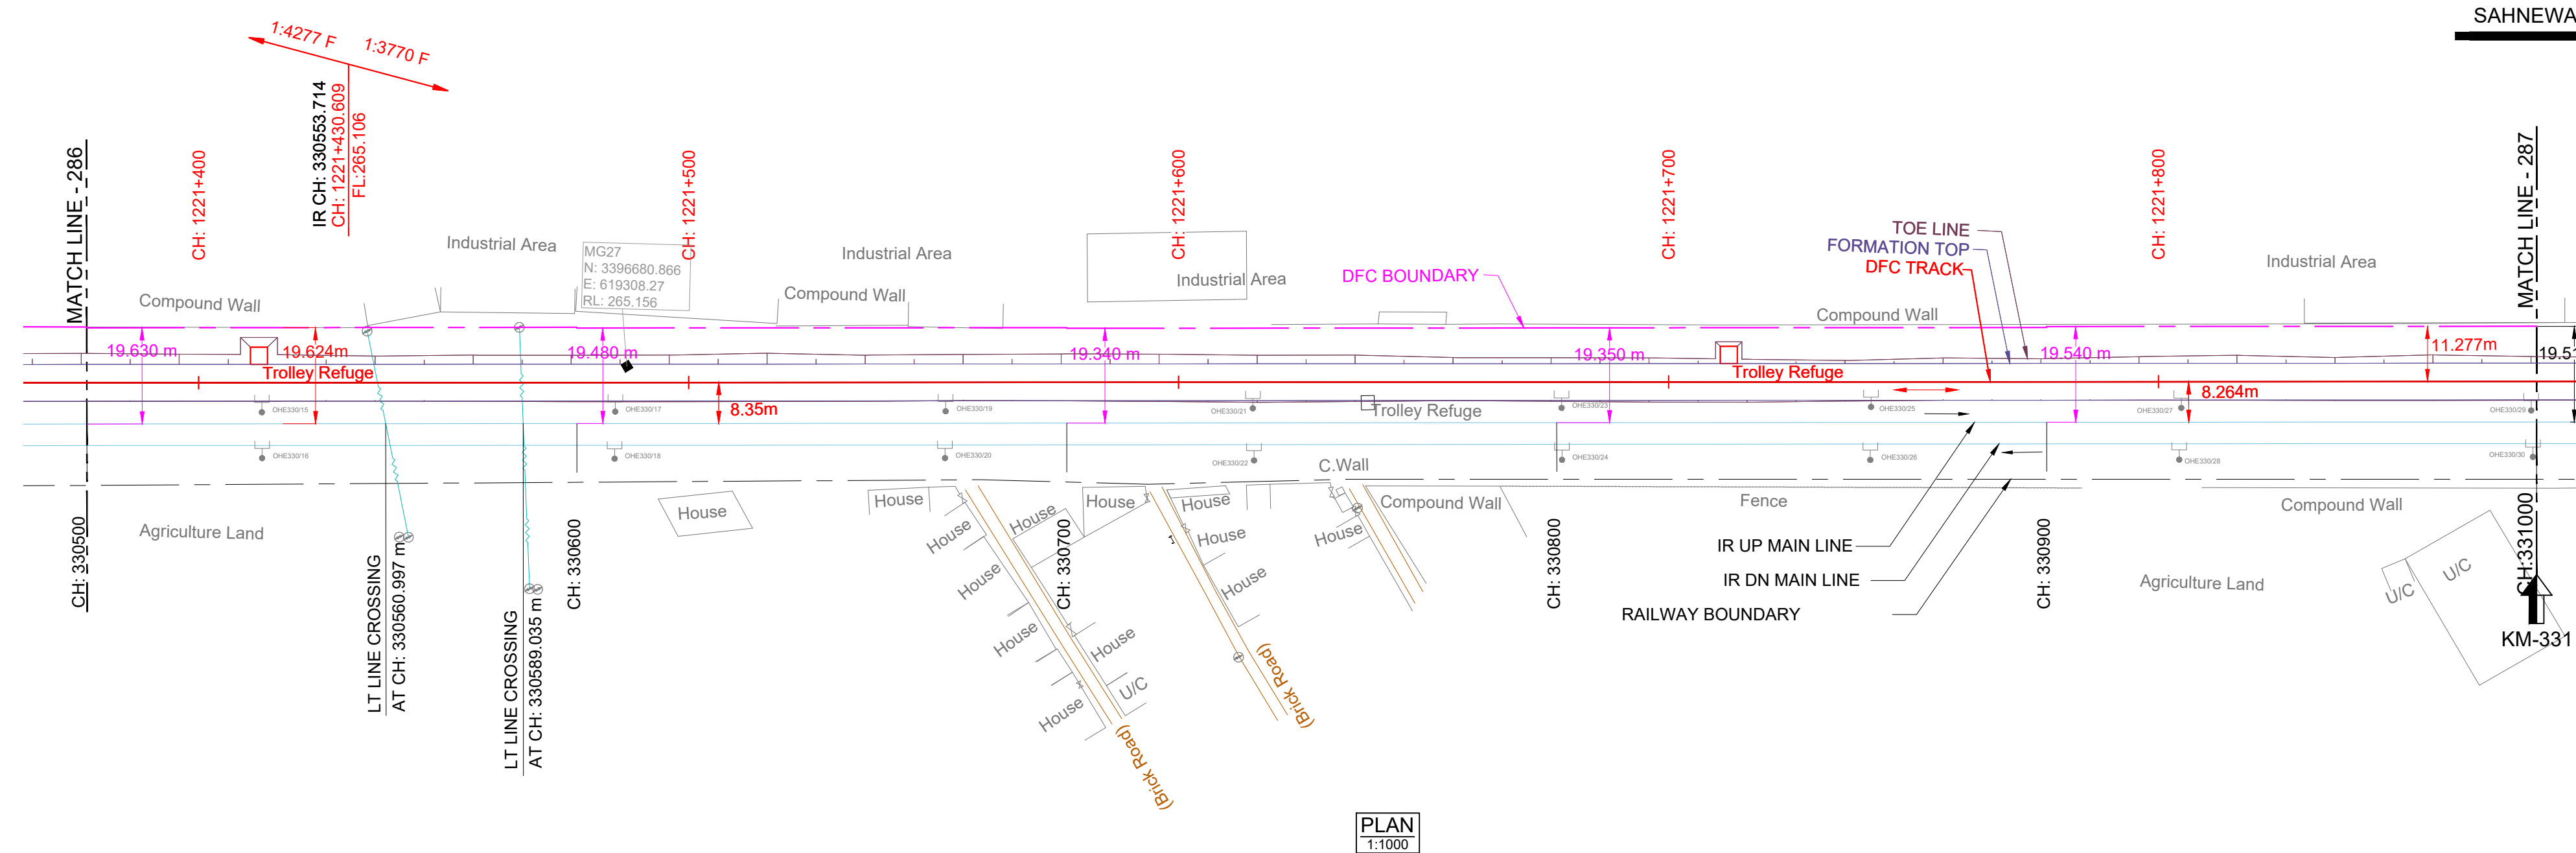

HORIZONTAL ALIGNMENT	L = 5592.259m																										
VERTICAL ALIGNMENT	L=1479.968 m 1 IN 4276.874 F L=20.0 m R=6367.97 m L=1480.269 m 1 IN 3770.373 F																										
TRACK DISTANCE FROM EXISTING NEAREST IR UP MAIN LINE TO DFC MAIN LINE	- 8.406 -	- 8.406 -	- 8.391 -	- 8.377 -	- 8.363 -	- 8.354 -	- 8.349 -	- 8.348 -	- 8.352 -	- 8.340 -	- 8.328 -	- 8.321 -	- 8.314 -	- 8.306 -	- 8.298 -	- 8.292 -	- 8.287 -	- 8.282 -	- 8.278 -	- 8.273 -	- 8.269 -	- 8.265 -	- 8.260 -	- 8.253 -	- 8.247 -	- 8.261 -	
HEIGHT OF BANKING(+) / DEPTH OF CUTTING(-) (PFL-GL)	+0.587 -	+0.587 -	+0.469 -	+0.551 -	+0.491 -	+0.375 -	+0.464 -	+1.151 -	+0.613 -	+0.378 -	+0.534 -	+0.587 -	+0.628 -	+0.641 -	+0.764 -	+0.780 -	+0.763 -	+0.716 -	+0.811 -	+0.978 -	+0.823 -	+0.709 -	+0.603 -	+0.680 -	+0.669 -	+0.527 -	
EXG GROUND LEVEL AT CENTER LINE OF DFC TRACK (GL)	- 264.531 -	- 264.531 -	- 264.644 -	- 264.558 -	- 264.613 -	- 264.724 -	- 264.629 -	- 263.937 -	- 264.470 -	- 264.694 -	- 264.533 -	- 264.474 -	- 264.428 -	- 264.410 -	- 264.282 -	- 264.280 -	- 264.272 -	- 264.314 -	- 264.213 -	- 264.041 -	- 264.191 -	- 264.299 -	- 264.400 -	- 264.318 -	- 264.324 -	- 264.460 -	
EXG GROUND LEVEL AT TOE LOCATION OF DFC TRACK	- 263.897 -	- 263.897 -	- 263.973 -	- 264.020 -	- 264.161 -	- 264.072 -	- 264.085 -	- 264.088 -	- 263.888 -	- 264.001 -	- 263.940 -	- 263.979 -	- 264.075 -	- 264.071 -	- 264.333 -	- 264.343 -	- 264.363 -	- 264.492 -	- 264.602 -	- 264.348 -	- 264.423 -	- 264.211 -	- 264.036 -	- 264.301 -	- 264.048 -	- 264.228 -	
DIFFERENCE BETWEEN DFC FORMATION LEVEL AND EXG.FORMATION LEVEL(PFL-EFL)	0.184 -	0.184 -	0.200 -	0.204 -	0.204 -	0.195 -	0.180 -	0.171 -	0.168 -	0.166 -	0.166 -	0.166 -	0.167 -	0.173 -	0.179 -	0.170 -	0.157 -	0.144 -	0.131 -	0.118 -	0.104 -	0.091 -	0.086 -	0.092 -	0.098 -	0.091 -	
DFC FORMATION LEVEL (PFL)	- 265.118 -	- 265.118 -	- 265.113 -	- 265.109 -	- 265.104 -	- 265.099 -	- 265.093 -	- 265.088 -	- 265.083 -	- 265.072 -	- 265.067 -	- 265.061 -	- 265.056 -	- 265.051 -	- 265.046 -	- 265.040 -	- 265.035 -	- 265.030 -	- 265.024 -	- 265.019 -	- 265.014 -	- 265.008 -	- 265.003 -	- 264.998 -	- 264.993 -	- 264.987 -	
EXG. FORMATION LEVEL OF EXG IR UP MAIN LINE (EFL)	- 264.934 -	- 264.934 -	- 264.913 -	- 264.905 -	- 264.900 -	- 264.903 -	- 264.913 -	- 264.917 -	- 264.915 -	- 264.906 -	- 264.901 -	- 264.896 -	- 264.889 -	- 264.878 -	- 264.866 -	- 264.870 -	- 264.878 -	- 264.886 -	- 264.894 -	- 264.901 -	- 264.909 -	- 264.918 -	- 264.917 -	- 264.906 -	- 264.895 -	- 264.896 -	
DIFFERENCE BETWEEN DFC RAIL LEVEL AND EXG. RAIL LEVEL (PRL - ERL)	0.225 -	0.225 -	0.241 -	0.245 -	0.246 -	0.237 -	0.222 -	0.213 -	0.209 -	0.207 -	0.208 -	0.207 -	0.209 -	0.215 -	0.221 -	0.211 -	0.198 -	0.185 -	0.172 -	0.159 -	0.146 -	0.132 -	0.127 -	0.134 -	0.139 -	0.132 -	
DFC RAIL LEVEL (PRL)	- 265.831 -	- 265.831 -	- 265.826 -	- 265.822 -	- 265.817 -	- 265.812 -	- 265.807 -	- 265.802 -	- 265.796 -	- 265.786 -	- 265.785 -	- 265.775 -	- 265.77 -	- 265.764 -	- 265.759 -	- 265.754 -	- 265.748 -	- 265.743 -	- 265.738 -	- 265.733 -	- 265.727 -	- 265.722 -	- 265.717 -	- 265.711 -	- 265.706 -	- 265.701 -	
EXG.RAIL LEVEL OF NEAREST IR UP MAIN LINE(ERL)	- 265.606 -	- 265.606 -	- 265.585 -	- 265.577 -	- 265.572 -	- 265.575 -	- 265.585 -	- 265.589 -	- 265.597 -	- 265.578 -	- 265.573 -	- 265.568 -	- 265.561 -	- 265.550 -	- 265.538 -	- 265.542 -	- 265.550 -	- 265.558 -	- 265.566 -	- 265.573 -	- 265.581 -	- 265.590 -	- 265.589 -	- 265.578 -	- 265.567 -	- 265.568 -	
EQUIVALENT CHAINEGE ON DFC TRACK	- 1221376.5 -	- 1221376.5 -	- 1221396.5 -	- 1221416.5 -	- 1221436.5 -	- 1221456.5 -	- 1221476.5 -	- 1221496.5 -	- 1221516.5 -	- 1221536.5 -	- 1221556.5 -	- 1221596.5 -	- 1221616.5 -	- 1221636.5 -	- 1221656.5 -	- 1221676.5 -	- 1221696.5 -	- 1221716.5 -	- 1221736.5 -	- 1221756.5 -	- 1221776.5 -	- 1221796.5 -	- 1221816.5 -	- 1221836.5 -	- 1221856.5 -	- 1221876.5 -	
EXISTING IR CHAINAGE	33030500.0 -	33030500.0 -	33030520.0 -	33030540.0 -	33030560.0 -	33030580.0 -	33030600.0 -	33030620.0 -	33030640.0 -	33030660.0 -	33030680.0 -	33030700.0 -	33030720.0 -	33030740.0 -	33030760.0 -	33030780.0 -	33030800.0 -	33030820.0 -	33030840.0 -	33030860.0 -	33030880.0 -	33030900.0 -	33030920.0 -	33030940.0 -	33030960.0 -	33030980.0 -	33031000.0 -

L - SECTION

TR.	
-----	--