
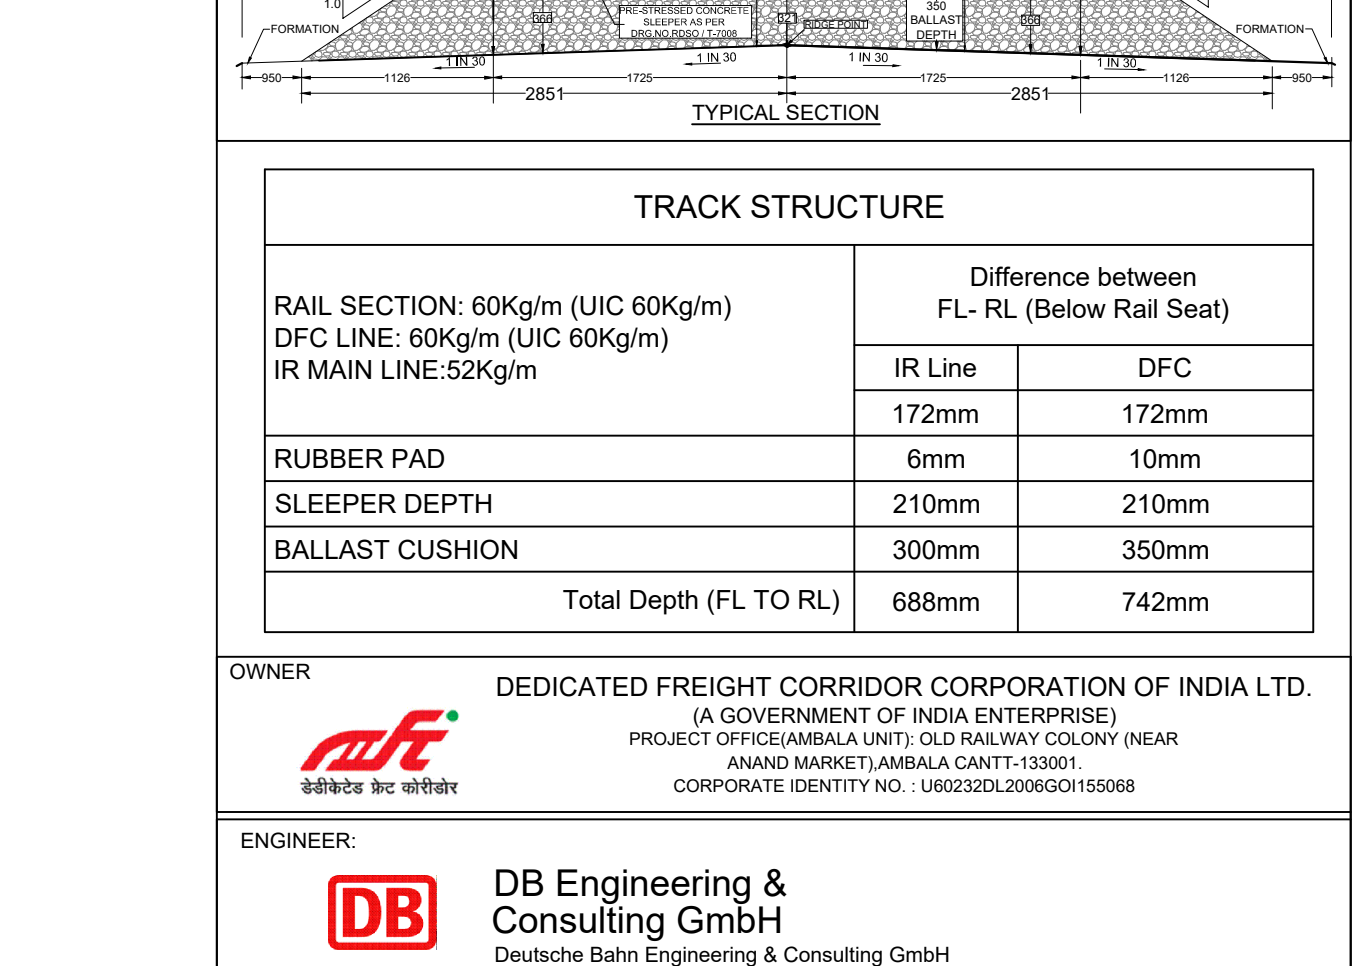


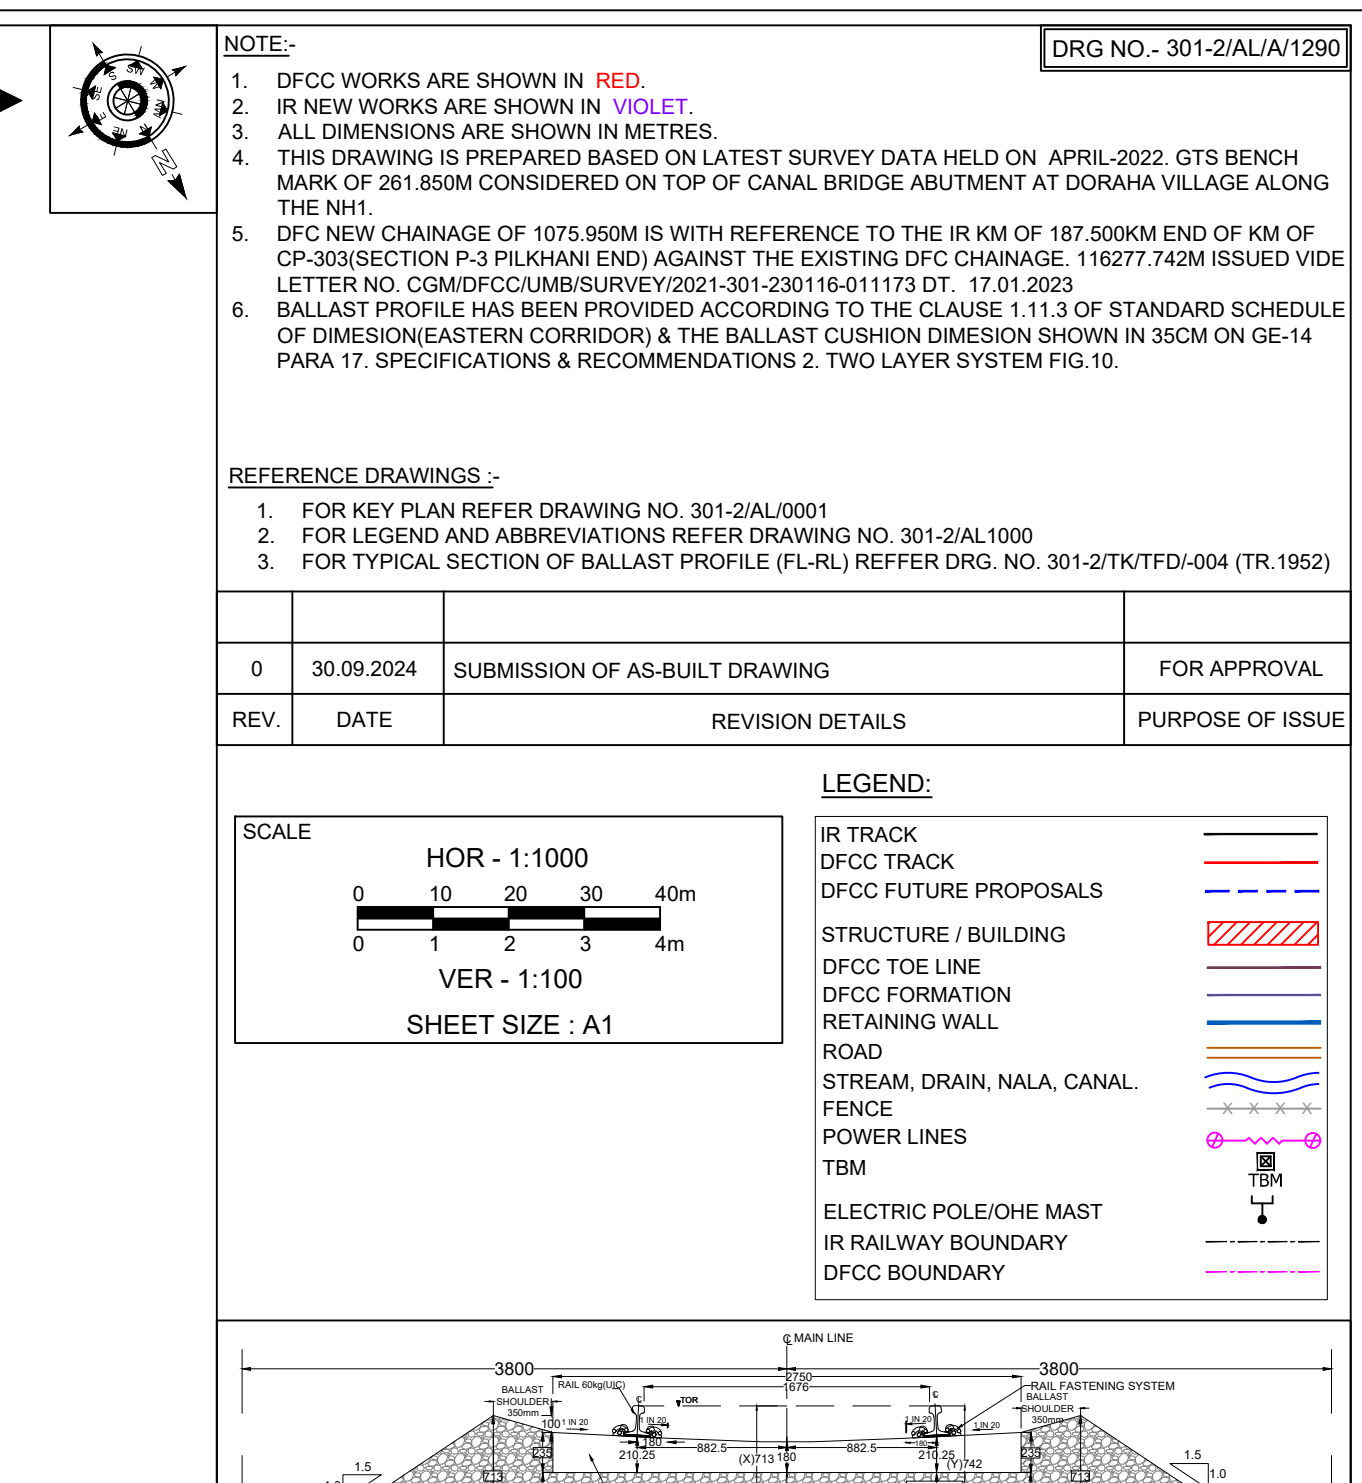

CONTRACTOR:			
GIL - TPL JV			
			
SUBMITTED BY		GIL - TPL JV	
	DATED	NAME	SIGNATURE
PREPARED BY			
CHECKED BY	30.09.2024	VIJAY PRATAP	
APPROVED BY	30.09.2024	PARASURAM KOTYADA	
APPROVED BY		DEUTSCHE BAHN ENGINEERING & CONSULTING GMBH	
	DATED	NAME	SIGNATURE
Sr. DE./CHIEF ENGINEER		SURESH K.YALANGI	
CHIEF TRACK ENGINEER		RAJ PAL SINGH	
T.L.		H.D. VIDJAK	
STAMP	A AS-BUILT DRAWING TR. Ref..... ENGINEER Sign.:		
EMPLOYER (DFCCIL):		DEDICATED FREIGHT CORRIDOR CORPORATION OF INDIA LTD.	
AS BUILT DRAWING			
TITLE		DFCC APPR. NO. -	
AS-BUILT PLAN AND PROFILE		ENGG. APPR. NO. -	
PROJECT NAME: 000 000 000 000 000		DPS. NO. 201 2(A) /A/1200	

TITLE AS-BUILT PLAN AND PROFILE FROM IR KM: 332.000 TO 332.500 FROM DFC KM:1222.840 TO 1223.341	DFCC APPR. NO. -	
	ENGG. APPR. NO. -	
	DRG. NO. -301-2/AL/A/1290	
	SHEET NO.: 1 OF 1	STATUS A
DATE : 30.09.2014		

TR