
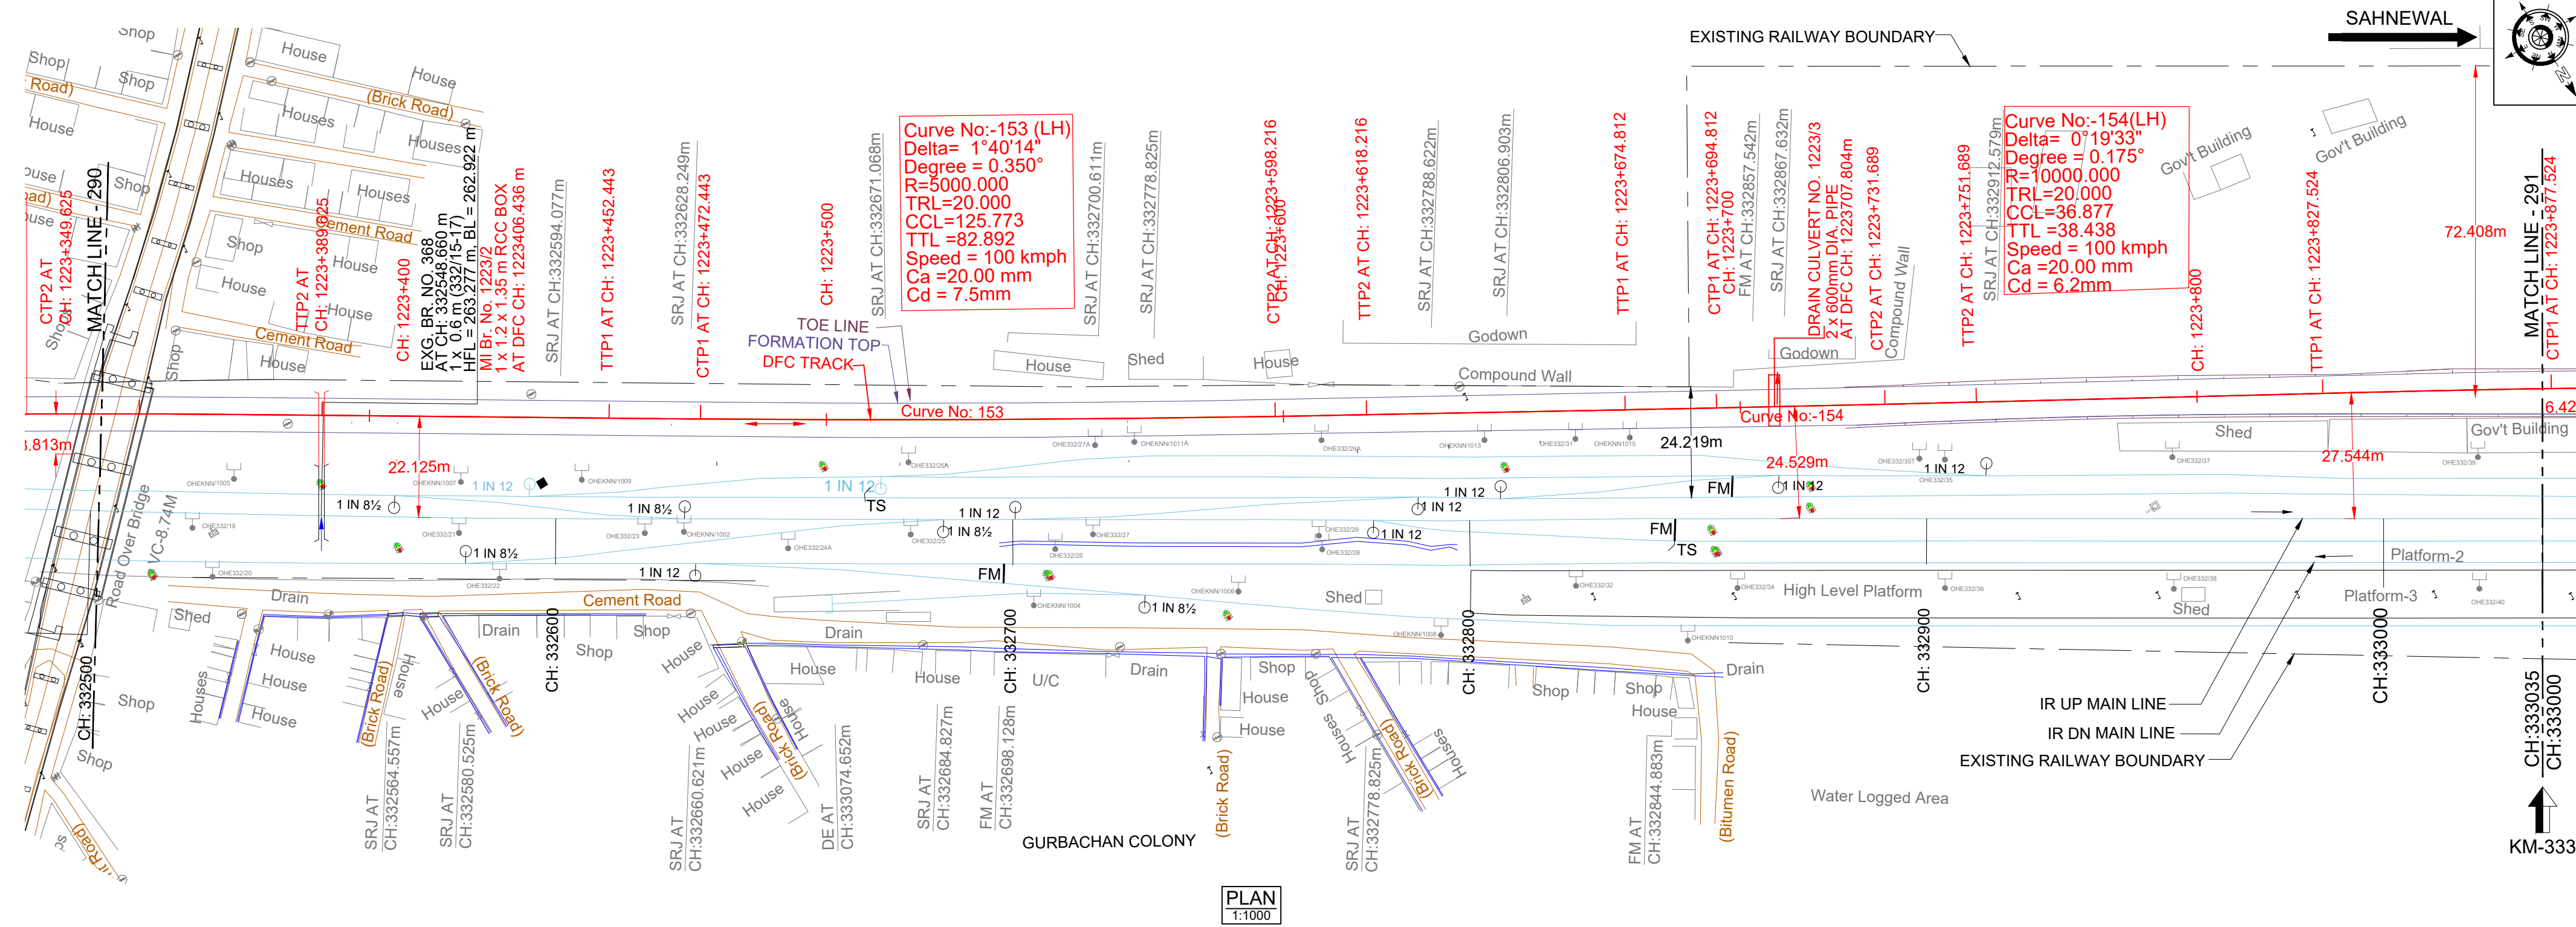


HORIZONTAL ALIGNMENT	LS = 40 L = 62.819 m TL= 20m R = -5000 TL= 20m L = 56.596 m LS = 20 R = -10000 LS = 20 L = 75.835 m TL= 50m																											
VERTICAL ALIGNMENT	L = 716.792 m G = 1 IN 3822.527 F																											
TRACK DISTANCE FROM EXISTING NEAREST IR UP MAIN LINE TO DFC MAIN LINE	-21.228	-21.638	-21.898	-22.061	-22.161	-22.102	-21.965	-21.815	-21.804	-21.863	-21.913	-22.101	-22.346	-22.668	-23.185	-23.607	-23.760	-23.912	-24.385	-24.774	-25.281	-25.781	-26.261	-26.748	-27.262	-27.765	-28.203	-28.461
HEIGHT OF BANKING(+) / DEPTH OF CUTTING(-) (PFL-GL)	-0.899	-1.292	-0.652	0.406	0.399	-0.471	-0.388	-0.175	-0.284	-0.320	-0.425	-0.640	-0.555	-0.601	-0.483	-0.450	-0.415	-0.414	-0.482	-0.263	-0.240	-0.417	-0.514	-0.670	-1.744	-0.812	-0.828	-1.608
EXG GROUND LEVEL AT CENTER LINE OF DFC TRACK (GL)	-265.230	-265.618	-264.972	-263.911	-264.378	-264.776	-264.686	-264.469	-264.573	-264.604	-264.704	-264.889	-264.913	-264.823	-264.864	-264.741	-264.702	-264.662	-264.656	-264.654	-264.719	-264.494	-264.466	-264.638	-264.730	-264.881	-264.619	-264.654
EXG GROUND LEVEL AT TOE LOCATION OF DFC TRACK	-265.200	-265.574	-264.970	-263.738	-264.300	-264.781	-264.692	-264.537	-264.573	-264.689	-264.682	-264.886	-264.814	-264.866	-264.974	-264.827	-264.677	-264.643	-264.640	-264.654	-264.476	-264.448	-264.559	-264.566	-264.619	-264.632	-264.646	-264.672
DIFFERENCE BETWEEN DFC FORMATION LEVEL AND EXG.FORMATION LEVEL.(PFL-EFL)	-0.044	-0.033	-0.020	-0.014	-0.018	-0.039	-0.006	0.023	0.024	0.061	0.047	0.112	0.120	0.124	0.150	0.171	0.164	0.159	0.174	0.133	0.125	0.051	0.053	0.051	0.041	0.046	0.059	0.079
DFC FORMATION LEVEL (PFL) AT CENTER LINE	-264.331	-264.326	-264.320	-264.315	-264.310	-264.305	-264.300	-264.294	-264.289	-264.284	-264.279	-264.273	-264.268	-264.263	-264.258	-264.252	-264.247	-264.242	-264.237	-264.231	-264.226	-264.221	-264.216	-264.211	-264.205	-264.200	-264.195	-264.191
EXG. FORMATION LEVEL OF EXG IR UP MAIN LINE (EFL)	-264.375	-264.359	-264.340	-264.329	-264.328	-264.344	-264.306	-264.271	-264.285	-264.223	-264.232	-264.181	-264.148	-264.139	-264.108	-264.081	-264.083	-264.083	-264.063	-264.098	-264.101	-264.170	-264.163	-264.180	-264.164	-264.154	-264.136	-264.112
DIFFERENCE BETWEEN DFC RAIL LEVEL AND EXG. RAIL LEVEL (PRL - ERL)	0.055	0.066	0.080	0.085	0.081	0.059	0.083	0.122	0.123	0.180	0.146	0.211	0.219	0.223	0.248	0.271	0.263	0.258	0.273	0.233	0.225	0.150	0.152	0.150	0.140	0.145	0.158	0.178
DFC RAIL LEVEL (PRL) AT INNER RAIL TOP	-265.102	-265.097	-265.091	-265.086	-265.081	-265.076	-265.071	-265.065	-265.060	-265.055	-265.050	-265.044	-265.039	-265.034	-265.029	-265.024	-265.018	-265.013	-265.008	-265.003	-264.997	-264.992	-264.987	-264.982	-264.976	-264.971	-264.966	-264.962
EXG.RAIL LEVEL OF NEAREST IR UP MAIN LINE(ERL)	-265.047	-265.031	-265.012	-265.001	-265.000	-265.016	-264.978	-264.943	-264.937	-264.895	-264.904	-264.833	-264.820	-264.811	-264.780	-264.753	-264.755	-264.755	-264.735	-264.770	-264.773	-264.842	-264.835	-264.832	-264.826	-264.826	-264.808	-264.784
EQUIVALENT CHAINAGE ON DFC TRACK	-1223340.7	-1223360.6	-1223380.6	-1223400.5	-1223420.5	-1223440.3	-1223460.1	-1223480.2	-1223500.2	-1223520.2	-1223540.1	-1223560.2	-1223580.3	-1223600.3	-1223620.3	-1223639.9	-1223659.9	-1223679.9	-1223690.1	-1223720.2	-1223740.2	-1223760.2	-1223780.2	-1223800.2	-1223820.2	-1223840.2	-1223860.2	-1223875.0
EXISTING IR CHAINAGE	332500.0	332520.0	332540.0	332560.0	332580.0	332600.0	332620.0	332640.0	332660.0	332680.0	332700.0	332720.0	332740.0	332760.0	332780.0	332800.0	332820.0	332840.0	332860.0	332880.0	332900.0	332920.0	332940.0	332960.0	332980.0	333000.0	333020.0	333034.8

L - SECTION

SAHNEWAL →

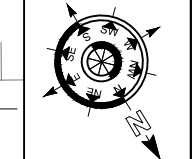



- | | |
|---|--------------------------|
| NOTE:- | DRG NO. - 301-2/ALA/1291 |
| <p>1. DFCW WORKS ARE SHOWN IN RED.</p> <p>2. IR NEW WORKS ARE SHOWN IN VIOLET.</p> <p>3. ALL DIMENSIONS ARE SHOWN IN METRES.</p> <p>4. THIS DRAWING IS PREPARED BASED ON LATEST SURVEY DATA HELD ON APRIL 2022. GTS BENCH MARK OF 261.850M CONSIDERED ON TOP OF CANAL BRIDGE ABUTMENT AT DARHANA VILLAGE ALONG THE NH1.</p> <p>5. DFCW CHAINAGE OF 1702.950M IS WITH REFERENCE TO THE IR KM OF 187.500KM END OF KM OF CP-303(SECTION 3-PILKHANI END) AGAINST THE EXISTING DFCW CHAINAGE. 116277.742M ISSUED VIDE LETTER NO. CGM/DDC/UDM/SURVEY/2021-301-230116-011173 DT. 17.01.2023</p> <p>6. BALLAST PROFILE HAS BEEN PROVIDED ACCORDING TO THE CLAUSE 1.11.3 OF STANDARD SCHEDULE OF DIMENSIONS OF PAVEMENTS AND THE BALLAST CUSHION DIMENSION SHOWN IN SSCM ON CE-14 PARA 17. SPECIFICATIONS & RECOMMENDATIONS 2. TWO LAYER SYSTEM FIG. 10.</p> | |

REFERENCE DRAWINGS :-

1. FOR KEY PLAN REFER DRAWING NO. 301-2/AL/0001
2. FOR LEGEND AND ABBREVIATIONS REFER DRAWING NO. 301-2/AL/1000
3. FOR TYPICAL SECTION OF BALLAST PROFILE (FL-RL) REFER DRG. NO. 301-2/TK/TFD/004 (TR.1952)

0	30.09.2024	SUBMISSION OF AS-BUILT DRAWING	FOR APPROVAL
REV.	DATE	REVISION DETAILS	PURPOSE OF ISSUE

LEGEND:

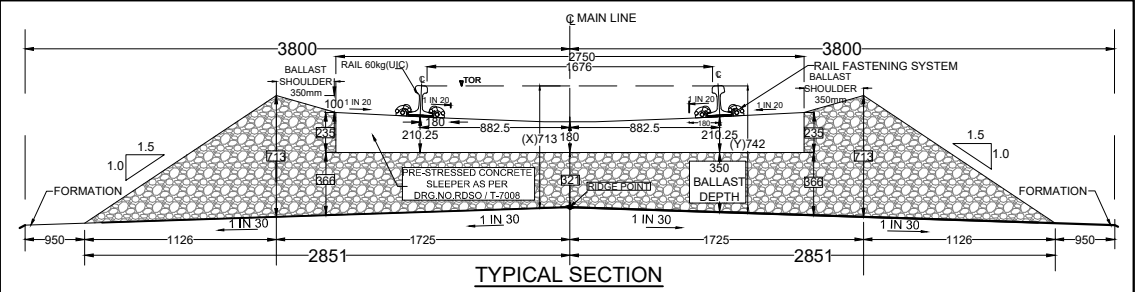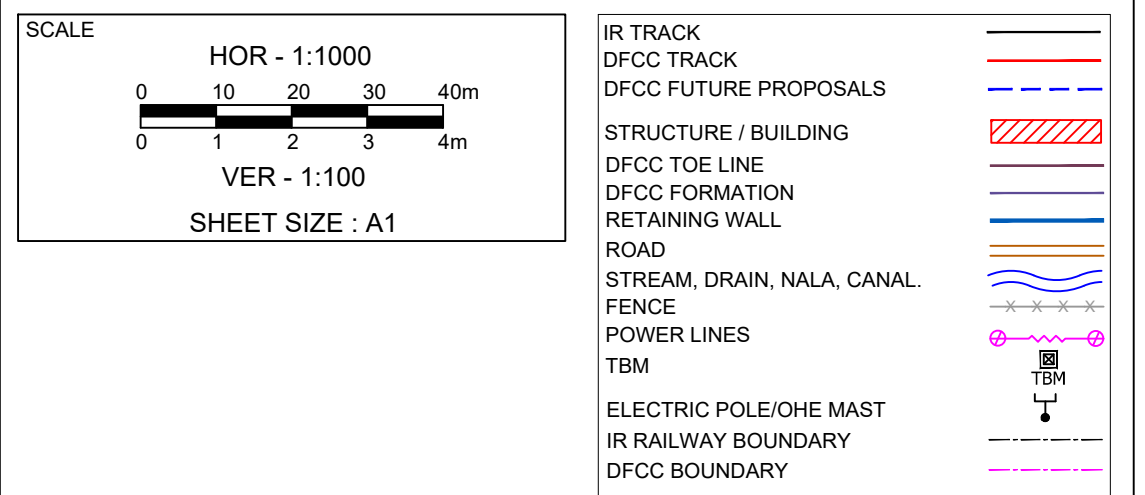

TRACK STRUCTURE		
RAIL SECTION: 60Kg/m (UIC 60Kg/m) DFC LINE: 60Kg/m (UIC 60Kg/m) IR MAIN LINE: 52Kg/m	Difference between FL- RL (Below Rail Seat)	
	IR Line	DFC
	172mm	172mm
RUBBER PAD	6mm	10mm
SLEEPER DEPTH	210mm	210mm
BALLAST CUSHION	300mm	350mm
Total Depth (FL TO RL)	688mm	742mm

OWNER DEDICATED FREIGHT CORRIDOR CORPORATION OF INDIA LTD.
(A GOVERNMENT OF INDIA ENTERPRISE)



DEDICATED FREIGHT CORRIDOR CORPORATION OF INDIA LTD.
(A GOVERNMENT OF INDIA ENTERPRISE)
PROJECT OFFICE/AMBALA UNIT: OLD RAILWAY COLONY (NEAR
ANAND MARKET),AMBALA CANTT-133001,
CORPORATE IDENTITY NO. : U60232DL2006GOI155068

ENGINEER



DB Engineering &
Consulting GmbH
Deutsche Bahn Engineering & Consulting GmbH

GIL - TPL JV



SUBMITTED BY		GIL - TPL JV	
	DATED	NAME	SIGNATURE
PREPARED BY			
CHECKED BY	30.09.2024	VIJAY PRATAP	
APPROVED BY	30.09.2024	PARASURAM KOTYADA	
APPROVED BY	DEUTSCHE BAHN ENGINEERING & CONSULTING GMBH		
	DATED	NAME	SIGNATURE
Sr. DE./CHIEF ENGINEER		SURESH K.YALANGI	
CHIEF TRACK ENGINEER		RAJ PAL SINGH	
T.L.		H.D. VIDJAK	

STAMP



EMPLOYER (DFCCIL):	DEDICATED FREIGHT CORRIDOR CORPORATION OF INDIA LTD.
--------------------	--

--	--	--	--

AS BUILT DRAWING

TITLE AS-BUILT PLAN AND PROFILE FROM IR KM: 332.500 TO 333.000 FROM DFC KM: 1223.341 TO 1223.875	DFCC APPR. NO. -	
	ENGG. APPR. NO. -	
	DRG. NO. -301-2/AL/A/1291	
	SHEET NO. : 1 OF 1	STATUS
DATE : 30.09.2024		A

TR.
