
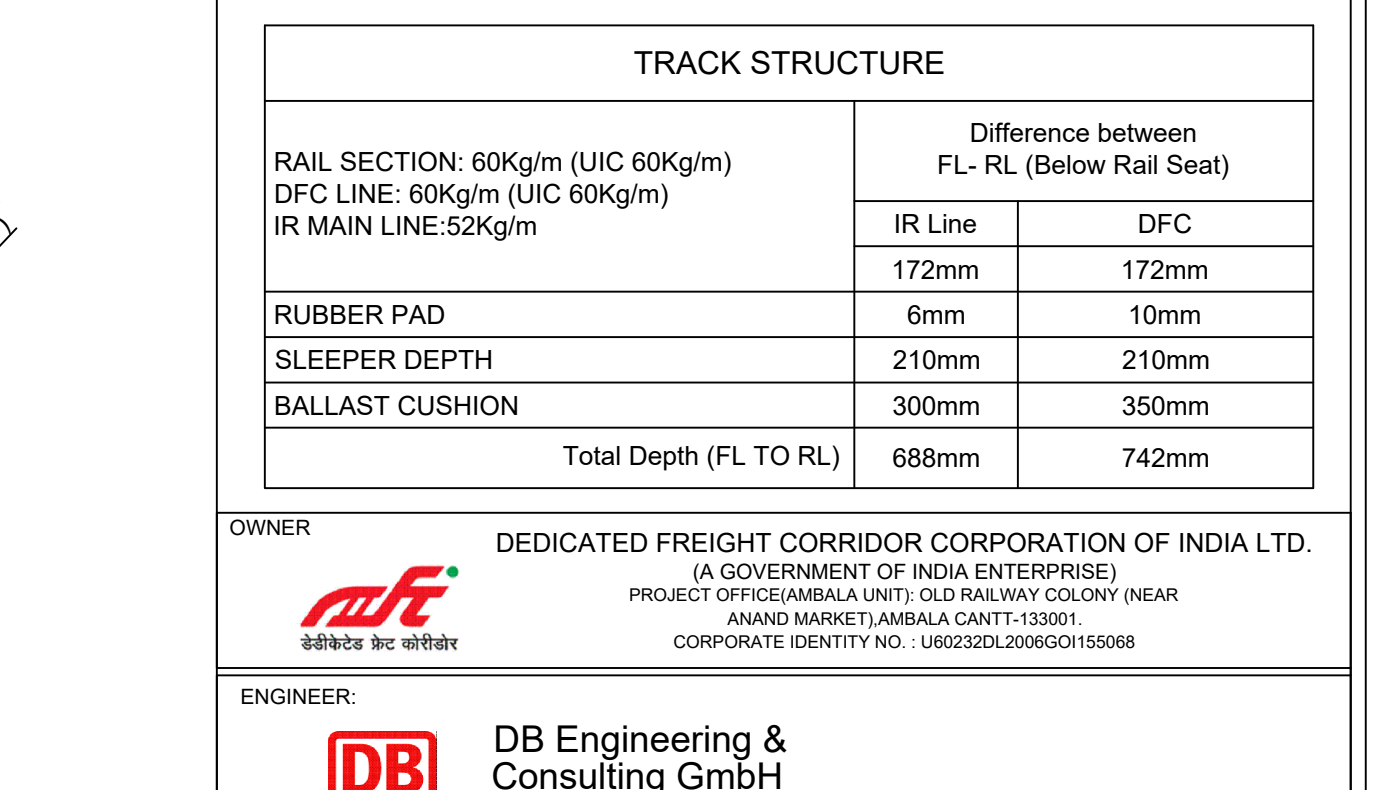


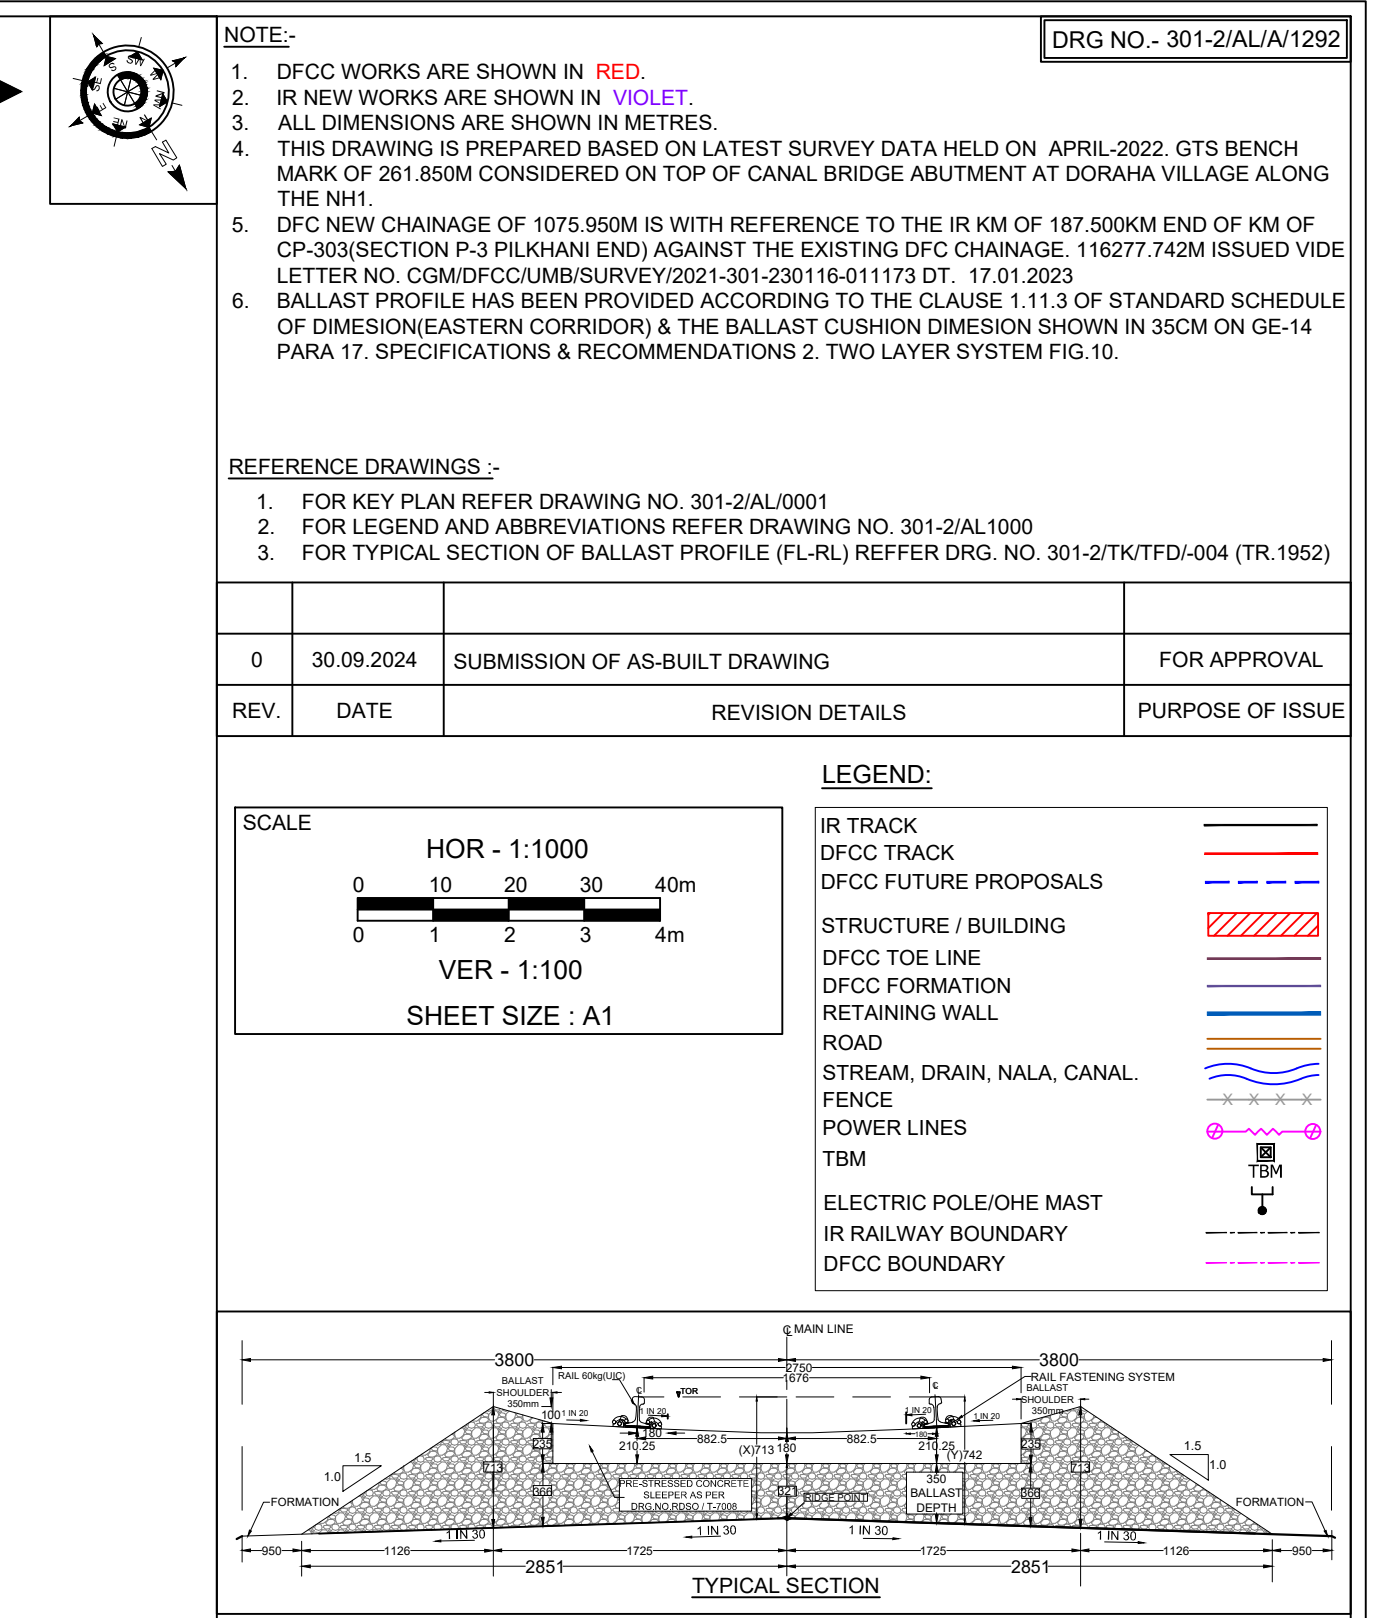

 			
SUBMITTED BY		GIL - TPL JV	
	DATED	NAME	SIGNATURE
PREPARED BY			
CHECKED BY	30.09.2024	VIJAY PRATAP	
APPROVED BY	30.09.2024	PARASURAM KOTYADA	
APPROVED BY		DEUTSCHE BAHN ENGINEERING & CONSULTING GMBH	
	DATED	NAME	SIGNATURE
Sr. DE./CHIEF ENGINEER		SURESH K.YALANGI	
CHIEF TRACK ENGINEER		RAJ PAL SINGH	
T.L.		H.D. VIDJAK	
STAMP  AS-BUILT DRAWING TR. Ref..... ENGINEER Sign.:			
EMPLOYER (DFCCIL):		DEDICATED FREIGHT CORRIDOR CORPORATION OF INDIA LTD.	
AS BUILT DRAWING			
TITLE		DFCC APPR. NO. -	
AS-BUILT PLAN AND PROFILE		ENGG. APPR. NO. -	
FROM IR KM: 333.000 TO 333.500		DRG. NO. -301-2/AL/A/1292	
FROM DFC KM: 1223.875 TO 1224.375		SHEET NO. : 1 OF 1	
		DATE : 30.09.2024	
		STATUS A	