
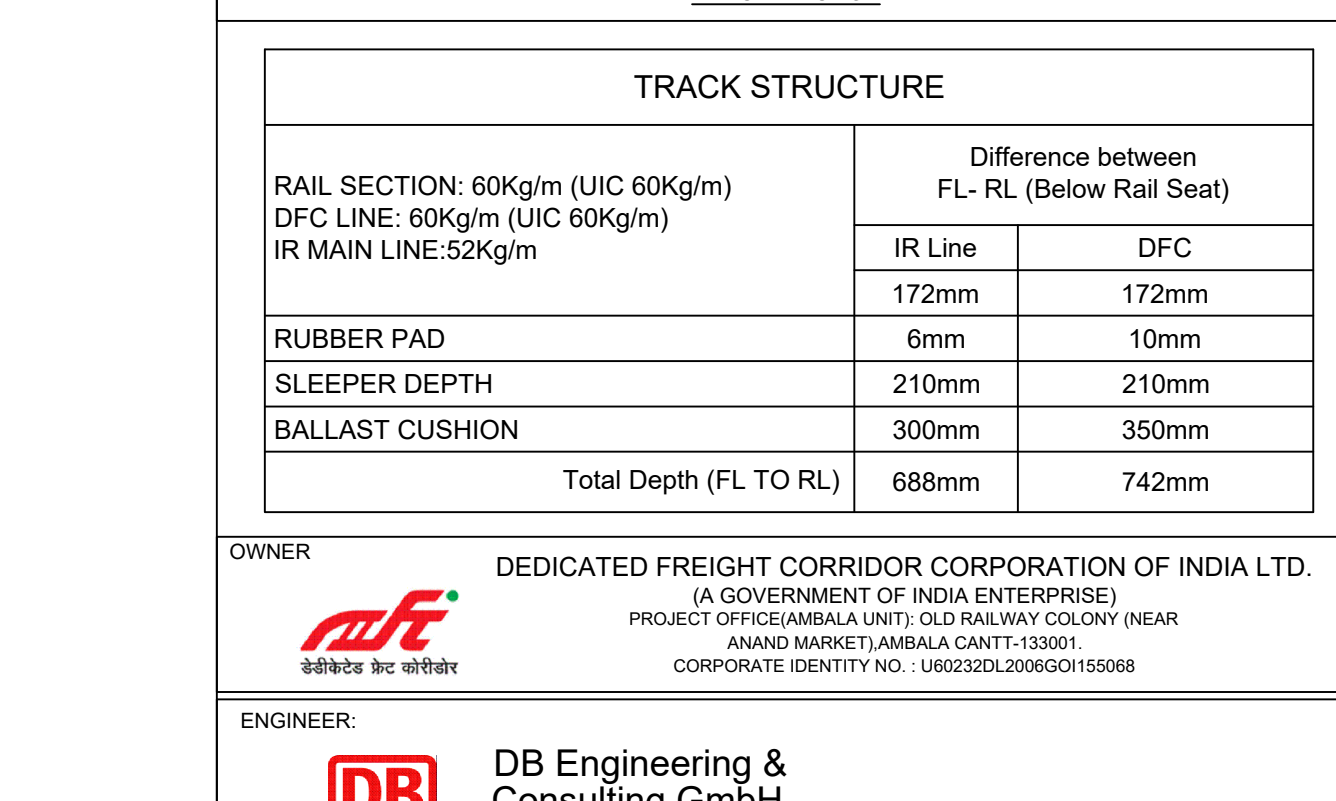


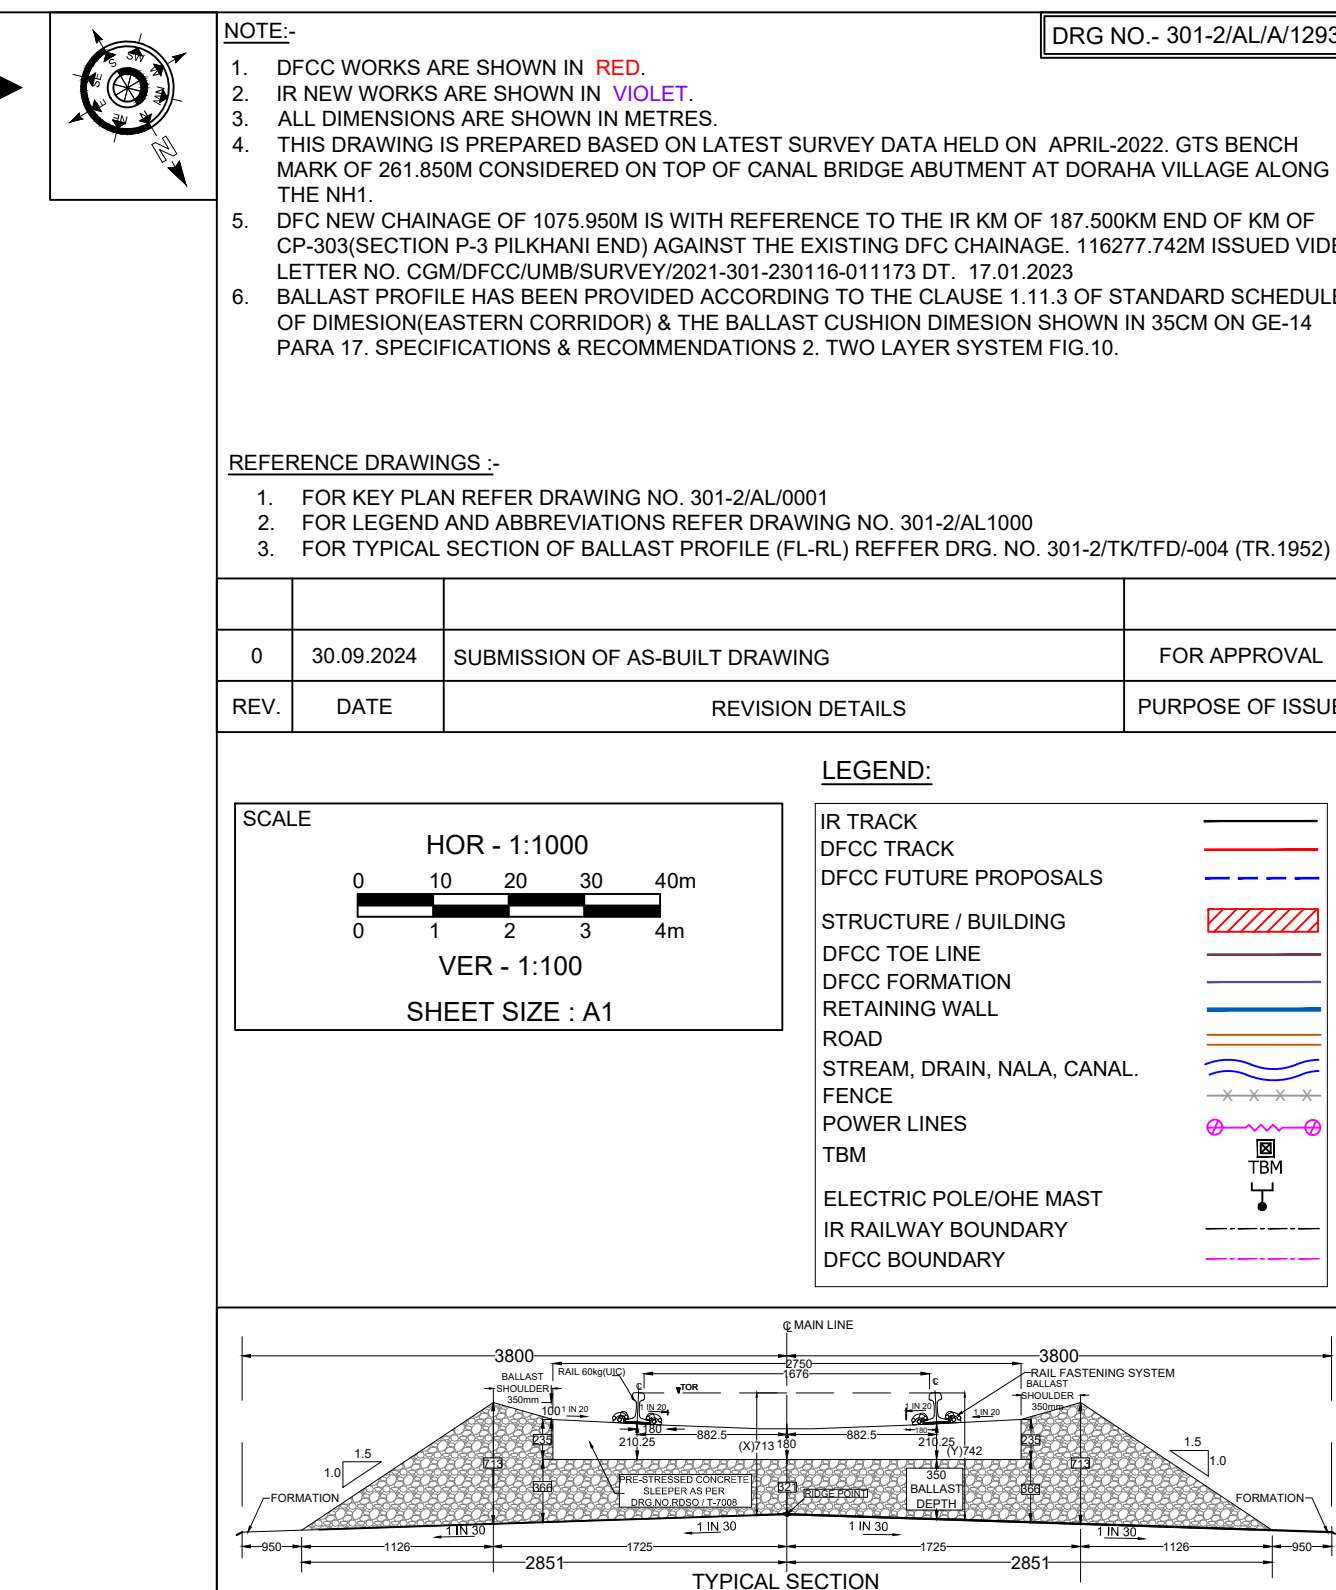

 		Deutsche Bahn Engineering & Consulting GmbH	
GIL - TPL JV			
 			
SUBMITTED BY	GIL - TPL JV		
	DATED	NAME	SIGNATURE
PREPARED BY			
CHECKED BY	30.09.2024	VIJAY PRATAP	
APPROVED BY	30.09.2024	PARASURAM KOTYADA	
APPROVED BY	DEUTSCHE BAHN ENGINEERING & CONSULTING GMBH		
	DATED	NAME	SIGNATURE
Sr. DE./CHIEF ENGINEER		SURESH K.YALANGI	
CHIEF TRACK ENGINEER		RAJ PAL SINGH	
T.L.		H.D. VIDJAK	
STAMP	A AS-BUILT DRAWING TR. Ref..... ENGINEER Sign.:		
EMPLOYER (DFCCIL):	DEDICATED FREIGHT CORRIDOR CORPORATION OF INDIA LTD.		
AS BUILT DRAWING			
TITLE		DFCC APPR. NO. -	
AS-BUILT PLAN AND PROFILE		ENGG. APPR. NO. -	

FROM IR KM: 333.500 TO 334.000 FROM DFC KM: 1224.375 to 1224.875	DRG. NO.: 301-2/AL/A/1293	STATUS A
	SHEET NO.: 1 OF 1 DATE: 30.09.2024	