




L - SECTION

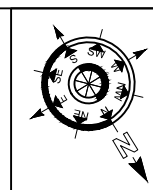


- DRG NO.- 301-2/AL/A/1294

- REFERENCE DRAWINGS :-

0	30.09.2024	SUBMISSION OF AS-BUILT DRAWING	FOR APPROVAL
REV.	DATE	REVISION DETAILS	PURPOSE OF ISSUE

SCALE	LEGEND
HOR - 1:1000 VER - 1:100 SHEET SIZE : A1	IR TRACK DFCC TRACK DFCC FUTURE PROPOSALS STRUCTURE / BUILDING DFCC TOE LINE DFCC FORMATION RETAINING WALL ROAD STREAM, DRAIN, NALA, CANAL, FENCE POWER LINES TBM ELECTRIC POLE/OHE MAST IR RAILWAY BOUNDARY DFCC BOUNDARY

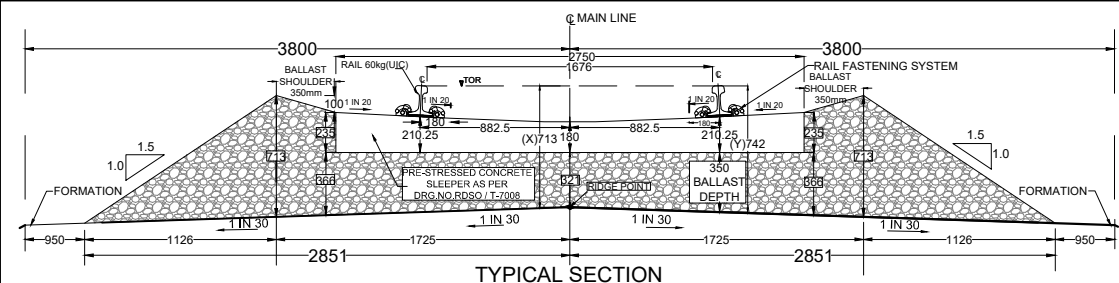

TRACK STRUCTURE		
RAIL SECTION: 60Kg/m (UIC 60Kg/m) DFC LINE: 60kg/m (UIC 60kg/m) IR MAIN LINE: 52Kg/m	Difference between FL- RL (Below Rail Seat)	
	IR Line	DFC
	172mm	172mm
RUBBER PAD	6mm	10mm
SLEEPER DEPTH	210mm	210mm
BALLAST CUSHION	300mm	350mm
Total Depth (FL TO RL)	688mm	742mm

OWNER



DEDICATED FREIGHT CORRIDOR CORPORATION OF INDIA LTD.
(A GOVERNMENT OF INDIA ENTERPRISE)
PROJECT OFFICE/AMBALA UNIT: OLD RAILWAY COLONY (NEAR
ANAND MARKET), AMBALA. CANTT-133001.
CORPORATE IDENTITY NO. : U60232DL2006060155068

ENGINEER:

 DB Engineering & Consulting GmbH
Deutsche Bahn Engineering & Consulting GmbH

CONTRACTOR: GIL - TPL JV

SUBMITTED BY	GIL - TPL JV		
	DATED	NAME	SIGNATURE
PREPARED BY			
CHECKED BY	30.09.2024	VIJAY PRATAP	
APPROVED BY	30.09.2024	PARASURAM KOTYADA	

APPROVED BY	DEUTSCHE BAHN ENGINEERING & CONSULTING GMBH		
	DATED	NAME	SIGNATURE
Sr. DE./CHIEF ENGINEER		SURESH K.YALANGI	
CHIEF TRACK ENGINEER		RAJ PAL SINGH	
T.L.		H.D. VIDJAK	

STAMP	A AS-BUILT DRAWING TR. Ref..... ENGINEER Sign.:		
EMPLOYER (DFCCIL):	DEDICATED FREIGHT CORRIDOR CORPORATION OF INDIA LTD		

AS BUILT DRAWING		
TITLE AS-BUILT PLAN AND PROFILE FROM IR KM: 334.000 TO 334.500 FROM DFC KM: 1224.875 TO 1225.375		DFCC APPR. NO. - ENGG. APPR. NO. - DRG. NO. - 301-2/AL/A/1294 SHEET NO. : 1 OF 1 DATE : 30.09.2024
		A

TR.