




DEDICATED FREIGHT CORRIDOR CORPORATION OF INDIA LTD.
(A GOVERNMENT OF INDIA ENTERPRISE)

EASTERN DEDICATED FREIGHT CORRIDOR
SAHNEWAL TO PILKHANI SECTION
CONTRACT PACKAGE - 301

PLAN & PROFILE OF AS BUILT DRAWINGS FOR DFC MAIN LINE

IR CHAINAGE FROM 334.500 KM TO 341.000 KM
DFCC CHAINAGE FROM KM 1225.375 TO KM 1231.877

DESIGN CONSULTANT

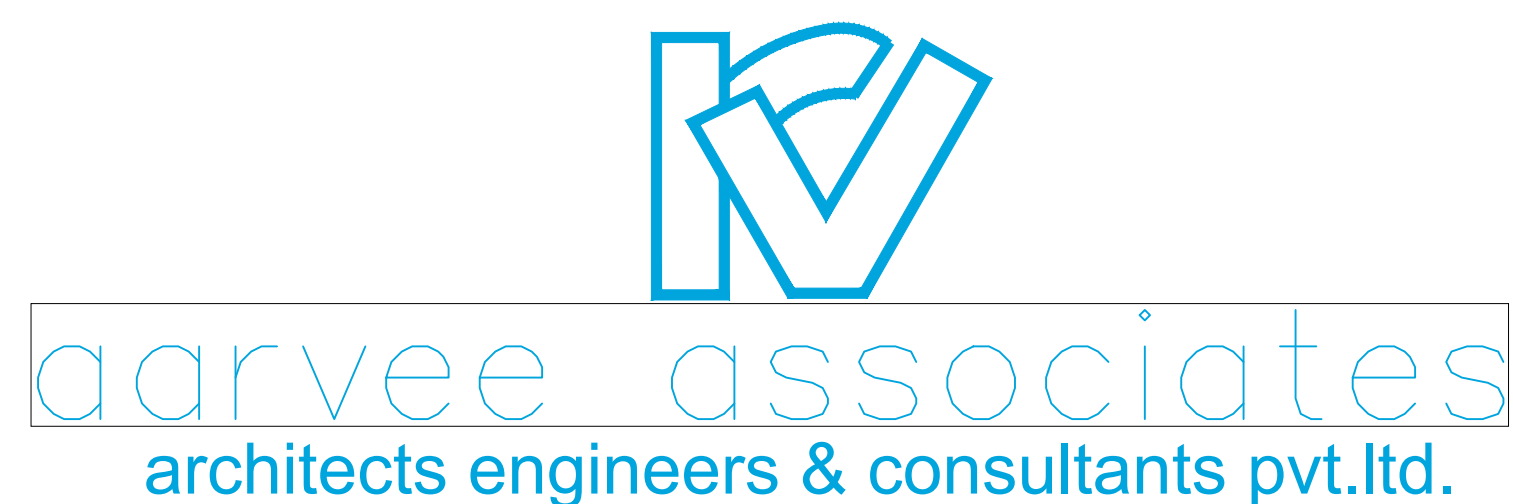


ENGINEER



CONTRACTOR CLIENT
GIL - TPL JV

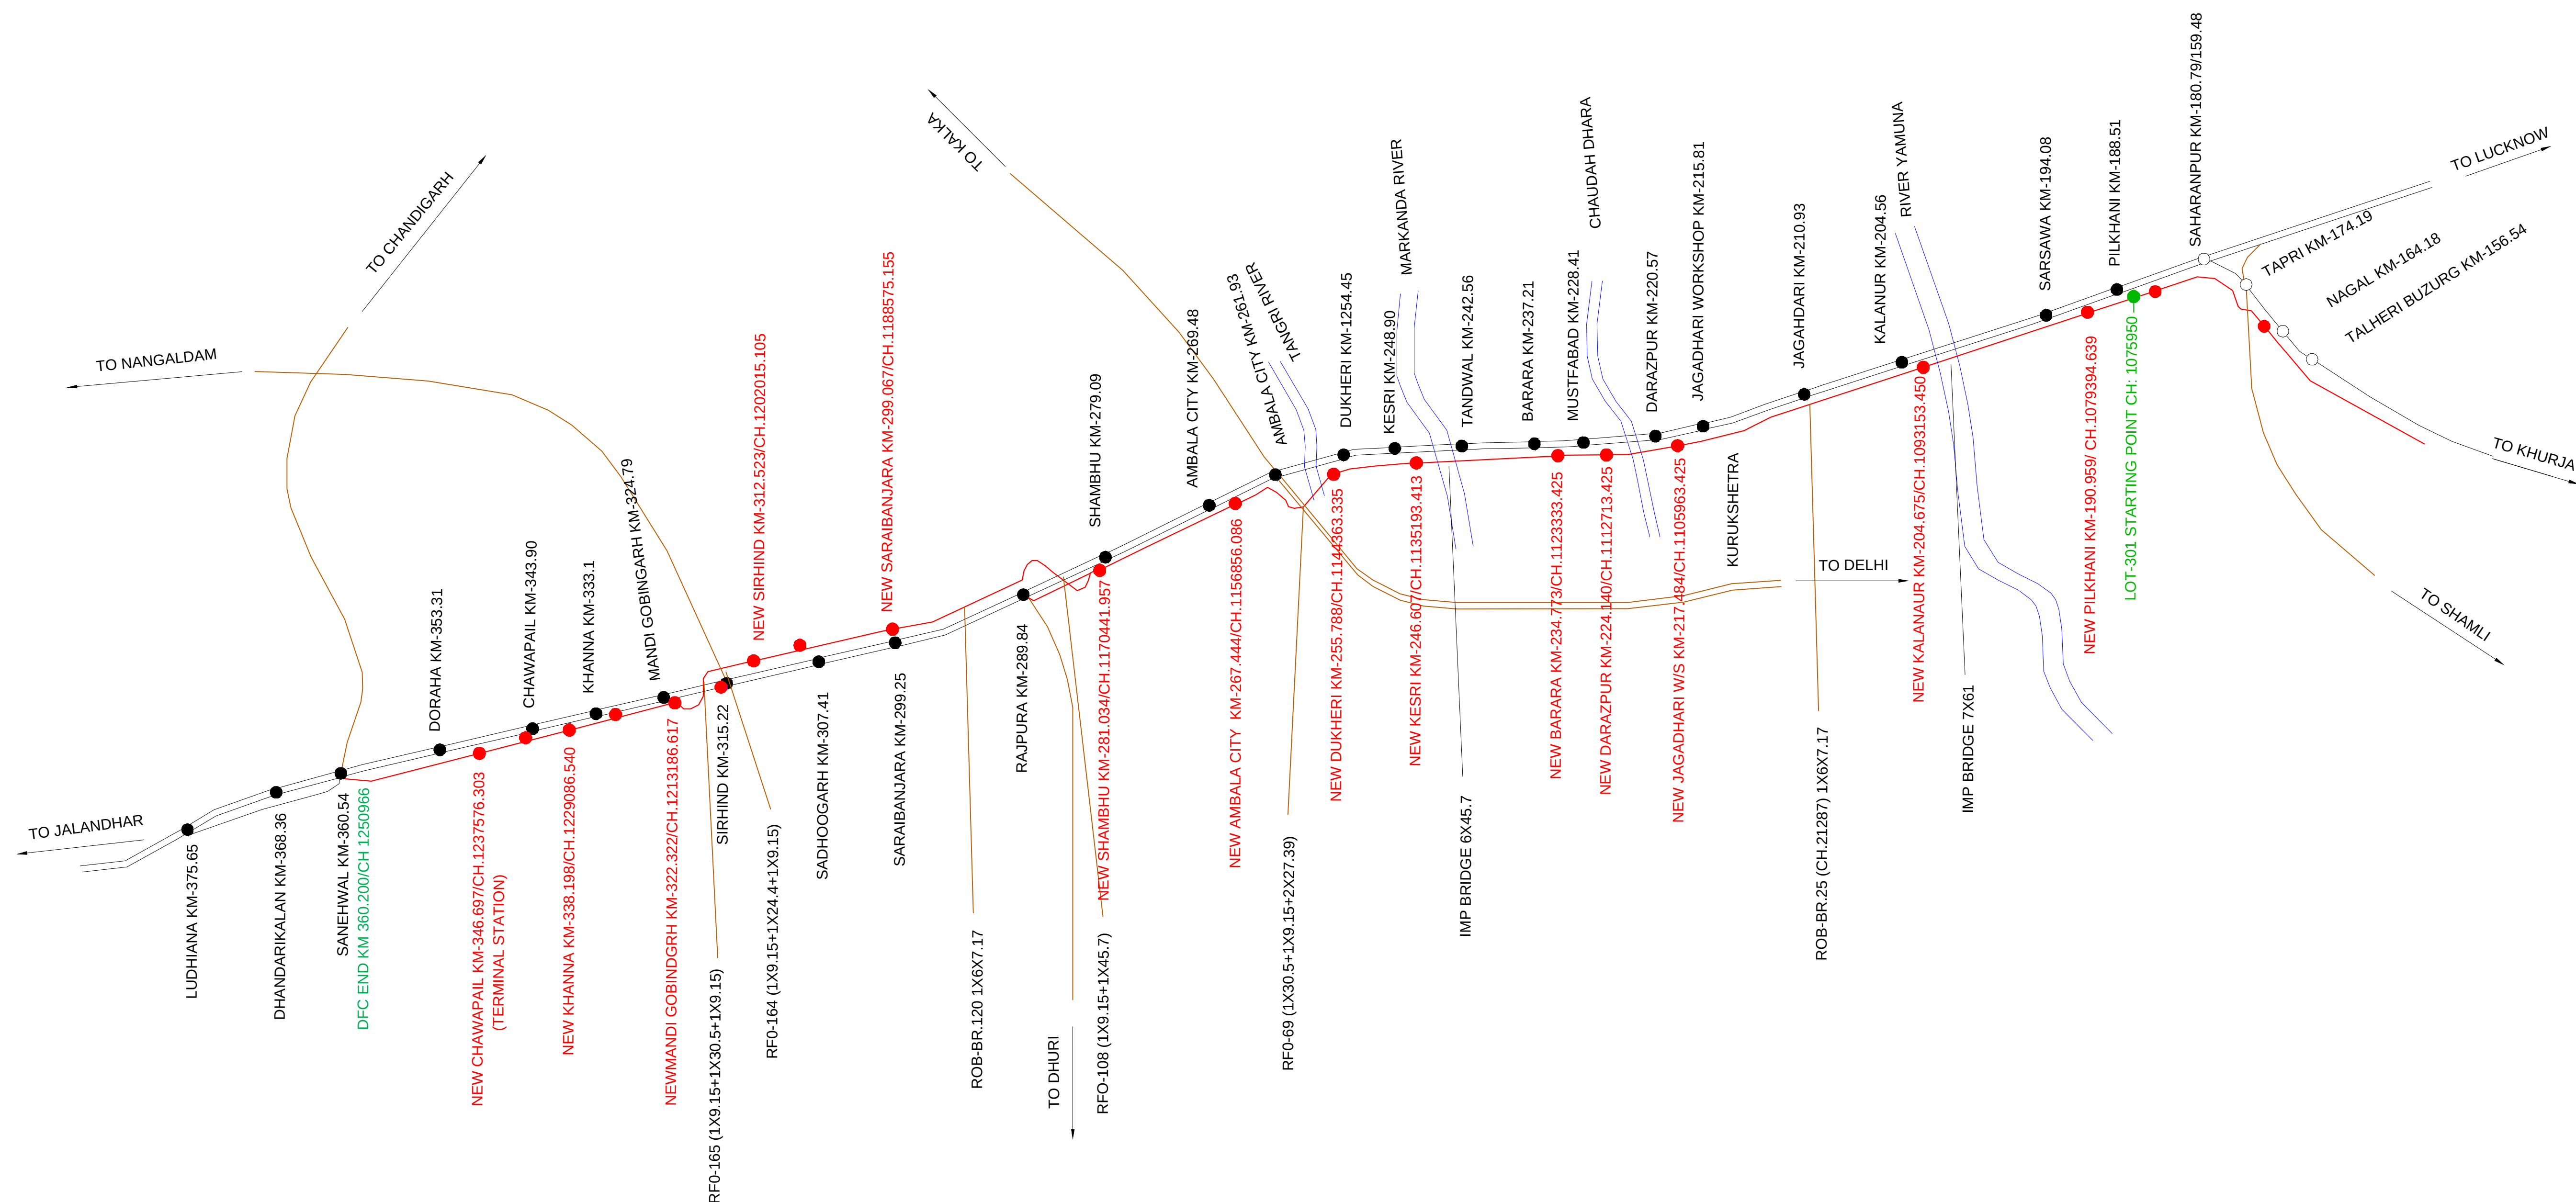


[illegible]

LEGEND	
EXISTING IR TRACK	
DFC TRACK	
DFC FUTURE PROPOSALS	
IR PROPOSALS	
TOE LINE	
FORMATION CESS	
RETAINING WALL	
DRAIN CUM RETAINING WALL	
ROAD	
STREAM, DRAIN, NALA, CANAL.	
FENCE	
POWER LINES	
GPS POINTS	
ELECTRIC POLE/OHE MAST	
EXISTING RAILWAY BOUNDARY	
DFC BOUNDARY	
DISMANTLED WORKS	
IOCL PIPE LINE	
IOCL ROW	
SIGNALLING CABLE PIPE	

ABBREVIATIONS		
1.	BL	- BED LEVEL
2.	BVC	- BEGIN OF VERTICAL CURVE
3.	Ca	- APPLIED CANT
4.	CCL	- CIRCULAR CURVE LENGTH
5.	CTP1	- COMMON TANGENT POINT
6.	CTP2	- COMMON TANGENT POINT
7.	DEGREE	- DEGREE OF CURVE
8.	DE	- DEAD END
9.	ECL	- EXISTING CLEARANCE
10.	EFB	- EXISTING FREE BOARD
11.	EFL	- EXISTING FORMATION LEVEL
12.	ERL	- EXISTING RAIL LEVEL
13.	ESL	- EXISTING SOFFIT LEVEL
14.	EVC	- END OF VERTICAL CURVE
15.	EVCL	- EXISTING VERTICAL CLEARANCE
16.	F/CSB	- FROM CENTER LINE OF STN BLDG
17.	FM	- FOULING MARK
18.	FSL	- FULL SUPPLY LEVEL
19.	HFL	- HIGH FLOOD LEVEL
20.	L	- STRAIGHT LENGTH
21.	LH	- LEFT HANDED
22.	LHS	- LIMITED HEIGHT SUBWAY
23.	PCL	- PROPOSED CLEARANCE
24.	PFB	- PROPOSED FREE BOARD
25.	PFL	- PROPOSED FORMATION LEVEL
26.	PRL	- PROPOSED RAIL LEVEL
27.	PSL	- PROPOSED SOFFIT LEVEL
28.	PVCL	- PROPOSED VERTICAL CLEARANCE
29.	PVI	- POINT OF VERTICAL INTERSECTION
30.	R	- RADIUS
31.	REV.BL	- REVISED BED LEVEL
32.	RH	- RIGHT HANDED
33.	Rr	- RESULTANT RADIUS
34.	SE	- SUPER ELEVATION
35.	SRJ	- STOCK RAIL JOINT
36.	TS	- TRAP SWITCH
37.	TTL	- TOTAL TANGENT LENGTH
38.	TTP1	- TRANSITION TANGENT POINT
39.	TTP2	- TRANSITION TANGENT POINT
40.	TL	- TRANSITION LENGTH
41.	DELTA	- DEFLECTION ANGLE

				SCALE	DESIGN CONSULTANT	CONTRACTOR	ENGINEER	OWNER	PROJECT	TITLE	DFCC APPR. NO. -					
				NOT TO SCALE	 aarvee associates architects engineers & consultants pvt.ltd.	  GIL - TPL JV	 DB Engineering & Consulting GmbH	 मेडीकेटर फ्रेट कॉर्पोरेश	DEDICATED FREIGHT CORRIDOR CORPORATION OF INDIA LTD. (A GOVERNMENT OF INDIA ENTERPRISE) PROJECT OFFICE(AMBALA UNIT): OLD RAILWAY COLONY (NEAR ANAND MARKET),AMBALA CANTT-133001. CORPORATE IDENTITY NO. : U60232DL2006GOI155068	EASTERN DEDICATED FREIGHT CORRIDOR SAHNEWAL TO PILKHANI CONTRACT PACKAGE - 301	ALIGNMENT DRAWINGS LEGEND AND ABBREVIATIONS	ENG. APPR. NO. -				
																DRG. NO. - 301-2/AL/1000
REV.	DATE	REVISION DETAILS	PURPOSE OF ISSUE								SHEET NO. : 1 OF 1	REV. No.	STATUS			
											DATE : 15-06-2024	0	A			

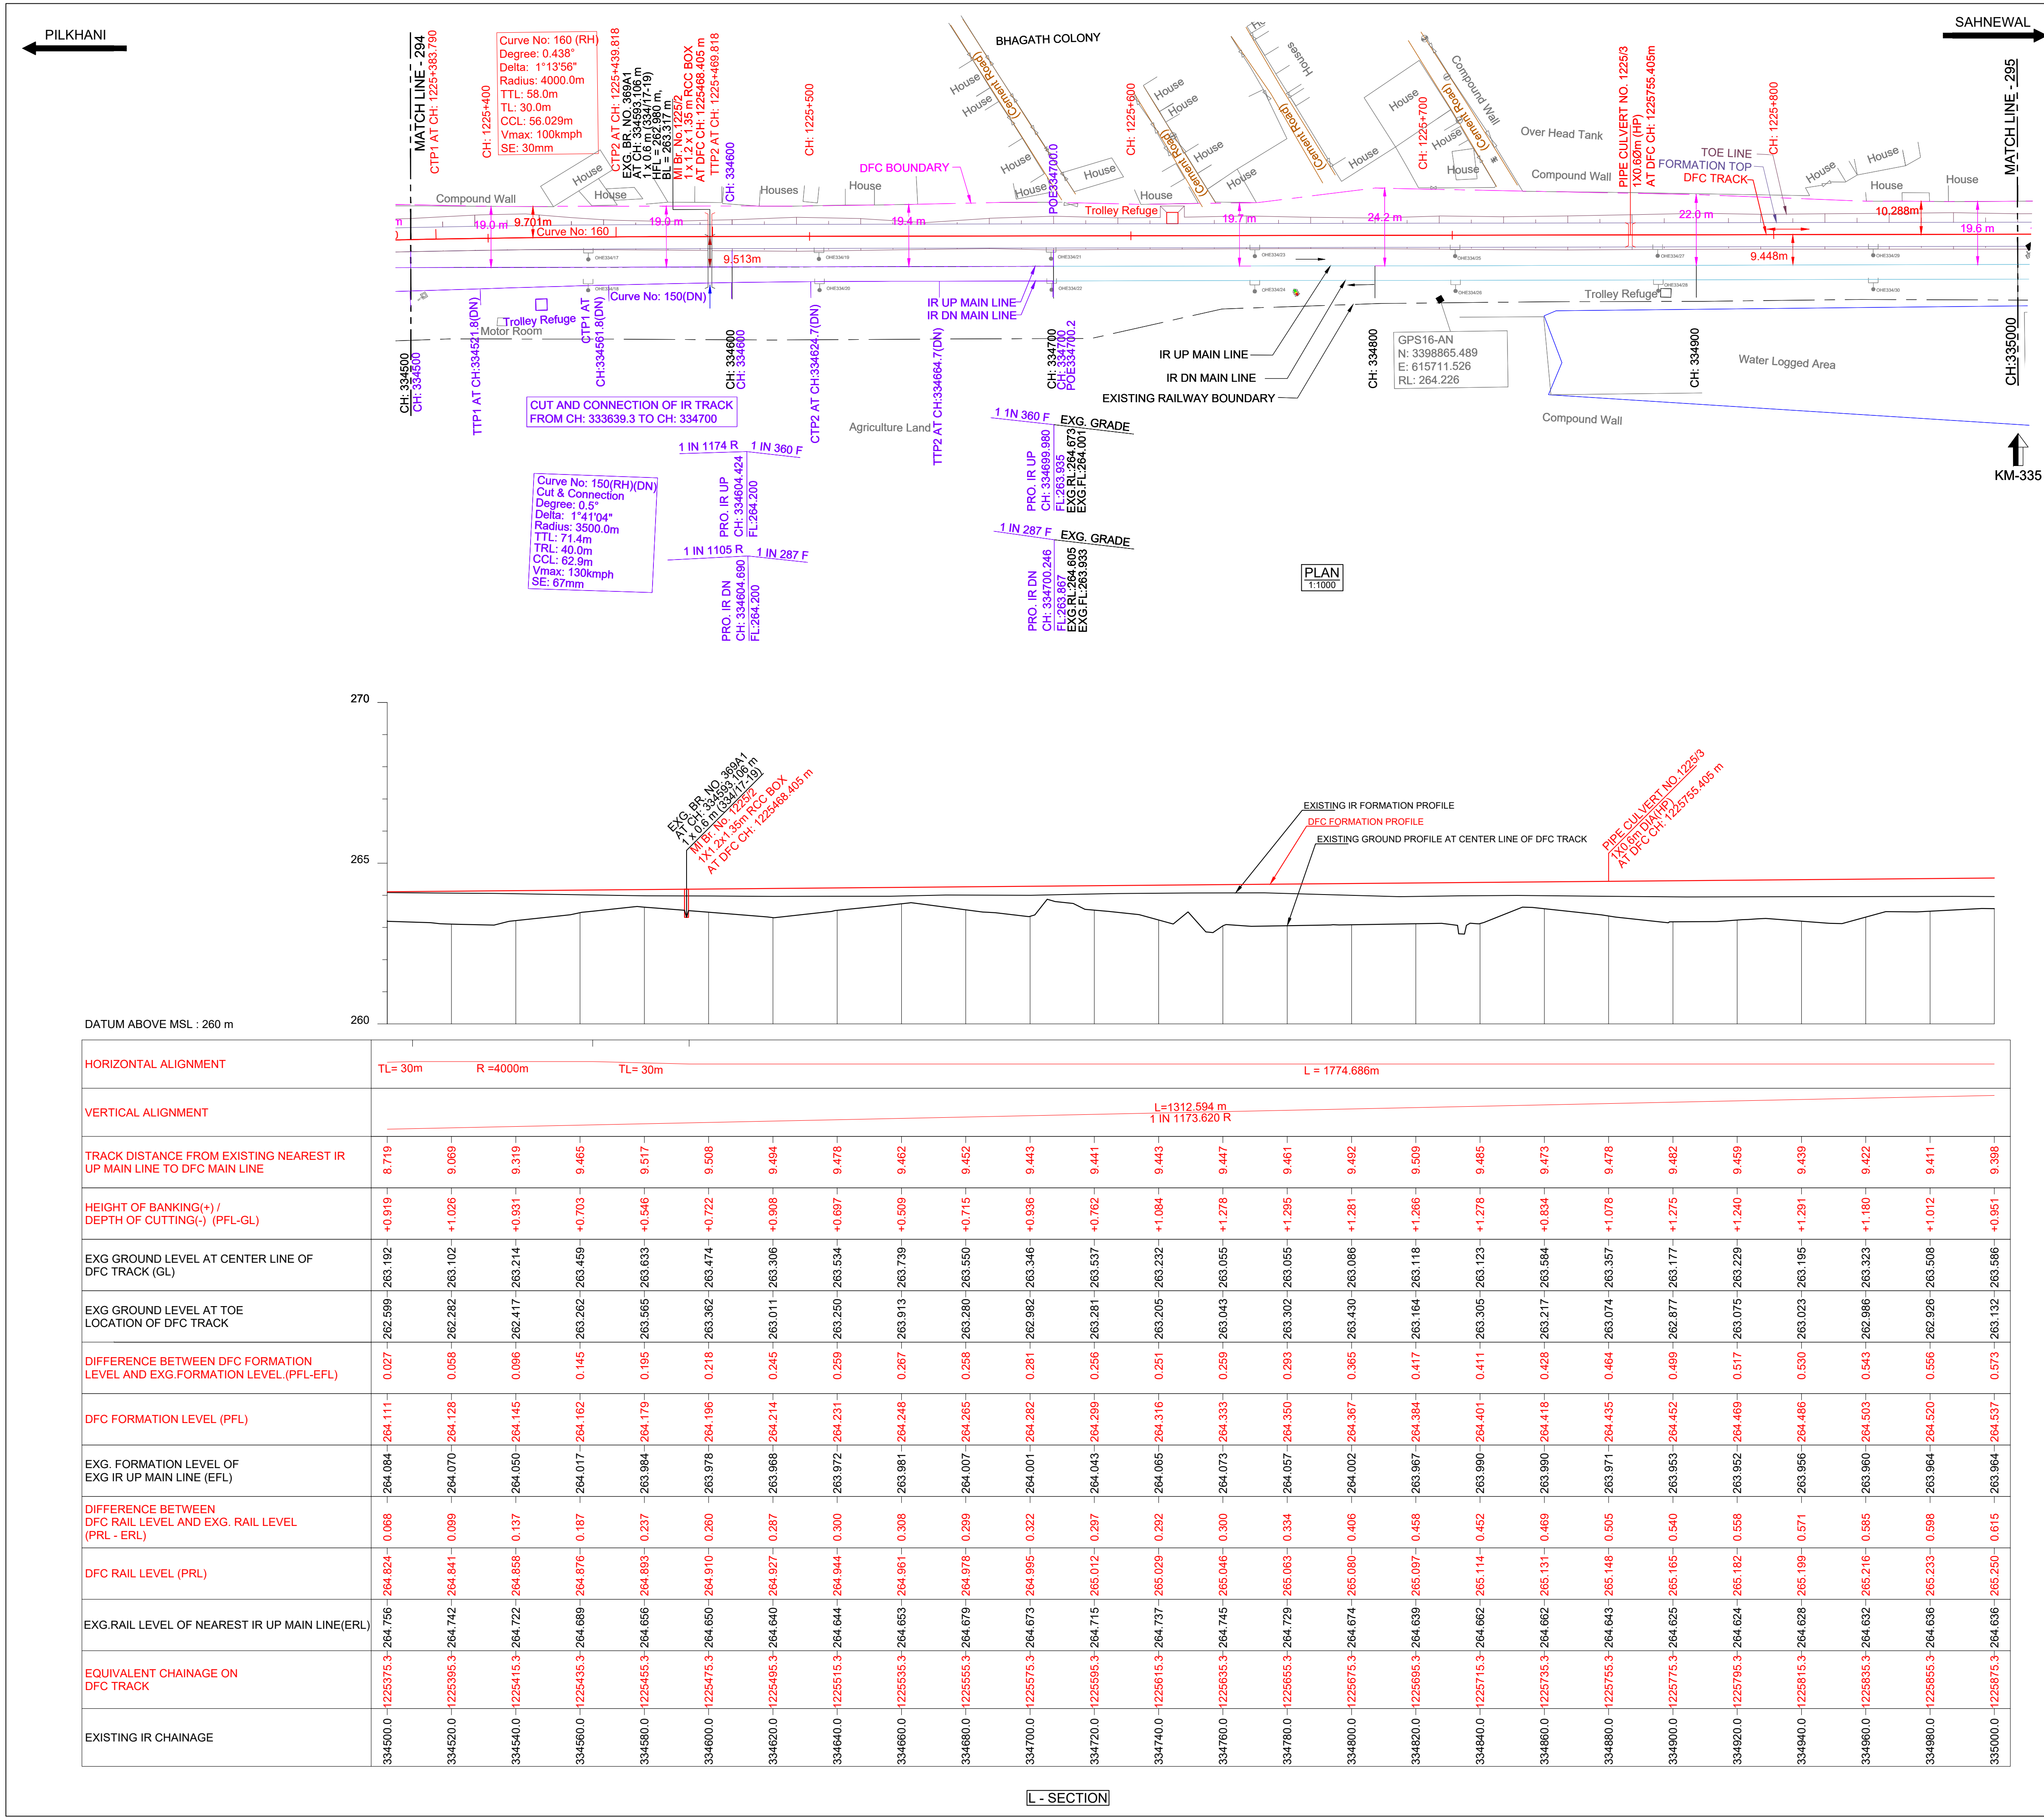

NOTE:-

- DFCC WORKS ARE SHOWN IN RED.
- IR NEW WORKS ARE SHOWN IN VIOLET.
- ALL DIMENSIONS ARE SHOWN IN METRES.
- THIS DRAWING IS PREPARED BASED ON LATEST SURVEY DATA HELD ON APRIL-2022. GTS BENCH MARK OF 261.85M CONSIDERED ON TOP OF CANAL BRIDGE ABUTMENT AT DORANA VILLAGE ALONG THE NH1.
- DFC NEW CHAINAGE OF 1075.950M IS WITH REFERENCE TO THE IR KM OF 187.500KM END OF KM OF CP-303(SECTION P-3 PILKHANI END) AGAINST THE EXISTING DFC CHAINAGE. 116277.742M ISSUED VIDE LETTER NO. COM/DFCC/MB/SURVEY/2021-301-2301/16-01/173 DT. 17.01.2023.
- BALLAST PROFILE HAS BEEN PROVIDED ACCORDING TO THE CLAUSE 1.11.3 OF STANDARD SCHEDULE OF DIMENSION(EASTERN CORRIDOR) & THE BALLAST CUSHION DIMENSION SHOWN IN 35CM ON GE-14 PARA 17. SPECIFICATIONS & RECOMMENDATIONS 2. TWO LAYER SYSTEM FIG.10.

REFERENCE DRAWINGS :-

- FOR KEY PLAN REFER DRAWING NO. 301-2/AL/0001
- FOR LEGEND AND ABBREVIATIONS REFER DRAWING NO. 301-2/AL/1000
- FOR TYPICAL SECTION OF BALLAST PROFILE (FL-RL) REFER DRG. NO. 301-2/TK/TFD/-004 (TR.1952)

LEGEND:

IR TRACK
DFCC TRACK
DFCC FUTURE PROPOSALS
STRUCTURE / BUILDING
DFCC TOE LINE
DFCC FORMATION
RETAINING WALL
ROAD
STREAM, DRAIN, NALA, CANAL.
FENCE
POWER LINES
TBM
ELECTRIC POLE/OHE MAST
IR RAILWAY BOUNDARY
DFCC BOUNDARY

SCALE

HOR - 1:1000
VER - 1:100
SHEET SIZE : A1

TYPICAL SECTION

TRACK STRUCTURE	
RAIL SECTION: 60Kg/m (UIC 60Kg/m) DFC LINE: 60Kg/m (UIC 60Kg/m) IR MAIN LINE: 52Kg/m	Difference between FL- RL (Below Rail Seat)
	IR Line DFC
RUBBER PAD	172mm 172mm
SLEEPER DEPTH	6mm 10mm
BALLAST CUSHION	210mm 210mm
	300mm 350mm
Total Depth (FL TO RL)	688mm 742mm

OWNER

DEDICATED FREIGHT CORRIDOR CORPORATION OF INDIA LTD.
(A GOVERNMENT OF INDIA ENTERPRISE)
PROJECT OFFICE (AMBALA UNIT): OLD RAILWAY COLONY (NEAR ANAND MARKET), AMBALA CANTT-133001.
CORPORATE IDENTITY NO. : U60232DL2006G01155068

ENGINEER:

DB Engineering & Consulting GmbH
Deutsche Bahn Engineering & Consulting GmbH

CONTRACTOR:

GIL - TPL JV
GAR TATA

SUBMITTED BY	GIL - TPL JV		
	DATED	NAME	SIGNATURE
PREPARED BY			
CHECKED BY	03.10.2024	VIJAY PRATAP	
APPROVED BY	03.10.2024	PARASURAM KOTYADA	

APPROVED BY

DEUTSCHE BAHN ENGINEERING & CONSULTING GMBH

	DATED	NAME	SIGNATURE
Sr. DE./CHIEF ENGINEER		SURESH K.YALANGI	
CHIEF TRACK ENGINEER		RAJ PAL SINGH	
T.L.		H.D. VIDJAK	

STAMP

A AS-BUILT DRAWING
TR. Ref.:.....
ENGINEER Sign.:.....

EMPLOYER (DFCCIL):

DEDICATED FREIGHT CORRIDOR CORPORATION OF INDIA LTD.

AS BUILT DRAWING

TITLE

AS-BUILT PLAN AND PROFILE


FROM IR KM: 334.500 TO 335.000
FROM DFC KM: 1225.375 TO 1225.875

DFCC APPR. NO. -
ENGG. APPR. NO. -
DRG. NO. :301-2/AL/A/1295
SHEET NO. : 1 OF 1
DATE : 03.10.2024

STATUS

A

TR.

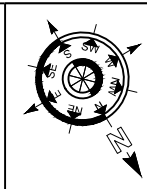

NOTE


1. DFC WORKS ARE SHOWN IN **RED**.
2. IR NEW WORKS ARE SHOWN IN **VIOLET**.
3. ALL DIMENSIONS ARE GIVEN IN METRES.
THIS DRAWING IS PREPARED BASED ON LATEST SURVEY DATA HELD ON APRIL-2022. GTS BENCH MARK OF 261.850M CONSIDERED ON TOP OF CANAL BRIDGE ABUTMENT AT DORAHA VILLAGE ALONG THE LEFT BANK.
4. DFC NEW CHAINAGE OF 1795.950M IS WITH REFERENCE TO THE IR KM OF 187.500KM END OF KM OF CFC-303(SECTION P-3 PILKHANI END) AGAINST THE EXISTING DFC CHAINAGE. 116277.742M ISSUED VIOLET LETTERS.
5. THE EXISTING DFC CHAINAGE OF 1795.950M TO THE BALLAST CUSHION MARK SHOWN IN SSCM ON GE-1 BALLAST PROFILE HAS BEEN PROVIDED ACCORDING TO THE CLAUSE 11.1.3 OF STANDARD SCHEDULE OF MEASUREMENTS AND VALUATION.
6. PARA 17, SPECIFICATIONS & RECOMMENDATIONS 2, TWO LAYER SYSTEM OF FORD.

REFERENCE DRAWINGS :-


1. FOR KEY PLAN REFER DRAWING NO. 301-2/AL/0001
2. FOR LEGEND AND ABBREVIATIONS REFER DRAWING NO. 301-2/AL1000
3. FOR TYPICAL SECTION OF BALLAST PROFILE (FL-RL) REFFER DRG. NO. 301-2/TK/TFD/-004 (TR.1952)

0	03.10.2024	SUBMISSION OF AS-BUILT DRAWING	FOR APPROVAL
REV.	DATE	REVISION DETAILS	PURPOSE OF ISSUE

LEGEND

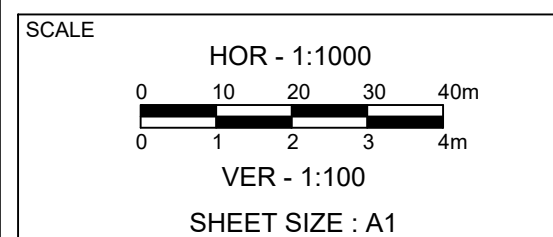

IR TRACK	
DFCC TRACK	
DFCC FUTURE PROPOSALS	
STRUCTURE / BUILDING	
DFCC TOE LINE	
DFCC FORMATION	
RETAINING WALL	
ROAD	
STREAM, DRAIN, NALA, CANAL.	
FENCE	
POWER LINES	
TBM	
ELECTRIC POLE/OHE MAST	
IR RAILWAY BOUNDARY	
DFCC BOUNDARY	

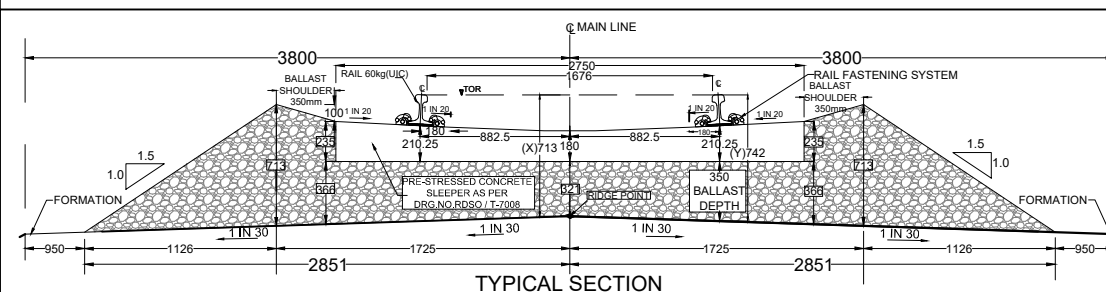

TRACK STRUCTURE		
RAIL SECTION: 60Kg/m (UIC 60Kg/m) DFC LINE: 60Kg/m (UIC 60Kg/m) IR MAIN LINE: 52Kg/m	Difference between FL- RL (Below Rail Seat)	
	IR Line	DFC
	172mm	172mm
RUBBER PAD	6mm	10mm
SLEEPER DEPTH	210mm	210mm
BALLAST CUSHION	300mm	350mm
Total Depth (FL TO RL)	688mm	742mm

OWNERS



DEDICATED FREIGHT CORRIDOR CORPORATION OF INDIA LTD.

(A GOVERNMENT OF INDIA ENTERPRISE)

PROJECT OFFICE(AMBALA UNIT): OLD RAILWAY COLONY

CORPORATE IDENTITY NO. : U160232DL2006GOI15501

ENGINEER



DB Engineering &
Consulting GmbH

Deutsche Bahn Engineering & Consulting GmbH

CONTRACTOR

GIL - TPL JW



SUBMITTED BY	GIL - TPL JV		
	DATED	NAME	SIGNATURE
PREPARED BY			
CHECKED BY	03.10.2024	VIJAY PRATAP	
APPROVED BY	03.10.2024	PARASURAM KOTYADA	

APPROVED BY	DEUTSCHE BAHN ENGINEERING & CONSULTING GMBH		
	DATED	NAME	SIGNATURE
Sr. DE./CHIEF ENGINEER		SURESH K.YALANGI	
CHIEF TRACK ENGINEER		RAJ PAL SINGH	
T.L.		H.D. VIDJAK	

STAMP

A AS-BUILT DRAWING
TR. Ref.....
ENGINEER Sign.:

EMPLOYER (DFCCIL):

DEDICATED FREIGHT CORRIDOR CORPORATION OF INDIA LTD

TITLE

AS-BUILT PLAN AND PROFILE



FIGURE 11: THE EFFECT OF THE RISK-NEUTRALITY PARAMETER ON THE OPTIMAL PORTFOLIO

FROM DEC KM: 1235.835 +/- 1236.33

FROM DTG RM: 1220.070 TO 1220.070	DATE : 03.10.2024
-----------------------------------	-------------------

STATUS



ED

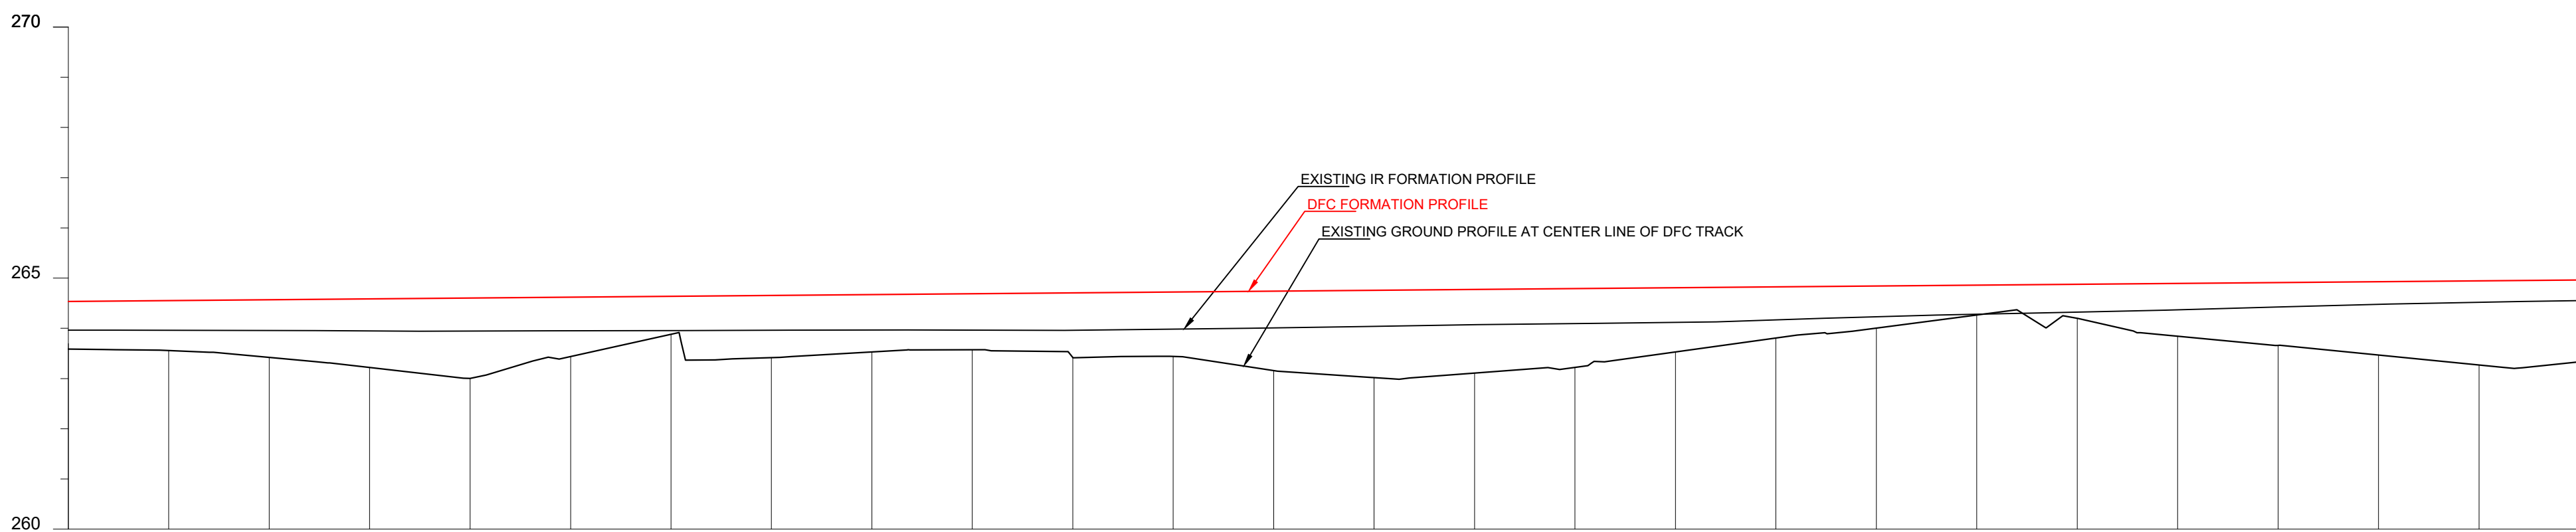
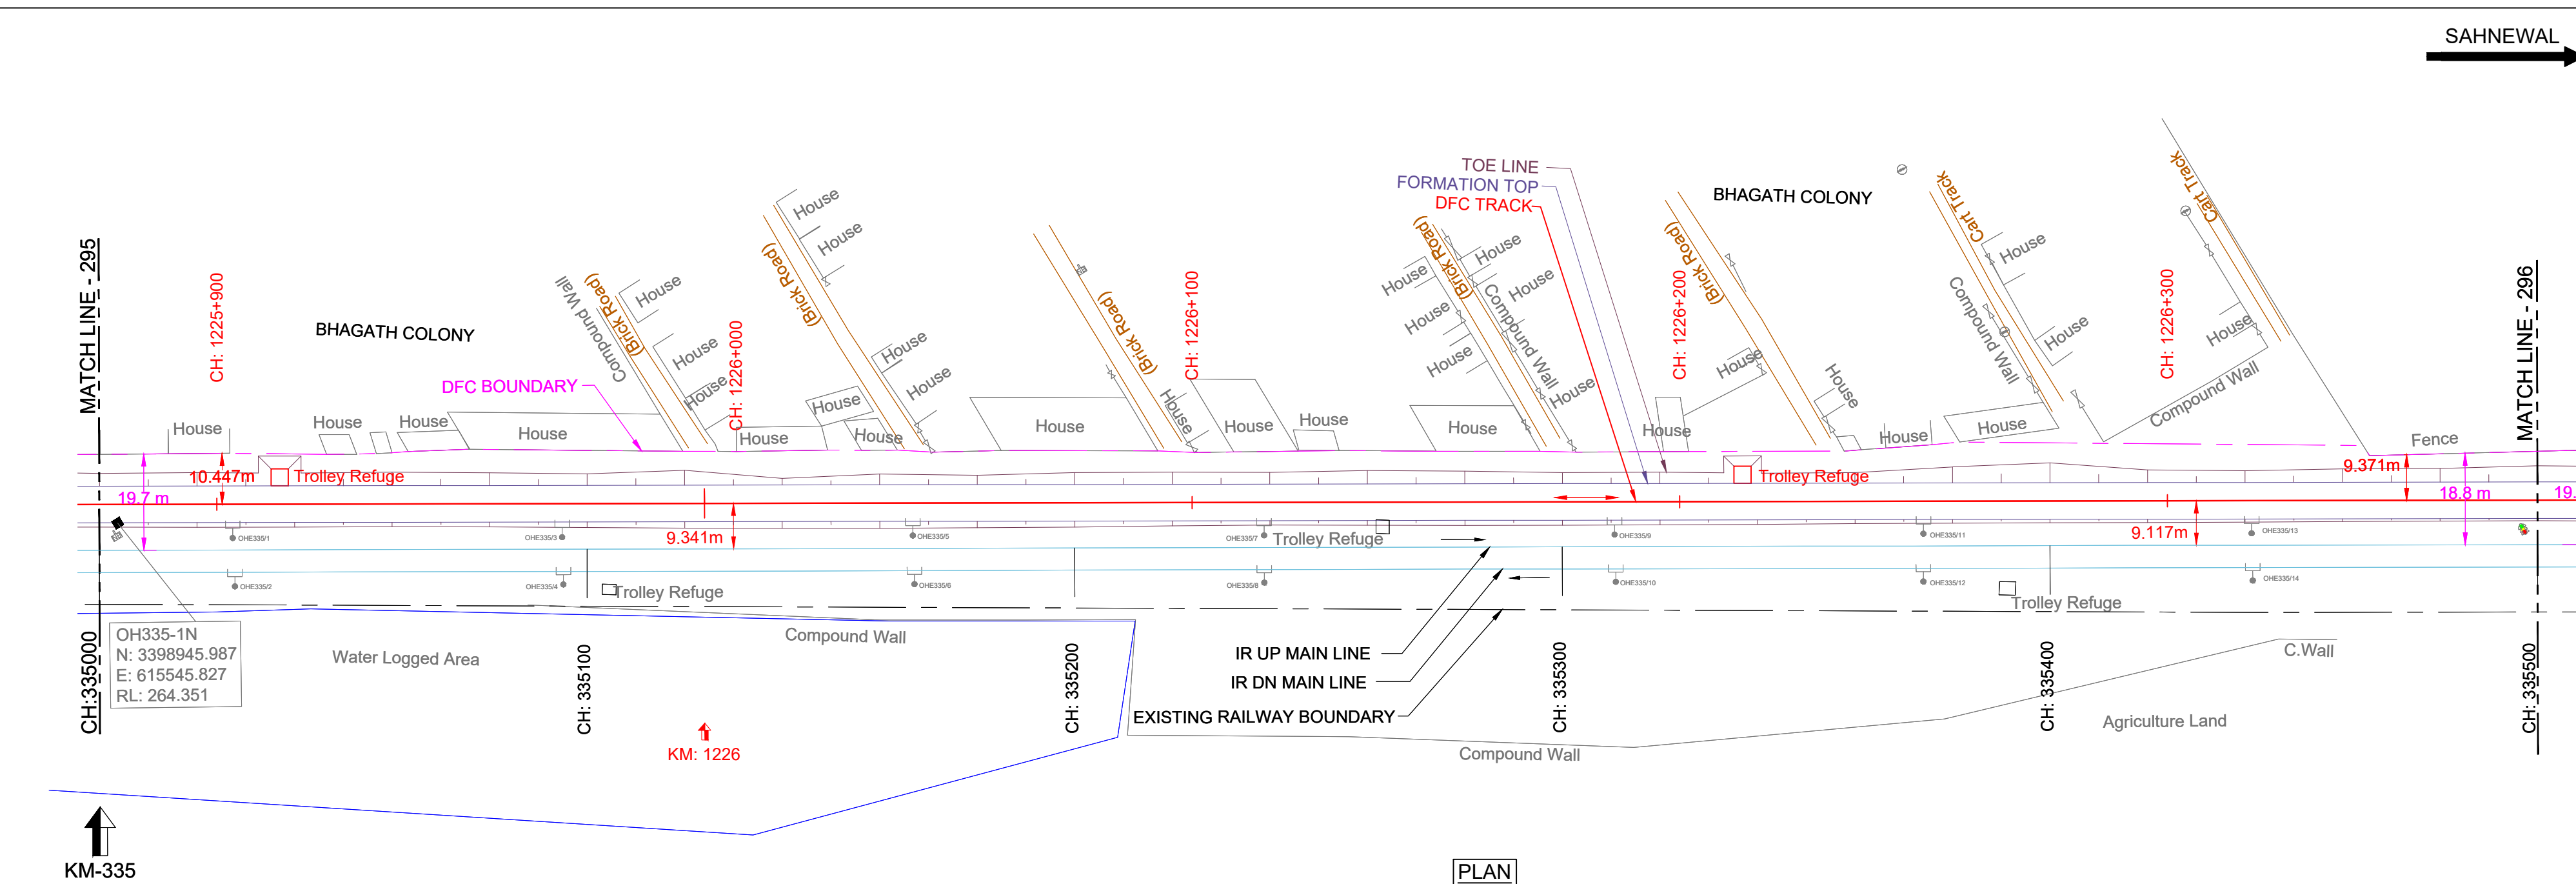


DATUM ABOVE MSL : 260 m

HORIZONTAL ALIGNMENT	L = 1774.686m									
VERTICAL ALIGNMENT	L = 1312.594 m 1 IN 1173.620 R									
TRACK DISTANCE FROM EXISTING NEAREST IR UP MAIN LINE TO DFC MAIN LINE										
HEIGHT OF BANKING(+) / DEPTH OF CUTTING(-) (PFL-GL)										
EXG GROUND LEVEL AT CENTER LINE OF DFC TRACK (GL)										
EXG GROUND LEVEL AT TOE LOCATION OF DFC TRACK										
DIFFERENCE BETWEEN DFC FORMATION LEVEL AND EXG FORMATION LEVEL (PFL-EFL)										
DFC FORMATION LEVEL (PFL)										
EXG. FORMATION LEVEL OF EXG IR UP MAIN LINE (EFL)										
DIFFERENCE BETWEEN DFC RAIL LEVEL AND EXG. RAIL LEVEL (PRL - ERL)										
DFC RAIL LEVEL (PRL)										
EXG. RAIL LEVEL OF NEAREST IR UP MAIN LINE (ERL)										
EQUIVALENT CHAINE ON DFC TRACK										
EXISTING IR CHAINE										

L - SECTION

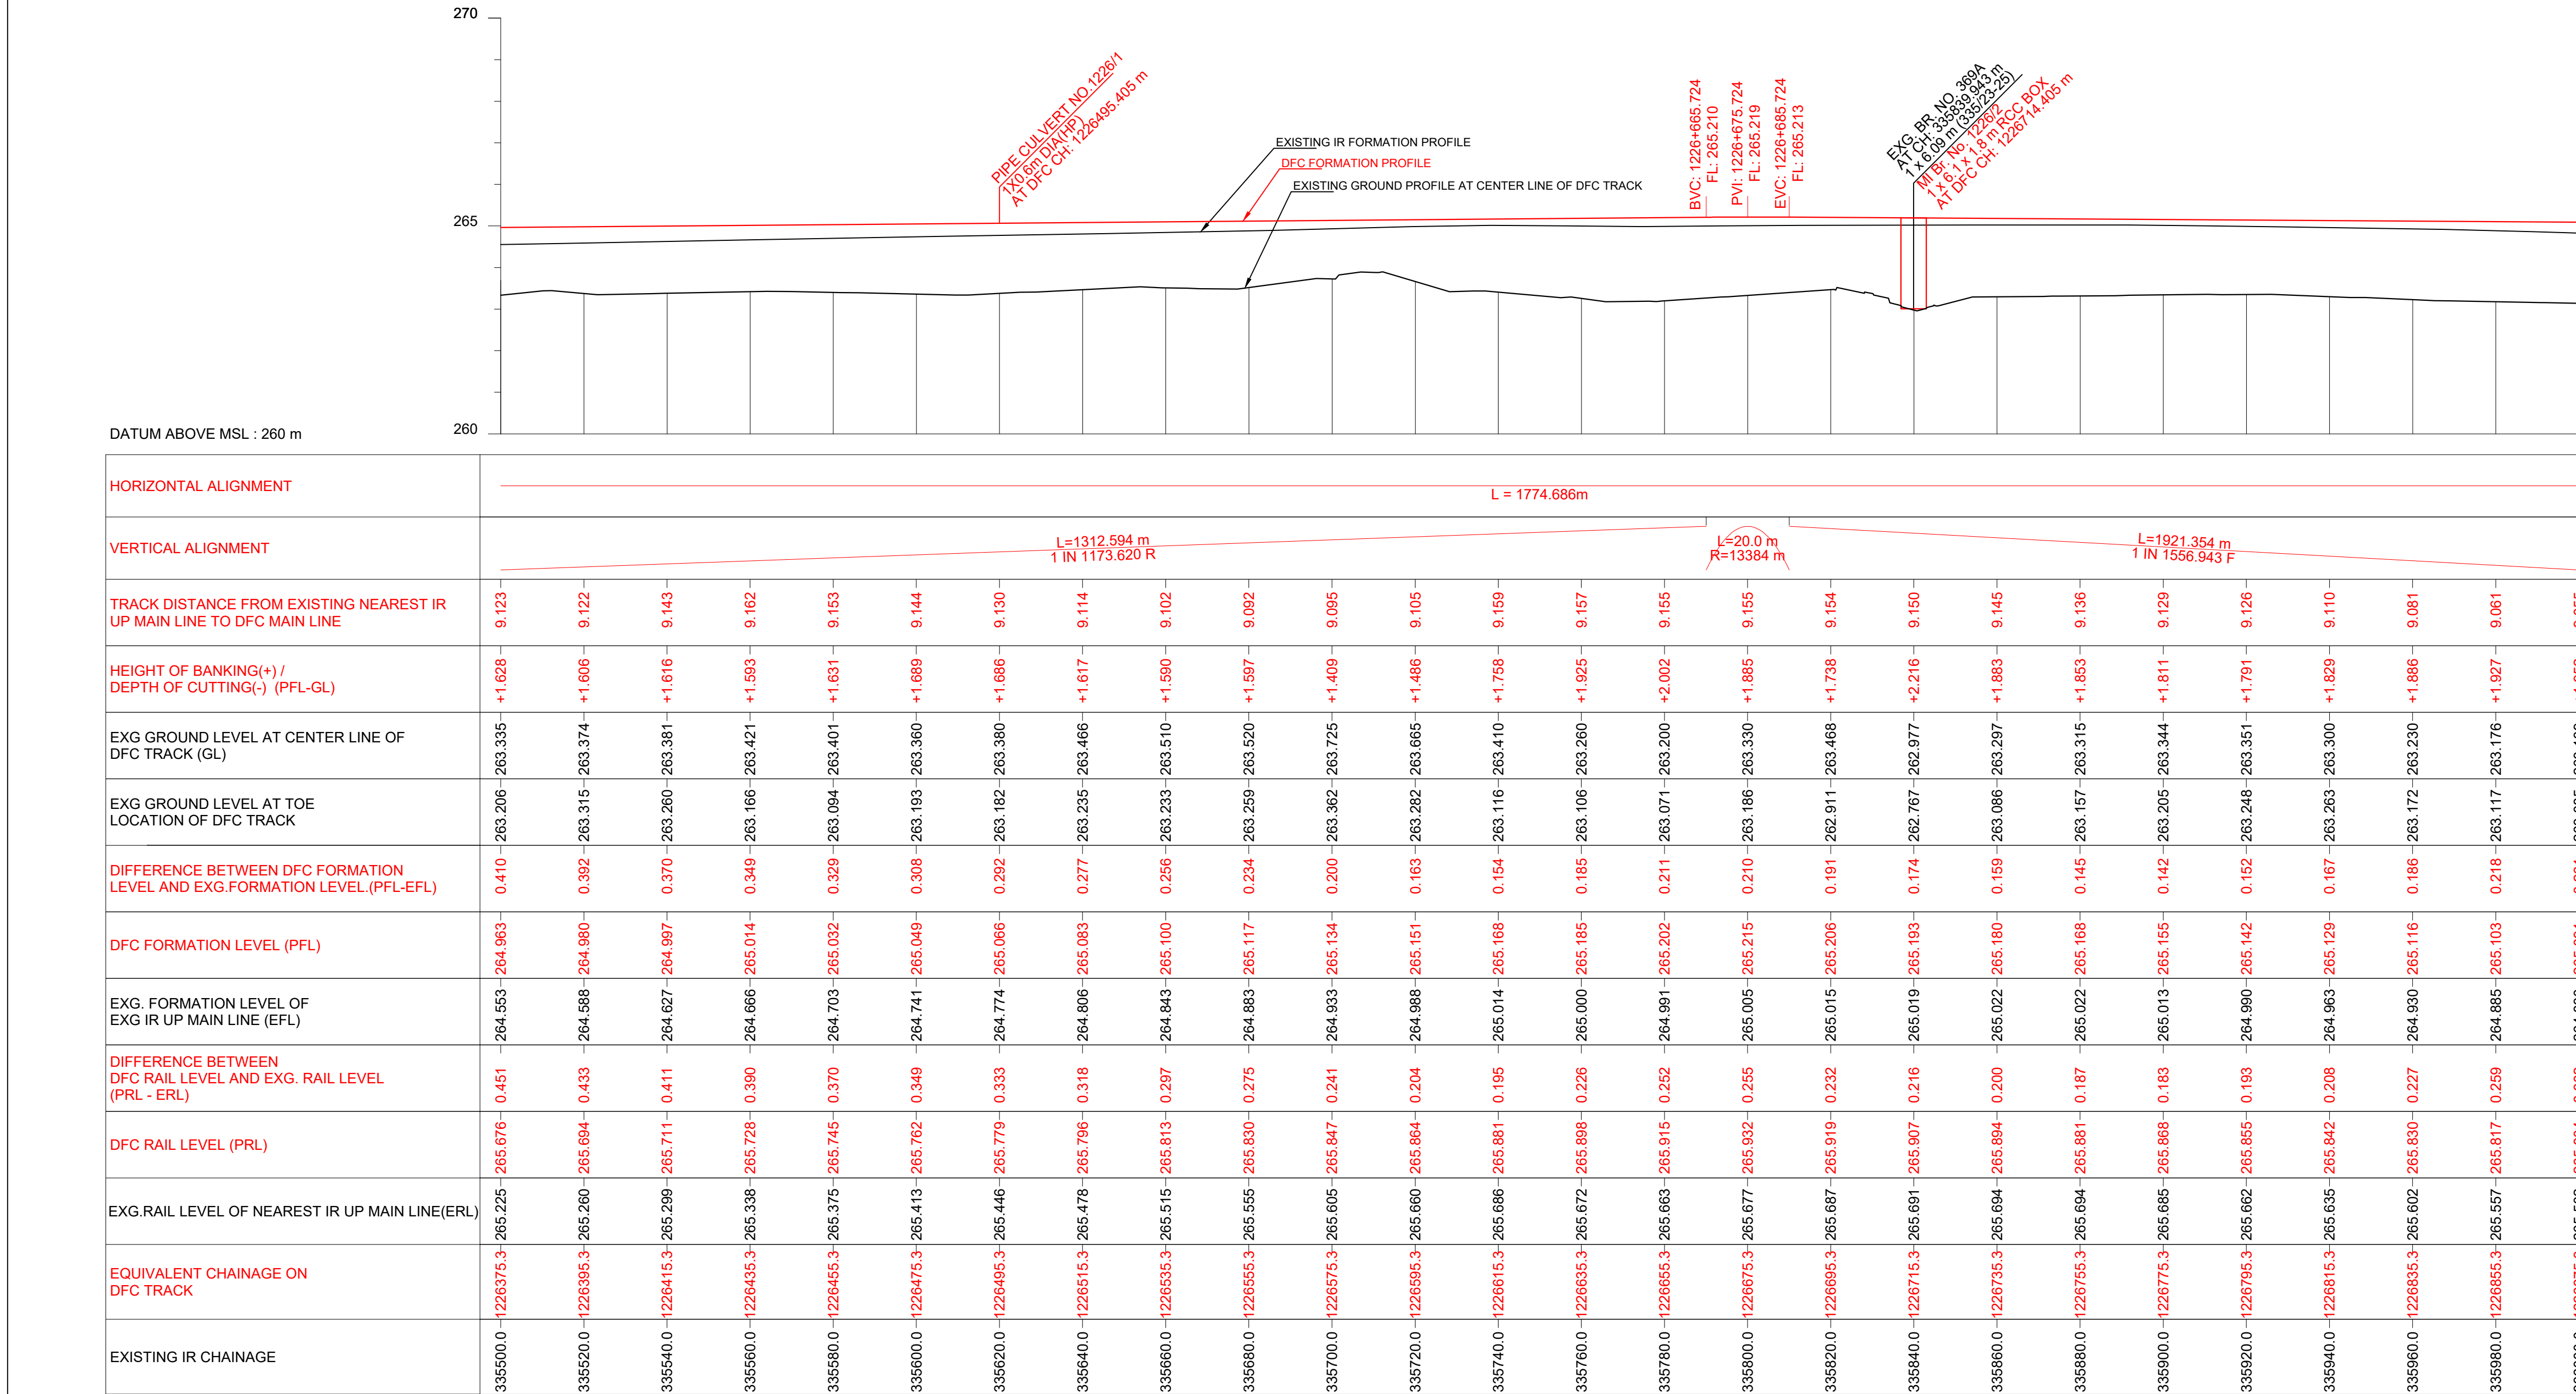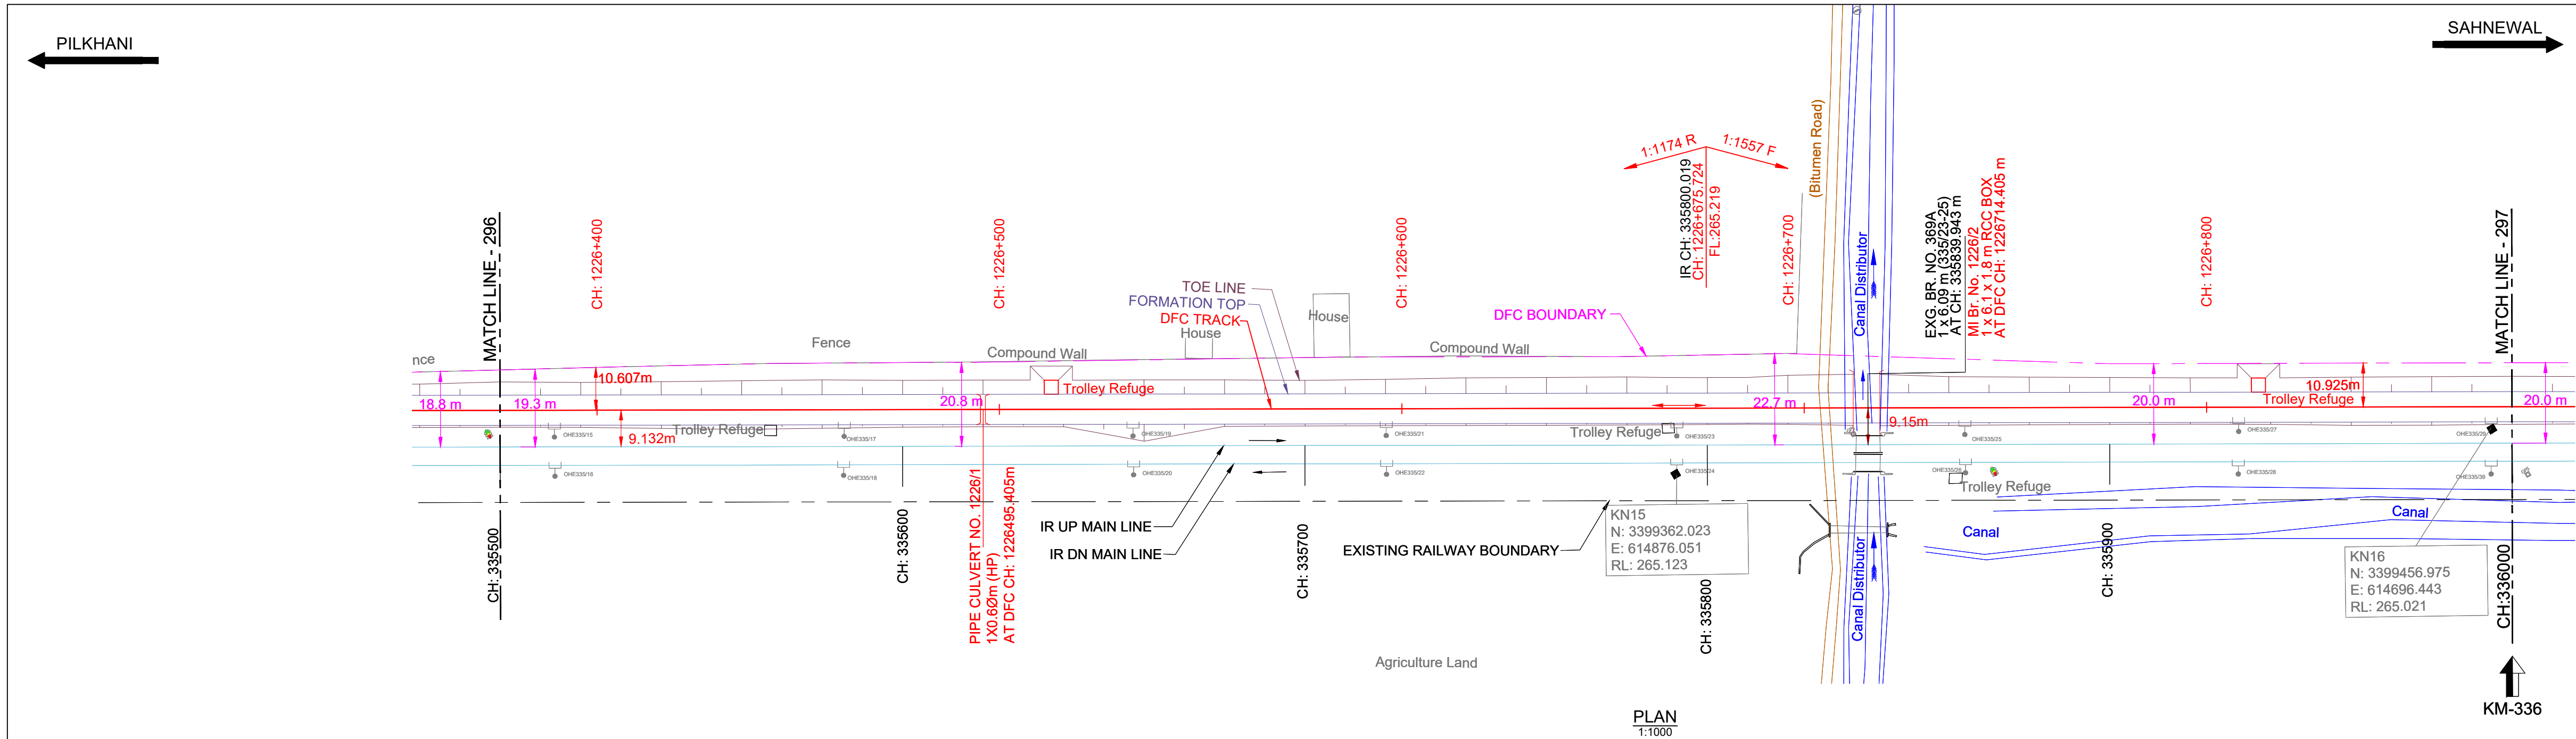

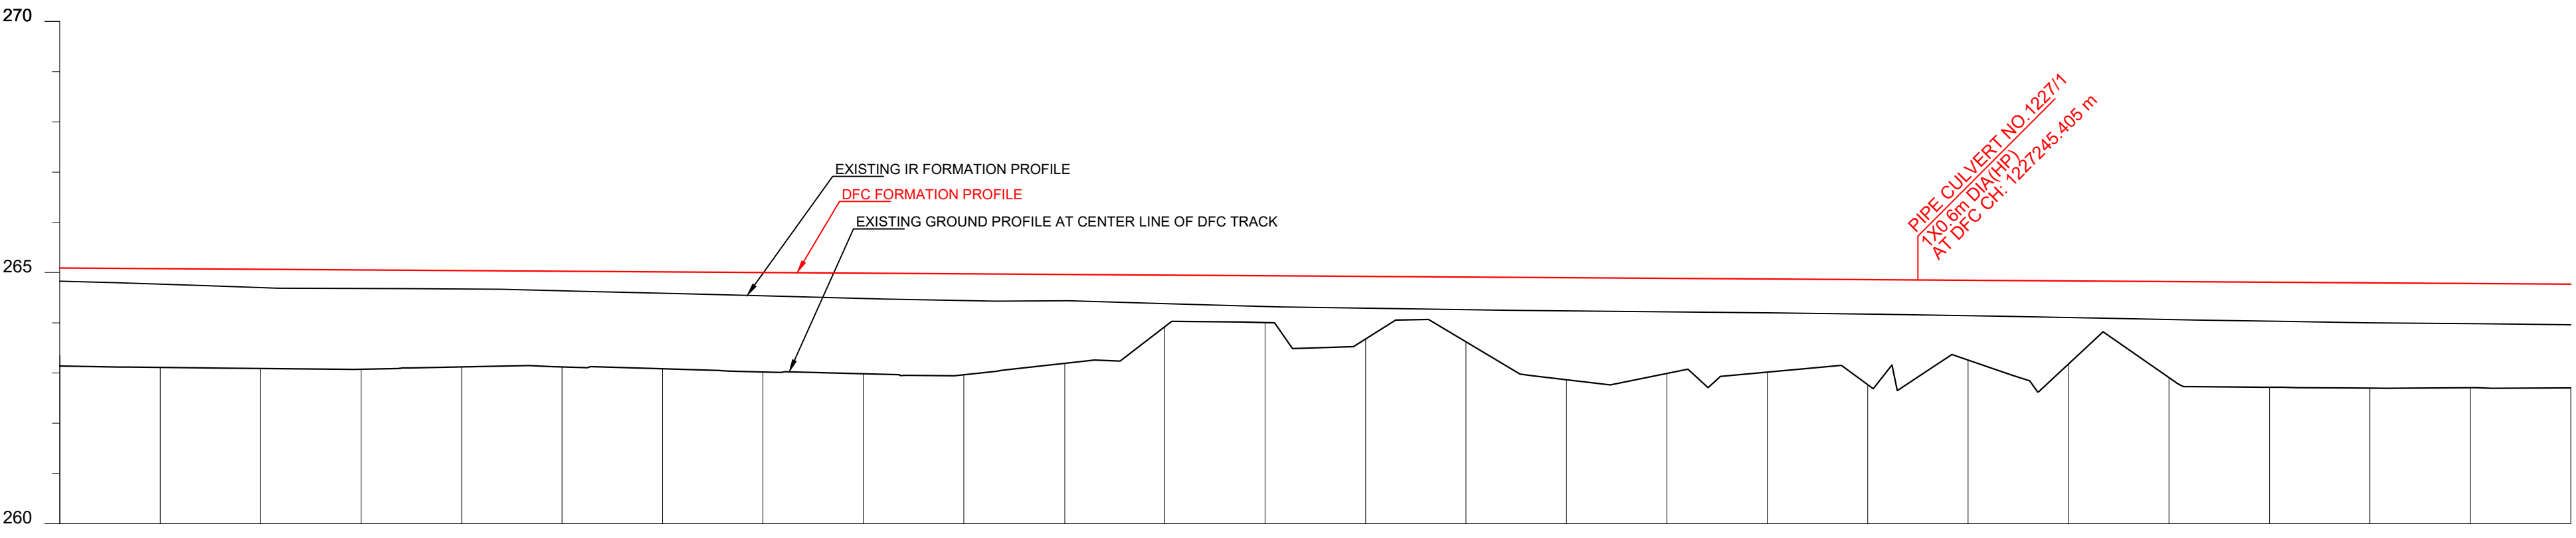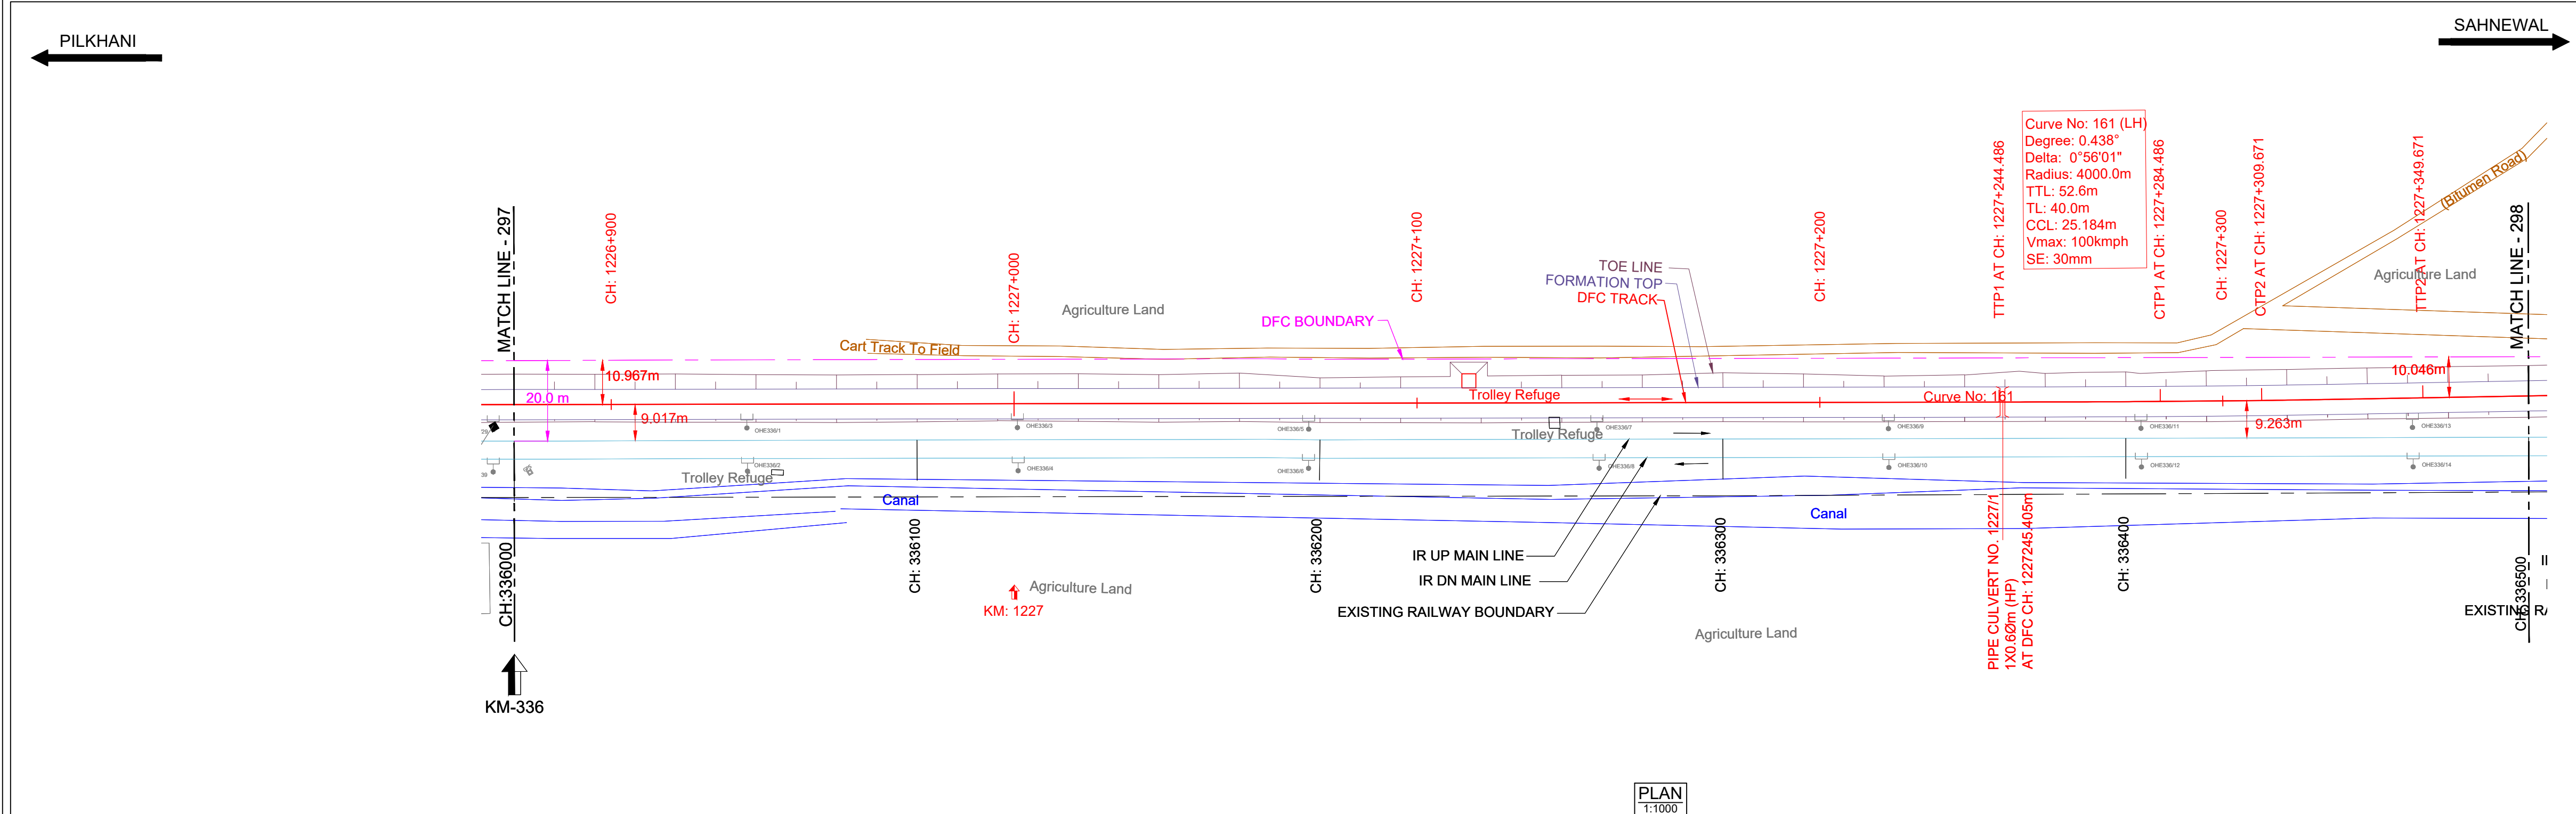

DATUM ABOVE MSL : 260 m

HORIZONTAL ALIGNMENT	L = 1774.686m																												TL= 40m				R = -4000m				TL= 40m				L = 273.505m																																																																																																																																																																																																																																																																																																																																																																																																																																																																																																																																																																																																																																																																																																																																																																																																																																																																																																																																																																																																																																																																																																																																																																																																																																																																																																																																																																																																																																																																																																																																																							
VERTICAL ALIGNMENT	L=1921.354 m 1 IN 1556.943 F																																																																																																																																																																																																																																																																																																																																																																																																																																																																																																																																																																																																																																																																																																																																																																																																																																																																																																																																																																																																																																																																																																																																																																																																																																																																																																																																																																																																																																																																																																																																																																																															
TRACK DISTANCE FROM EXISTING NEAREST IR UP MAIN LINE TO DFC MAIN LINE	9.055																																9.037								8.998								8.979								8.965								8.957								8.954								8.949								8.943								8.931								9.087								9.085								9.074								9.065								9.056								9.053								9.054								9.056								9.047								9.038								9.061								9.169								9.360								9.631								9.950								10.271																																																																																																																																																																																																																																																																																																																																																																																																																																																																																																																																																																																																																																																																																																																																																																																																																																																																																																																																																																																																																																																																																																																																																																																																																																																																																																																																																															
HEIGHT OF BANKING(+) / DEPTH OF CUTTING(-) (PFL-GL)	+1.952																																+1.968								+1.975								+1.978								+1.919								+1.906								+1.931								+1.980								+2.005								+2.011								+1.771								+1.030								+0.933								+1.252								+1.288								+2.033								+1.896								+1.855								+2.092								+1.590								+1.657								+1.913								+2.092								+2.077								+2.067																																																																																																																																																																																																																																																																																																																																																																																																																																																																																																																																																																																																																																																																																																																																																																																																																																																																																																																																																																																																																																																																																																																																																																																																																																																																																																																																																																							
EXG GROUND LEVEL AT CENTER LINE OF DFC TRACK (GL)	-263.139																																-263.110								-263.090								-263.074								-263.120								-263.082								-263.021								-263.120								-262.984								-263.672								-263.623								-262.865								-262.989								-263.017								-262.767								-263.256								-263.177								-262.908								-262.716								-262.697								-262.705								-262.702								-262.702								
L - SECTION

NOTE:-

- DFCC WORKS ARE SHOWN IN RED.
- IR NEW WORKS ARE SHOWN IN VIOLET.
- ALL DIMENSIONS ARE SHOWN IN METRES.
- THIS DRAWING IS PREPARED BASED ON LATEST SURVEY DATA HELD ON APRIL-2022. GTS BENCH MARK OF 261.850M CONSIDERED ON TOP OF CANAL BRIDGE ABUTMENT AT DORAHA VILLAGE ALONG THE NH1.
- DFC NEW CHAINAGE OF 1075.950M IS WITH REFERENCE TO THE IR KM OF 187.500KM END OF KM OF CP-303(SECTION P-3 PILKHANI END) AGAINST THE EXISTING DFC CHAINAGE. 116277.742M ISSUED VIDE LETTER NO. COM/DFCC/UMS/SURVEY/2021-301-230116-011173.DT. 17.01.2023.
- BALLAST PROFILE HAS BEEN PROVIDED ACCORDING TO THE CLAUSE 1.11.3 OF STANDARD SCHEDULE OF DIMENSION(EASTERN CORRIDOR) & THE BALLAST CUSHION DIMENSION SHOWN IN 35CM ON GE-14 PARA 17. SPECIFICATIONS & RECOMMENDATIONS 2. TWO LAYER SYSTEM FIG.10.

REFERENCE DRAWINGS :-

- FOR KEY PLAN REFER DRAWING NO. 301-2/AL/0001
- FOR LEGEND AND ABBREVIATIONS REFER DRAWING NO. 301-2/AL/1000
- FOR TYPICAL SECTION OF BALLAST PROFILE (FL-RL) REFER DRG. NO. 301-2/TK/TFD/-004 (TR.1952)

03.10.2024SUBMISSION OF AS-BUILT DRAWINGFOR APPROVAL

REV. DATE REVISION DETAILS PURPOSE OF ISSUE

SCALE
HOR - 1:1000
VER - 1:100
SHEET SIZE : A1

LEGEND:

- IR TRACK
- DFCC TRACK
- DFCC FUTURE PROPOSALS
- STRUCTURE / BUILDING
- DFCC TOE LINE
- DFCC FORMATION
- RETAINING WALL
- ROAD
- STREAM, DRAIN, NALA, CANAL.
- FENCE
- POWER LINES
- TBM
- ELECTRIC POLE/OHE MAST
- IR RAILWAY BOUNDARY
- DFCC BOUNDARY

TYPICAL SECTION

TRACK STRUCTURE

RAIL SECTION: 60Kg/m (UIC 60Kg/m)	Difference between FL- RL (Below Rail Seat)	
DFC LINE: 60Kg/m (UIC 60Kg/m)	IR Line	DFC
IR MAIN LINE: 52Kg/m	172mm	172mm
RUBBER PAD	6mm	10mm
SLEEPER DEPTH	210mm	210mm
BALLAST CUSHION	300mm	350mm
Total Depth (FL TO RL)	688mm	742mm

OWNER
DEDICATED FREIGHT CORRIDOR CORPORATION OF INDIA LTD.
(A GOVERNMENT OF INDIA ENTERPRISE)
PROJECT OFFICE(AMBALA UNIT): OLD RAILWAY COLONY (NEAR ANAND MARKET),AMBALA CANTT-133001.
CORPORATE IDENTITY NO. : U60232DL2006GGI155068

ENGINEER:
DB Engineering & Consulting GmbH
Deutsche Bahn Engineering & Consulting GmbH

CONTRACTOR:
GIL - TPL JV
GAR TATA

SUBMITTED BY

GIL - TPL JV

DATEDNAMESIGNATURE

PREPARED BY

CHECKED BY03.10.2024VIJAY PRATAP

APPROVED BY03.10.2024PARASURAM KOTYADA

APPROVED BY

DEUTSCHE BAHN ENGINEERING & CONSULTING GMBH

DATEDNAMESIGNATURE

Sr. DE./CHIEF ENGINEERSURESH K.YALANGI

CHIEF TRACK ENGINEERRAJ PAL SINGH

T.L.H.D. VIDJAK

STAMP

AAS-BUILT DRAWING
TR. Ref.....
ENGINEER Sign.:

EMPLOYER (DFCCIL):

DEDICATED FREIGHT CORRIDOR CORPORATION OF INDIA LTD.



AS BUILT DRAWING

TITLE
AS-BUILT PLAN AND PROFILE
FROM IR KM: 336.000 TO 336.500
FROM DFC KM: 1226.875 to 1227.375

DFCC APPR. NO. -
ENG. APPR. NO. -
DRG. NO. :301-2/AL/A/1298
SHEET NO. : 1 OF 1
DATE : 03.10.2024

STATUS
A

TR.

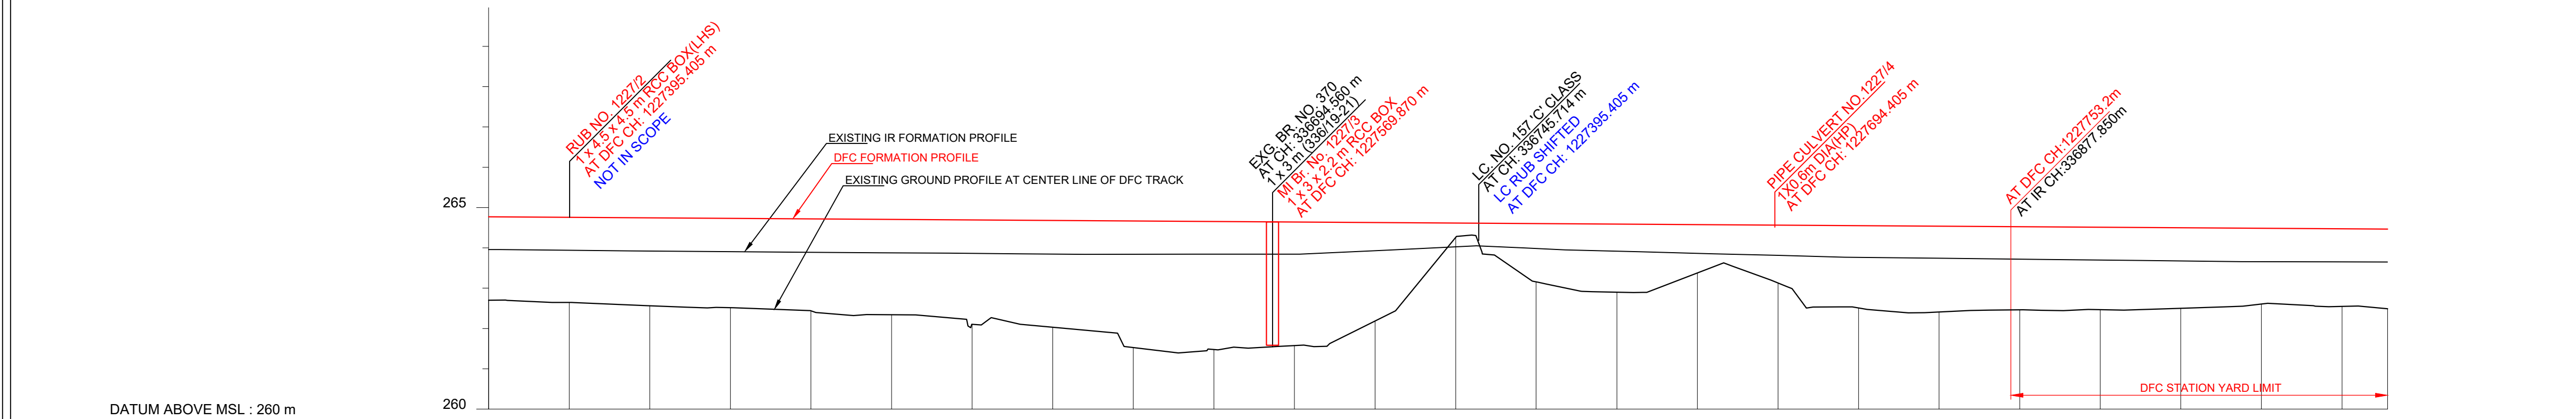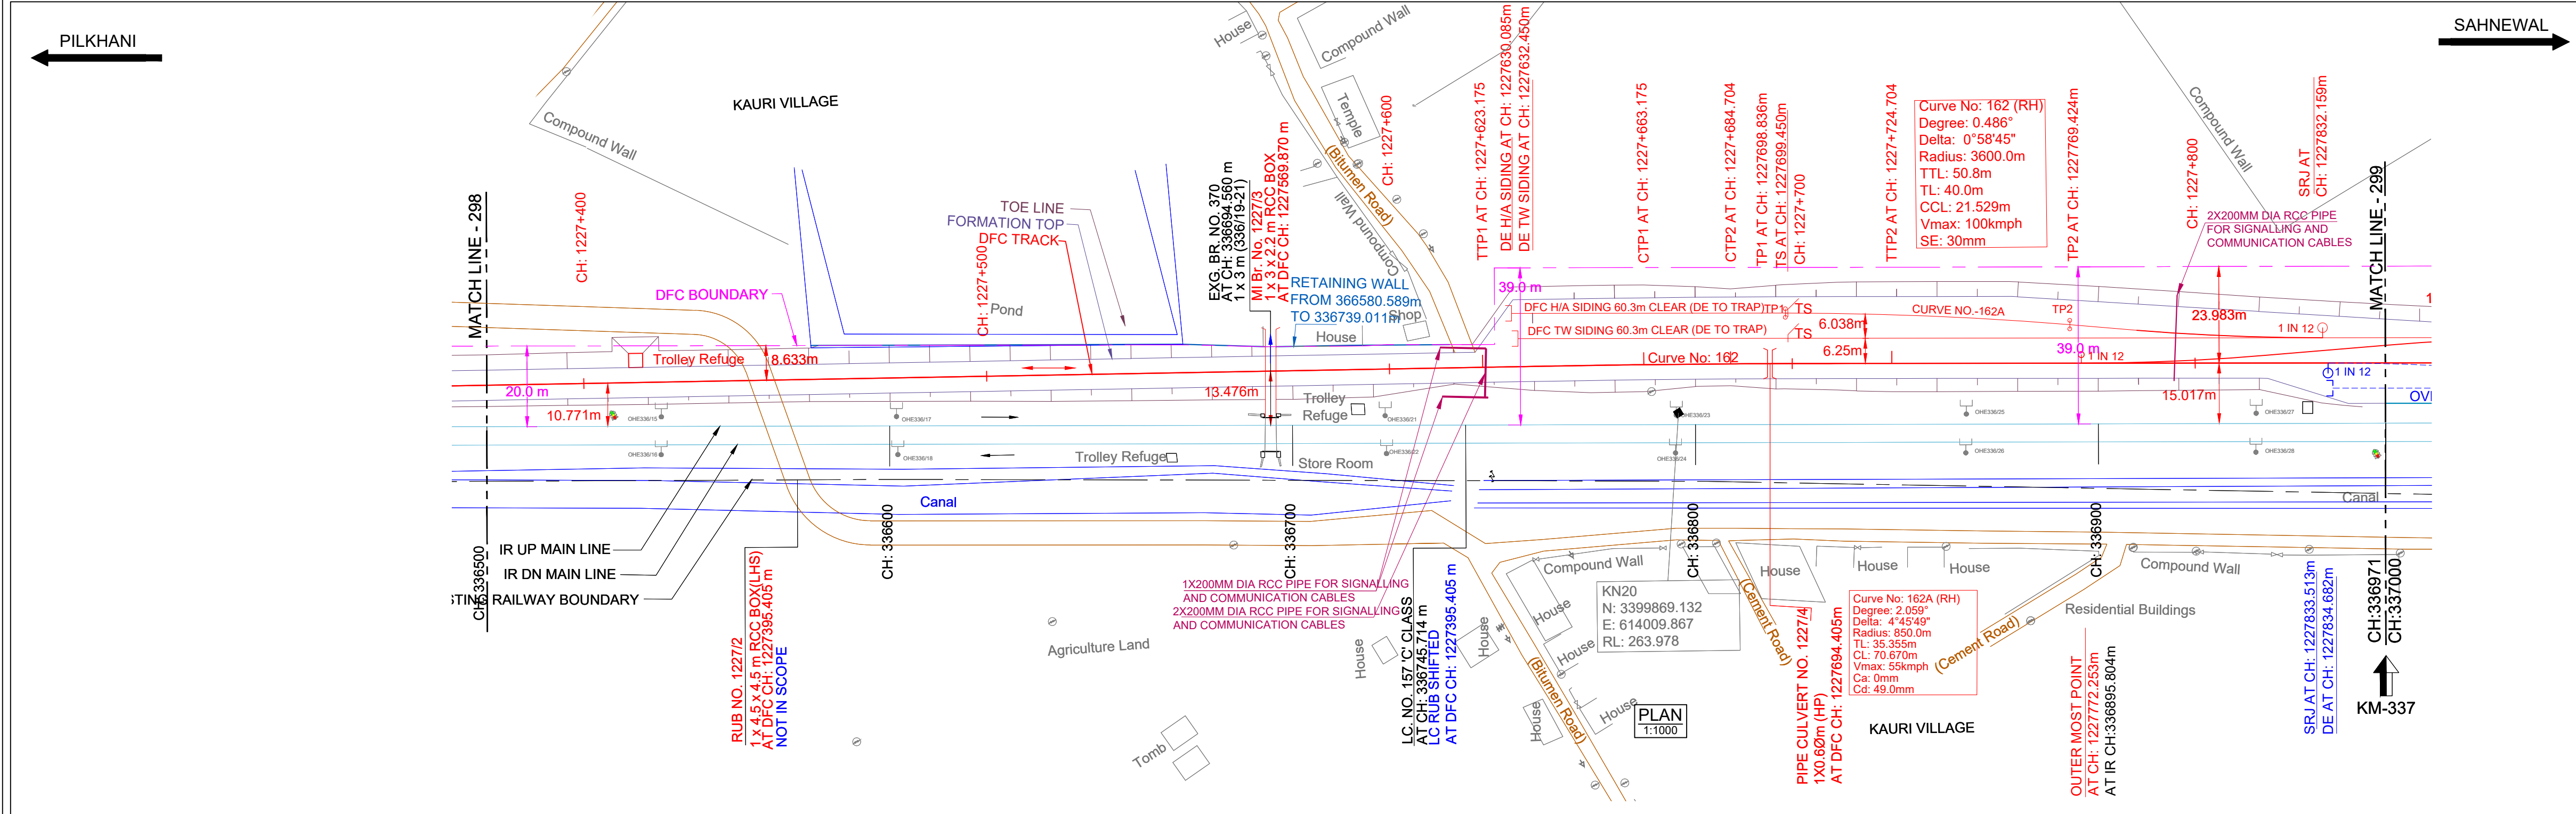

HORIZONTAL ALIGNMENT	L = 273.505m TL= 40m R =3600m TL= 40m L = 2876.804m																								
VERTICAL ALIGNMENT	L=1921.354 m 1 IN 1556.943 F																								
TRACK DISTANCE FROM EXISTING NEAREST IR UP MAIN LINE TO DFC MAIN LINE	10.271																								
HEIGHT OF BANKING(+) / DEPTH OF CUTTING(-) (PFL-GL)	+2.067																								
EXG GROUND LEVEL AT CENTER LINE OF DFC TRACK (GL)	262.702																								
EXG GROUND LEVEL AT TOE LOCATION OF DFC TRACK	262.773																								
DIFFERENCE BETWEEN DFC FORMATION LEVEL AND EXG.FORMATION LEVEL.(PFL-EFL)	0.810																								
DFC FORMATION LEVEL (PFL)	264.769																								
EXG. FORMATION LEVEL OF EXG IR UP MAIN LINE (EFL)	263.960																								
DIFFERENCE BETWEEN DFC RAIL LEVEL AND EXG. RAIL LEVEL (PRL - ERL)	0.851																								
DFC RAIL LEVEL (PRL)	265.483																								
EXG.RAIL LEVEL OF NEAREST IR UP MAIN LINE(ERL)	264.632																								
EQUIVALENT CHAINAGE ON DFC TRACK	-1227375.3																								
EXISTING IR CHAINAGE	336500.0																								

L - SECTION

NOTE:-

- DFCC WORKS ARE SHOWN IN RED.
- IR NEW WORKS ARE SHOWN IN VIOLET.
- ALL DIMENSIONS ARE SHOWN IN METRES.
- THIS DRAWING IS PREPARED BASED ON LATEST SURVEY DATA HELD ON APRIL-2022. GTS BENCH MARK OF 261.850M CONSIDERED ON TOP OF CANAL BRIDGE ABUTMENT AT DORAH VILLAGE ALONG THE NH1.
- DFC NEW CHAINAGE OF 1075.950M IS WITH REFERENCE TO THE IR KM OF 187.500KM END OF KM OF CP-303(SECTION P-3 PILKHANI END) AGAINST THE EXISTING DFC CHAINAGE. 116277.742M ISSUED VIDE LETTER NO. COM/DFCC/UM/SURVEY/2021-301-230116-011173 DT. 17.01.2023.
- BALLAST PROFILE HAS BEEN PROVIDED ACCORDING TO THE CLAUSE 1.11.3 OF STANDARD SCHEDULE OF DIMENSION(EASTERN CORRIDOR) & THE BALLAST CUSHION DIMENSION SHOWN IN 35CM ON GE-14 PARA 17. SPECIFICATIONS & RECOMMENDATIONS 2. TWO LAYER SYSTEM FIG.10.

REFERENCE DRAWINGS :-

- FOR KEY PLAN REFER DRAWING NO. 301-2/AL/0001
- FOR LEGEND AND ABBREVIATIONS REFER DRAWING NO. 301-2/AL/1000
- FOR TYPICAL SECTION OF BALLAST PROFILE (FL-RL) REFER DRG. NO. 301-2/TK/TFD/-004 (TR.1952)

03.10.2024SUBMISSION OF AS-BUILT DRAWINGFOR APPROVAL

REV. DATE REVISION DETAILS PURPOSE OF ISSUE

SCALE
HOR - 1:1000
VER - 1:100
SHEET SIZE : A1

LEGEND:

- IR TRACK
- DFCC TRACK
- DFCC FUTURE PROPOSALS
- STRUCTURE / BUILDING
- DFCC TOE LINE
- DFCC FORMATION
- RETAINING WALL
- ROAD
- STREAM, DRAIN, NALA, CANAL.
- FENCE
- POWER LINES
- TBM
- ELECTRIC POLE/OHE MAST
- IR RAILWAY BOUNDARY
- DFCC BOUNDARY

TRACK STRUCTURE

RAIL SECTION: 60Kg/m (UIC 60Kg/m)	Difference between FL- RL (Below Rail Seat)	
DFC LINE: 60Kg/m (UIC 60Kg/m)	IR Line	DFC
IR MAIN LINE: 52Kg/m	172mm	172mm
RUBBER PAD	6mm	10mm
SLEEPER DEPTH	210mm	210mm
BALLAST CUSHION	300mm	350mm
Total Depth (FL TO RL)	688mm	742mm

OWNER

DEDICATED FREIGHT CORRIDOR CORPORATION OF INDIA LTD.
(A GOVERNMENT OF INDIA ENTERPRISE)
PROJECT OFFICE(AMBALA UNIT): OLD RAILWAY COLONY (NEAR ANAND MARKET),AMBALA CANTT-133001.
CORPORATE IDENTITY NO. : U60232DL2006GGI155068

ENGINEER:

DB Engineering & Consulting GmbH
Deutsche Bahn Engineering & Consulting GmbH

CONTRACTOR:

GIL - TPL JV
GAR TATA

SUBMITTED BY	GIL - TPL JV		
	DATED	NAME	SIGNATURE
PREPARED BY			
CHECKED BY	03.10.2024	VIJAY PRATAP	
APPROVED BY	03.10.2024	PARASURAM KOTYADA	

APPROVED BY	DEUTSCHE BAHN ENGINEERING & CONSULTING GMBH		
	DATED	NAME	SIGNATURE
Sr. DE./CHIEF ENGINEER		SURESH K.YALANGI	
CHIEF TRACK ENGINEER		RAJ PAL SINGH	
T.L.		H.D. VIDJAK	

STAMP

A AS-BUILT DRAWING TR. Ref.:..... ENGINEER Sign.:.....

EMPLOYER (DFCCIL):

DEDICATED FREIGHT CORRIDOR CORPORATION OF INDIA LTD.



AS BUILT DRAWING

TITLE
AS-BUILT PLAN AND PROFILE
FROM IR KM: 336.500 TO 337.000
FROM DFC KM: 1227.375 TO 1227.847

DFCC APPR. NO. -
ENGG. APPR. NO. -
DRG. NO. :301-2/AL/A/1299
SHEET NO. :1 OF 1
DATE : 03.10.2024

STATUS
A

TR.

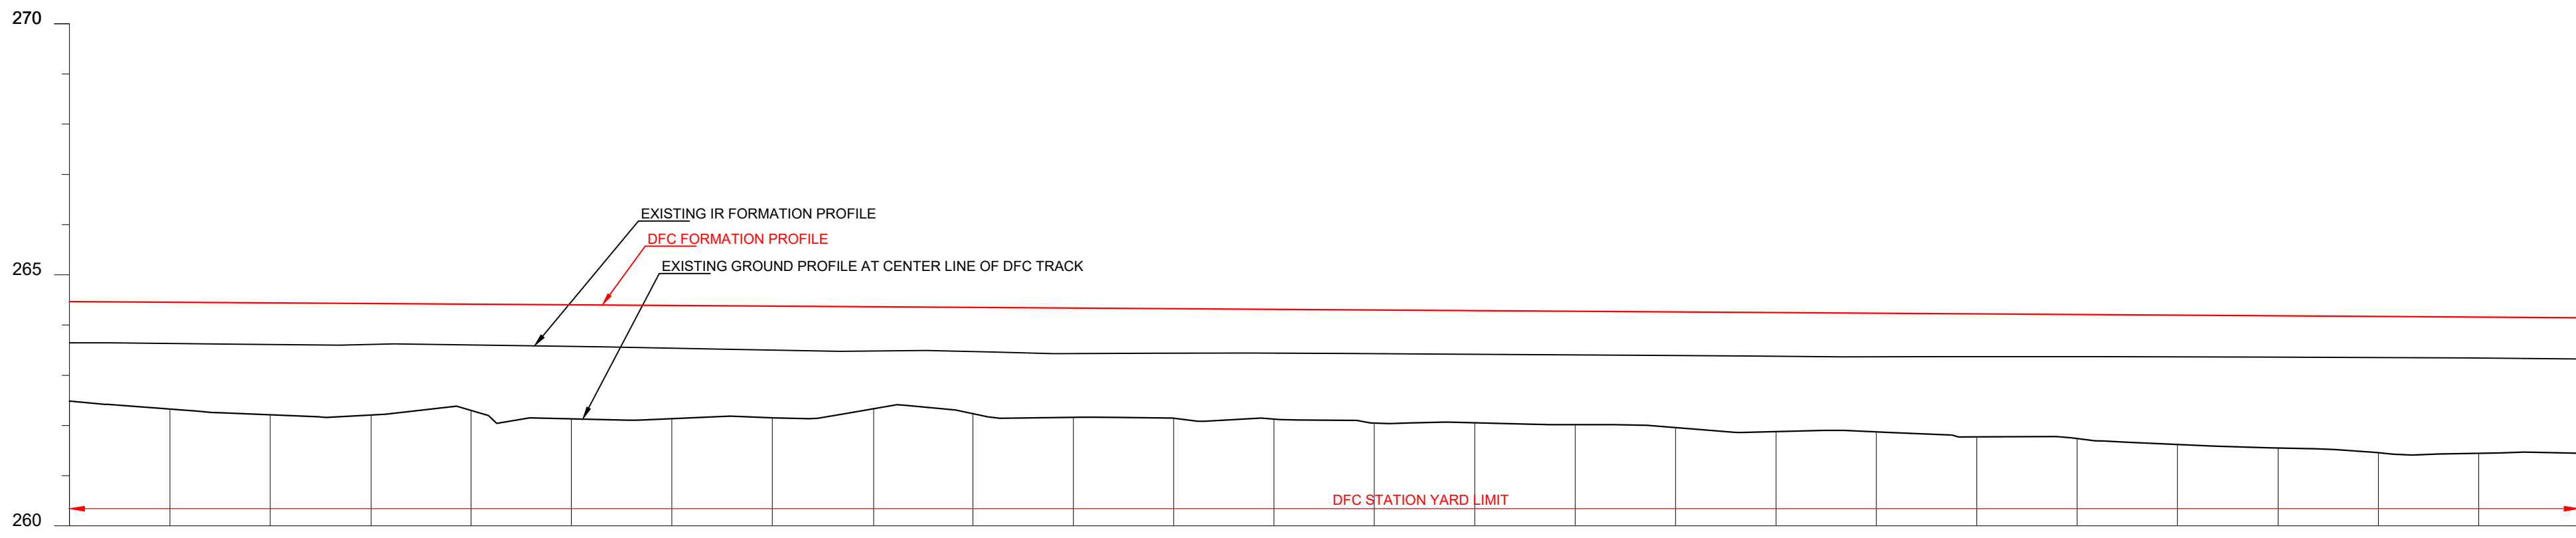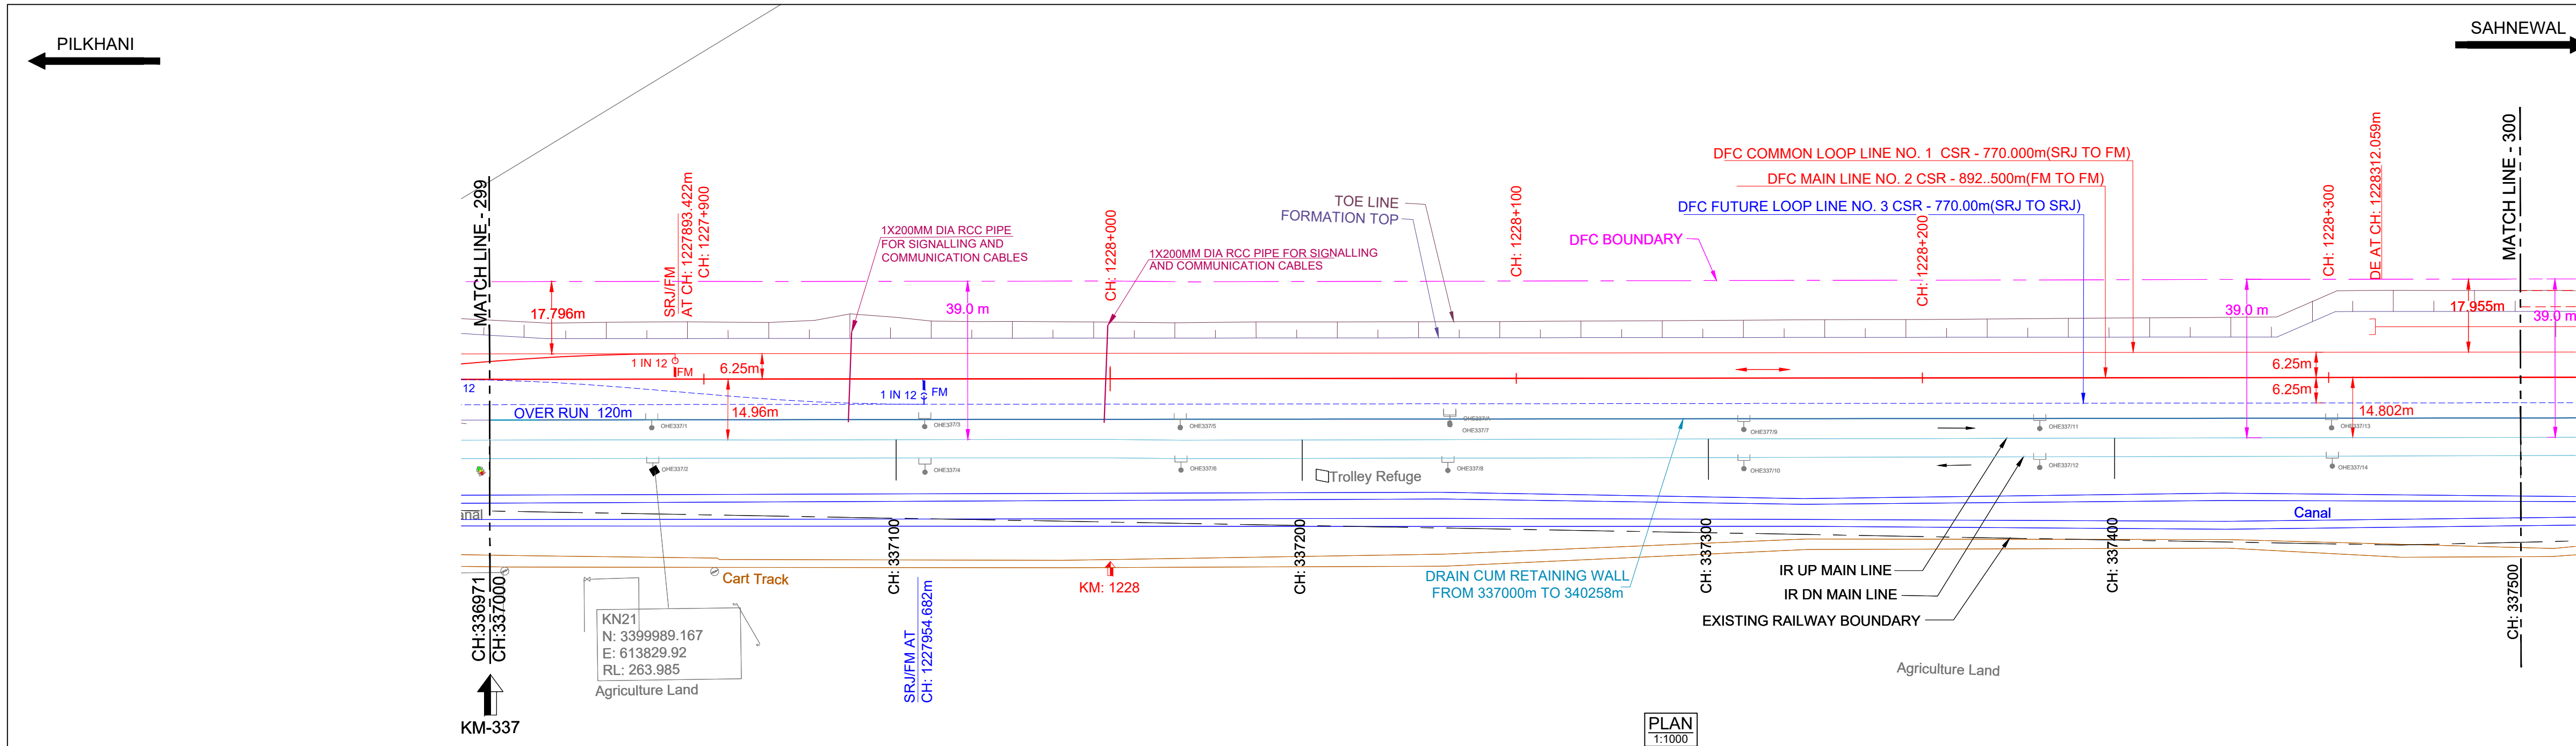


DATUM ABOVE MSL : 260 m

HORIZONTAL ALIGNMENT	L = 2876.804m																			
VERTICAL ALIGNMENT	L=1921.354 m 1 IN 1556.943 F																			
TRACK DISTANCE FROM EXISTING NEAREST IR UP MAIN LINE TO DFC MAIN LINE	14.907	14.907	14.952	14.942	14.967	14.975	14.955	14.950	14.952	15.037	15.150	15.111	15.095	15.072	15.025	14.989	14.973	14.956	14.938	14.783
HEIGHT OF BANKING(+) / DEPTH OF CUTTING(-) (PFL-GL)	+1.980	+1.980	+2.127	+2.229	+2.218	+2.114	+2.271	+2.255	+2.223	+2.032	+2.116	+2.174	+2.182	+2.187	+2.254	+2.235	+2.258	+2.303	+2.371	+2.704
EXG TRACK LEVEL AT CENTER LINE OF DFC TRACK (GL)	-262.487	-262.487	-262.327	-262.212	-262.210	-262.301	-262.131	-262.135	-262.154	-262.332	-262.235	-262.164	-262.143	-262.126	-262.046	-262.052	-262.016	-261.958	-261.877	-261.442
EXG GROUND LEVEL AT TOE LOCATION OF DFC TRACK	-262.511	-262.403	-262.327	-262.297	-262.323	-262.006	-261.705	-262.245	-262.246	-262.348	-262.313	-262.265	-262.245	-262.229	-262.175	-262.124	-262.070	-261.833	-261.606	-261.465
DIFFERENCE BETWEEN DFC FORMATION LEVEL AND EXG FORMATION LEVEL (PFL-EFL)	0.819	0.821	0.827	0.814	0.812	0.826	0.849	0.875	0.882	0.879	0.906	0.886	0.871	0.870	0.868	0.867	0.852	0.838	0.830	0.823
DFC FORMATION LEVEL (PFL)	-263.648	-263.633	-263.614	-263.614	-263.604	-263.576	-263.502	-263.439	-263.432	-263.441	-263.430	-263.419	-263.407	-263.394	-263.380	-263.369	-263.371	-263.372	-263.367	-263.322
EXG. FORMATION LEVEL OF EXG IR UP MAIN LINE (EFL)	-263.648	-263.633	-263.614	-263.614	-263.604	-263.576	-263.502	-263.439	-263.432	-263.441	-263.430	-263.419	-263.407	-263.394	-263.380	-263.369	-263.371	-263.372	-263.367	-263.322
DIFFERENCE BETWEEN DFC RAIL LEVEL AND EXG. RAIL LEVEL (PRL - ERL)	0.860	0.862	0.868	0.855	0.853	0.867	0.890	0.928	0.928	0.912	0.911	0.909	0.908	0.908	0.910	0.908	0.893	0.879	0.871	0.864
DFC RAIL LEVEL (PRL)	-265.180	-265.167	-265.154	-265.141	-265.129	-265.116	-265.090	-265.064	-265.051	-265.026	-265.013	-265.000	-264.987	-264.974	-264.962	-264.949	-264.936	-264.923	-264.910	-264.897
EXG. RAIL LEVEL OF NEAREST IR UP MAIN LINE (ERL)	-264.320	-264.305	-264.286	-264.286	-264.276	-264.248	-264.174	-264.154	-264.144	-264.104	-264.102	-264.091	-264.079	-264.066	-264.052	-264.041	-264.033	-264.026	-264.017	-263.984
EQUIVALENT CHAINAGE ON DFC TRACK	-1227896.6	-1227896.6	-1227896.6	-1227896.6	-1227906.7	-1227926.6	-1227966.6	-1228006.6	-1228026.6	-1228046.6	-1228066.6	-1228086.6	-1228106.6	-1228126.6	-1228146.6	-1228166.6	-1228186.6	-1228206.6	-1228226.6	-1228246.6
EXISTING IR CHAINAGE	337000.0	337020.0	337040.0	337060.0	337080.0	337100.0	337120.0	337140.0	337160.0	337180.0	337200.0	337220.0	337240.0	337260.0	337280.0	337300.0	337320.0	337340.0	337360.0	337380.0

L - SECTION

SAHNEWAL

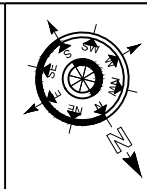

NOTE:-

1. DFC WORKS ARE SHOWN IN RED.
2. IR NEW WORKS ARE SHOWN IN VIOLET.
3. ALL DIMENSIONS ARE SHOWN IN METRES.
4. THIS DRAWING IS PREPARED BASED ON LATEST SURVEY DATA HELD ON APRIL-2022. GTS BENCH MARK OF 261.850M CONSIDERED ON TOP OF CANAL BRIDGE ABUTMENT AT DORAHA VILLAGE ALONG THE NH1.
5. DFC NEW CHAINAGE OF 1075.950M IS WITH REFERENCE TO THE IR KM OF 187.500KM END OF KM OF CP-303(SECTION P-3 PILKHANI END) AGAINST THE EXISTING DFC CHAINAGE. 116277.742M ISSUED VIDE LETTER NO. COM/DFC/UM/SURVEY/2021-301-230116-011173 DT. 17.01.2023.
6. BALLAST PROFILE HAS BEEN PROVIDED ACCORDING TO THE CLAUSE 1.11.3 OF STANDARD SCHEDULE OF DIMENSION(EASTERN CORRIDOR) & THE BALLAST CUSHION DIMENSION SHOWN IN 35CM ON GE-14 PARA 17. SPECIFICATIONS & RECOMMENDATIONS 2. TWO LAYER SYSTEM FIG.10.

REFERENCE DRAWINGS :-

1. FOR KEY PLAN REFER DRAWING NO. 301-2/AL/0001
2. FOR LEGEND AND ABBREVIATIONS REFER DRAWING NO. 301-2/AL/1000
3. FOR TYPICAL SECTION OF BALLAST PROFILE (FL-RL) REFER DRG. NO. 301-2/TK/TFD/-004 (TR. 1952)

0	03.10.2024	SUBMISSION OF AS-BUILT DRAWING	FOR APPROVAL
REV.	DATE	REVISION DETAILS	PURPOSE OF ISSUE

LEGEND:

SCALE

HOR - 1:1000

VER - 1:100

SHEET SIZE : A1

IR TRACK

DFCC TRACK

DFCC FUTURE PROPOSALS

STRUCTURE / BUILDING

DFCC TOE LINE

DFCC FORMATION

RETAINING WALL

ROAD

STREAM, DRAIN, NALA, CANAL

FENCE


POWER LINES

TBM

ELECTRIC POLE/OHE MAST

IR RAILWAY BOUNDARY

DFCC BOUNDARY

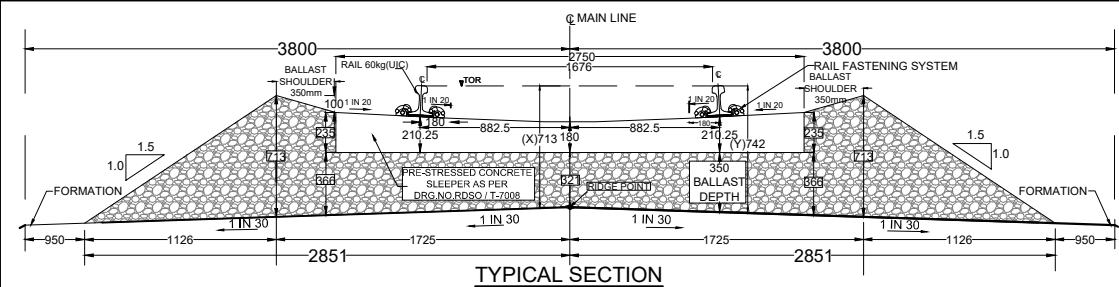

TRACK STRUCTURE		
RAIL SECTION: 60Kg/m (UIC 60Kg/m) DFC LINE: 60Kg/m (UIC 60Kg/m) IR MAIN LINE: 52Kg/m	Difference between FL- RL (Below Rail Seat)	
	IR Line	DFC
RUBBER PAD	172mm	172mm
SLEEPER DEPTH	210mm	210mm
BALLAST CUSHION	300mm	350mm
Total Depth (FL TO RL)	688mm	742mm

OWNER

DEDICATED FREIGHT CORRIDOR CORPORATION OF INDIA LTD.

(A GOVERNMENT OF INDIA ENTERPRISE)

PROJECT OFFICE (AMBALA UNIT): OLD RAILWAY COLONY (NEAR ANAND MARKET), AMBALA CANTT-133001.

CORPORATE IDENTITY NO. : U60232DL2006GGI155068

ENGINEER:

DB Engineering & Consulting GmbH

Deutsche Bahn Engineering & Consulting GmbH

CONTRACTOR:

GIL - TPL JV

GAR TATA


SUBMITTED BY	GIL - TPL JV		
	DATED	NAME	SIGNATURE
PREPARED BY			
CHECKED BY	03.10.2024	VIJAY PRATAP	
APPROVED BY	03.10.2024	PARASURAM KOTYADA	

APPROVED BY	DEUTSCHE BAHN ENGINEERING & CONSULTING GMBH		
	DATED	NAME	SIGNATURE
Sr. DE./CHIEF ENGINEER		SURESH K.YALANGI	
CHIEF TRACK ENGINEER		RAJ PAL SINGH	
T.L.		H.D. VIDJAK	

STAMP	A AS-BUILT DRAWING TR. Ref.:..... ENGINEER Sign.:.....		
EMPLOYER (DFCCIL):	DEDICATED FREIGHT CORRIDOR CORPORATION OF INDIA LTD.		

AS BUILT DRAWING			
TITLE		DFCC APPR. NO. -	
AS-BUILT PLAN AND PROFILE		ENGG. APPR. NO. -	
FROM IR KM: 337.000 TO 337.500		DRG. NO. - 301-2/AL/A/1300	
FROM DFC KM: 1227.847 to 1228.347		SHEET NO. : 1 OF 1	
		DATE : 03.10.2024	
		STATUS	
		A	

TR.

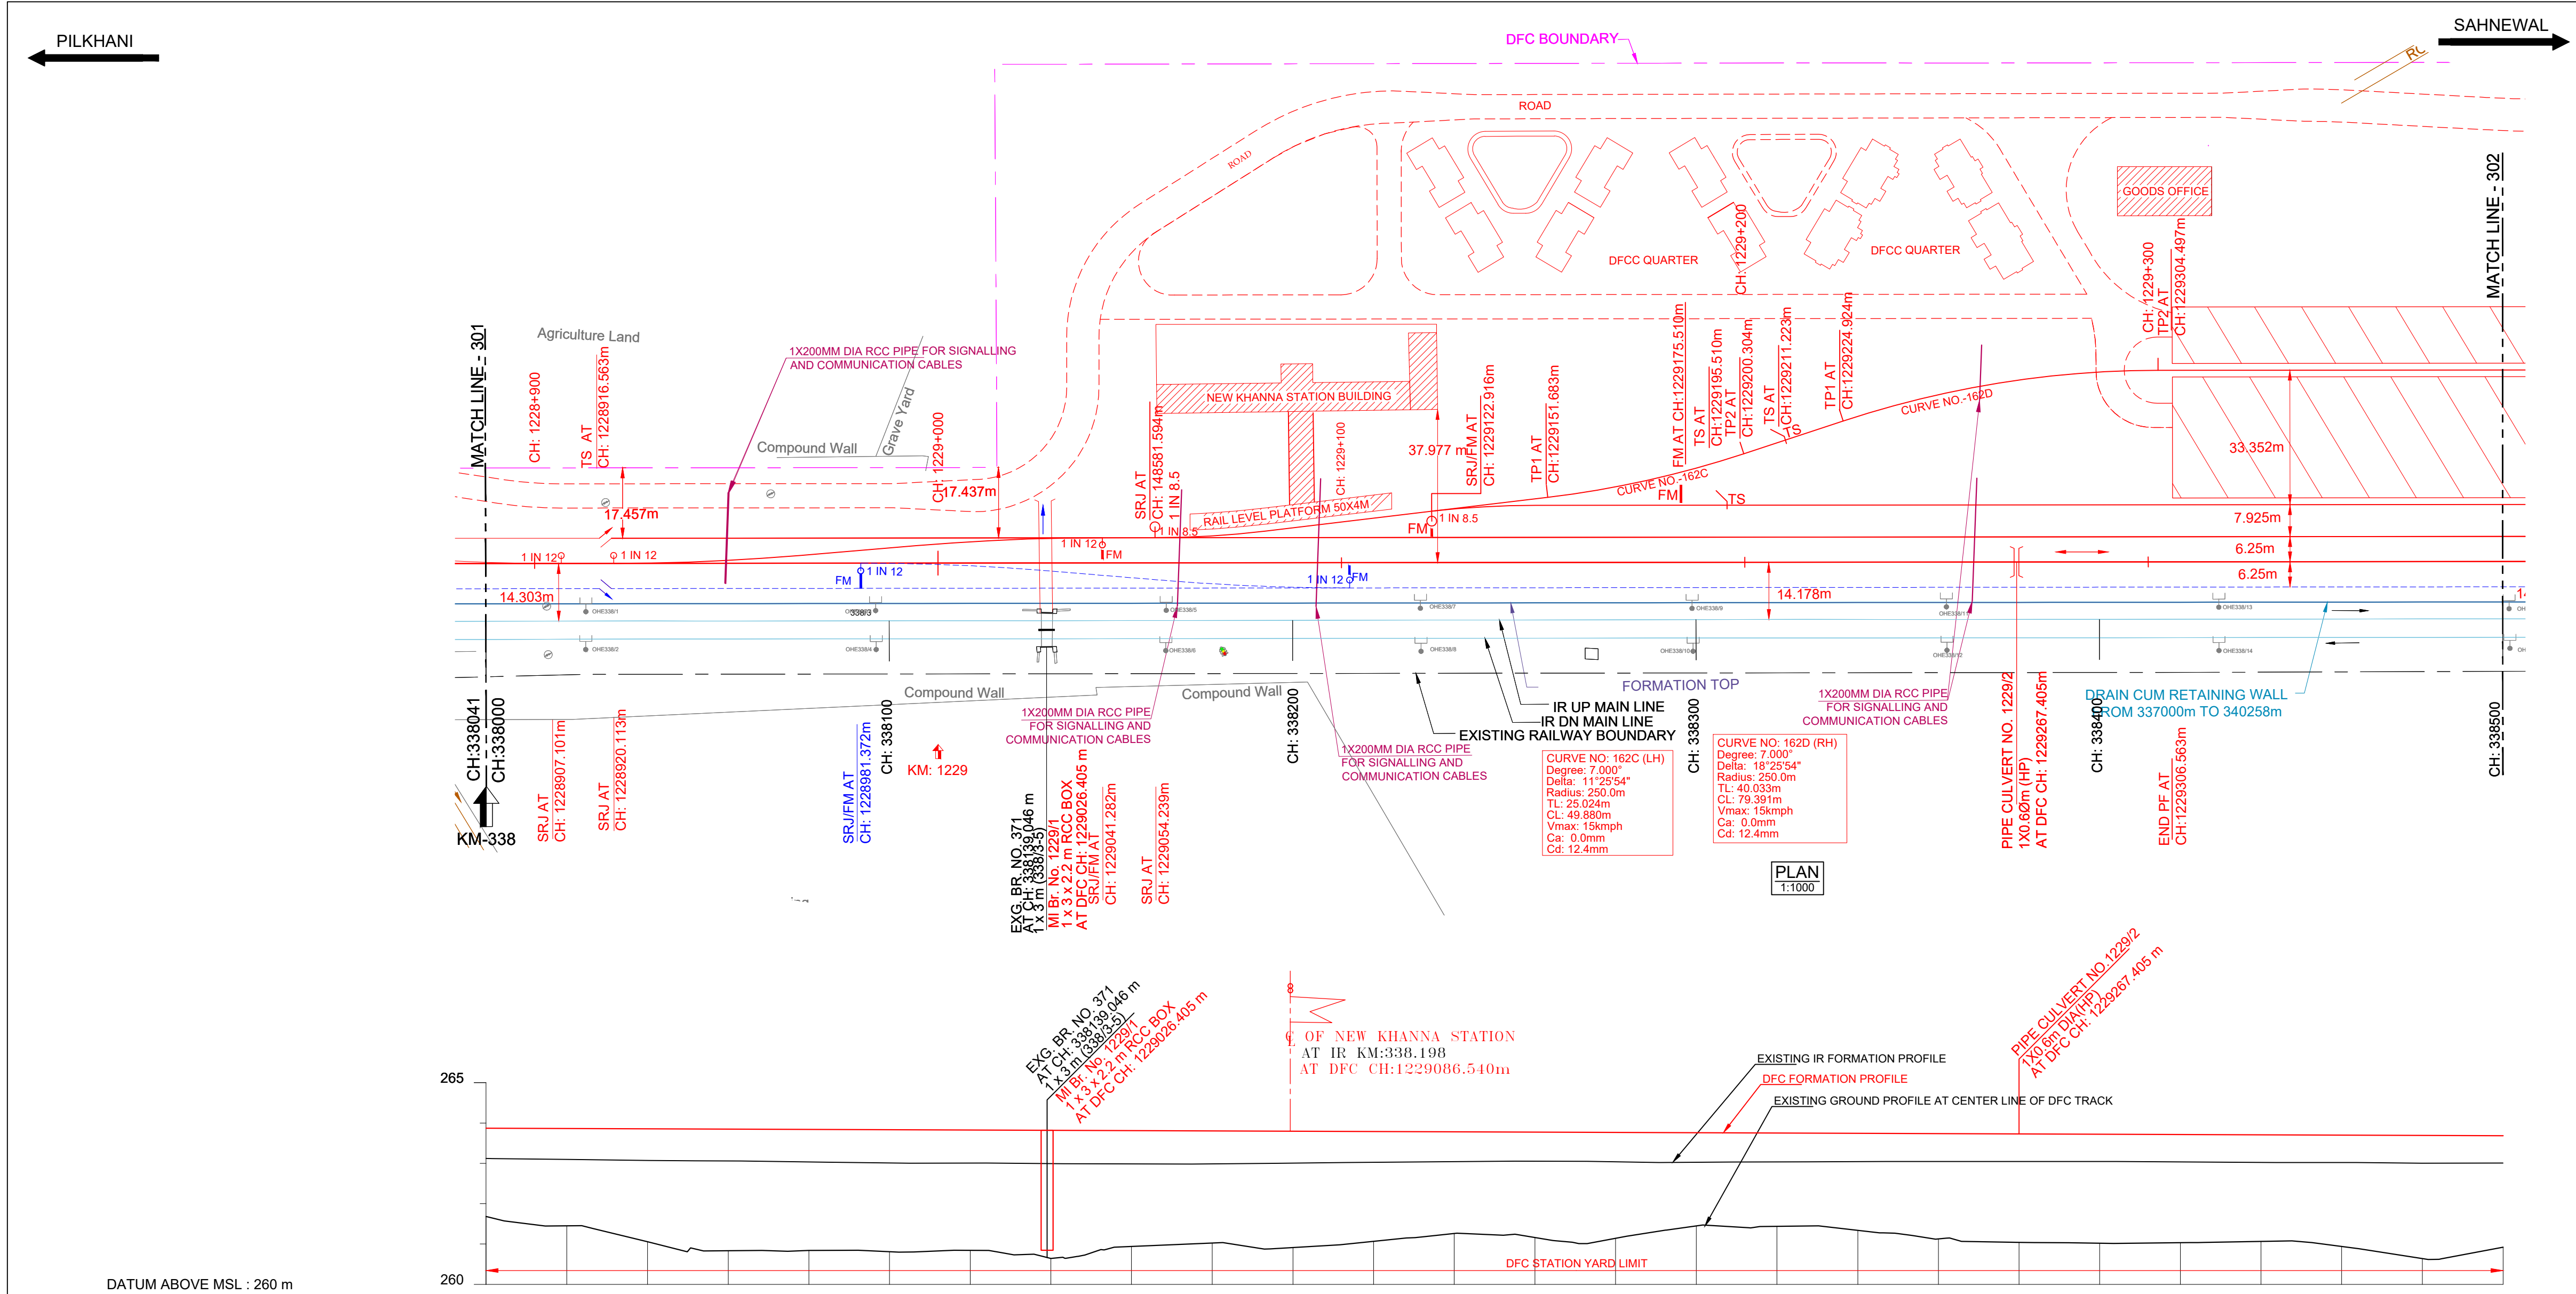

HORIZONTAL ALIGNMENT		L = 2876.804m																									
VERTICAL ALIGNMENT		L=1922.051 m 1 IN 2687.971 F																									
TRACK DISTANCE FROM EXISTING NEAREST IR UP MAIN LINE TO DFC MAIN LINE		14.320	14.320																								
HEIGHT OF BANKING(+) / DEPTH OF CUTTING(-) (PFL-GL)		+2.187	+2.187																								
EXG GROUND LEVEL AT CENTER LINE OF DFC TRACK (GL)		-261.684	-261.684																								
EXG GROUND LEVEL AT TOE LOCATION OF DFC TRACK		-261.802	-261.802																								
DIFFERENCE BETWEEN DFC FORMATION LEVEL AND EXG.FORMATION LEVEL (PFL-EFL)		0.751	0.751																								
DFC FORMATION LEVEL (PFL)		-263.871	-263.871																								
EXG. FORMATION LEVEL OF EXG IR UP MAIN LINE (EFL)		-263.121	-263.121																								
DIFFERENCE BETWEEN DFC RAIL LEVEL AND EXG. RAIL LEVEL (PRL - ERL)		0.792	0.792																								
DFC RAIL LEVEL (PRL)		-264.584	-264.584																								
EXG.RAIL LEVEL OF NEAREST IR UP MAIN LINE(ERL)		-263.793	-263.793																								
EQUIVALENT CHAINAGE ON DFC TRACK		-1228887.2	-1228887.2																								
EXISTING IR CHAINAGE		338040.6	338040.6																								

L - SECTION

NOTE:-

- DFCC WORKS ARE SHOWN IN RED.
- IR NEW WORKS ARE SHOWN IN VIOLET.
- ALL DIMENSIONS ARE SHOWN IN METRES.
- THIS DRAWING IS PREPARED BASED ON LATEST SURVEY DATA HELD ON APRIL-2022. GTS BENCH MARK OF 261.850M CONSIDERED ON TOP OF CANAL BRIDGE ABUTMENT AT DORAHA VILLAGE ALONG THE NH1.
- DFC NEW CHAINAGE OF 1075.950M IS WITH REFERENCE TO THE IR KM OF 187.500KM END OF KM OF CP-303(SECTION P-3 PILKHANI END) AGAINST THE EXISTING DFC CHAINAGE. 116277.742M ISSUED VIDE LETTER NO. COM/DFCC/MB/SURVEY/2021-301-2301/16-01/173.DT. 17.01.2023.
- BALLAST PROFILE HAS BEEN PROVIDED ACCORDING TO THE CLAUSE 1.11.3 OF STANDARD SCHEDULE OF DIMENSION(EASTERN CORRIDOR) & THE BALLAST CUSHION DIMENSION SHOWN IN 35CM ON GE-14 PARA 17. SPECIFICATIONS & RECOMMENDATIONS 2. TWO LAYER SYSTEM FIG.10.

REFERENCE DRAWINGS :-

- FOR KEY PLAN REFER DRAWING NO. 301-2/AL/0001
- FOR LEGEND AND ABBREVIATIONS REFER DRAWING NO. 301-2/AL/1000
- FOR TYPICAL SECTION OF BALLAST PROFILE (FL-RL) REFER DRG. NO. 301-2/TK/TFD/-004 (TR.1952)

0	03.10.2024	SUBMISSION OF AS-BUILT DRAWING	FOR APPROVAL
REV.	DATE	REVISION DETAILS	PURPOSE OF ISSUE

SCALE
HOR - 1:1000
VER - 1:100
SHEET SIZE - A1

LEGEND:

- IR TRACK
- DFCC TRACK
- DFCC FUTURE PROPOSALS
- STRUCTURE / BUILDING
- DFCC TOE LINE
- DFCC FORMATION
- RETAINING WALL
- ROAD
- STREAM, DRAIN, NALA, CANAL.
- FENCE
- POWER LINES
- TBM
- ELECTRIC POLE/OHE MAST
- IR RAILWAY BOUNDARY
- DFCC BOUNDARY

TRACK STRUCTURE		
RAIL SECTION: 60Kg/m (UIC 60Kg/m) DFC LINE: 60Kg/m (UIC 60Kg/m) IR MAIN LINE: 52Kg/m	Difference between FL- RL (Below Rail Seat)	
	IR Line	DFC
RUBBER PAD	172mm	172mm
SLEEPER DEPTH	6mm	10mm
BALLAST CUSHION	210mm	210mm
	300mm	350mm
Total Depth (FL TO RL)	688mm	742mm

OWNER

DEDICATED FREIGHT CORRIDOR CORPORATION OF INDIA LTD.
(A GOVERNMENT OF INDIA ENTERPRISE)
PROJECT OFFICE(AMBALA UNIT): OLD RAILWAY COLONY (NEAR ANAND MARKET),AMBALA CANTT-133001.
CORPORATE IDENTITY NO. : U60232DL20060G01155068

ENGINEER:

DB Engineering & Consulting GmbH
Deutsche Bahn Engineering & Consulting GmbH

CONTRACTOR:
GIL - TPL JV

SUBMITTED BY	GIL - TPL JV		
	DATED	NAME	SIGNATURE
PREPARED BY			
CHECKED BY	03.10.2024	VIJAY PRATAP	
APPROVED BY	03.10.2024	PARASURAM KOTYADA	
APPROVED BY	DEUTSCHE BAHN ENGINEERING & CONSULTING GMBH		
	DATED	NAME	SIGNATURE
Sr. DE./CHIEF ENGINEER		SURESH K.YALANGI	
CHIEF TRACK ENGINEER		RAJ PAL SINGH	
T.L.		H.D. VIDJAK	

STAMP

EMPLOYER (DFCCIL): DEDICATED FREIGHT CORRIDOR CORPORATION OF INDIA LTD.


AS BUILT DRAWING

TITLE
AS-BUILT PLAN AND PROFILE
FROM IR KM: 338.000 TO 338.500
FROM DFC KM: 1228.887 to 1229.387

DFCC APPR. NO. -
ENGG. APPR. NO. -
DRG. NO. -301-2/AL/A/1302
SHEET NO.: 1 OF 1
DATE: 03.10.2024


STATUS
A

TR.

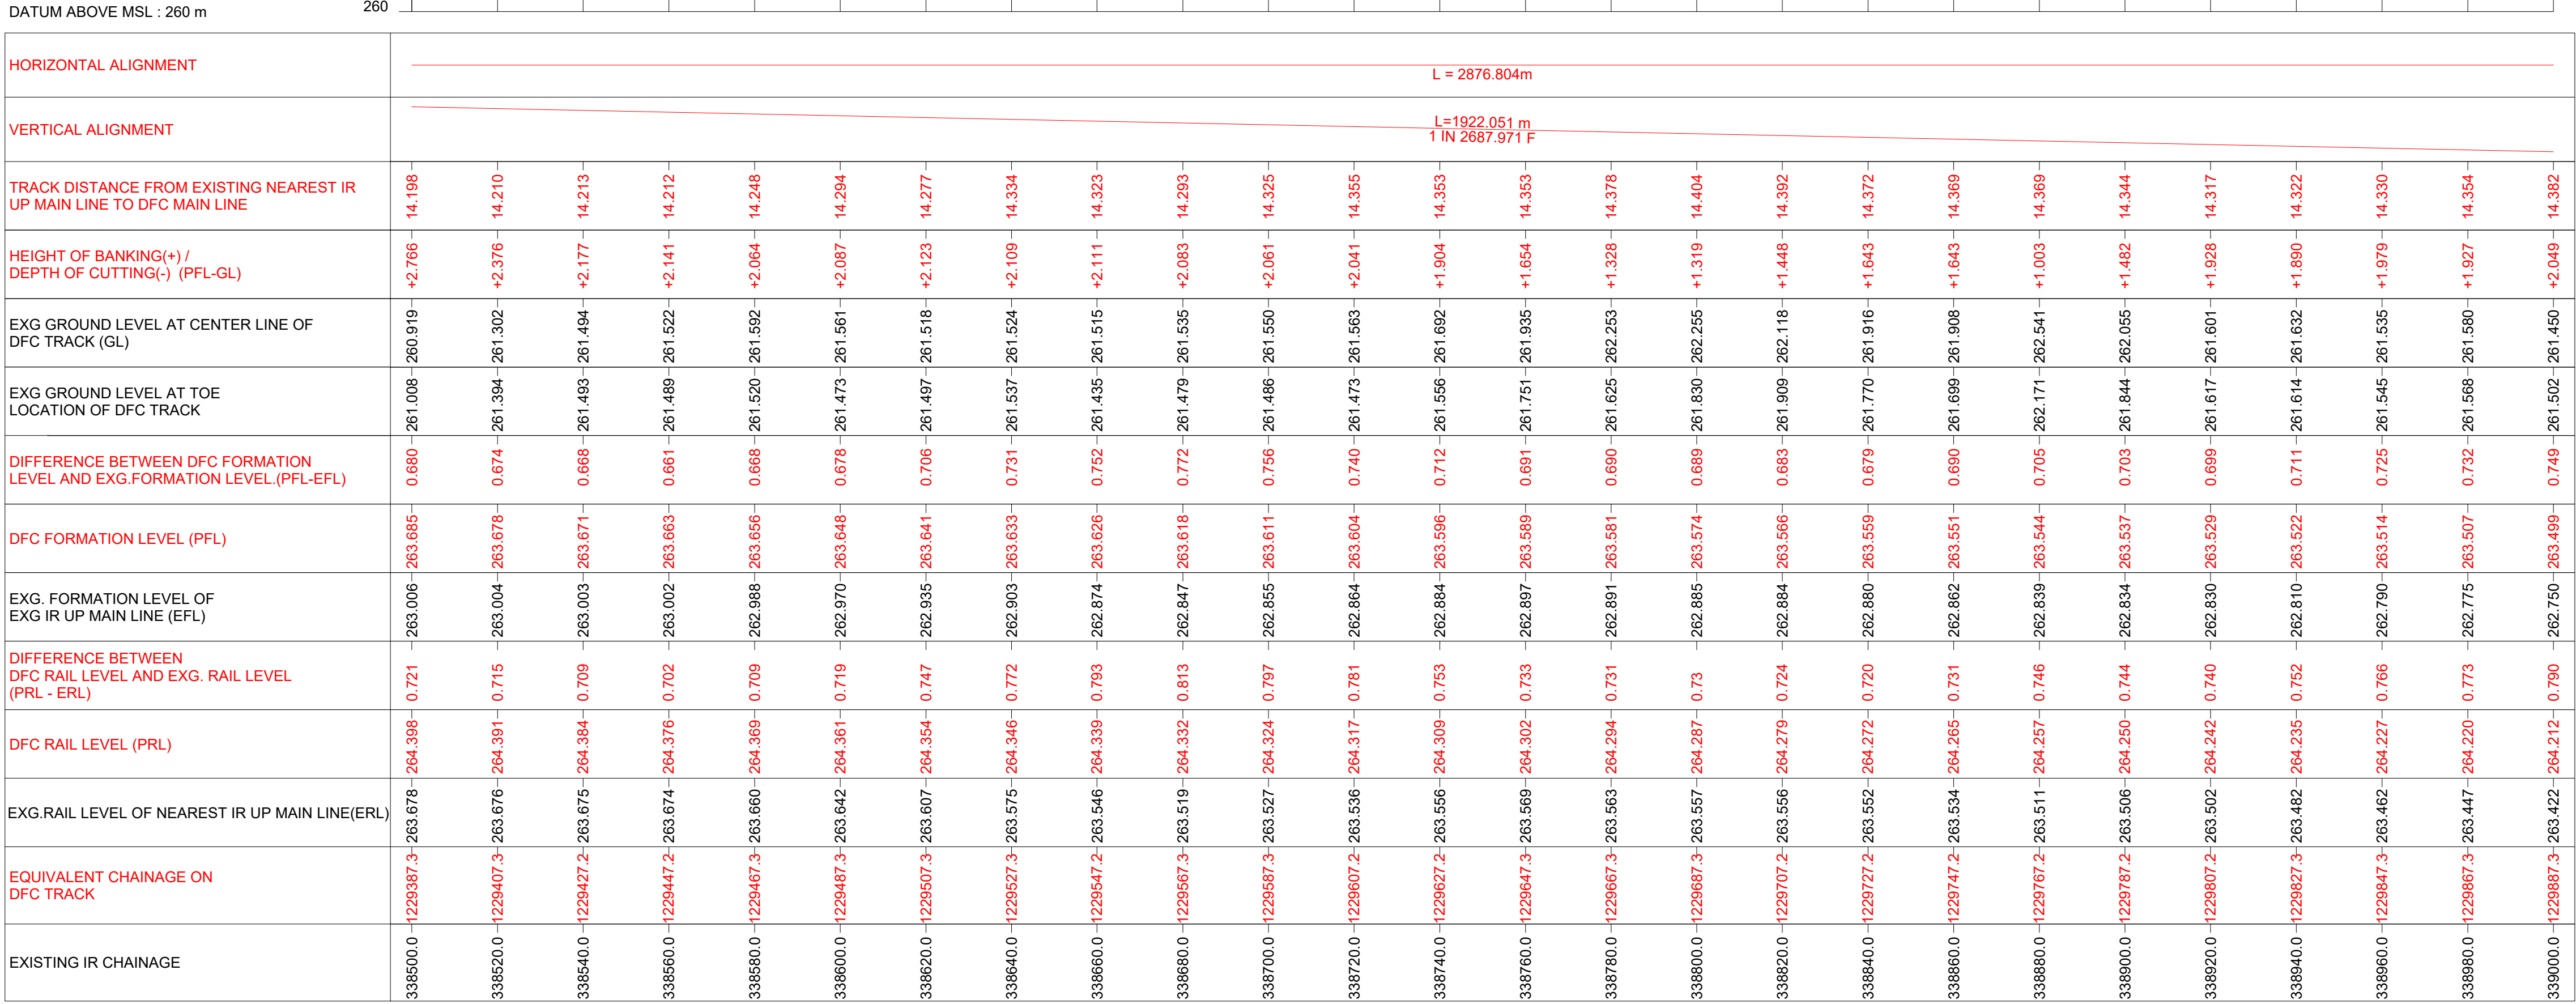

AS BUILT DRAWING	
TITLE AS-BUILT PLAN AND PROFILE FROM IR KM: 338.500 TO 339.000 FROM DFC KM: 1229.387 to 1229.887	DFCC APPR. NO. -
	ENGG. APPR. NO. -
	DRG. NO. -301-2/AL/A/1303
	SHEET NO. : 1 OF 1
DATE : 03.10.2024	
STATUS A	

TR.

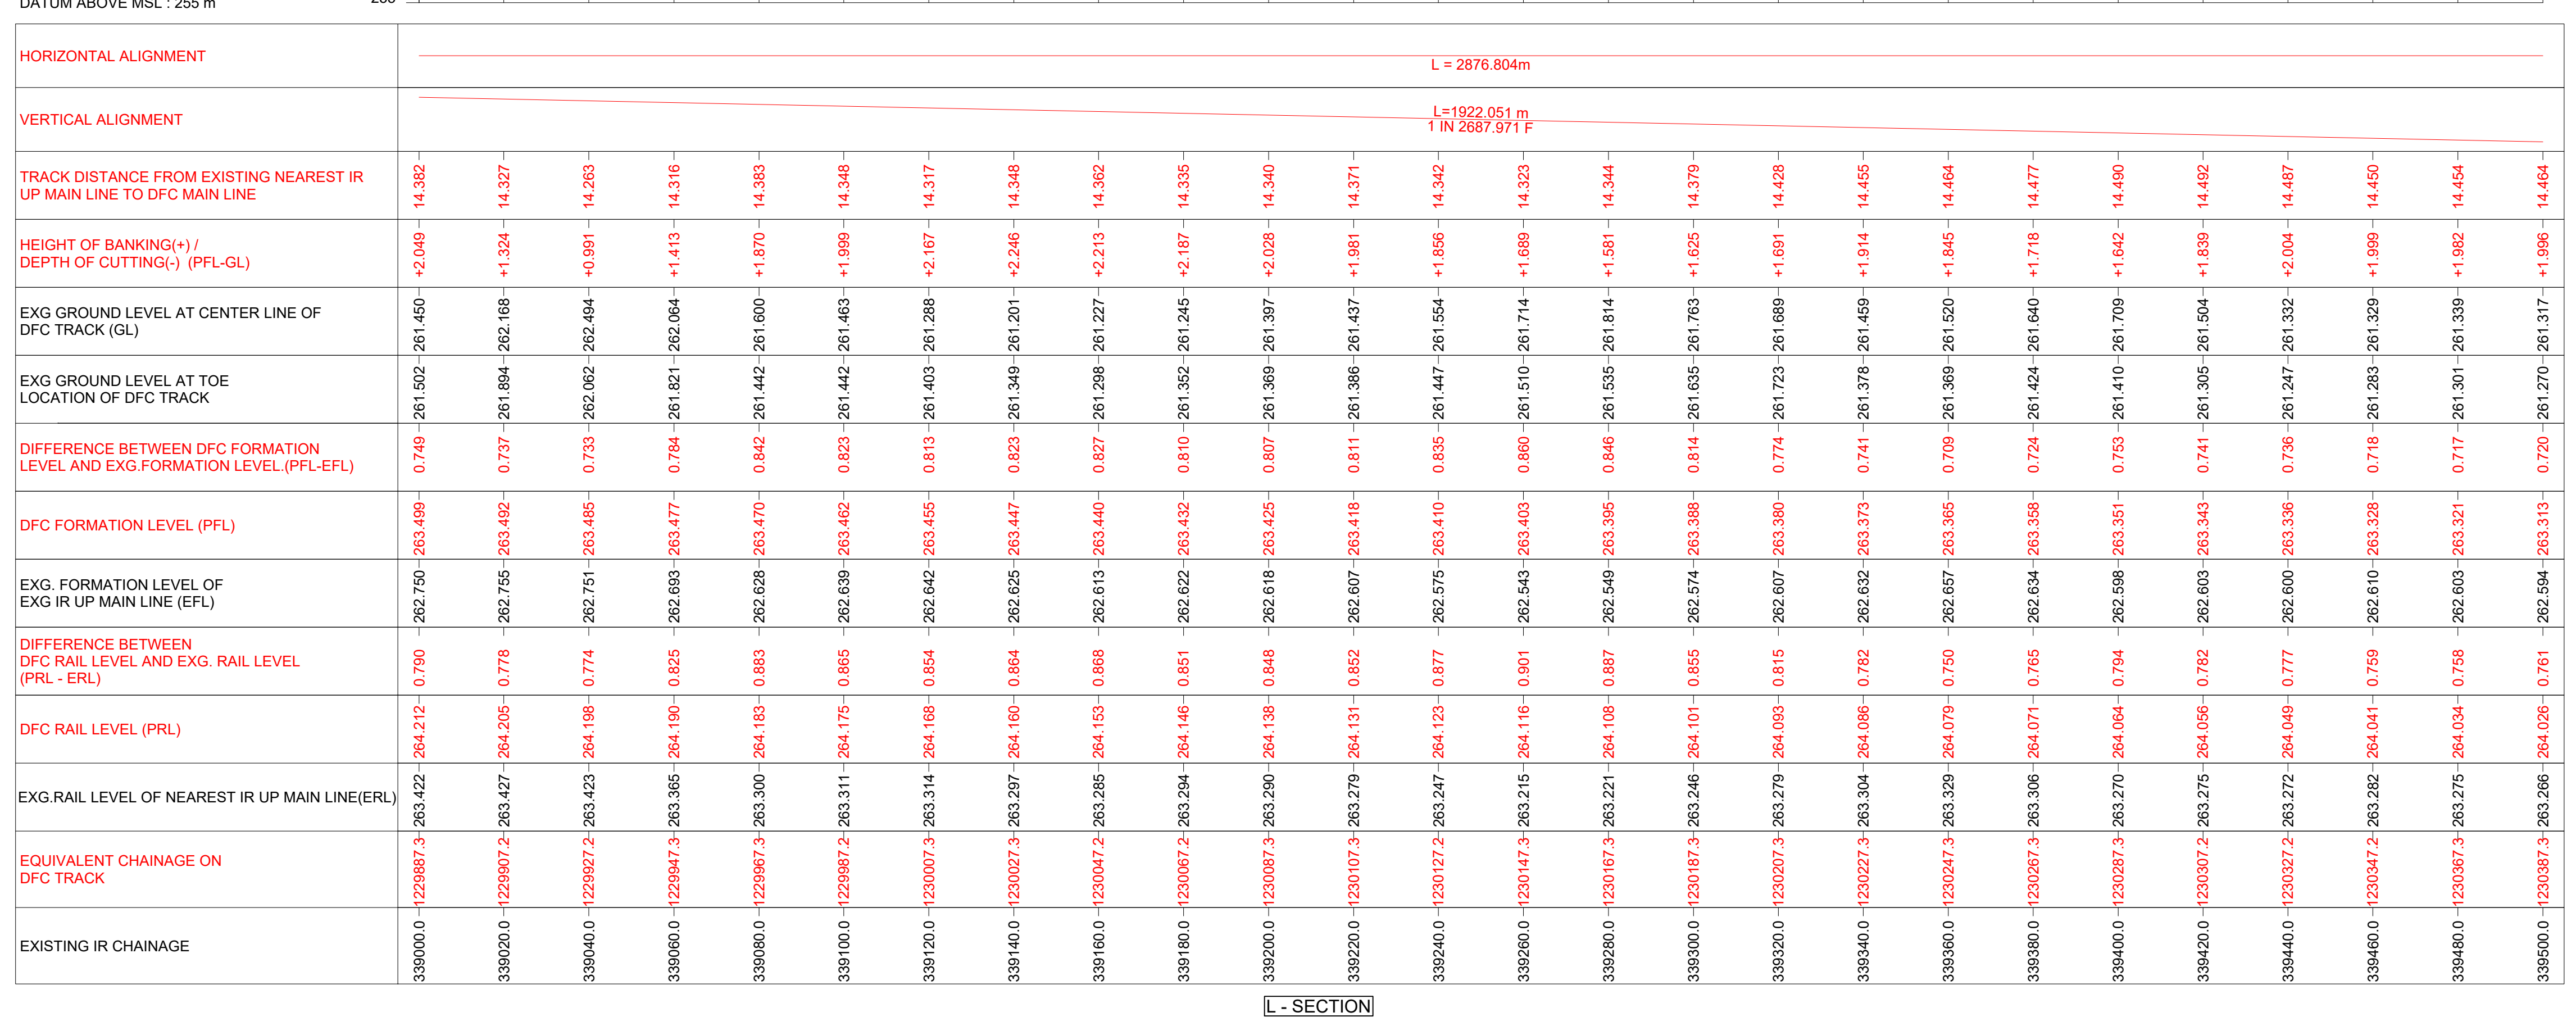

1. DFC WORKS ARE SHOWN IN RED.

2. IR NEW WORKS ARE SHOWN IN VIOLET.

3. ALL DIMENSIONS ARE SHOWN IN METRES.

4. THIS DRAWING IS PREPARED BASED ON LATEST SURVEY DATA HELD ON APRIL-2022, GTS BENCH MARK OF 261.850M CONSIDERED ON TOP OF CANAL BRIDGE ABUTMENT AT DORAHA VILLAGE ALONG THE NH1.

5. DFC NEW CHAINAGE OF 1075.950M IS WITH REFERENCE TO THE IR KM OF 187.500KM END OF KM OF CP-303(SECTION P-3 PILKHANI END) AGAINST THE EXISTING DFC CHAINAGE, 116277.742M ISSUED VIDE LETTER NO. CGMD/COL/JMS/SURVEY/2021-301-2301/16-11/173 DT. 17.01.2023

6. BALLAST PROFILE HAS BEEN PROVIDED ACCORDING TO THE CLAUSE 1.11.3 OF STANDARD SCHEDULE OF DIMENSION(EASTERN CORRIDOR) & THE BALLAST CUSHION DIMENSION SHOWN IN 35CM ON GE-14 PARA 17. SPECIFICATIONS & RECOMMENDATIONS 2. TWO LAYER SYSTEM FIG.10.

REFERENCE DRAWINGS :-

1. FOR KEY PLAN REFER DRAWING NO. 301-2/AL/0001

2. FOR LEGEND AND ABBREVIATIONS REFER DRAWING NO. 301-2/AL/1000

3. FOR TYPICAL SECTION OF BALLAST PROFILE (FL-RL) REFER DRG. NO. 301-2/TK/TFDI-004 (TR.1952)

0

03.10.2024

DATE

SUBMISSION OF AS-BUILT DRAWING

REVISION DETAILS

FOR APPROVAL

PURPOSE OF ISSUE

SCALE

HOR - 1:1000

VER - 1:100

SHEET SIZE : A1

LEGEND:

IR TRACK

DFCC TRACK

DFCC FUTURE PROPOSALS

STRUCTURE / BUILDING

DFCC TOE LINE

DFCC FORMATION

RETAINING WALL

ROAD

STREAM, DRAIN, NALA, CANAL.

POWER LINES

TBM

ELECTRIC POLE/OHE MAST

IR RAILWAY BOUNDARY

DFCC BOUNDARY

3800

3800


3800

3800

3800

3800

3800</

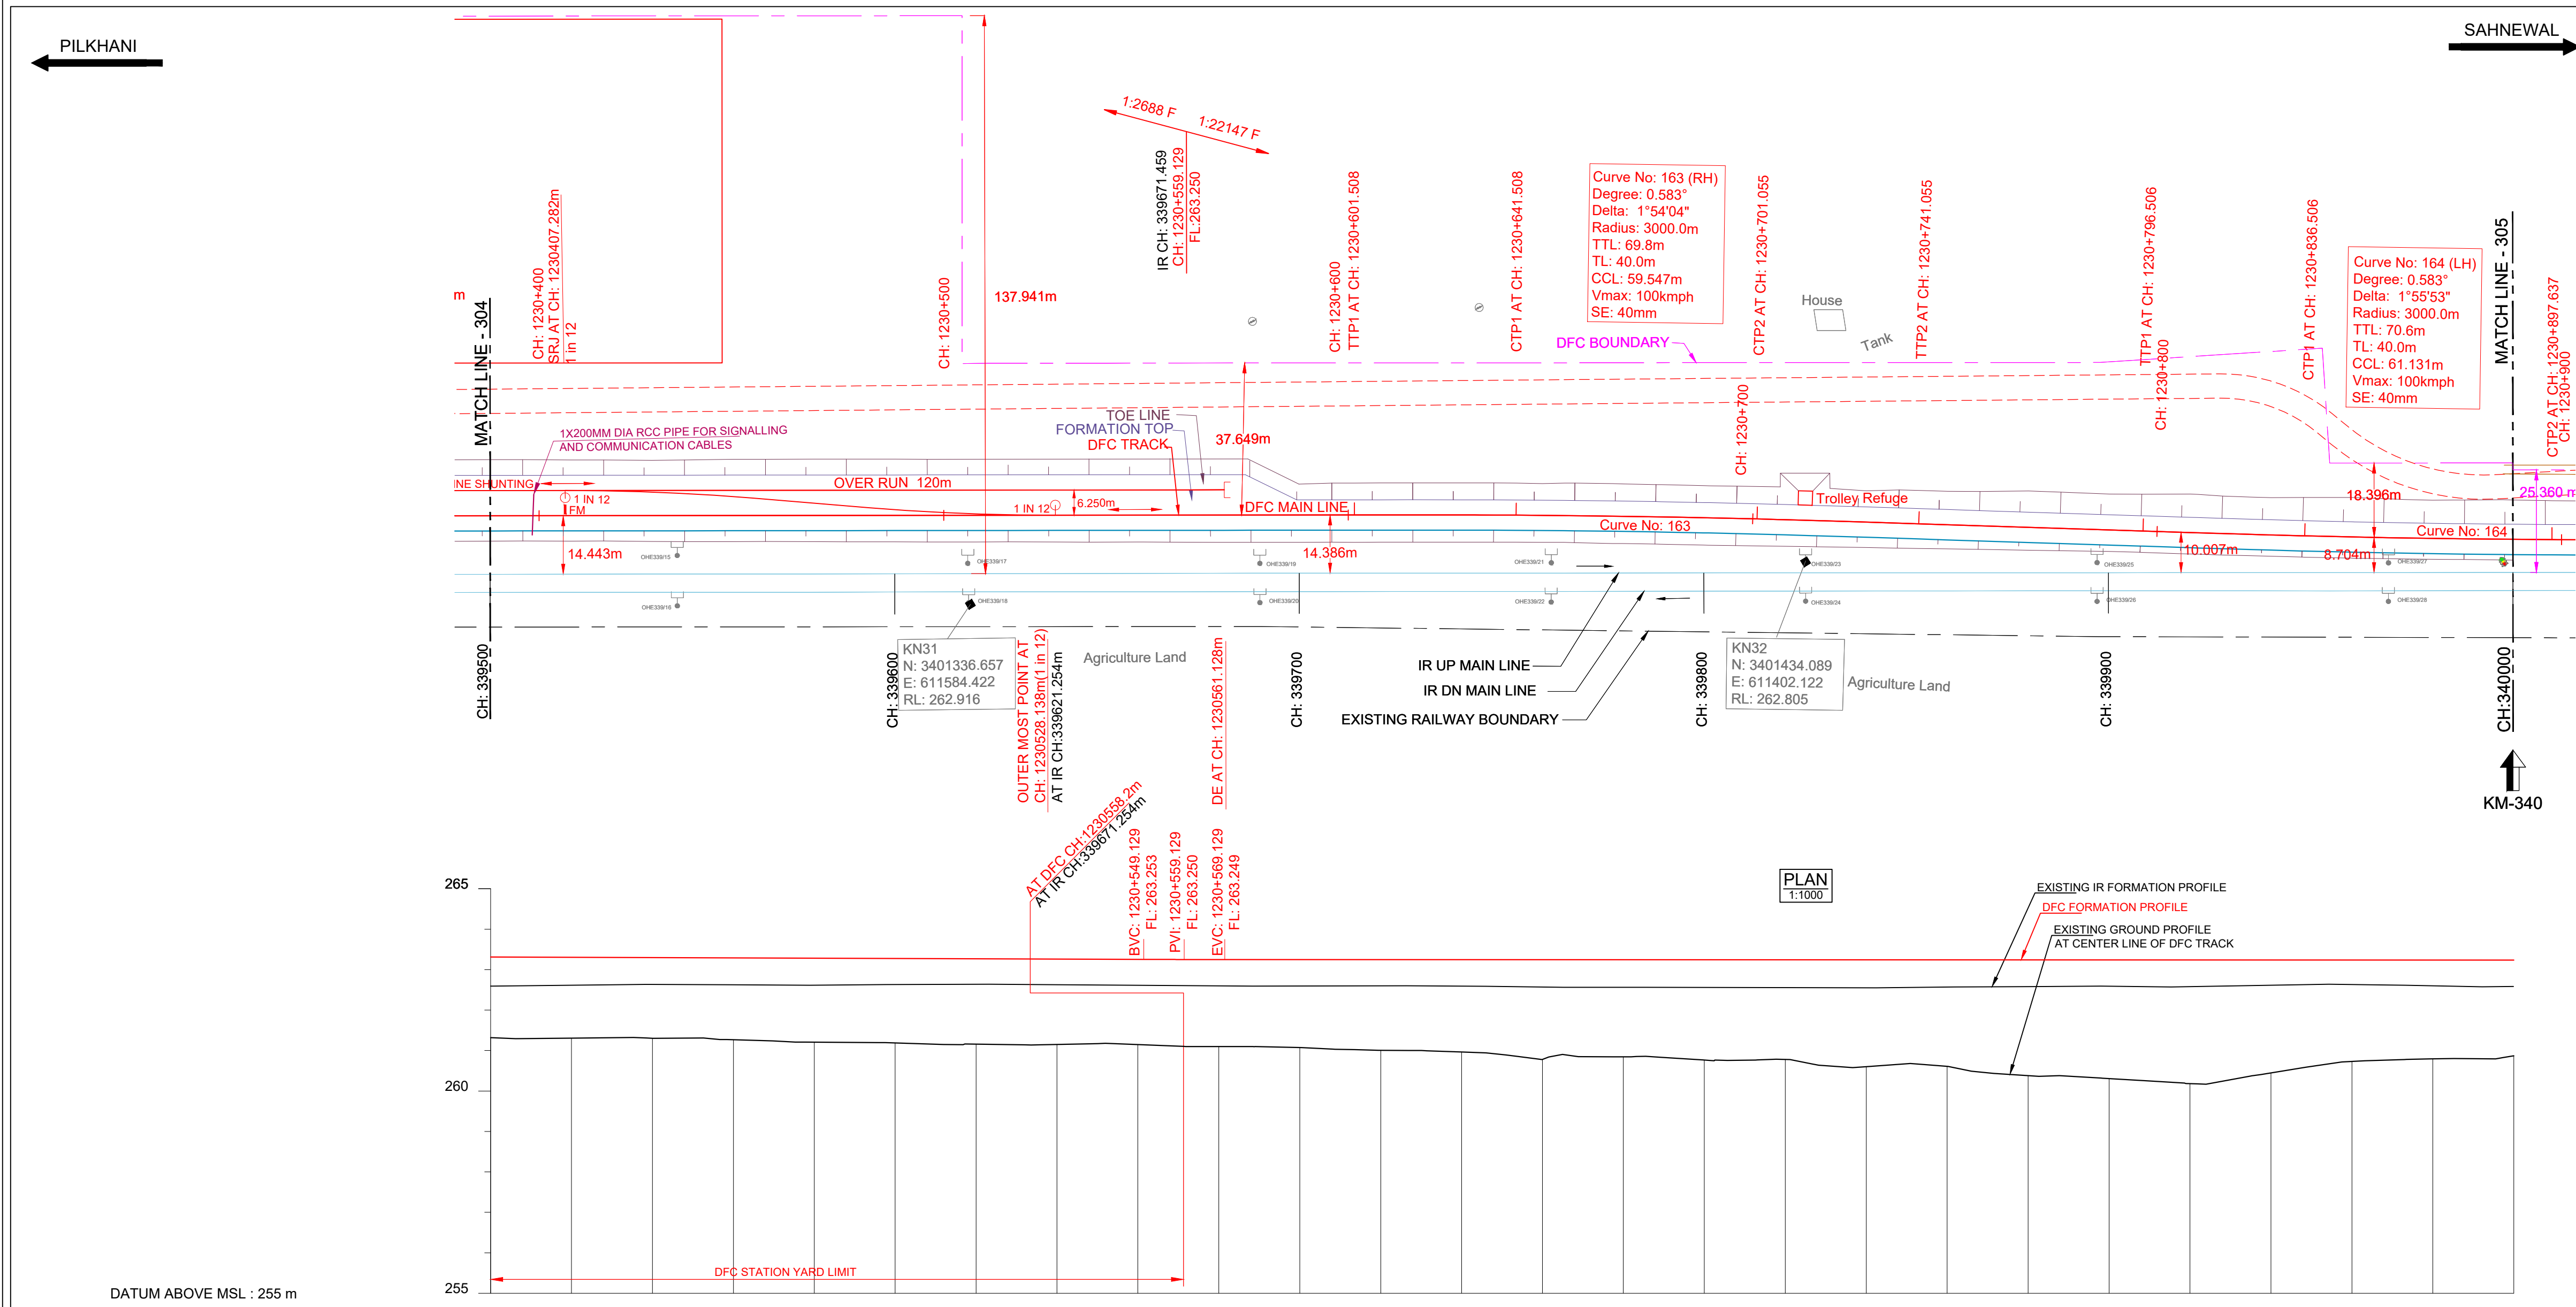

DATUM ABOVE MSL : 255 m

HORIZONTAL ALIGNMENT	L = 2876.804m																									TL= 40m					R =3000m					TL= 40m					L = 55.451m					TL= 40m					R =-3000m																																																																																																																																																																																																																																																																																																																																																																																																																																																																																																																																																																																																																																																																																																																																																																																																																																																																																																																																																																																																																																																																																																																																																																																																																																																																																																									
VERTICAL ALIGNMENT	L=1922.051 m 1 IN 2687.971 F																									L=20.0 m R=61185 m					L=1641.322 m 1 IN 22147.416 F																																																																																																																																																																																																																																																																																																																																																																																																																																																																																																																																																																																																																																																																																																																																																																																																																																																																																																																																																																																																																																																																																																																																																																																																																																																																																																																													
TRACK DISTANCE FROM EXISTING NEAREST IR UP MAIN LINE TO DFC MAIN LINE	14.464																																																																																																																																																																																																																																																																																																																																																																																																																																																																																																																																																																																																																																																																																																																																																																																																																																																																																																																																																																																																																																																																																																																																																																																																																																																																																																																																																											

L - SECTION

NOTE:-

- DFCC WORKS ARE SHOWN IN RED.
- IR NEW WORKS ARE SHOWN IN VIOLET.
- ALL DIMENSIONS ARE SHOWN IN METRES.
- THIS DRAWING IS PREPARED BASED ON LATEST SURVEY DATA HELD ON APRIL-2022. GTS BENCH MARK OF 261.850M CONSIDERED ON TOP OF CANAL BRIDGE ABUTMENT AT DORAHA VILLAGE ALONG THE NH1.
- DFC NEW CHAINAGE OF 1075.950M IS WITH REFERENCE TO THE IR KM OF 187.500KM END OF KM OF CP-303(SECTION P-3 PILKHANI END) AGAINST THE EXISTING DFC CHAINAGE. 116277.742M ISSUED VIDE LETTER NO. COM/DFCC/MB/SURVEY/2021-301-230116-011173.DT. 17.01.2023.
- BALLAST PROFILE HAS BEEN PROVIDED ACCORDING TO THE CLAUSE 1.11.3 OF STANDARD SCHEDULE OF DIMENSION(EASTERN CORRIDOR) & THE BALLAST CUSHION DIMENSION SHOWN IN 35CM ON GE-14 PARA 17. SPECIFICATIONS & RECOMMENDATIONS 2. TWO LAYER SYSTEM FIG.10.

REFERENCE DRAWINGS :-

- FOR KEY PLAN REFER DRAWING NO. 301-2/AL/0001
- FOR LEGEND AND ABBREVIATIONS REFER DRAWING NO. 301-2/AL/1000
- FOR TYPICAL SECTION OF BALLAST PROFILE (FL-RL) REFER DRG. NO. 301-2/TK/TFD/004 (TR.1952)

0	03.10.2024	SUBMISSION OF AS-BUILT DRAWING	FOR APPROVAL
REV.	DATE	REVISION DETAILS	PURPOSE OF ISSUE

SCALE
HOR - 1:1000
VER - 1:100
SHEET SIZE : A1

LEGEND:

- IR TRACK
- DFCC TRACK
- DFCC FUTURE PROPOSALS
- STRUCTURE / BUILDING
- DFCC TOE LINE
- DFCC FORMATION
- RETAINING WALL
- ROAD
- STREAM, DRAIN, NALA, CANAL
- FENCE
- POWER LINES
- TBM
- ELECTRIC POLE/OHE MAST
- IR RAILWAY BOUNDARY
- DFCC BOUNDARY

TYPICAL SECTION

TRACK STRUCTURE

RAIL SECTION: 60Kg/m (UIC 60Kg/m)	Difference between FL- RL (Below Rail Seat)	
DFC LINE: 60Kg/m (UIC 60Kg/m)	IR Line	DFC
IR MAIN LINE: 52Kg/m	172mm	172mm
RUBBER PAD	6mm	10mm
SLEEPER DEPTH	210mm	210mm
BALLAST CUSHION	300mm	350mm
Total Depth (FL TO RL)	688mm	742mm

OWNER
DEDICATED FREIGHT CORRIDOR CORPORATION OF INDIA LTD.
(A GOVERNMENT OF INDIA ENTERPRISE)
PROJECT OFFICE(AMBALA UNIT): OLD RAILWAY COLONY (NEAR ANAND MARKET),AMBALA CANTT-133001.
CORPORATE IDENTITY NO. : U60232DL2006GGI155068

ENGINEER:
DB Engineering & Consulting GmbH
Deutsche Bahn Engineering & Consulting GmbH

CONTRACTOR:
GIL - TPL JV
GAR TATA

SUBMITTED BY	GIL - TPL JV		
	DATED	NAME	SIGNATURE
PREPARED BY			
CHECKED BY	03.10.2024	VIJAY PRATAP	
APPROVED BY	03.10.2024	PARASURAM KOTYADA	
APPROVED BY	DEUTSCHE BAHN ENGINEERING & CONSULTING GMBH		
	DATED	NAME	SIGNATURE
Sr. DE./CHIEF ENGINEER		SURESH K.YALANGI	
CHIEF TRACK ENGINEER		RAJ PAL SINGH	
T.L.		H.D. VIDJAK	



STAMP
A AS-BUILT DRAWING
TR. Ref.:.....
ENGINEER Sign.:.....

EMPLOYER (DFCCIL): DEDICATED FREIGHT CORRIDOR CORPORATION OF INDIA LTD.

AS BUILT DRAWING

TITLE	DFCC APPR. NO. -	STATUS A
AS-BUILT PLAN AND PROFILE	ENG. APPR. NO. -	
FROM IR KM: 339.500 TO 340.000	DRG. NO. :301-2/AL/A/1305	
FROM DFC KM: 1230.387 to 1230.887	SHEET NO. : 1 OF 1	
	DATE : 03.10.2024	

TR.

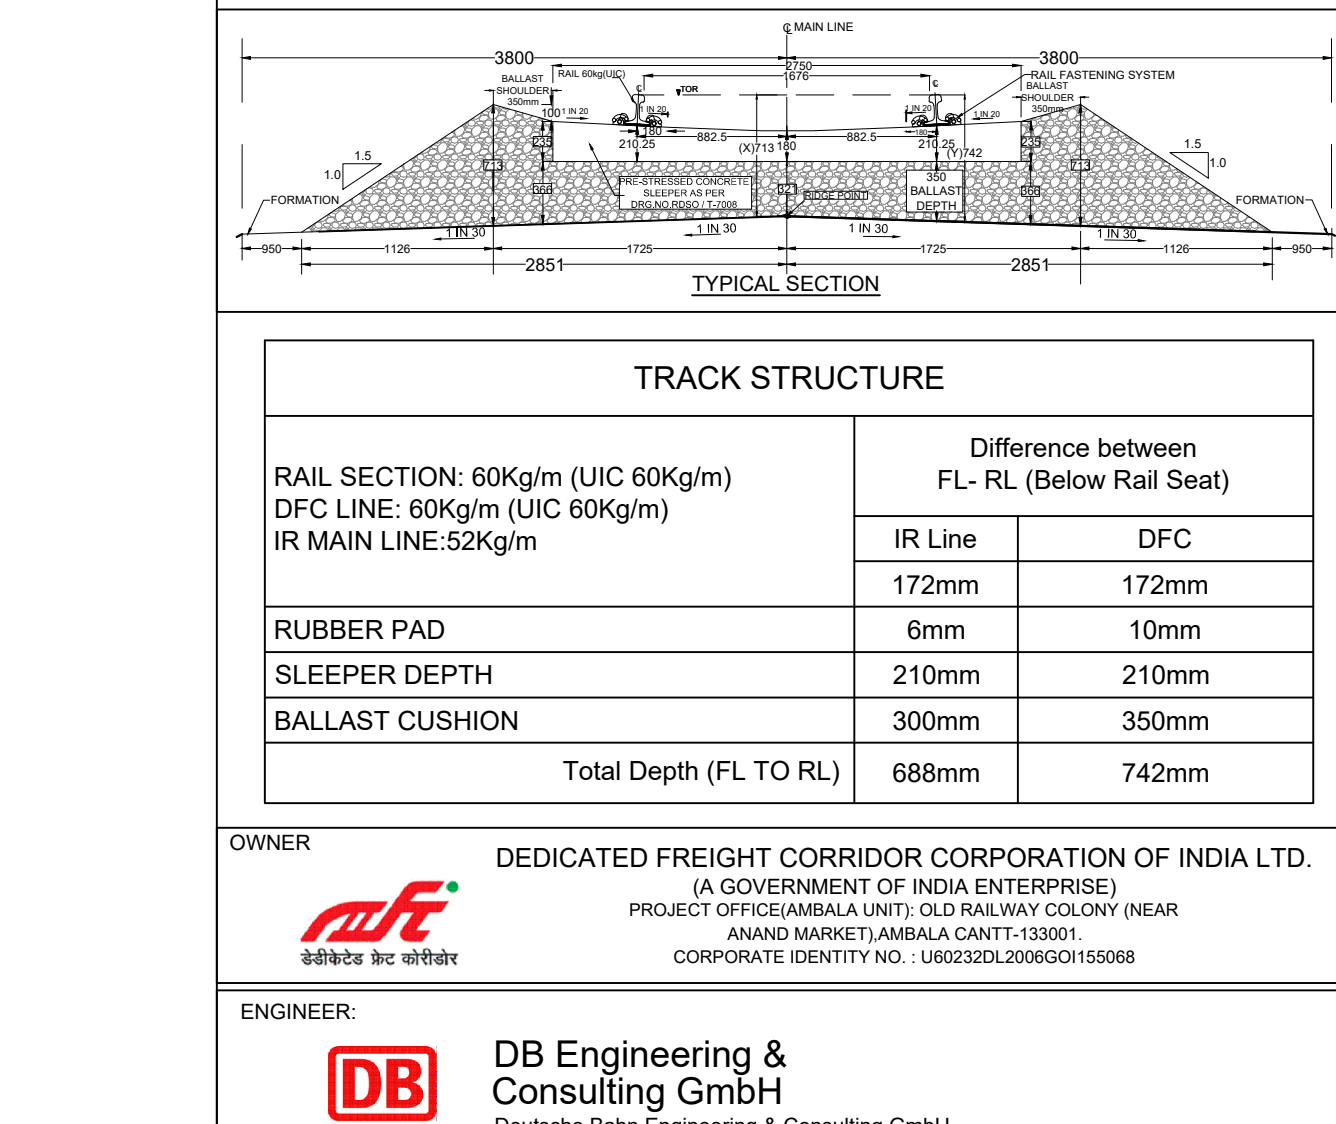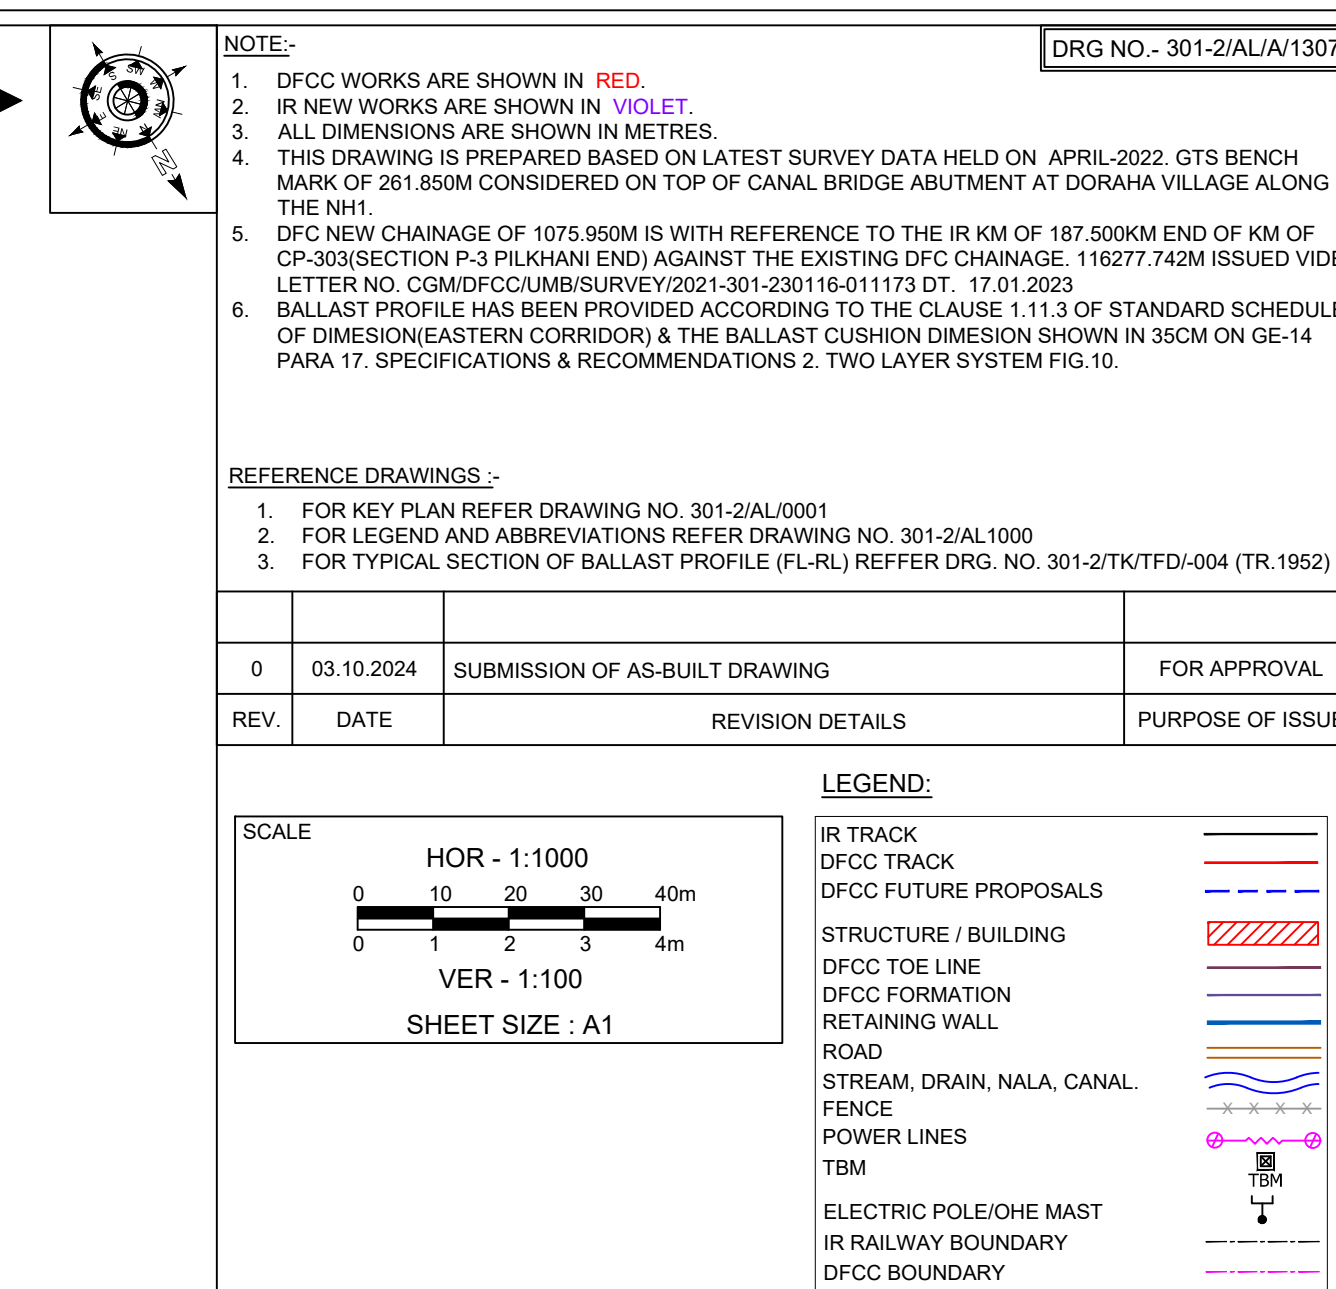

CONTRACTOR:				GIL - TPL JV	
		 			
SUBMITTED BY		GIL - TPL JV			
	DATED	NAME		SIGNATURE	
PREPARED BY					
CHECKED BY		03.10.2024	VIJAY PRATAP		
APPROVED BY		03.10.2024	PARASURAM KOTYADA		
APPROVED BY		DEUTSCHE BAHN ENGINEERING & CONSULTING GMBH			
	DATED	NAME		SIGNATURE	
Sr. DE./CHIEF ENGINEER		SURESH K.YALANGI			
CHIEF TRACK ENGINEER		RAJ PAL SINGH			
T.L.		H.D. VIDJAK			
STAMP		A AS-BUILT DRAWING TR. Ref.:..... ENGINEER Sign.:			
EMPLOYER (DFCCIL):		DEDICATED FREIGHT CORRIDOR CORPORATION OF INDIA LTD.			
AS BUILT DRAWING					
TITLE		DFCC APPR. NO. - ENG. APPR. NO. - DRG. NO. 201 2/A/IA/1207			
AS-BUILT PLAN AND PROFILE SECTION 1111 201 2/A/IA/1207					