


OWNER

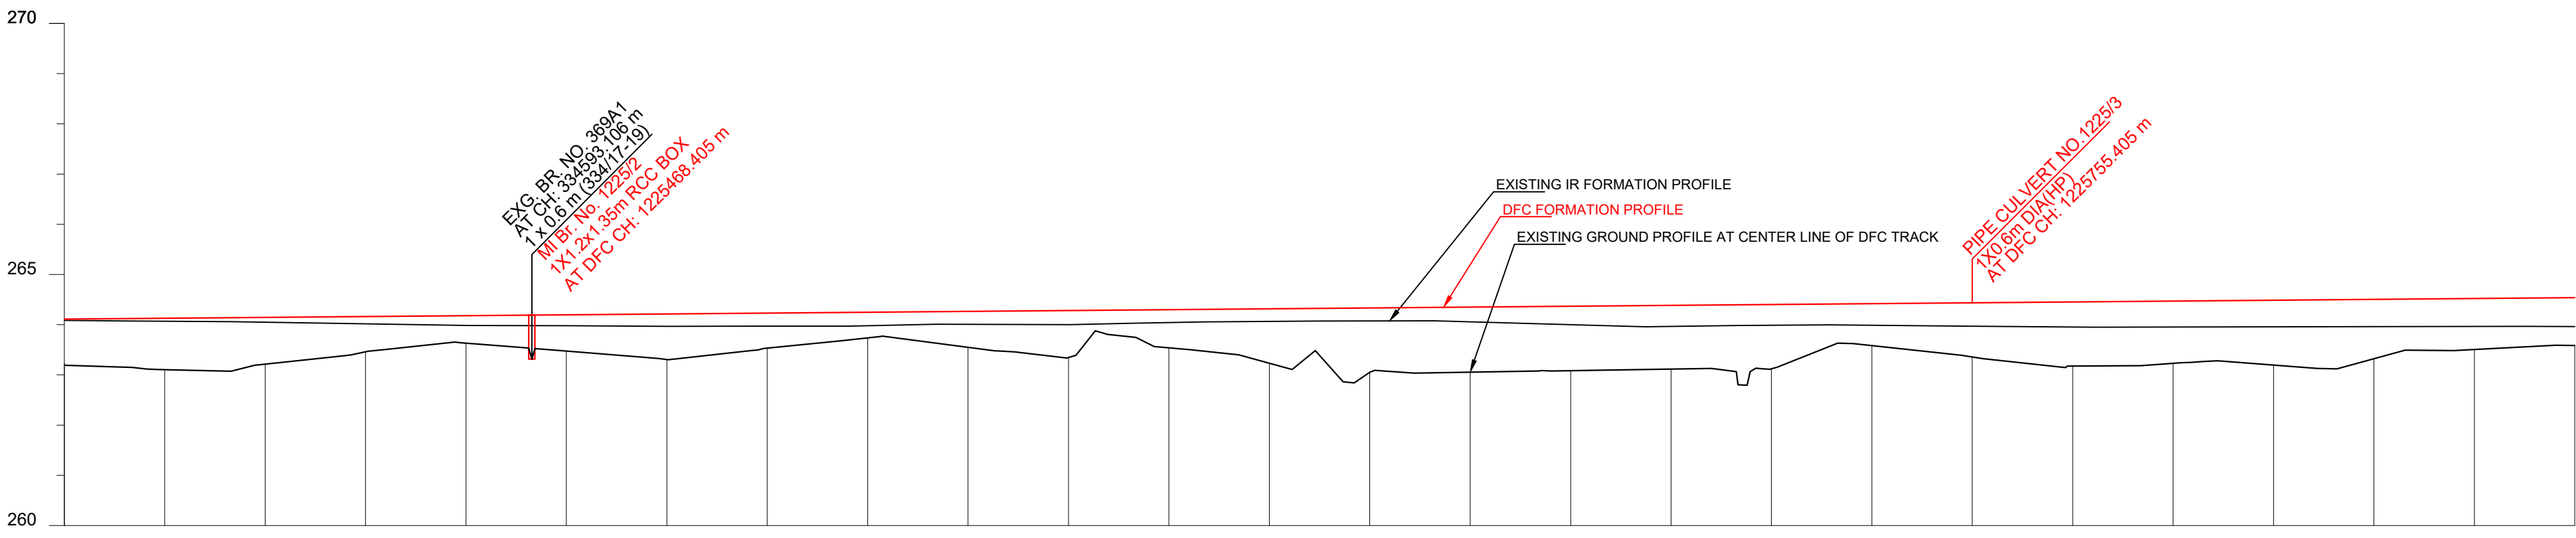

डेडीकेटेड फ्रीट कोरिडोर

DEDICATED FREIGHT CORRIDOR CORPORATION OF INDIA LTD.

(A GOVERNMENT OF INDIA ENTERPRISE)

PROJECT OFFICE(AMBALA UNIT): OLD RAILWAY COLONY (NEAR
ANAND MARKET) AMBALA CANTT-133001.

CORPORATE IDENTITY NO. : U60232DL2006GO1155068

CONTRACTOR: GIL - TPL JV

APPROVED BY	DEUTSCHE BAHN ENGINEERING & CONSULTING GMBH		
	DATED	NAME	SIGNATURE
Sr. DE./CHIEF ENGINEER		SURESH K.YALANGI	
CHIEF TRACK ENGINEER		RAJ PAL SINGH	
T.L.		H.D. VIDJAK	

AS BUILT DRAWING		
TITLE AS-BUILT PLAN AND PROFILE FROM IR KM: 334.500 TO 335.000 FROM DFC KM: 1225.375 to 1225.875	DFCC APPR. NO. -	STATUS A
	ENGG. APPR. NO. -	
	DRG. NO. -301-2/AL/A/1295	
	SHEET NO. : 1 OF 1	
	DATE : 03.10.2024	